



Request for Proposals

3.0 MG West Side Reservoir and 24-inch Transmission Main

CIP #1149

Addendum No. 2

October 18, 2022

The following is provided as supplementary information to the Request for Proposals published on October 5, 2022 (QuestCDN #8306687).

The optional pre-proposal meeting took place on October 13, 2022 at 1:00 p.m. The following were discussion points or responses to questions answered at the meeting/site visit.

- City staff discussed key highlights of the project, including:
 - City staff involved (review and comment, project management)
 - Scope of work:
 - Phase 1 – preliminary engineering and “mini master plan” to verify assumptions and correct sizing of reservoir and piping
 - Alternatives analysis (specifically for seismic design)
 - Site plan: need to take future use into account – 2nd reservoir and possible well
 - Note: existing house to stay, barn will be demolished. House is currently occupied, and we need to coordinate with tenants.
 - Phase 2 – final engineering and construction services
 - Operational concerns with the length of 24” transmission pipe (water age), as well as construction impacts on Tooze Rd with the Sherwood 48” line in the same corridor.

Questions/Responses:

- Q: Can the City provide the draft water system schematic?
 - Yes, See Attachment D
- Q: What is the purpose of the proposed well?
 - This would be to replace wells that are no longer functioning. This is only a conceptual idea at this point, but the City wants to make sure to have the option available.
- Q: Any other operational concerns?
 - Typical concerns for this type of facility. Need to look at operator safety with the reservoir height (e.g. stairs vs. ladders)

- Q: What level of effort is expected with public involvement?
 - This needs to be right-sized for the project and will depend on the impacts to Tooze Rd. Typically, City expects consultant to provide materials and support for public involvement. There may be a need to attend open-houses at the site or a City Council meeting.
- Q: Does the City have a SCADA integrator? What should the relationship be with the integrator?
 - Yes, the City works with Portland Engineering. It's preferred to include them as a sub-consultant for this project rather than having the City directly contract with them.
- Q: What specifically is the City looking for in a seismic alternatives analysis?
 - Costs associated with different design criteria and guidance in selection (Oregon codes/Resilience Plan vs. Willamette Water Supply standards).
- Q: Schedule – is the schedule in the RFP firm?
 - There is no specific driver for the Oct 2025 completion other than to wrap up before another rainy season. Can be extended but need to be watchful of the City's expansion and need for additional storage.

Attachments:

- A. Pre-proposal sign in sheet
- B. Pre-proposal meeting agenda
- C. Pre-proposal meeting PowerPoint
- D. DRAFT – Water System Schematic
- E. Record drawings of Sherwood 48" main

End of Addendum No. 2

By: Mike Nacrelli, PE, Project Manager

Attachment A

**CITY OF WILSONVILLE
ENGINEERING DEPARTMENT
PRE-PROPOSAL MEETING SIGN-IN**

DATE: October 13, 2022, 1:00 PM

PROJECT: West Side Level B Reservoir and 24" Transmission Main

PROJECT MANAGER: Mike Nacrelli, mnacrelli@ci.wilsonville.or.us, 503-570-1540

PRESENT AT MEETING

NAME	REPRESENTING	PHONE #	E-MAIL ADDRESS
Andrew Barrett	COW	503-570-1567	abarrett@ci.wilsonville.or.us
Sarah Alton	COW	503-570-1538	salton@ci.wilsonville.or.us
Ian Eglitis	COW	503-570-1584	eglitis@ci.wilsonville.or.us
Mike Nacrelli	COW	503-570-1540	mnacrelli@ci.wilsonville.or.us
Taylor Stockton	RH2	503-460-7488	tstockton@rh2.com
Jason Rice	WSC	503-387-7300	jrice@wsc-inc.com
Scott Duren	WSC	503-387-7300	sduren@wsc-inc.com
Jesse Fields	Keller	503-999-1434	jfields@kellerassociates.com
Peter Olsen	Keller	503-364-2002	polsen@kellerassociates.com
Lael Alderman	Consor	503-225-9010	Lael.alderman@consoreng.com
Adam Blair	Consor	503-2252-9010	Adam.blair@consoreng.com
Brad Moore	Hazen & Sawyer	Via Zoom	Via Zoom
Dan Garbely	Hazen & Sawyer	Via Zoom	Via Zoom
Mark Nelson	Kennedy/Jenks	Via Zoom	Via Zoom
David Matz	RH2	Via Zoom	Via Zoom
Anna-Marie Matalucci	AKS	Via Zoom	Via Zoom

PRE-PROPOSAL MEETING AGENDA

PROJECT: West Side Level B Reservoir and 24" Transmission Main
Project No. 1149

LOCATION: 29799 SW Town Center Loop E, Wilsonville, OR 97070
Arrowhead Creek Conference Room or via Zoom

DATE/TIME: October 13, 2022 – 1:00 PM

OWNER: City of Wilsonville

PROJECT MANAGER: Mike Nacrelli, P.E. (City of Wilsonville)

1. INTRODUCTIONS – Name, Company, and Role
2. RFP SCHEDULE
 - A. Change Request/Question Deadline – 10/28/22, 5:00 PM
 - B. Addenda Issuance Deadline – 10/31/22, 5:00 PM
 - C. Proposal Due Date – 11/3/22, 4:00 PM
 - D. Notice of Intent to Award – 11/16/22
 - E. City Council Award – 12/19/22
 - F. Notice of Award – 12/20/22
3. PROJECT BACKGROUND
 - A. Review of RFP Attachment B
4. SCOPE OF WORK
 - A. Review of RFP Section 2
5. TERM OF SERVICE
 - A. Final Completion Date: October 10, 2025
6. OTHER TOPICS AND QUESTIONS
7. OPTIONAL SITE VISIT – 2:00 PM
 - A. 12771 SW Tooze Road, Sherwood, OR 97140

West Side Level 'B' Reservoir and 24" Transmission Main

Pre-Proposal Meeting
October 13, 2022

Mike Nacrelli, Senior Civil Engineer
mnacrelli@ci.Wilsonville.or.us



WILSONVILLE
OREGON

Meeting Agenda





- Sign-Ins (all attendees)
- City's Project Team Introductions
 - Mike Nacrelli, Senior Civil Engineer
 - Andrew Barrett, Capital Projects Engineering Manager
 - Sarah Alton, Civil Engineer
- Proposal Schedule
- Project Overview
- Scope of Work
- Questions
- Site Visit – 12771 SW Tooze Rd, Sherwood, OR 97140

Proposal Schedule



- Change Request/Question Deadline – 10/28/22, 5:00 PM
- Addenda Issuance Deadline – 10/31/22, 5:00 PM
- Proposal Due Date – 11/3/22, 4:00 PM
- Notice of Intent to Award – 11/16/22
- City Council Award – 12/19/22
- Notice of Award – 12/20/22

Project Overview

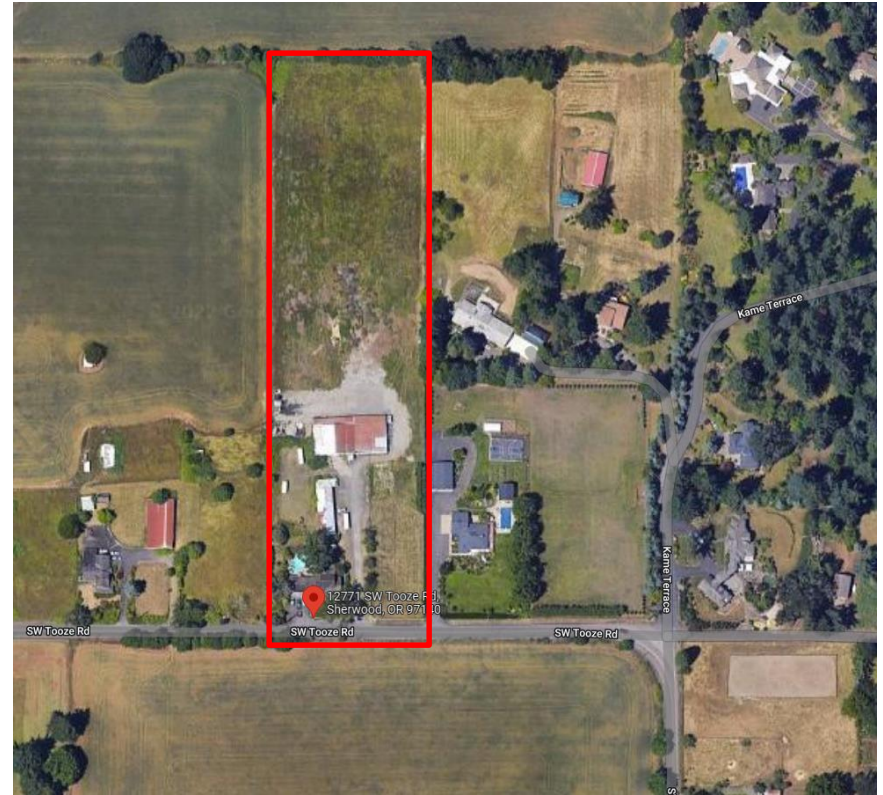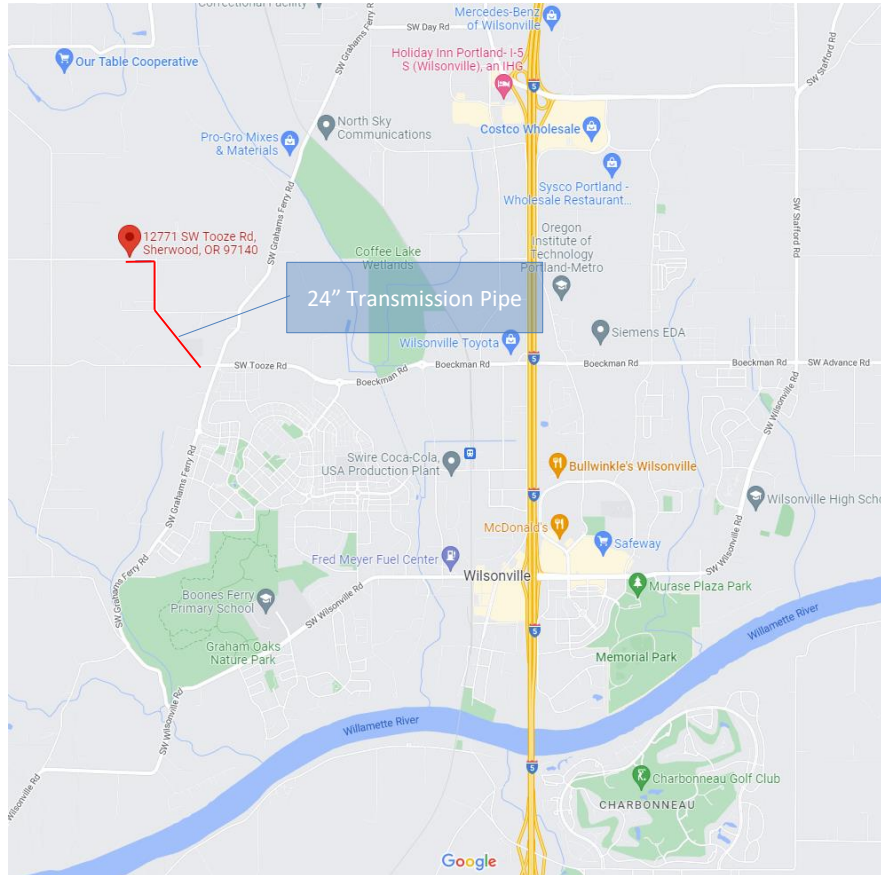


Project Overview




Exhibit A Site Plan

Preliminary-
Not for Construction

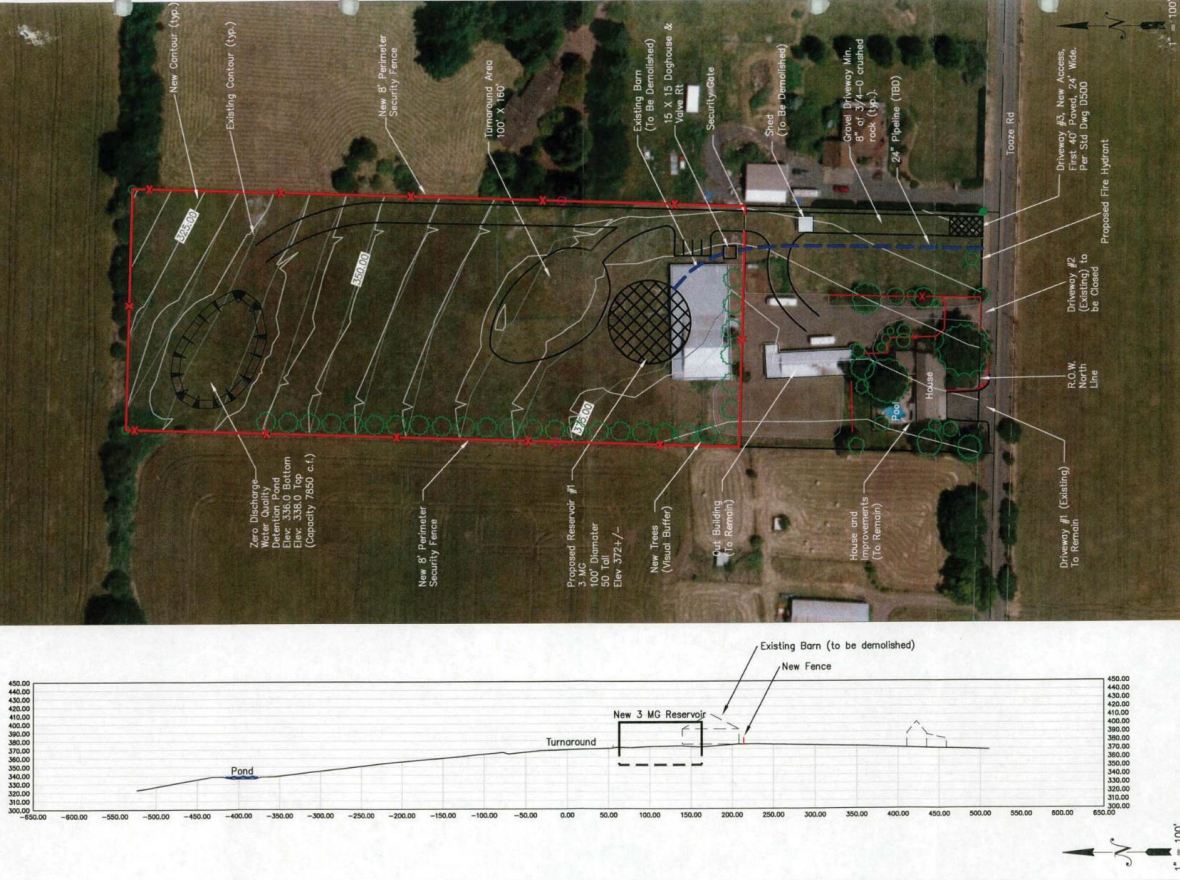

Date: January 11, 2023 Scale: 1" = 100' Drawn By: Dana Johnson Date Plotted: January 11, 2023 Drawing Name: Exhibit A Site Plan.dwg	City of Wilsonville Engineering Division Proposed Site Layout Concept Property: 735 RW 100 Tract 14, Lot 930 Washington County, OR
City of Wilsonville Engineering Division 25799 SW Town Center Loop East Wilsonville, OR 97170 503-682-4986	


Project Overview

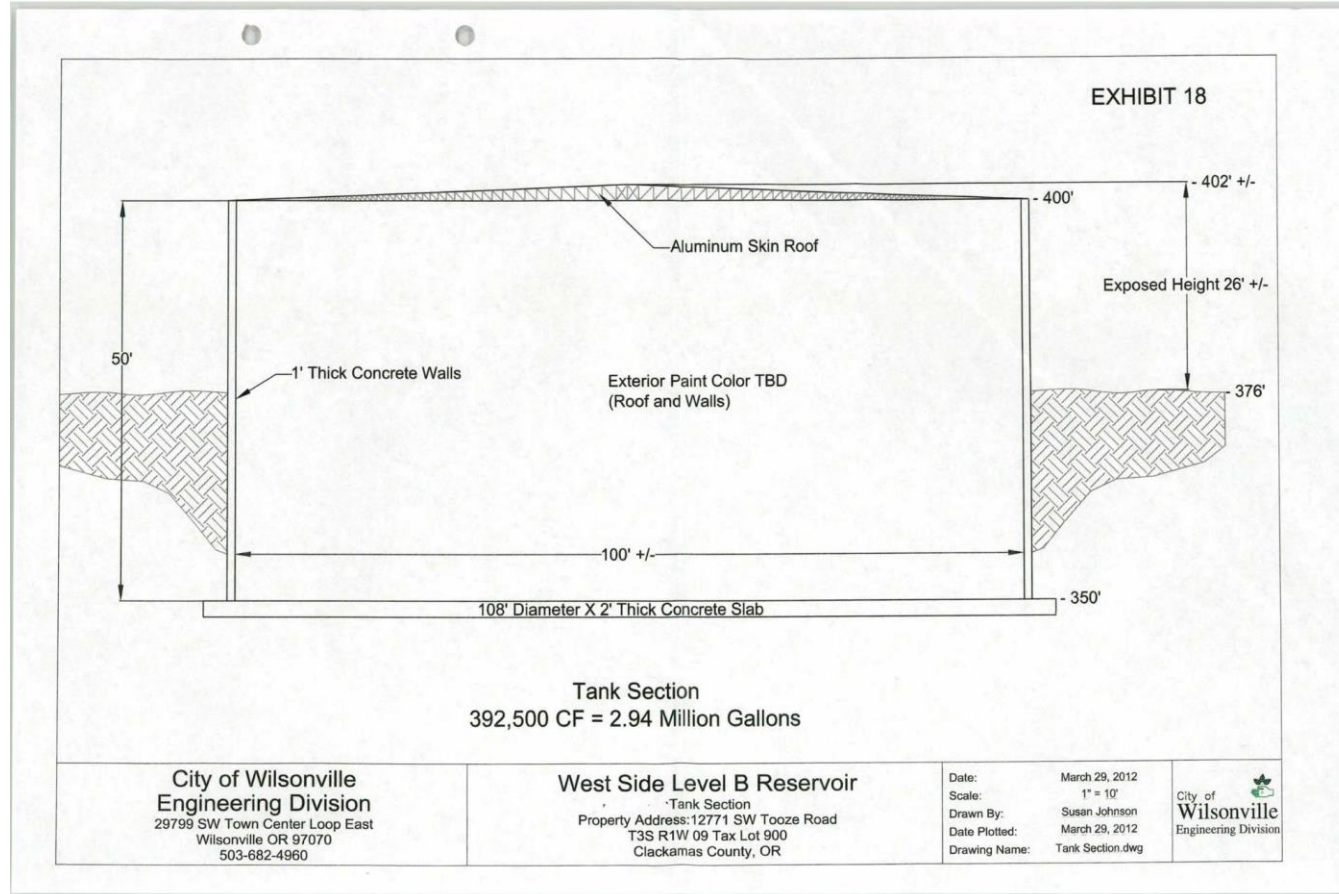

Scope of Work



- Goal: A new 3.0 MG D-110 reservoir and associated 24” transmission piping, completed by October 2025.
- Phase 1: Preliminary Analysis & Investigation:
 - “Mini Master Plan” – need to verify the 2015 assumptions and update if necessary
 - Pre-design work: reports, site plans, cost estimates for alternatives
- Phase 2: Final Analyses, Design, & Construction:
 - Design – Bid – Build project delivery method
 - 30%, 60%, 90%, and 100% design levels

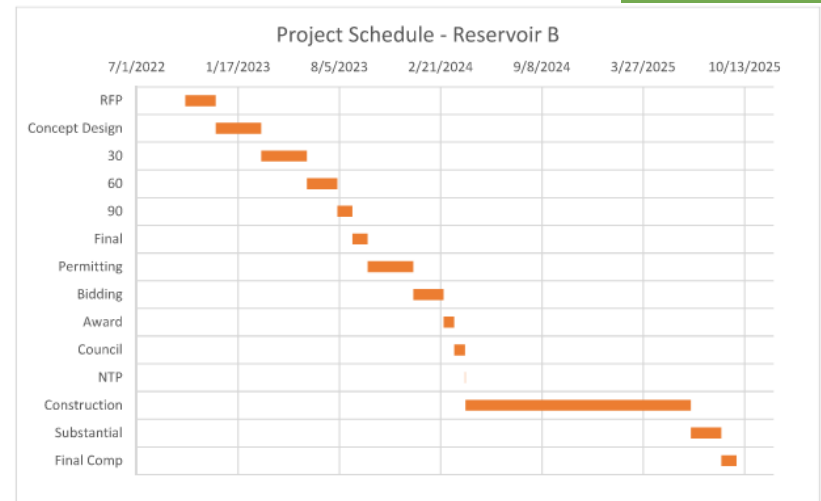


Questions





DRAFT

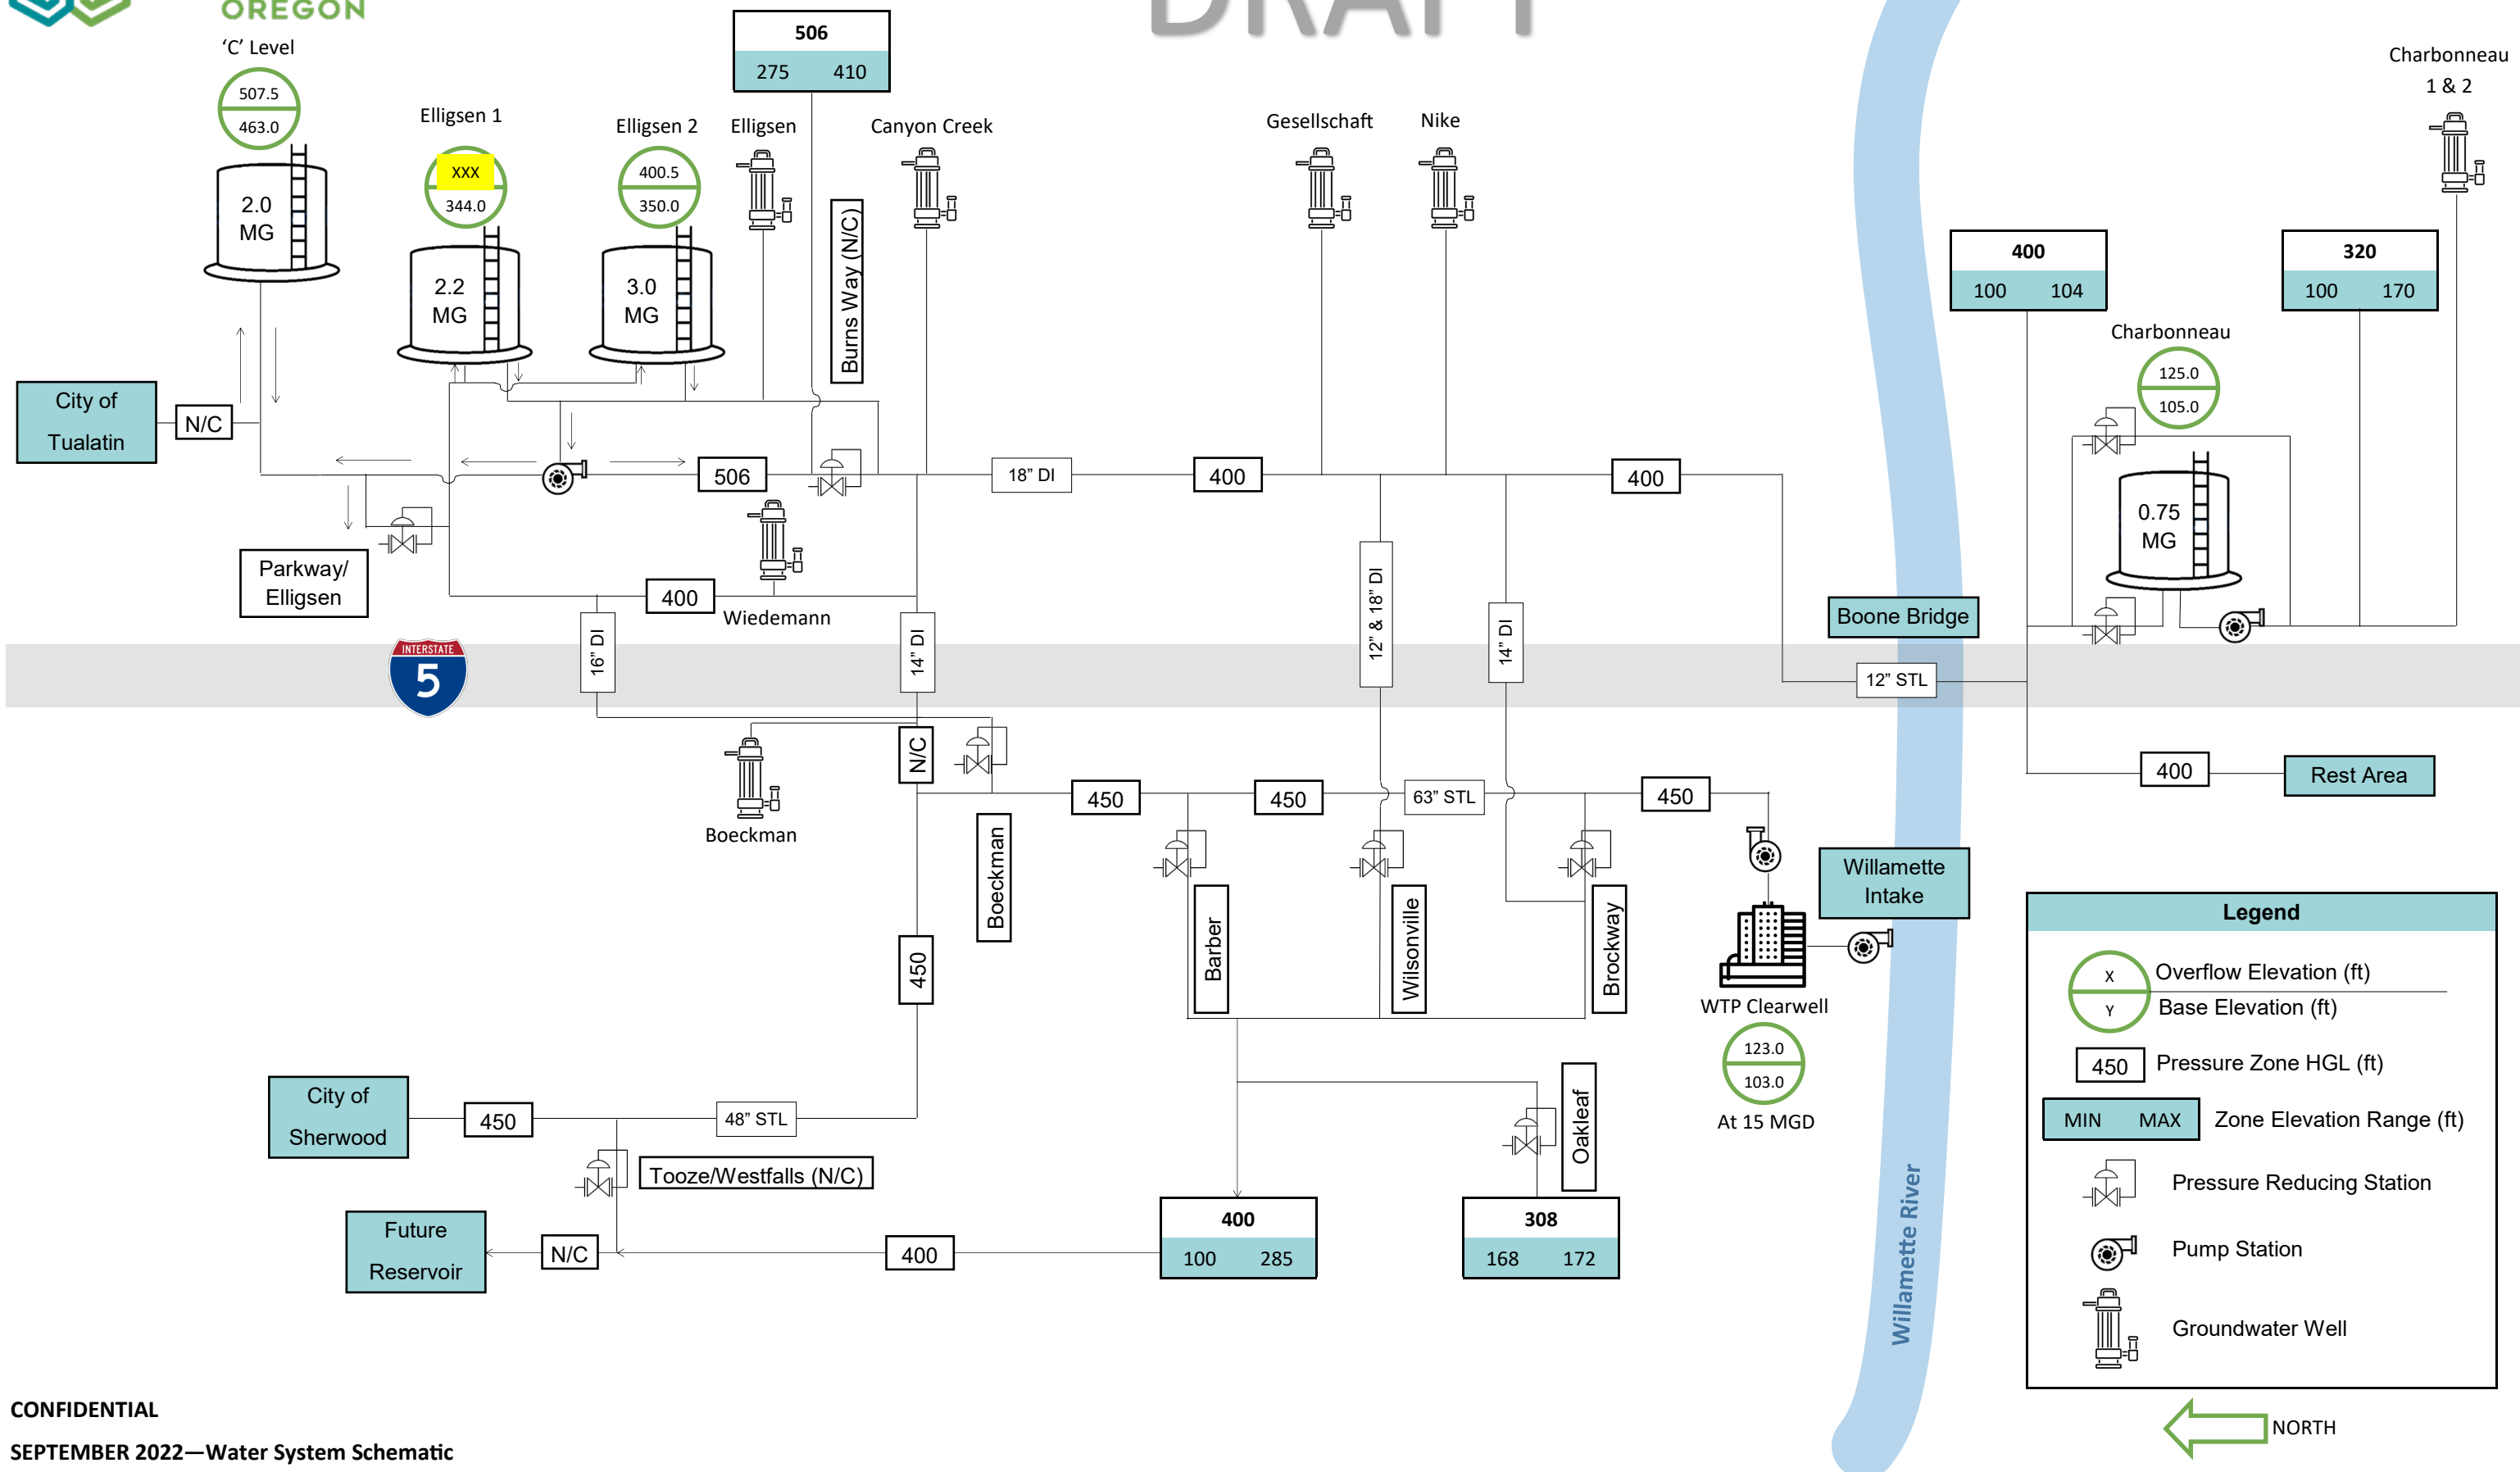

Legend

- x Overflow Elevation (ft)
- y Base Elevation (ft)
- 450 Pressure Zone HGL (ft)
- MIN MAX Zone Elevation Range (ft)
- Pressure Reducing Station
- Pump Station
- Groundwater Well



CITY OF SHERWOOD WATER SUPPLY IMPROVEMENT PROJECT TRANSMISSION PIPELINE VOLUME 3 OF 3


JUNE 2009

RECORD DRAWINGS

THIS DRAWING IS FOR RECORD PURPOSES ONLY, AND HAS BEEN PREPARED BASED IN PART ON INFORMATION PROVIDED BY OTHERS RELATIVE TO REPORTED CONSTRUCTED CONDITIONS. WHILE THIS INFORMATION IS BELIEVED TO BE RELIABLE, MURRAY, SMITH & ASSOCIATES, INC. MAKES NO ASSURANCES, STATED OR IMPLIED, AS TO THE ACCURACY OF THIS DRAWING. THOSE RELYING ON THIS RECORD DRAWING FOR ANY PURPOSE ARE ADVISED TO OBTAIN INDEPENDENT VERIFICATION OF ITS ACCURACY. CONTRACT MODIFICATION INFORMATION, FABRICATOR'S SHOP DRAWINGS AND OTHER PROJECT SUBMITTAL INFORMATION PROVIDED BY THE CONTRACTOR WHICH FURTHER CLARIFY DETAILS OF CONSTRUCTION MAY BE ON FILE. SEE ORIGINAL CONTRACT DRAWINGS FOR ENGINEER'S SEAL AND SIGNATURES.

VERSION 4.0 12-9-97


G:\PDX_Projects\07_0873\207_Design-Final_Plans\CAD\07-0873-207-OR-G-1-R.dwg G-1 8/29/2011 11:03 AM DAK 18.1s (LMS Tech)

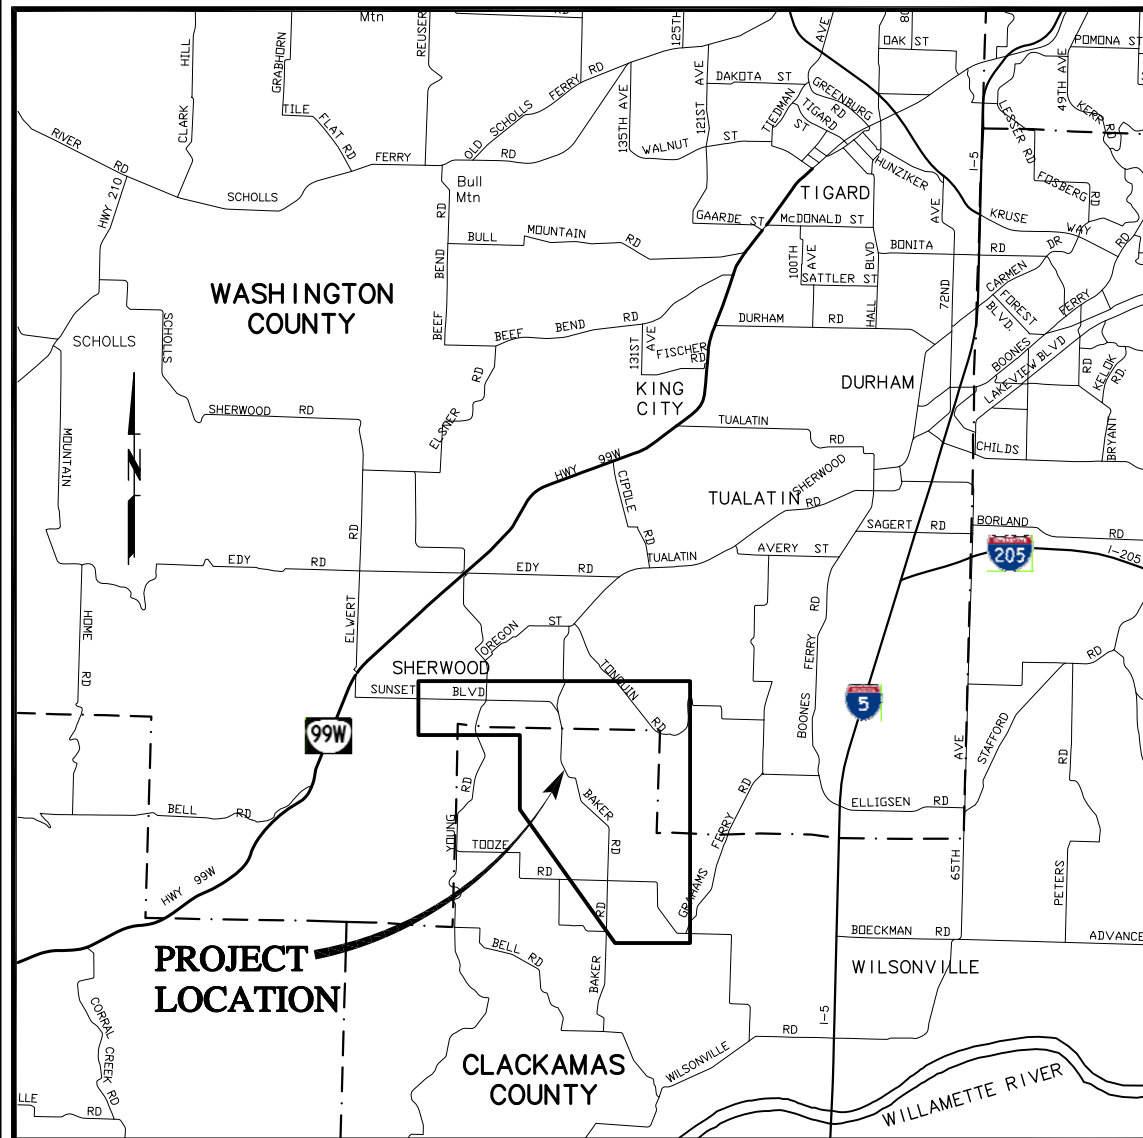

VICINITY MAP
SCALE: 1"=5000'



MSA Murray, Smith & Associates, Inc.
Engineers/Planners
121 S.W. Salmon, Suite 900 PHONE 503-225-9010
Portland, Oregon 97204 FAX 503-225-9022

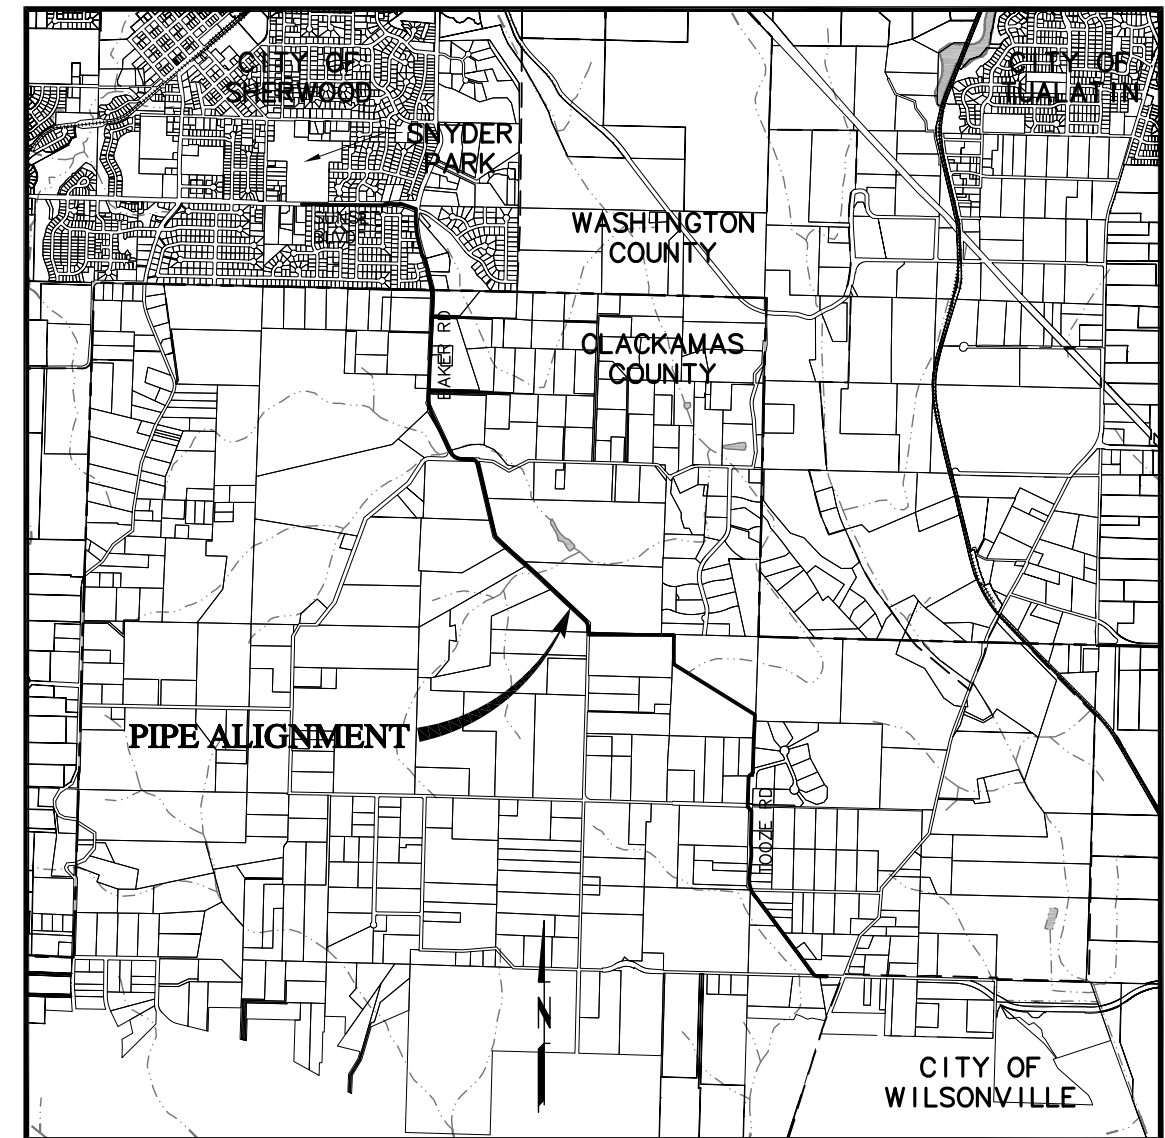

LOCATION MAP
SCALE: 1"=1500'

INDEX OF DRAWINGS

GENERAL

- 1 G-1 TITLE PAGE, VICINITY MAP, LOCATION MAP
- 2 G-2 INDEX OF DRAWINGS
- 3 G-3 GENERAL NOTES/EROSION CONTROL NOTES
- 4 G-4 SYMBOLS AND LEGEND
- 5 G-5 ABBREVIATIONS
- 6 G-6 PLAN SHEET KEY MAP
- 7 G-7 SURVEY CONTROL/GEOTECHNICAL EXPLORATION

TRAFFIC CONTROL

- 8 TC-1 PRELIMINARY TRAFFIC CONTROL PLAN - OVERVIEW
- 9 TC-2 PRELIMINARY TRAFFIC CONTROL PLAN - SUNSET BLVD CLOSURE
- 10 TC-3 PRELIMINARY TRAFFIC CONTROL PLAN - BAKER ROAD NORTH OF McCONNELL CLOSURE
- 11 TC-4 PRELIMINARY TRAFFIC CONTROL PLAN - BAKER ROAD SOUTH OF McCONNELL CLOSURE
- 12 TC-5 PRELIMINARY TRAFFIC CONTROL PLAN - TOOZE ROAD NORTH OF WESTFALL CLOSURE
- 13 TC-6 PRELIMINARY TRAFFIC CONTROL PLAN - TOOZE ROAD EAST OF WESTFALL CLOSURE

EROSION AND SEDIMENT CONTROL

- 14 ESC-1 EROSION AND SEDIMENT CONTROL COVER SHEET
- 15 ESC-2 EROSION AND SEDIMENT CONTROL NOTES AND LEGEND
- 16 ESC-3 EROSION AND SEDIMENT CONTROL MEASURES -1
- 17 ESC-4 EROSION AND SEDIMENT CONTROL MEASURES -2
- 18 ESC-5 EROSION AND SEDIMENT CONTROL DETAILS -1
- 19 ESC-6 EROSION AND SEDIMENT CONTROL DETAILS -2

CIVIL SCHEDULE A

- 20 C-1 PLAN AND PROFILE STA A16+00 TO STA A21+40
- 21 C-2 PLAN AND PROFILE STA A21+40 TO STA A26+80
- 22 C-3 PLAN AND PROFILE STA A26+80 TO STA A32+40
- △ 23 C-4 PLAN AND PROFILE STA A32+40 TO STA A36+80
- 24 C-5 48" WATER PLAN AND PROFILE STA A36+80 TO STA A42+40
- 25 C-5A 12" SD PLAN AND PROFILE STA A37+95 TO STA A41+52
- 26 C-6 48" WATER PLAN AND PROFILE STA A42+40 TO STA A47+80
- 27 C-6A 8" WATER PLAN AND PROFILE STA A43+92 TO STA A47+80
- 28 C-6B 15" SD PLAN AND PROFILE STA A43+74 TO STA A45+31
- 29 C-7 48" WATER PLAN AND PROFILE STA A47+80 TO STA A49+72
- 30 C-7A 8" WATER PLAN AND PROFILE STA A47+80 TO STA A49+72

CIVIL SCHEDULE B

- 31 C-8 PLAN AND PROFILE STA B0+00 TO STA B5+60
- 32 C-9 PLAN AND PROFILE STA B5+60 TO STA B11+00
- 33 C-10 PLAN AND PROFILE STA B11+00 TO STA B16+40
- 34 C-11 PLAN AND PROFILE STA B16+40 TO STA B22+00
- 35 C-12 PLAN AND PROFILE STA B22+00 TO STA B27+60
- 36 C-13 PLAN AND PROFILE STA B27+60 TO STA B33+00
- 37 C-14 PLAN AND PROFILE STA B33+00 TO STA B38+60
- 38 C-15 PLAN AND PROFILE STA B38+60 TO STA B44+00
- 39 C-16 PLAN AND PROFILE STA B44+00 TO STA B49+60
- 40 C-17 PLAN AND PROFILE STA B49+60 TO STA B55+20
- 41 C-18 PLAN AND PROFILE STA B55+20 TO STA B60+80
- 42 C-19 PLAN AND PROFILE STA B60+80 TO STA B64+59

CIVIL SCHEDULE C

- 43 C-20 PLAN AND PROFILE STA C0+00 TO STA C5+60
- 44 C-21 PLAN AND PROFILE STA C5+60 TO STA C11+20
- 45 C-22 PLAN AND PROFILE STA C11+20 TO STA C16+80
- 46 C-23 PLAN AND PROFILE STA C16+80 TO STA C22+40
- 47 C-24 PLAN AND PROFILE STA C22+40 TO STA C28+00
- 48 C-25 PLAN AND PROFILE STA C28+00 TO STA C33+40
- 49 C-26 PLAN AND PROFILE STA C33+40 TO STA C39+00
- 50 C-27 PLAN AND PROFILE STA C39+00 TO STA C44+60
- 51 C-28 PLAN AND PROFILE STA C44+60 TO STA C47+17

CIVIL SCHEDULE D

- 52 C-29 PLAN AND PROFILE STA D0+20 TO STA D5+60
- 53 C-30 PLAN AND PROFILE STA D5+60 TO STA D11+20
- 54 C-31 PLAN AND PROFILE STA D11+20 TO STA D16+80
- 55 C-32 PLAN AND PROFILE STA D16+80 TO STA D22+40
- △ 56 C-33 PLAN AND PROFILE STA D22+40 TO STA D28+00
- △ 57 C-34 PLAN AND PROFILE STA D28+00 TO STA D29+62

DETAILS

- 58 DT-1 PIPELINE DETAILS-1
- 59 DT-2 PIPELINE DETAILS-2
- 60 DT-3 PIPELINE DETAILS-3
- 61 DT-4 PIPELINE DETAILS-4
- 62 DT-5 PIPELINE DETAILS-5
- 63 DT-6 PIPELINE DETAILS-6
- 64 DT-7 MISC DETAILS
- 65 DT-8 MISC DETAILS
- 66 DT-9 MISC DETAILS
- 67 DT-10 MISC DETAILS
- 68 DT-11 MISC DETAILS
- 69 DT-12 MISC DETAILS
- 70 DT-13 CORROSION CONTROL DETAILS-1
- 71 DT-14 CORROSION CONTROL DETAILS-2
- 72 DT-15 ROADWAY SECTIONS & DETAILS-1
- 73 DT-16 ROADWAY SECTIONS & DETAILS-2
- 74 DT-17 ROADWAY SECTIONS & DETAILS-3
- 75 LT-1 BAKER ROAD STREET LIGHTING PLAN
- 76 LT-2 LIGHTING DETAILS

ELECTRICAL

- 77 GE-1 ELECTRICAL GENERAL SYMBOLS
- 78 GE-2 ELECTRICAL GENERAL ABBREVIATIONS AND NOTES
- 79 E-1 ELECTRICAL SITE LAYOUT PLAN



**Know what's below.
Call before you dig.**

ATTENTION: OREGON LAW REQUIRES THE CONTRACTOR TO FOLLOW THE RULES ADOPTED BY THE OREGON UTILITY NOTIFICATION CENTER. THOSE RULES ARE SET FORTH IN OAR 952-001-0010 THROUGH OAR 952-001-0090. THE CONTRACTOR MAY OBTAIN COPIES OF THE RULES BY CALLING THE UTILITY NOTIFICATION CENTER. <NOTE: THE TELEPHONE NUMBER FOR THE OREGON UTILITY NOTIFICATION CENTER IS 503-246-6699.>

NO.	DATE	BY	REVISION
△	08/22/11	BVO	RECORD DRAWING
△	07/23/10	SMG	REVISED 48" PIPE ALIGNMENT
△	09/14/09	SMG	RFI #1

NOTICE
0 1/2 1
IF THIS BAR DOES NOT MEASURE 1" THEN DRAWING IS NOT TO SCALE

SMG DESIGNED
DAK DRAWN
MLH CHECKED

RECORD DRAWING
SEE DISCLAIMER, SHEET 1.
VERSION 4.1
12-9-97

MSA Murray Smith & Associates, Inc.
Engineers/Planners
121 S.W. Salmon, Suite 900 PHONE 503-225-9010
Portland, Oregon 97204 FAX 503-225-9022

City of Sherwood Oregon
WATER SUPPLY IMPROVEMENT PROJECT TRANSMISSION PIPELINE

INDEX OF DRAWINGS
PROJECT NO.: 07-0873.207 SCALE: AS SHOWN DATE: JUNE 2009

SHEET
G-2
2 of 79

G:\PDX_Projects\07_0873\207_Design-Final_Plans\CAD\DOR\07-0873-207-OR-G-2-R.dwg G-2 9/2/2011 12:08 PM DAK 18.1s (LMS Tech)

GENERAL NOTES:

1. ALL DI PIPING TO BE RESTRAINED JOINT PIPING (R) UNLESS OTHERWISE SPECIFICALLY IDENTIFIED AS (SP) FOR STANDARD PUSH-ON JOINT PIPING. SEE SPECS FOR APPROVED TYPES OF RESTRAINT.
2. PROBES AND BORE HOLES ARE REFERENCED IN GEOTECHNICAL INVESTIGATION REPORTS OF JANUARY 3, 2007, AND FEBRUARY 6, 2009, ISSUED BY GRI. THIS REPORT IS INCLUDED AS SUPPLEMENTARY INFORMATION AND IS FOR CONTRACTOR REFERENCE ONLY AND IS NOT A PART OF THE CONTRACT DOCUMENTS.
3. LOCATIONS OF EXISTING UTILITIES ARE BASED ON INFORMATION SUPPLIED BY THE UTILITIES AND CONSIDERED APPROXIMATE ONLY. WORK FOR THIS CONTRACT MAY BE LOCATED IN CLOSE PROXIMITY TO EXIST UTILITIES. SEE SECTION 02222. THE CONTRACTOR SHALL POTHOLE AND VERIFY LOCATIONS, ELEVATIONS, TYPES AND SIZES OF EXISTING UTILITIES PRIOR TO CONSTRUCTING NEW PIPING FAR ENOUGH IN ADVANCE TO ALLOW NECESSARY ADJUSTMENTS IN GRADE AND SHALL NOTIFY ENGINEER OF NEED TO ADJUST PIPING INSTALLATION ACCORDINGLY. POTHOLING SHALL SUFFICIENTLY PRECEDE LAYING OF PIPE TO ALLOW REQUIRED ELEVATION ADJUSTMENTS TO BE ACCOMPLISHED WITHOUT REWORK. ELEVATION ADJUSTMENTS SHALL BE EXPECTED AND ARE INCIDENTAL TO THE WORK. DEFLECT PIPE AS REQUIRED AND WITHIN MANUFACTURER'S TOLERANCES TO AVOID EXISTING UTILITIES AND COMPLETE TIE-INS.
4. RESTRAIN ALL VALVES, TEES, BENDS, AND FITTINGS UNLESS OTHERWISE NOTED. ALL DI FITTINGS TO BE RESTRAINED MECHANICAL JOINT UNLESS OTHERWISE NOTED.
5. ALL FLANGED CONNECTIONS SHALL CONFORM TO THE REQUIREMENTS OF AWWA C115 AND C207, LATEST EDITION.
6. PROVIDE POLYETHYLENE ENCASEMENT FOR ALL DI PIPING WITHIN TEN (10) FEET OF EXISTING GAS MAIN ACCORDING TO ANSI/AWWA C105/A21.5.
7. TEST PRESSURE FOR DI WATER PIPING TO BE 150 PSI UNLESS OTHERWISE NOTED.
8. TEST PRESSURE FOR STEEL WATER PIPING TO BE 1.25 X WORKING PRESSURE OR 150 PSI WHICHEVER IS GREATER, UNLESS OTHERWISE NOTED.
9. HYDROSTATIC FIELD TEST PRESSURE SHALL BE AS SPECIFIED IN SECTION 01650.
10. UNLESS NOTED ON THE DRAWINGS OR SPECIFIED OTHERWISE, ALL WORK IS TO BE CONSTRUCTED IN ACCORDANCE WITH THE MOST RECENT VERSION OF CITY OF SHERWOOD PUBLIC WORKS AND CLEAN WATER SERVICES STANDARDS AND THE OREGON ADMINISTRATIVE RULES (OAR), CHAPTER 333.
11. CONTRACTOR SHALL PROVIDE TEMPORARY TAPS AND BLOWOFFS AND THRUST BLOCKING AS REQUIRED TO FACILITATE FLUSHING, TESTING AND DISINFECTION OF WATERLINES. AT COMPLETION OF DISINFECTION, REMOVE TEMPORARY TEST TAPS AND REPLACE WITH PERMANENT DUCTILE IRON, STEEL OR BRASS PLUGS.
12. ALL EXISTING FEATURES INCLUDING BUT NOT LIMITED TO ROADWAYS, STRUCTURES, LOTS, CURBS, SIDEWALKS, FENCES, WALLS, PLANTING, DITCHES, MAILBOXES, SIGNS, PIPING AND UTILITIES DISTURBED DURING CONSTRUCTION SHALL BE RESTORED TO EXISTING CONDITION UNLESS OTHERWISE SPECIFIED. CONTRACTOR SHALL REPAIR ALL UTILITY SERVICES DAMAGED DURING CONSTRUCTION AND SUCH REPAIRS SHALL BE CONSIDERED INCIDENTAL.
13. CONTRACTOR TO OBTAIN AND COMPLY WITH CITY OF SHERWOOD AND CLACKAMAS COUNTY PERMITS AND REQUIREMENTS FOR WORK IN, AND RESTORATION OF, CITY AND COUNTY ROADWAYS.
14. ALL WATER PIPING SHALL HAVE A MINIMUM OF 3 FEET OF COVER FROM TOP OF PIPE BELL TO STREET GRADE OR OTHER FINISH GRADE, UNLESS OTHERWISE SHOWN OR APPROVED BY ENGINEER.
15. DO NOT REMOVE TREES UNLESS THEY HAVE BEEN PREVIOUSLY IDENTIFIED IN THE FIELD FOR REMOVAL PER ENGINEER.
16. FINAL LOCATIONS OF ALL VALVE BOXES, TEST STATIONS, AIR RELEASE VALVES AND BLOWOFFS, SHALL BE FIELD VERIFIED PRIOR TO CONSTRUCTION PER ENGINEER.
17. PROVIDE "AS CONSTRUCTED" DRAWINGS INDICATING ALL CHANGES IN GRADE, ALIGNMENT, FITTINGS AND MATERIALS INSTALLED AND ANY OTHER UTILITIES OR OBSTACLES NOT SO INDICATED ON THESE PLANS.
18. AT THE END OF EACH WORK DAY ALL OPEN TRENCHES SHALL BE BACKFILLED TO GRADE OR PLATED. SEE SECTION 02222.
19. CONTRACTOR SHALL COMPLY WITH ALL OREGON DEPARTMENT OF ENVIRONMENTAL QUALITY (DEQ) REQUIREMENTS IN THE DISPOSAL OF CHLORINATED WATER. SEE SPECIFICATIONS.
20. CONTRACTOR SHALL BE RESPONSIBLE FOR PROTECTING CONSTRUCTION SURVEYS. PRIOR TO CONSTRUCTION, FIELD LAYOUT SHALL BE APPROVED BY ENGINEER. SEE CONTRACT DOCUMENTS FOR SURVEY REQUIREMENTS.
21. WHERE A WATERLINE CROSSES A SANITARY SEWER LINE, ONE PIPE LENGTH OF THE WATERLINE MUST BE CENTERED AT THE CROSSING. COMPLY W/ OAR CHAPTER 333 RULES FOR REQUIRED WATERLINE-SEWERLINE SEPARATION AND CROSSING REQUIRED.
22. PIPE DEFLECTION OF DUCTILE IRON PIPE LIMITED TO ONE-HALF MANUFACTURER'S RECOMMENDATIONS.
23. HORIZ BEND COORDINATES REPRESENT THE CENTERLINE POINT OF INTERSECTION.
24. MAINLINE VALVE OPERATOR NUTS TO BE PLACED ON SIDE CLOSEST TO EDGE OF PAYMENT.
25. MANHOLES SHALL BE CONSTRUCTED IN ACCORDANCE WITH CLEAN WATER SERVICES STANDARD PLANS AND SPECIFICATIONS.
26. MANHOLE COVERS SHALL BE SET FLUSH WITH FINISH GRADE. ALL MANHOLE COVERS OUT OF ROADWAYS SHALL BE TAMPER PROOF UNLESS OTHERWISE NOTED.

GENERAL NOTES CONT.:

27. SEE SPECIAL PROVISIONS OF SPECIFICATIONS FOR SPECIAL CONSTRUCTION SEQUENCING FOR PIPELINE CONSTRUCTION.
28. CONTRACTOR IS TO POTHOLE AND VERIFY EXACT DEPTHS AND LOCATIONS OF EXISTING UTILITIES PRIOR TO CONSTRUCTION.
29. EXISTING UTILITIES, NOT INTENDED FOR REPLACEMENT, ARE TO BE PROTECTED AND PRESERVED DURING CONSTRUCTION.
30. SOME EXISTING UTILITIES SHOWN ON THESE PLANS MAY BE RELOCATED PRIOR TO CONSTRUCTION. UTILITY LOCATES PERFORMED PRIOR TO CONSTRUCTION SHOULD REPRESENT NEW LOCATION OF RELOCATED UTILITIES.
31. NOTIFY PGE PRIOR TO WORK IMPACTING UTILITY POLES. COORDINATE PROTECTION, RELOCATION, OR REPLACEMENT OF UTILITY POLES WITH PGE.
32. CONNECTIONS TO EXISTING WATERLINES MAY REQUIRE TEMPORARY SHUTDOWNS OF EXISTING FACILITIES. THE CONTRACTOR SHALL COORDINATE THIS WORK WITH THE CITY OF SHERWOOD AND PROVIDE A MINIMUM OF 72 HOURS ADVANCE NOTICE PRIOR TO PERFORMING WATERLINE TIE-IN WORK. SEE SPECIFICATIONS FOR SEQUENCE OF CONSTRUCTION REQUIREMENTS. OPERATION OF VALVES SHALL BE BY CITY OF SHERWOOD PERSONNEL ONLY.
33. FOR CLARITY, OVERHEAD LINES ARE NOT SHOWN ON THE DWGS. NUMEROUS EXIST. OVERHEAD LINES OCCUR ALONG THE PIPE ALIGNMENT. CONTRACTOR TO CONFIRM CONDITIONS IN VICINITY OF OVERHEAD LINES.
34. THE FIRST LENGTH OF 48-INCH STEEL PIPE INSTALLED AT THE BEGINNING OF EACH WORK DAY SHALL BE INSTALLED SUCH THAT THE JOINT IS STABBED AN ADDITIONAL DEPTH TO ALLOW FOR CONTRACTION OF THE PIPE AS IT COOLS ONCE PLACED IN THE GROUND AND BACKFILLED. THE JOINT SHALL NOT BE WELDED UNTIL NEAR THE END OF THE WORK DAY OR UNTIL THE BEGINNING OF THE NEXT DAY. ONCE THE PIPE SEGMENTS INSTALLED IN THE TRENCH FOR THAT DAY ARE BACKFILLED, ARE WITHIN 10 DEGREES OF AMBIENT GROUND TEMPERATURE AND ARE FULLY CONTRACTED, THE FIRST PIPE JOINT CAN BE WELDED. THIS PROCEDURE SHALL BE FOLLOWED IN ADDITION TO THE SPECIFICATION REQUIREMENT TO COVER THE PIPE TO AVOID DIRECT SUNLIGHT ON THE PIPE.

CITY OF SHERWOOD STANDARD NOTES:

1. CONTRACTOR SHALL NOTIFY CITY OF SHERWOOD ENGINEERING DEPARTMENT AT 503-925-2306 TWO (2) BUSINESS DAYS PRIOR TO COMMENCEMENT OF WORK ON GRADING, PUBLIC IMPROVEMENTS, OR STORM WATER TREATMENT FACILITIES.
2. ALL CONSTRUCTION SHALL CONFORM TO CITY OF SHERWOOD STANDARD CONSTRUCTION SPECIFICATIONS. CONTRACTOR AND SUBCONTRACTOR(S) SHALL HAVE A MINIMUM OF ONE SET OF APPROVED PLANS AND CITY OF SHERWOOD STANDARD CONSTRUCTION SPECIFICATIONS ON THE JOB SITE AT ALL TIMES DURING CONSTRUCTION.
3. CITY OF SHERWOOD MAINTAINS THE ENDS OF HOUSE LATERALS AT THE CURB LINE IN RIGHT OF WAY AND AT THE END OF THE TEE IN EASEMENTS.
4. CITY OF SHERWOOD BUILDING DEPARTMENT APPROVALS AND PERMITS ARE REQUIRED FOR PRIVATELY MAINTAINED SEWER, INLETS, INLET LEADS, AND SERVICE LATERALS CONSTRUCTED OUTSIDE OF PUBLIC RIGHT-OF-WAY OR SEWER EASEMENT. ALL WORK APPROVED UNDER PLUMBING PERMITS SHALL BE PRIVATELY OWNED AND MAINTAINED.
5. ATTENTION EXCAVATORS: OREGON LAW REQUIRES YOU TO FOLLOW RULES ADOPTED BY OREGON UTILITY NOTIFICATION CENTER. THOSE RULES ARE SET FORTH IN OAR 952-001-0010 THROUGH OAR 952-001-0090. YOU MAY OBTAIN COPIES OF THESE RULES FROM THE CENTER BY CALLING (503) 232-1987. IF YOU HAVE ANY QUESTIONS ABOUT THE RULES, YOU MAY CONTACT THE CALL CENTER. YOU MUST NOTIFY THE CENTER AT LEAST 2 BUSINESS DAYS, BUT NOT MORE THAN 10 BUSINESS DAYS, BEFORE COMMENCING EXCAVATION. CALL 503-246-6699.
6. MARK ENDS OF ALL STUB OUTS AND LATERALS WITH CONTINUOUS PRESSURE TREATED 2"x4". TOP 12" TO BE PAINTED WHITE FOR STORM AND STENCILED WITH BLACK "ST", PAINTED GREEN FOR SANITARY AND STENCILED WITH BLACK "SS". ALSO INCLUDE PIPE SIZE, MATERIAL TYPE, AND PIPE DEPTH. BURY 2"x4" TO I.E. OF STUB OR LATERAL.
7. ALL TRENCH LINES AND EXCAVATIONS SHALL BE PROPERLY SHORED AND BRACED TO PREVENT CAVING. UNUSUALLY DEEP EXCAVATIONS MAY REQUIRE EXTRA SHORING AND BRACING. ALL SHEETING, SHORING, AND BRACING OF TRENCHES SHALL CONFORM TO OREGON OCCUPATIONAL SAFETY AND HEALTH DIVISION (OSHA) REGULATIONS AND CITY OF SHERWOOD STANDARD CONSTRUCTION SPECIFICATIONS. SEE SECTION 02222.

EROSION CONTROL NOTES:

1. ALL EROSION CONTROL MEASURES SHALL BE IN ACCORDANCE WITH THE WES/CWS EROSION PREVENTION AND SEDIMENT CONTROL PLANNING AND DESIGN MANUAL (REV. DECEMBER 2008) EXCEPT AS SPECIFICALLY REQUESTED BY OR APPROVED BY WES/CWS. THIS MANUAL IS AVAILABLE FOR FREE BY DOWNLOADING FROM THE WES WEBSITE AT: [HTTP://WWW.CO.CLACKAMAS.OR.US/WES/](http://www.co.clackamas.or.us/wes/)
2. APPROVAL OF THIS EROSION SEDIMENTATION CONTROL (ESC) PLAN DOES NOT CONSTITUTE AN APPROVAL OF PERMANENT ROAD OR DRAINAGE DESIGN (E.G.: SIZE AND LOCATION OF ROADS, PIPES, RESTRICTIONS, CHANNELS, RETENTION FACILITIES, UTILITIES, ETC.).
3. THE IMPLEMENTATION OF THESE EROSION/SEDIMENTATION CONTROL (ESC) PLANS AND THE CONSTRUCTION, MAINTENANCE, REPLACEMENT, AND UPGRADING OF THESE ESC FACILITIES IS THE RESPONSIBILITY OF THE CONTRACTOR UNTIL ALL CONSTRUCTION IS COMPLETED AND APPROVED AND VEGETATION/LANDSCAPING IS ESTABLISHED.
4. THE BOUNDARIES OF THE CLEARING LIMITS SHOWN ON THESE PLANS SHALL BE CLEARLY FLAGGED IN THE FIELD PRIOR TO CONSTRUCTION. DURING THE CONSTRUCTION PERIOD, NO DISTURBANCE BEYOND THE FLAGGED CLEARING LIMITS SHALL BE PERMITTED. THE FLAGGING SHALL BE MAINTAINED BY THE CONTRACTOR FOR THE DURATION OF CONSTRUCTION.

EROSION CONTROL NOTES CONT.:

5. THE ESC FACILITIES SHOWN ON THESE PLANS MUST BE CONSTRUCTED IN CONJUNCTION WITH ALL CLEARING AND GRADING ACTIVITIES, AND IN SUCH A MANNER AS TO ENSURE THAT SEDIMENT AND SEDIMENT LADEN WATER DO NOT ENTER THE DRAINAGE SYSTEM, ROADWAYS, OR VIOLATE APPLICABLE WATER STANDARDS.
 6. THE ESC FACILITIES SHOWN ON THESE PLANS ARE THE MINIMUM REQUIREMENTS FOR ANTICIPATED SITE CONDITIONS. DURING THE CONSTRUCTION PERIOD, THE ESC FACILITIES SHALL BE UPGRADED AS NEEDED FOR UNEXPECTED STORM EVENTS AND TO ENSURE THAT SEDIMENT AND SEDIMENT LADEN WATER DO NOT LEAVE THE SITE.
 7. THE ESC FACILITIES SHALL BE INSPECTED DAILY BY THE CONTRACTOR AND MAINTAINED AS NECESSARY TO ENSURE THEIR CONTINUED FUNCTIONALITY.
 8. DURING INACTIVE PERIODS ON THE SITE OF GREATER THAN SEVEN (7) CONSECUTIVE CALENDAR DAYS, INSPECTIONS SHALL BE REQUIRED ONCE EVERY TWO (2) WEEKS.
 9. FOR EACH CATCH BASIN PROTECTION, CLEANING MUST OCCUR WHEN DESIGN CAPACITY HAS BEEN REDUCED BY FIFTY PERCENT. ALL CATCH BASINS AND CONVEYANCE LINES SHALL BE CLEANED PRIOR TO PAVING. THE CLEANING OPERATION SHALL NOT FLUSH SEDIMENT LADEN WATER INTO THE DOWN STREAM SYSTEM.
 10. CONSTRUCTION ENTRANCES SHALL BE INSTALLED AT THE BEGINNING OF CONSTRUCTION AND MAINTAINED FOR THE DURATION OF THE PROJECT. SEE PLANS FOR GRAVEL CONSTRUCTION ENTRANCE. ADDITIONAL MEASURES MAY BE REQUIRED TO ENSURE THAT ALL PAVED AREAS ARE KEPT CLEAN FOR THE DURATION OF THE PROJECT. TRUCKS ENTERING PAVEMENT FROM UNPAVED AREAS SHALL BE FREE OF MUD AND DEBRIS. SEE REQ'T OF 1200-C PERMIT.
 11. FILTER FABRIC INLET BARRIERS SHALL BE INSTALLED AT NEW AND EXISTING STORM INLETS TO PREVENT SEDIMENT AND SEDIMENT LADEN WATER FROM ENTERING THE STORM DRAINAGE SYSTEM.
 12. CONTRACTOR SHALL PROVIDE DUST CONTROL AS REQUIRED, SEE SPECIFICATIONS AND PERMIT REQUIREMENTS.
 13. PAVEMENT SURFACES AND VEGETATION ARE TO BE PLACED AS RAPIDLY AS POSSIBLE.
 14. SEEDING SHALL BE PERFORMED NO LATER THAN SEPTEMBER 1 FOR EACH PHASE OF CONSTRUCTION.
 15. IF THERE ARE EXPOSED SOILS OR SOILS NOT FULLY STABILIZED FROM OCTOBER 1 THROUGH MAY 31, THE WET WEATHER EROSION CONTROL MEASURES WILL BE IN EFFECT ACCORDING TO WES/CWS EROSION PREVENTION AND SEDIMENT CONTROL PLANNING AND DESIGN MANUAL (REV. DECEMBER 2008).
 16. ESC MEASURES SHALL BE REMOVED BY THE CONTRACTOR WHEN VEGETATION IS FULLY ESTABLISHED, AS APPROVED BY THE ENGINEER.
 17. NOTIFY ENGINEER 24 HOURS PRIOR TO ANY WORK ON SITE.
- ### SEDIMENT FENCE NOTES:
18. STANDARD OR HEAVY-DUTY SEDIMENT FENCE FILTER FABRIC SHALL HAVE MANUFACTURED STITCHED LOOPS WITH 2"x2"x4' POSTS. STITCHED LOOPS SHALL BE INSTALLED ON THE UPHILL SIDE OF THE SLOPED AREA.
 19. THE FILTER FABRIC FENCE SHALL BE INSTALLED TO FOLLOW THE CONTOURS WHERE FEASIBLE. THE FENCE POSTS SHALL BE SPACED A MAXIMUM OF 6 FEET APART AND DRIVEN SECURELY INTO THE GROUND A MINIMUM OF 12 INCHES.
 20. SEDIMENT FENCES SHOULD BE INSTALLED A MINIMUM OF 3 FEET FROM TOE OF SLOPE IN ORDER TO MAXIMIZE STORAGE.
 21. A TRENCH SHOULD BE EXCAVATED 6 INCHES DEEP ALONG THE LINE OF POSTS. TRENCH SHOULD BE BACKFILLED AND THE SOIL COMPACTED ON BOTH SIDES OF THE SEDIMENT FENCE.
 22. ALL SEDIMENT FENCING MATERIAL AND PLACEMENT SHALL BE IN ACCORDANCE WITH THE WES/CWS EROSION PREVENTION AND SEDIMENT CONTROL PLANNING AND DESIGN MANUAL (REV. DECEMBER 2008).
 23. SEDIMENT FENCES SHALL BE REMOVED WHEN THEY HAVE SERVED THEIR USEFUL PURPOSE, BUT NOT BEFORE THE UPSLOPE AREA HAS BEEN PERMANENTLY STABILIZED.
 24. WHEN JOINING TWO OR MORE SEDIMENT FENCES TOGETHER, JOIN THE TWO END STAKES BY WRAPPING THE TWO ENDS AT LEAST ONE AND ONE HALF TURNS AND DRIVING THE JOINED STAKES INTO THE GROUND TOGETHER.
 25. WHEN SEDIMENT FENCE APPROACHES ITS TERMINATION POINT, TURN FENCE UPHILL AND EXTEND ON FULL PANEL (6 FT). HEIGHT OF A SEDIMENT FENCE SHOULD NOT EXCEED 3 FEET. STORAGE HEIGHT AND PONDING HEIGHT SHOULD NEVER EXCEED 1.5 FEET.
- ### BIO-FILTER BAG NOTES:
26. BIO-FILTER BAGS SHOULD BE CLEAN 100% RECYCLED WOOD PRODUCT WASTE.
 27. BIO-FILTER BAGS SHALL BE STANDARD SIZE 10" x 8" x 30", WEIGHING APPROXIMATELY 45 POUNDS WITH 1/2" PLASTIC NETTING.
 28. USE 2 - 1" x 2" STAKES PER BAG, DRIVEN 12-INCHES INTO GROUND.
 29. OVERLAP ENDS OF ADJACENT BAGS 6-INCHES TO PREVENT PIPING BETWEEN JOINTS.
 30. ROUTINELY INSPECT BAGS. CHECK THAT STAKES ARE SECURE, ENDS OF BAGS ARE OVERLAPPED AND PLASTIC MESH BAGS HAVE NO TEARS.
 31. REMOVE SEDIMENT WHEN IT HAS ACCUMULATED TO 1/3 HEIGHT OF BAG.

G:\PDX\Projects\07\0873\207 Design-Final Plans\CAD\DOR\07-0873-207-OR-G-3-G-5-R.dwg G-3 8/29/2011 11:21 AM DAK 18.1.s (LMS Tech)

NO.	DATE	BY	REVISION
A	08/22/11	BVO	RECORD DRAWING

NOTICE

0 1/2 1

IF THIS BAR DOES NOT MEASURE 1" THEN DRAWING IS NOT TO SCALE

SMG
DESIGNED

DAK
DRAWN

MLH
CHECKED

RECORD DRAWING

SEE DISCLAIMER, SHEET 1.

VERSION 4.1
12-9-97

MSA Murray Smith & Associates, Inc.
Engineers/Planners

121 S.W. Salmon, Suite 900 PHONE 503-225-9010
Portland, Oregon 97204 FAX 503-225-9022



WATER SUPPLY IMPROVEMENT PROJECT TRANSMISSION PIPELINE

**GENERAL NOTES/
EROSION CONTROL NOTES**

PROJECT NO.: 07-0873.207 SCALE: AS SHOWN DATE: JUNE 2009

SHEET

G-3

3 of 79

G:\PDX_Projects\07\0873\207 Design-Final Plans\CAD\07-0873-207-OR-G-4-R.dwg G-4 8/29/2011 11:32 AM DAK 18.1s (LMS Tech)

PIPE SYMBOLS

PLANT	SCHEMATIC	DESCRIPTION
		WELDED JOINT
		FLANGED JOINT
		GROOVED END JOINT
		MECHANICAL JOINT
		PUSH-ON JOINT (RUBBER GASKET)
		FLANGED COUPLING ADAPTER
		DOUBLE BALL FLEXIBLE EXTENSION COUPLING
		FLEXIBLE COUPLING W/THRUST RING
		ELBOW UP
		ELBOW DOWN
		TEE UP
		TEE DOWN
		LATERAL UP
		LATERAL DOWN
		CONCENTRIC REDUCER
		ECCENTRIC REDUCER
		UNION
		BLIND FLANGE
		CAP
		LONG SLEEVE
		FLEXIBLE COUPLING
		CAPPED END OR PLUGGED END FITTING

VALVE SYMBOLS

BURIED	PLANT	SCHEMATIC	DESCRIPTION
			BUTTERFLY VALVE
			GATE VALVE
			GLOBE VALVE
			BALL VALVE
			BALANCING VALVE
			DIAPHRAGM VALVE
			PLUG VALVE (TOP)
			PLUG VALVE (SIDE)
			3-WAY PLUG VALVE
			SWING CHECK VALVE
			DOUBLE CHECK ASSEMBLY
			BALL SWING CHECK
			SILENT CHECK VALVE
			PRESSURE REDUCING VALVE
			ALTITUDE CONTROL VALVE
			SOLENOID VALVE
			RELIEF VALVE
			NEEDLE VALVE
			HOSE VALVE
			REDUCED PRESSURE BACKFLOW PREVENTER W/GATE VALVES
			HOSE BIBB


TOPOGRAPHIC LEGEND & NOTES

	EXISTING	PROPOSED
WATERLINE		
FUTURE PIPELINE		
ELECTRICITY		
GAS		
TELEPHONE/TELEMETRY		
CABLE TELEVISION		
SANITARY SEWER LINE		
STORM DRAIN		
CULVERT		
ABANDON PIPE		
DRAINAGE DITCH		
BARBWIRE FENCE		
CHAIN LINK FENCE		
WOODEN FENCE		
ROCK WALL		
TREE/BUSH LINE		
CENTERLINE		
EASEMENT/PROPERTY LINE		
EDGE OF PAVEMENT/AC		
EDGE OF GRAVEL		
CURB		
SIDEWALK		
STRUCTURE OR FACILITY		
CONTOUR MINOR		
CONTOUR MAJOR		
ASPHALT DRIVEWAY		
GRAVEL DRIVEWAY		

TOPOGRAPHIC LEGEND & NOTES CONTINUE

	EXISTING	PROPOSED
MANHOLE		
CLEAN-OUT		
CATCH BASIN/FIELD INLET		
THRUST BLOCK		
VALVE		
AIR INJECTION ASSEMBLY		
PERMANENT BLOW-OFF ASSEMBLY		
TF500 BLOW-OFF ASSEMBLY		
TEMPORARY BLOW-OFF ASSEMBLY		
AIR RELEASE ASSEMBLY		
FIRE HYDRANT ASSEMBLY		
WATER METER		
BOLLARD		
PULL BOX/JUNCTION BOX		
CATHODIC PROTECTION TEST STATION		
INSULATION JOINT		
DISMANTLING JOINT		
UTILITY POLE		
GUY WIRE		
MAIL BOX		
SIGN		
BENCH MARK		
TREE DECIDUOUS		
TREE CONIFEROUS		
TREE TO BE REMOVED		
TREE TO BE PROTECTED WITH FENCING		

SECTION AND DETAIL DESIGNATIONS

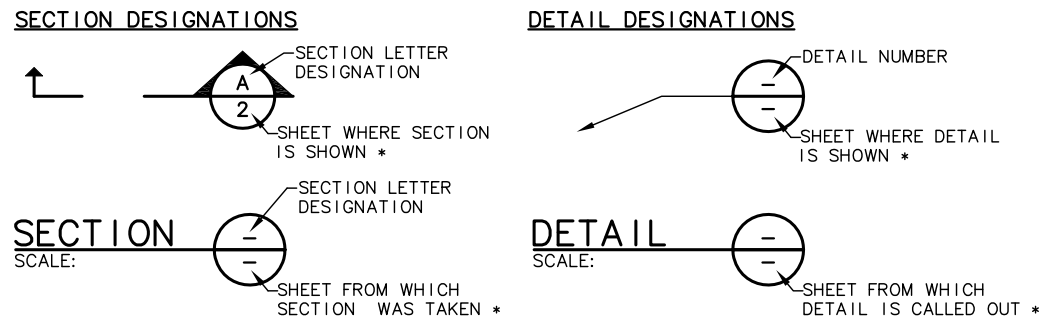

* NOTE: IF PLAN AND SECTION FOR DETAIL CALL-OUT AND DETAIL ARE SHOWN ON THE SAME DRAWING, DRAWING NUMBER IS REPLACED WITH A DASH.

MISCELLANEOUS PIPING SYMBOLS


	STRAINER
	SIGHT GLASS
	PRESSURE GAUGE W/COCK
	PRESSURE SWITCH W/COCK
	THERMOMETER
	ROTAMETER
	METER

CALLOUT SYMBOLS

	SLIP ON JOINT PIPE
	RESTRAINED JOINT PIPE
	COMPACTED NATIVE BACKFILL & NATIVE SURFACE RESTORATION
	COMPACTED GRANULAR BACKFILL & GRANULAR SURFACE RESTORATION
	COMPACTED GRANULAR BACKFILL & AC SURFACE RESTORATION

	LIGHT POST
	SURFACE ELEVATION
	FINAL GRADING SLOPES
	CARSONITE MARKER
	MANWAY VAULT
	TRENCH DAM

NOTICE

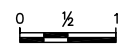

IF THIS BAR DOES NOT MEASURE 1" THEN DRAWING IS NOT TO SCALE

SMG
DESIGNED
DAK
DRAWN
MLH
CHECKED

RECORD DRAWING
SEE DISCLAIMER, SHEET 1.
VERSION 4.1
12-9-97



Murray Smith & Associates, Inc.
Engineers/Planners
121 S.W. Salmon, Suite 900 PHONE 503-225-9010
Portland, Oregon 97204 FAX 503-225-9022



WATER SUPPLY IMPROVEMENT PROJECT TRANSMISSION PIPELINE

SYMBOLS AND LEGEND

PROJECT NO.: 07-0873.207 SCALE: AS SHOWN DATE: JUNE 2009

SHEET

G-4

4 of 79

G:_PDX_Projects\07_0873\207_Design-Final_Plans\CAD\07-0873-207-OR-G-3-G-5-R.dwg G-5 8/29/2011 11:21 AM DAK 18.1s (LMS Tech)

<p>Ⓞ AASHTO AMERICAN ASSOCIATION OF STATE HIGHWAY & TRANSPORTATION OFFICIALS</p> <p>AB ANCHOR BOLT</p> <p>ABAN (D) ABANDON (ED)</p> <p>ABS ACRYLONITRILE BUTADIENE STYRENE</p> <p>ABV ABOVE</p> <p>AC ASPHALTIC CONCRETE</p> <p>ACI AMERICAN CONCRETE INSTITUTE</p> <p>ACP ASPHALTIC CONCRETE PAVING</p> <p>ADJ ADJUSTABLE</p> <p>ADJC ADJACENT</p> <p>ADPTR ADAPTOR</p> <p>AFF ABOVE FINISHED FLOOR</p> <p>AFG ABOVE FINISHED GRADE</p> <p>AHR ANCHOR</p> <p>AL ALUMINUM</p> <p>ALT ALTERNATE</p> <p>AMP AMPERE</p> <p>ANSI AMERICAN NATIONAL STANDARDS INSTITUTE</p> <p>APPROX APPROXIMATE</p> <p>APVVD APPROVED</p> <p>APWA AMERICAN PUBLIC WORKS ASSOCIATION</p> <p>ARCH ARCHITECTURAL</p> <p>ARV AIRE RELEASE VALVE</p> <p>ASCE AMERICAN SOCIETY OF CIVIL ENGINEERS</p> <p>ASSN ASSOCIATION</p> <p>ASSY ASSEMBLY</p> <p>ASTM AMERICAN SOCIETY FOR TESTING & MATERIALS</p> <p>ATM ATMOSPHERE</p> <p>AUTO AUTOMATIC</p> <p>AUX AUXILIARY</p> <p>AVE AVENUE</p> <p>AVG AVERAGE</p> <p>AWG AMERICAN WIRE GAUGE</p> <p>AWWA AMERICAN WATER WORKS ASSOCIATION</p> <p>B&S BELL & SPIGOT</p> <p>BC BOLT CIRCLE</p> <p>BD BOARD</p> <p>BTWN BETWEEN</p> <p>BF BOTH FACE</p> <p>BFD BACKFLOW PREVENTION DEVICE</p> <p>BFILL BACKFILL</p> <p>BFV BUTTERFLY VALVE</p> <p>BHP BRAKE HORSEPOWER</p> <p>BKGD BACKGROUND</p> <p>BLDG BUILDING</p> <p>BLK BLOCK</p> <p>BLVD BOULEVARD</p> <p>BM BENCH MARK / BEAM</p> <p>BMP BEST MANAGEMENT PRACTICE</p> <p>BO BLOWOFF</p> <p>BOC BACK OF CURB</p> <p>BS BOTH SIDES</p> <p>BSMT BASEMENT</p> <p>BTf BOTTOM FACE</p> <p>BTU BRITISH THERMAL UNIT</p> <p>BTWN BETWEEN</p> <p>BV BALL VALVE</p> <p>BW BOTH WAYS</p> <p>C CELSIUS</p> <p>CARV COMBINATION AIR RELEASE VALVE</p> <p>CATV CABLE TELEVISION</p> <p>CB CATCH BASIN</p> <p>CC CENTER TO CENTER</p> <p>CCP CONCRETE CYLINDER PIPE</p> <p>CCW COUNTER CLOCKWISE</p> <p>CFM CUBIC FEET PER MINUTE</p> <p>CFS CUBIC FEET PER SECOND</p> <p>CHAN CHANNEL</p> <p>CHEM CHEMICAL</p> <p>CHFR CHAMFER</p> <p>CHKV CHECK VALVE</p> <p>CI CAST IRON</p> <p>CIP CAST IRON PIPE</p> <p>CIPC CAST IN PLACE CONCRETE</p> <p>CIV CAST IRON VALVE</p> <p>CISP CAST IRON SOIL PIPE</p> <p>CJ CONSTRUCTION JOINT</p> <p>CL or Ⓞ CENTER LINE</p> <p>CL2 CHLORINE</p> <p>CLG CEILING</p> <p>CLJ CONTROL JOINT</p> <p>CLR CLEAR</p> <p>CLSM CONTROLLED LOW STRENGTH MATERIAL</p> <p>CMP CORRUGATED METAL PIPE</p> <p>CMU CONCRETE MASONRY UNIT</p> <p>CND CONDUIT</p> <p>CO CLEANOUT</p> <p>COL COLUMN</p> <p>COMB CONCRETE CONNECTION ANCHOR BOLT</p> <p>CONC CONSTRUCTION CONTINUOUS CONTRACT (OR) COORDINATE</p> <p>CONN CONNECTION ANCHOR BOLT</p> <p>CONST CONSTRUCTION CONTINUOUS CONTRACT (OR)</p> <p>CONT CONTINUOUS CONTRACT (OR)</p> <p>CONTR CONTRACT (OR)</p> <p>COORD COORDINATE</p> <p>COP COPPER</p> <p>CORP CORPORATION</p> <p>CORR CORRUGATED</p> <p>CP CONTROL POINT</p> <p>CPLG COUPLING</p> <p>CPVC CHLORINATED POLYVINYL CHLORIDE</p> <p>CR CRUSHED ROCK</p> <p>CS COMBINED SEWER</p> <p>CSP CONCRETE SEWER PIPE</p> <p>CT COURT</p> <p>CTR CENTER</p> <p>CU CUBIC</p> <p>CULV CULVERT</p> <p>CY CONTROL VALVE</p> <p>CW CLOCKWISE / COLD WATER</p> <p>CWS CLEAN WATER SERVICES</p> <p>CY CUBIC YARDS</p> <p>CYL CYLINDER LOCK</p> <p>D DRAIN</p> <p>DBL DOUBLE</p> <p>DC DIRECT CURRENT</p> <p>DEFL DEFLECTION</p> <p>DEG DEGREE</p> <p>DET DETAIL</p> <p>DI DUCTILE IRON</p> <p>DIA DIAMETER</p> <p>DIM DIMENSION</p> <p>DIR DIRECTION</p> <p>DIST DISTANCE</p> <p>DN DOWN</p> <p>DR DRIVE</p> <p>DS DOWNSPOUT</p> <p>DWL DRAWING</p> <p>DWV DRAIN WASTE AND VENT</p> <p>DWY DRIWEWAY</p> <p>E EAST</p> <p>EA EACH</p> <p>ECC ECCENTRIC</p> <p>EF EACH FACE</p> <p>EL ELEVATION</p> <p>E.G. EXAMPLE</p> <p>ELB ELBOW</p> <p>ELEC ELECTRICAL</p> <p>ENCL ENCLOSURE</p> <p>ENGR ENGINEER</p> <p>EOP EDGE OF PAVEMENT</p> <p>EQ or EQL EQUAL</p> <p>EQL SP EQUALLY SPACED</p> <p>EQUIP EQUIPMENT</p> <p>EW EACH WAY</p> <p>EXC EXCAVATE</p> <p>EXIST EXISTING</p> <p>EXIST GR EXISTING GRADE</p> <p>EXP EXPANSION</p> <p>EXP BT EXPANSION BOLT</p> <p>EXP JT EXPANSION JOINT</p> <p>EXT EXTERIOR</p> <p>F FAHRENHEIT</p> <p>F TO F FACE TO FACE</p> <p>FAB FABRICATE</p> <p>FB FLAT BAR</p> <p>FCA FLANGED COUPLING ADAPTER</p> <p>FCO FLOOR CLEANOUT</p> <p>FD FLOOR DRAIN</p> <p>FDN FOUNDATION</p> <p>FEXT FIRE EXTINGUISHER</p> <p>FF FAR FACE</p> <p>FGL FIBERGLASS</p> <p>FH FIRE HYDRANT</p> <p>FIN FL FINISH FLOOR</p> <p>FIN GR FINISH GRADE</p> <p>FIPT FEMALE IRON PIPE THREAD</p> <p>FITG FITTING</p> <p>FL FLOOR LINE</p> <p>FLEX FLEXIBLE</p> <p>FLG FLANGE</p> <p>FLL FLOW LINE</p> <p>FLR FLOOR</p> <p>FM FORCE MAIN</p> <p>FO FIBER OPTIC</p> <p>FOC FACE OF CONCRETE</p> <p>FOF FACE OF FINISH</p> <p>FOM FACE OF MASONRY</p> <p>FOS FACE OF STUDS</p> <p>FPM FEET PER MINUTE</p> <p>FPS FEET PER SECOND</p> <p>FRP FIBERGLASS REINFORCED PLASTIC</p> <p>FT FEET / FOOT</p> <p>FTG FOOTING</p> <p>FUT FUTURE</p> <p>FXTR FIXTURE</p> <p>G GAS</p> <p>GA GAUGE</p> <p>GAL GALLON</p> <p>GALV GALVANIZED</p> <p>GC GROOVED COUPLING</p> <p>GFA GROOVED FLANGE ADAPTER</p> <p>GI GALVANIZED IRON</p> <p>GIP GALVANIZED IRON PIPE</p> <p>GJ GRIP JOINT</p> <p>GL GLASS</p> <p>GLV GLOBE VALVE</p> <p>GND GROUND</p> <p>GPD GALLONS PER DAY</p> <p>GPH GALLONS PER HOUR</p> <p>GPM GALLONS PER MINUTE</p> <p>GPS GALLONS PER SECOND</p> <p>GR GRADE</p> <p>GR LN GRADE LINE</p> <p>GRTG GRATING</p> <p>GV GATE VALVE</p> <p>GRVL GRAVEL</p> <p>GYP GYPSUM</p> <p>HB HOSE BIBB</p> <p>HC HOLLOW CORE</p> <p>HDPE HIGH DENSITY POLYETHYLENE</p> <p>HDR HEADER</p> <p>HDWE HARDWARE</p> <p>HGR HANGER</p> <p>HGT HEIGHT</p> <p>HH HANDHOLD</p> <p>HM HOLLOW METAL</p> <p>HNDRL HAND RAIL</p> <p>HOA HAND-OFF-AUTO</p> <p>HOR HAND-OFF-REMOTE</p> <p>HORIZ HORIZONTAL</p> <p>HP HIGH PRESSURE / HORSEPOWER</p> <p>HPG HIGH PRESSURE GAS</p> <p>HPT HIGH POINT</p> <p>HR HOUR</p> <p>HSB HIGH STRENGTH BOLT</p> <p>HV HOSE VALVE</p> <p>HVAC HEATING, VENTILATION, AIR CONDITIONING</p> <p>HWL HIGH WATER LINE</p> <p>HWY HIGHWAY</p> <p>HYD HYDRANT</p> <p>HYDR HYDRAULIC</p> <p>I&C INSTRUMENTATION & CONTROL</p> <p>IAW IN ACCORDANCE WITH</p> <p>ID INSIDE DIAMETER</p> <p>IE INVERT ELEVATION</p> <p>IF INSIDE FACE</p> <p>IMPVT IMPROVEMENT</p> <p>IN INCH</p> <p>INCC INCLUDE (D) (ING)</p> <p>INFL INFLUENT</p> <p>INJ INJECTION</p> <p>INSTL INSTALLATION / INSTALL</p> <p>INSUL INSULATION</p> <p>INTER INTERCEPTOR</p> <p>INTR INTERIOR</p> <p>INV INVERT</p> <p>IP IRON PIPE</p> <p>IPT IRON PIPE THREAD</p> <p>IR IRON ROD</p> <p>IRRIG IRRIGATION</p> <p>JT JOINT</p> <p>JUNC JUNCTION</p> <p>KPL KICK PLATE</p> <p>KVA KILOVOLT AMPERE</p> <p>KW KILOWATT</p> <p>KWY KEYWAY</p> <p>L LENGTH OF CURVE</p> <p>LAB LABORATORY</p> <p>LAT LATERAL</p> <p>LAV LAVATORY</p> <p>LB POUND</p> <p>LF LINEAL FOOT</p> <p>LIN LINEAL / LINEAR</p> <p>LN LANE</p> <p>LOC LOCATION</p> <p>LONG LONGITUDINAL</p> <p>LP LOW PRESSURE</p> <p>LPT LOW POINT</p> <p>LRG LARGE</p> <p>LS LONG SLEEVE / LUMP SUM</p> <p>LT LEFT</p> <p>LVL LEVEL</p> <p>LWL LOW WATER LINE</p> <p>MAN MANUAL</p> <p>MATL MATERIAL</p> <p>MAX MAXIMUM</p> <p>MB MAIL BOX</p> <p>MCC MOTOR CONTROL CENTER</p> <p>MCP MASTER CONTROL PANEL</p> <p>MECH MECHANICAL</p> <p>MET METAL</p> <p>MFR MANUFACTURER</p> <p>MGD MILLION GALLONS PER DAY</p> <p>MH MANHOLE</p> <p>MIN MINIMUM</p> <p>MIPT MALE IRON PIPE THREAD</p> <p>MISC MISCELLANEOUS</p> <p>MJ MECHANICAL JOINT</p> <p>MON MONUMENT / MONOLITHIC</p> <p>MOT MOTOR</p> <p>MP MILEPOST</p> <p>MSL MEAN SEA LEVEL</p> <p>MTD MOUNTED</p> <p>MUTCD MOUNTED ON UNIFORM TRAFFIC CONTROL DEFICES</p> <p>N NORTH</p> <p>NA NOT APPLICABLE</p> <p>NC NORMALLY CLOSED</p> <p>NF NEAR FACE</p> <p>NIC NOT IN CONTRACT</p> <p>NO / NO. NORMALLY OPEN / NUMBER</p> <p>NOM NOMINAL</p> <p>NORM NORMAL</p> <p>NP NON PAVE</p> <p>NRS NON-RISING STEM</p> <p>NTS NOT TO SCALE</p> <p>O TO O OUT TO OUT</p> <p>OC ON CENTER</p> <p>OD OUTSIDE DIAMETER</p> <p>ODOT OREGON DEPARTMENT OF TRANSPORTATION</p> <p>OF OVERFLOW / OUTSIDE FACE</p> <p>OPNG OPENING</p> <p>OPP OPPOSITE</p> <p>ORIG ORIGINAL</p> <p>OSHA OCCUPATIONAL SAFETY AND HEALTH ADMINISTRATION</p> <p>OVHD OVERHEAD</p> <p>P&ID PROCESS & INSTRUMENTATION DIAGRAM</p> <p>PC POINT OF CURVE</p> <p>PCC POINT OF COMPOUND CURVE</p> <p>PCVC POINT OF CURVATURE ON VERTICAL CURVE</p> <p>PE PLAIN END</p> <p>PERF PERFORATED</p> <p>PERM PERMANENT</p> <p>PERP PERPENDICULAR</p> <p>PG PRESSURE GAGE</p> <p>PGE PORTLAND GENERAL ELECTRIC</p> <p>PH PIPE HANGER</p> <p>PI POINT OF INTERSECTION</p> <p>PIVC POINT OF INTERSECTION ON VERTICAL CURVE</p> <p>PL or PL PROPERTY LINE / PLATE / PLASTIC</p> <p>PLBG PLUMBING</p> <p>PNL PANEL</p> <p>PNC POINT ON CURVE</p> <p>POLY POLYETHYLENE</p> <p>POT POINT ON TANGENCY</p> <p>PP POWER POLE</p> <p>PRC POINT OF REVERSE CURVE</p> <p>PRCST PRECAST</p> <p>PREP PREPARATION</p> <p>PRESS PRESSURE</p> <p>PRKG PARKING</p> <p>PROP PROPERTY</p> <p>PRV PRESSURE REDUCING VALVE</p> <p>PS PUMP STATION</p> <p>PSI POUNDS PER SQUARE INCH</p> <p>PSIG POUNDS PER SQUARE INCH GAGE</p> <p>PSL PIPE SLEEVE</p> <p>PSPT PIPE SUPPORT</p> <p>PT POINT OF TANGENCY</p> <p>PTVC POINT OF TANGENCY ON VERTICAL CURVE</p> <p>PV PLUG VALVE</p> <p>PVC POLYVINYL CHLORIDE</p> <p>PVMT PAVEMENT</p> <p>PWR POWER</p> <p>QTY QUANTITY</p> <p>RAD RADIUS</p> <p>RC REINFORCED CONCRETE</p> <p>RCP REINFORCED CONCRETE PIPE</p> <p>RD ROAD / ROOF DRAIN</p> <p>RDCR REDUCER</p> <p>REF REFERENCE</p> <p>REINF REINFORCE (D) (ING) (MENT)</p> <p>REQD or REQ'D REQUIRED</p> <p>RESTR RESTRAINED</p> <p>RFC A RESTRAINED FLANGE COUPLING ADAPTER</p> <p>RM ROOM</p> <p>RND ROUND</p> <p>RO ROUGH OPENING</p> <p>ROW or R/W RIGHT OF WAY</p> <p>RPPBD REDUCED PRESSURE BACKFLOW PREVENTION DEVICE</p> <p>RPM REVOLUTIONS PER MINUTE</p> <p>RR RAILROAD</p> <p>RST REINFORCING STEEL</p> <p>RT RIGHT</p> <p>S SOUTH</p> <p>SALV SALVAGE</p> <p>SAN SANITARY</p> <p>SC SOLID CORE</p> <p>SCH(ED) SCHEDULE</p> <p>SDL SADDLE</p> <p>SDMH STORM DRAIN MANHOLE</p> <p>SDR STANDARD DIMENSION RATIO</p> <p>SECT SECTION</p> <p>SHLDR SHOULDER</p> <p>SHT SHEET</p> <p>SIM SIMILAR</p> <p>SLP SLOPE</p> <p>SLV SLEEVE</p> <p>SOLN SOLUTION</p> <p>SP SOIL PIPE / SEWER PIPE</p> <p>SPCL SPECIAL</p> <p>SPEC (S) SPECIFICATION (S)</p> <p>SPG SPACING</p> <p>SPL SPOOL</p> <p>SPRT SUPPORT</p> <p>SQ SQUARE</p> <p>SQ FT SQUARE FOOT</p> <p>SQ IN SQUARE INCH</p> <p>SQ YD SQUARE YARD</p> <p>SS SANITARY SEWER</p> <p>SST STAINLESS STEEL</p> <p>ST STREET</p> <p>STA STATION</p> <p>STDS STANDARD</p> <p>STL STEEL</p> <p>STOR STORAGE</p> <p>STR STRAIGHT</p> <p>STRUCT STRUCTURE / STRUCTURAL</p> <p>SUBMG SUBMERGED</p> <p>SUCT SUCTION</p> <p>SV SOLENOID VALVE</p> <p>SVC SERVICE</p> <p>SW SOUTHWEST</p> <p>S/W SIDEWALK</p> <p>SWD SIDEWATER DEPTH</p> <p>SWGR SWITCH GEAR</p> <p>SYMM SYMMETRICAL</p> <p>SYS SYSTEM</p> <p>T TANGENT</p> <p>T&B TOP & BOTTOM</p> <p>TB THRUST BLOCK</p> <p>TBM TEMPORARY BENCH MARK</p> <p>TC TOP OF CONCRETE / TOP OF CURB</p> <p>TDH TOTAL DYNAMIC HEAD</p> <p>TEL TELEPHONE</p> <p>TEMP TEMPERATURE / TEMPORARY</p> <p>T&G TONGUE & GROOVE</p> <p>THK THICKNESS</p> <p>THRD THREAD(ED)</p> <p>THRU THROUGH</p> <p>TP TEST PIT/TOP OF PAVEMENT/TURNING POINT</p> <p>TRANS TRANSITION</p> <p>TSP TRI-SODIUM PHOSPHATE</p> <p>TST TOP OF STEEL</p> <p>TTO TANGENTIAL TURN OUT</p> <p>TVWD TUALATIN VALLEY WATER DISTRICT</p> <p>TW TOP OF WALL</p> <p>TYP TYPICAL</p> <p>UG UNDERGROUND</p> <p>UH UNIT HEATER</p> <p>UN UNION</p> <p>UON UNLESS OTHERWISE NOTED</p> <p>US UNITED STATES</p> <p>USGS UNITED STATES GEOLOGIC SURVEY</p> <p>V VENT / VOLT</p> <p>VAC VACUUM</p> <p>VB VACUUM BREAKER</p> <p>VBOX VALVE BOX</p> <p>VC VERTICAL CURVE</p> <p>VERT VERTICAL</p> <p>VFD VARIABLE FREQUENCY DRIVE</p> <p>VLT VAULT</p> <p>VB VERTICAL BEND</p> <p>VCP VITRIFIED CLAY PIPE</p> <p>VOL VOLUME</p> <p>VTR VENT THROUGH ROOF</p> <p>W WEST</p> <p>W/ WITH</p> <p>W/O WITHOUT</p> <p>W/W WALL TO WALL</p> <p>WD WOOD</p> <p>WF WIDE FLANGE</p> <p>WH WALL HYDRANT</p> <p>WHTR WATER HEATER</p> <p>WI WROUGHT IRON</p> <p>WM WATER METER</p> <p>WP WORKING POINT / WATERPROOFING</p> <p>WS WATER SERVICE</p> <p>WSDOT WASHINGTON STATE DEPARTMENT OF TRANSPORTATION</p> <p>WT WEIGHT</p> <p>WTP WATER TREATMENT PLANT</p> <p>WTR WATER</p> <p>WES WATER ENVIRONMENT SERVICES</p> <p>WTRT WATERTIGHT</p> <p>WWF WELDED WIRE FABRIC</p> <p>WWTF WASTEWATER TREATMENT FACILITY</p> <p>WWTP WASTEWATER TREATMENT PLANT</p> <p>X SECT CROSS SECTION</p> <p>XFMR TRANSFORMER</p> <p>YD YARD DRAIN/YARD</p> <p>YH YARD HYDRANT</p> <p>YR YEAR</p> <p>ZN ZINC</p>

NO.	DATE	BY	REVISION
1	08/22/11	BVO	RECORD DRAWING

NOTICE

0 1/2 1

IF THIS BAR DOES NOT MEASURE 1" THEN DRAWING IS NOT TO SCALE

SMG DESIGNED
DAK DRAWN
MLH CHECKED

RECORD DRAWING

SEE DISCLAIMER, SHEET 1.

VERSION 4.1
12-9-97

MSA Murray Smith & Associates, Inc.
Engineers/Planners

121 S.W. Salmon, Suite 900
Portland, Oregon 97204

PHONE 503-225-9010
FAX 503-225-9022

WATER SUPPLY IMPROVEMENT PROJECT TRANSMISSION PIPELINE

City of Sherwood Oregon

ABBREVIATIONS


PROJECT NO.: 07-0873.207 SCALE: AS SHOWN DATE: JUNE 2009

SHEET

G-5

5 of 79

G:\PDX\Projects\07-0873\207 Design-Final Plans\CAD\07-0873-207-OR-G6-G7-R.dwg G-6 8/29/2011 12:00 PM DAK 18.1s (LMS Tech)

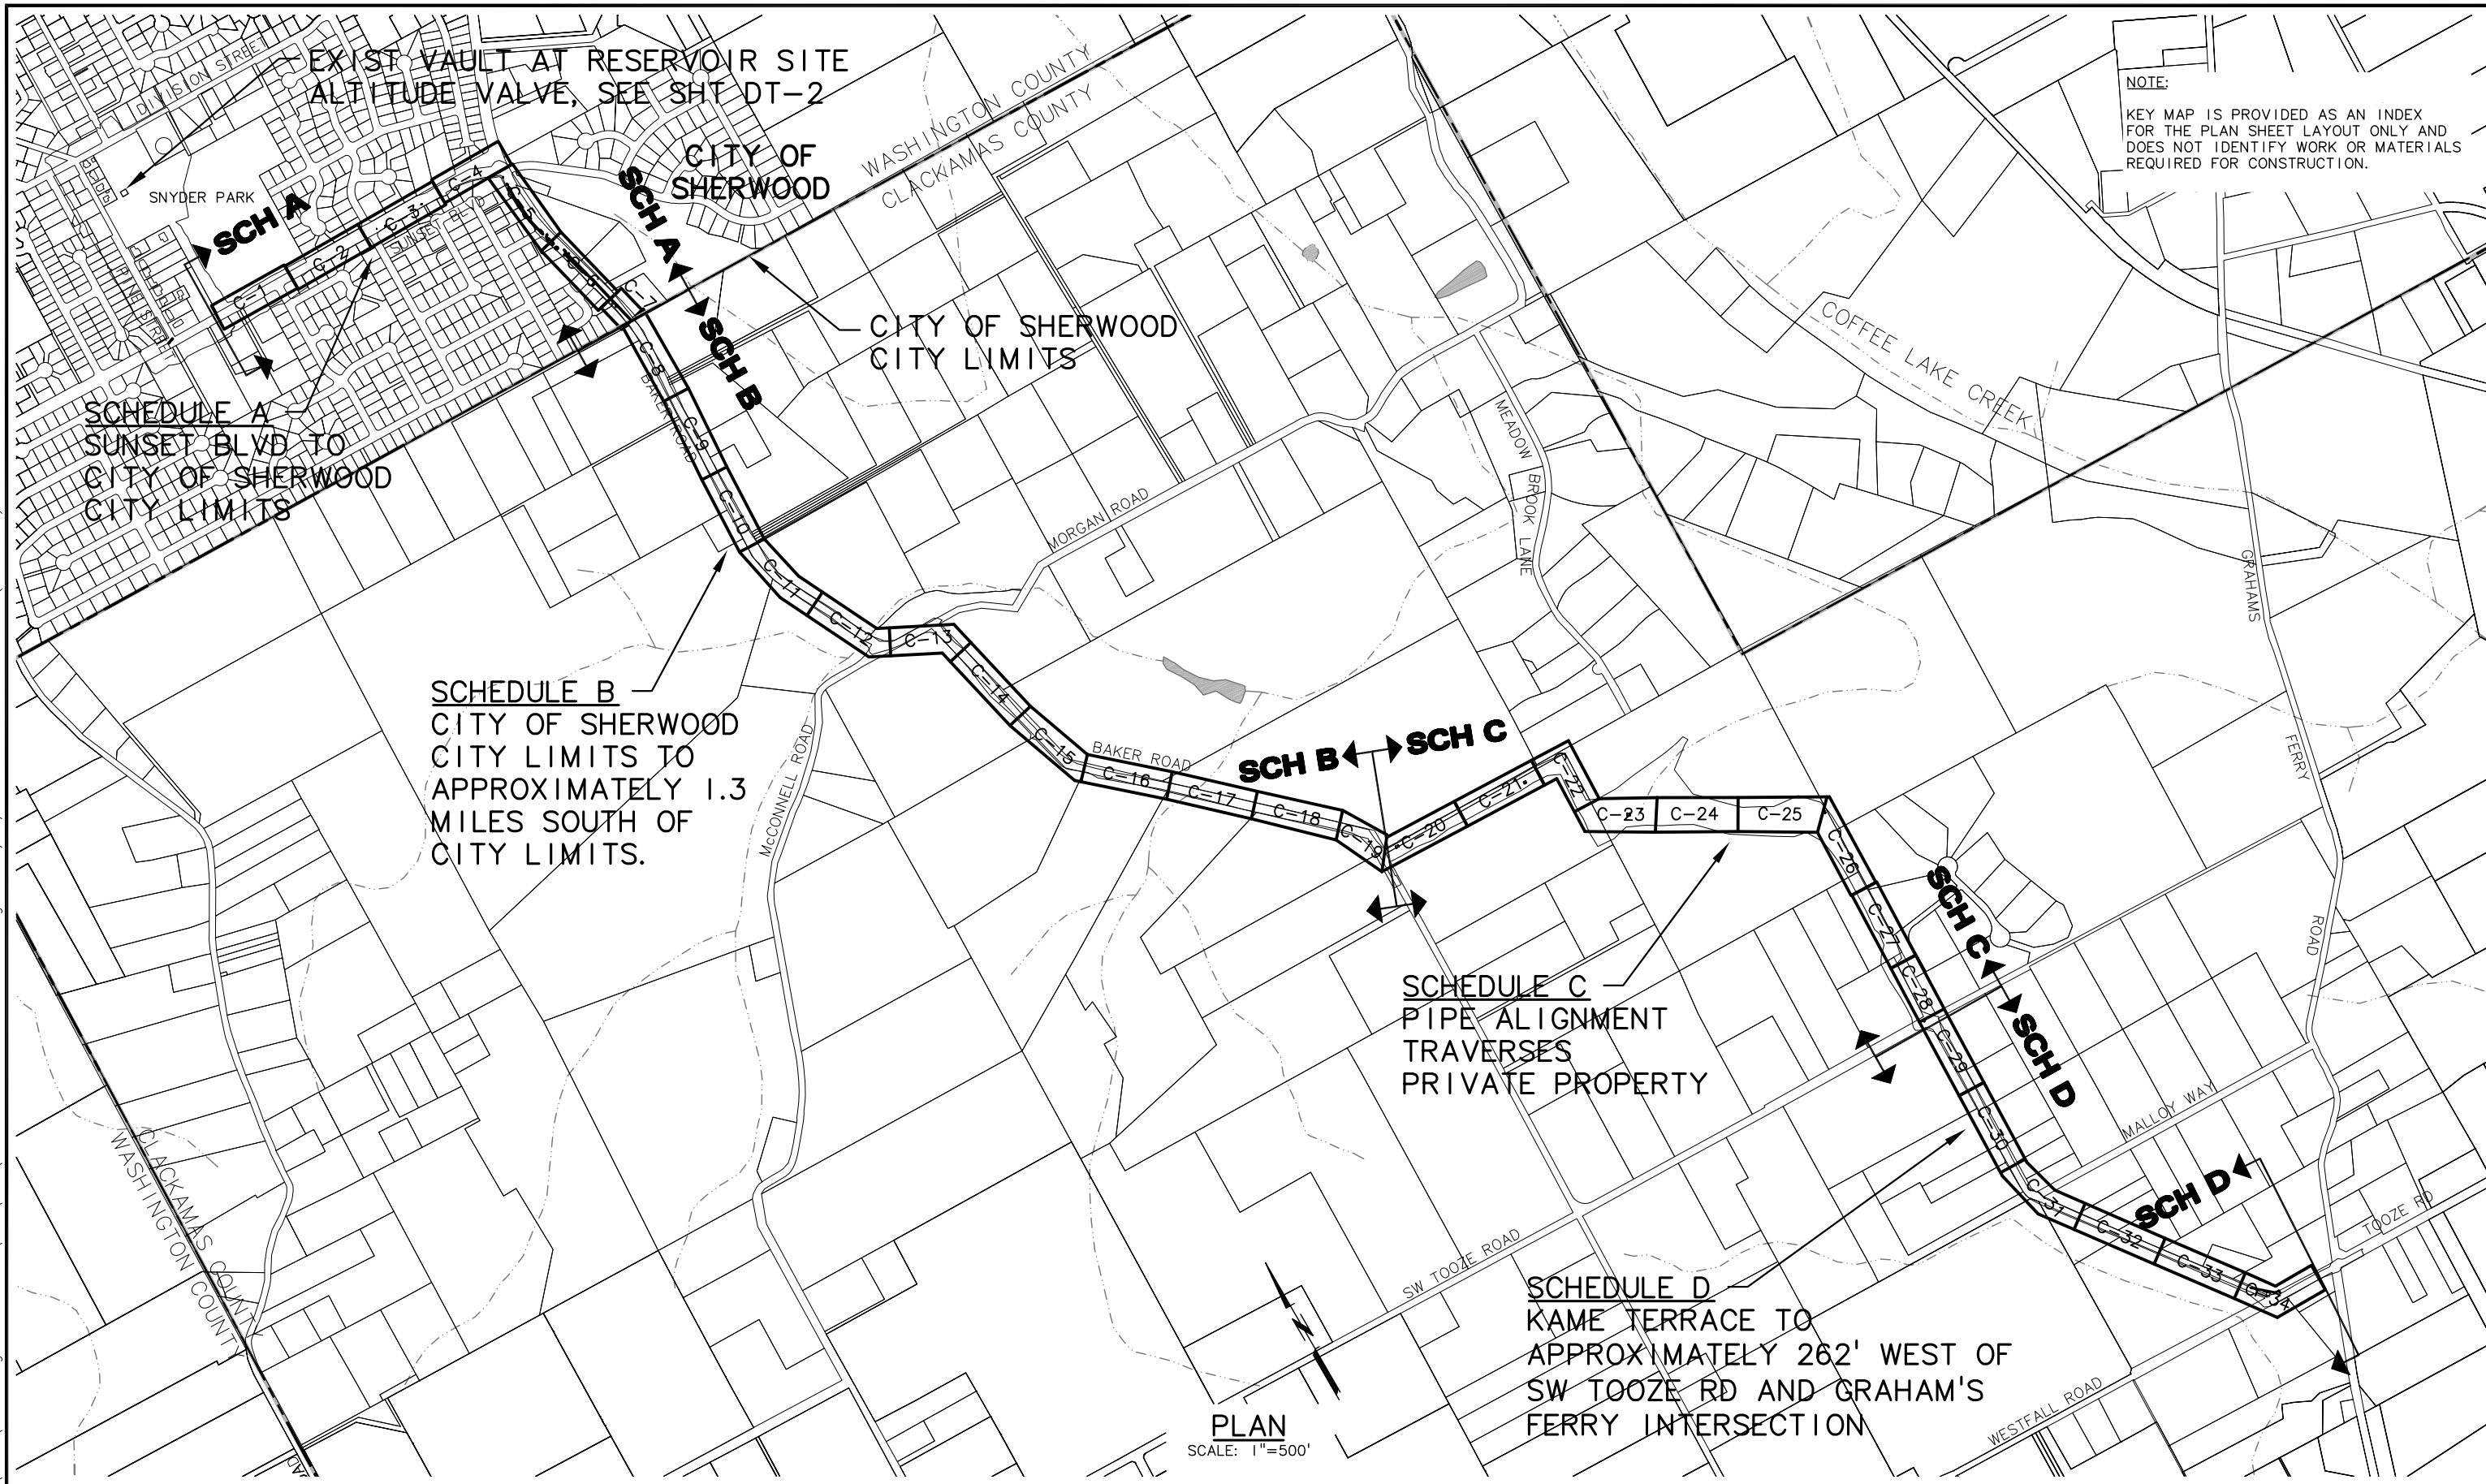

NOTE:
KEY MAP IS PROVIDED AS AN INDEX FOR THE PLAN SHEET LAYOUT ONLY AND DOES NOT IDENTIFY WORK OR MATERIALS REQUIRED FOR CONSTRUCTION.

EXIST VULT AT RESERVOIR SITE
ALTITUDE VALVE, SEE SHT DT-2

SCHEDULE B
CITY OF SHERWOOD
CITY LIMITS TO
APPROXIMATELY 1.3
MILES SOUTH OF
CITY LIMITS.

SCHEDULE C
PIPE ALIGNMENT
TRAVERSES
PRIVATE PROPERTY

SCHEDULE D
KAME TERRACE TO
APPROXIMATELY 262' WEST OF
SW TOOZE RD AND GRAHAM'S
FERRY INTERSECTION

PLAN
SCALE: 1"=500'

NO.	DATE	BY	REVISION
1	08/22/11	BVO	RECORD DRAWING

NOTICE
0 1/2 1
IF THIS BAR DOES NOT MEASURE 1" THEN DRAWING IS NOT TO SCALE

SMG DESIGNED
DAK DRAWN
MLH CHECKED

RECORD DRAWING
SEE DISCLAIMER, SHEET 1.
VERSION 4.1
12-9-97

MSA Murray Smith & Associates, Inc.
Engineers/Planners
121 S.W. Salmon, Suite 900 PHONE 503-225-9010
Portland, Oregon 97204 FAX 503-225-9022




WATER SUPPLY IMPROVEMENT PROJECT TRANSMISSION PIPELINE

PLAN SHEET KEY MAP
PROJECT NO.: 07-0873.207 SCALE: AS SHOWN DATE: JUNE 2009

SHEET
G-6
6 of 79

G:_PDX_Projects\07\0873\207 Design-Final Plans\CAD\07-0873-207-OR-G6-G7-R.dwg G-7 8/29/2011 12:00 PM DAK 18.1s (LMS Tech)

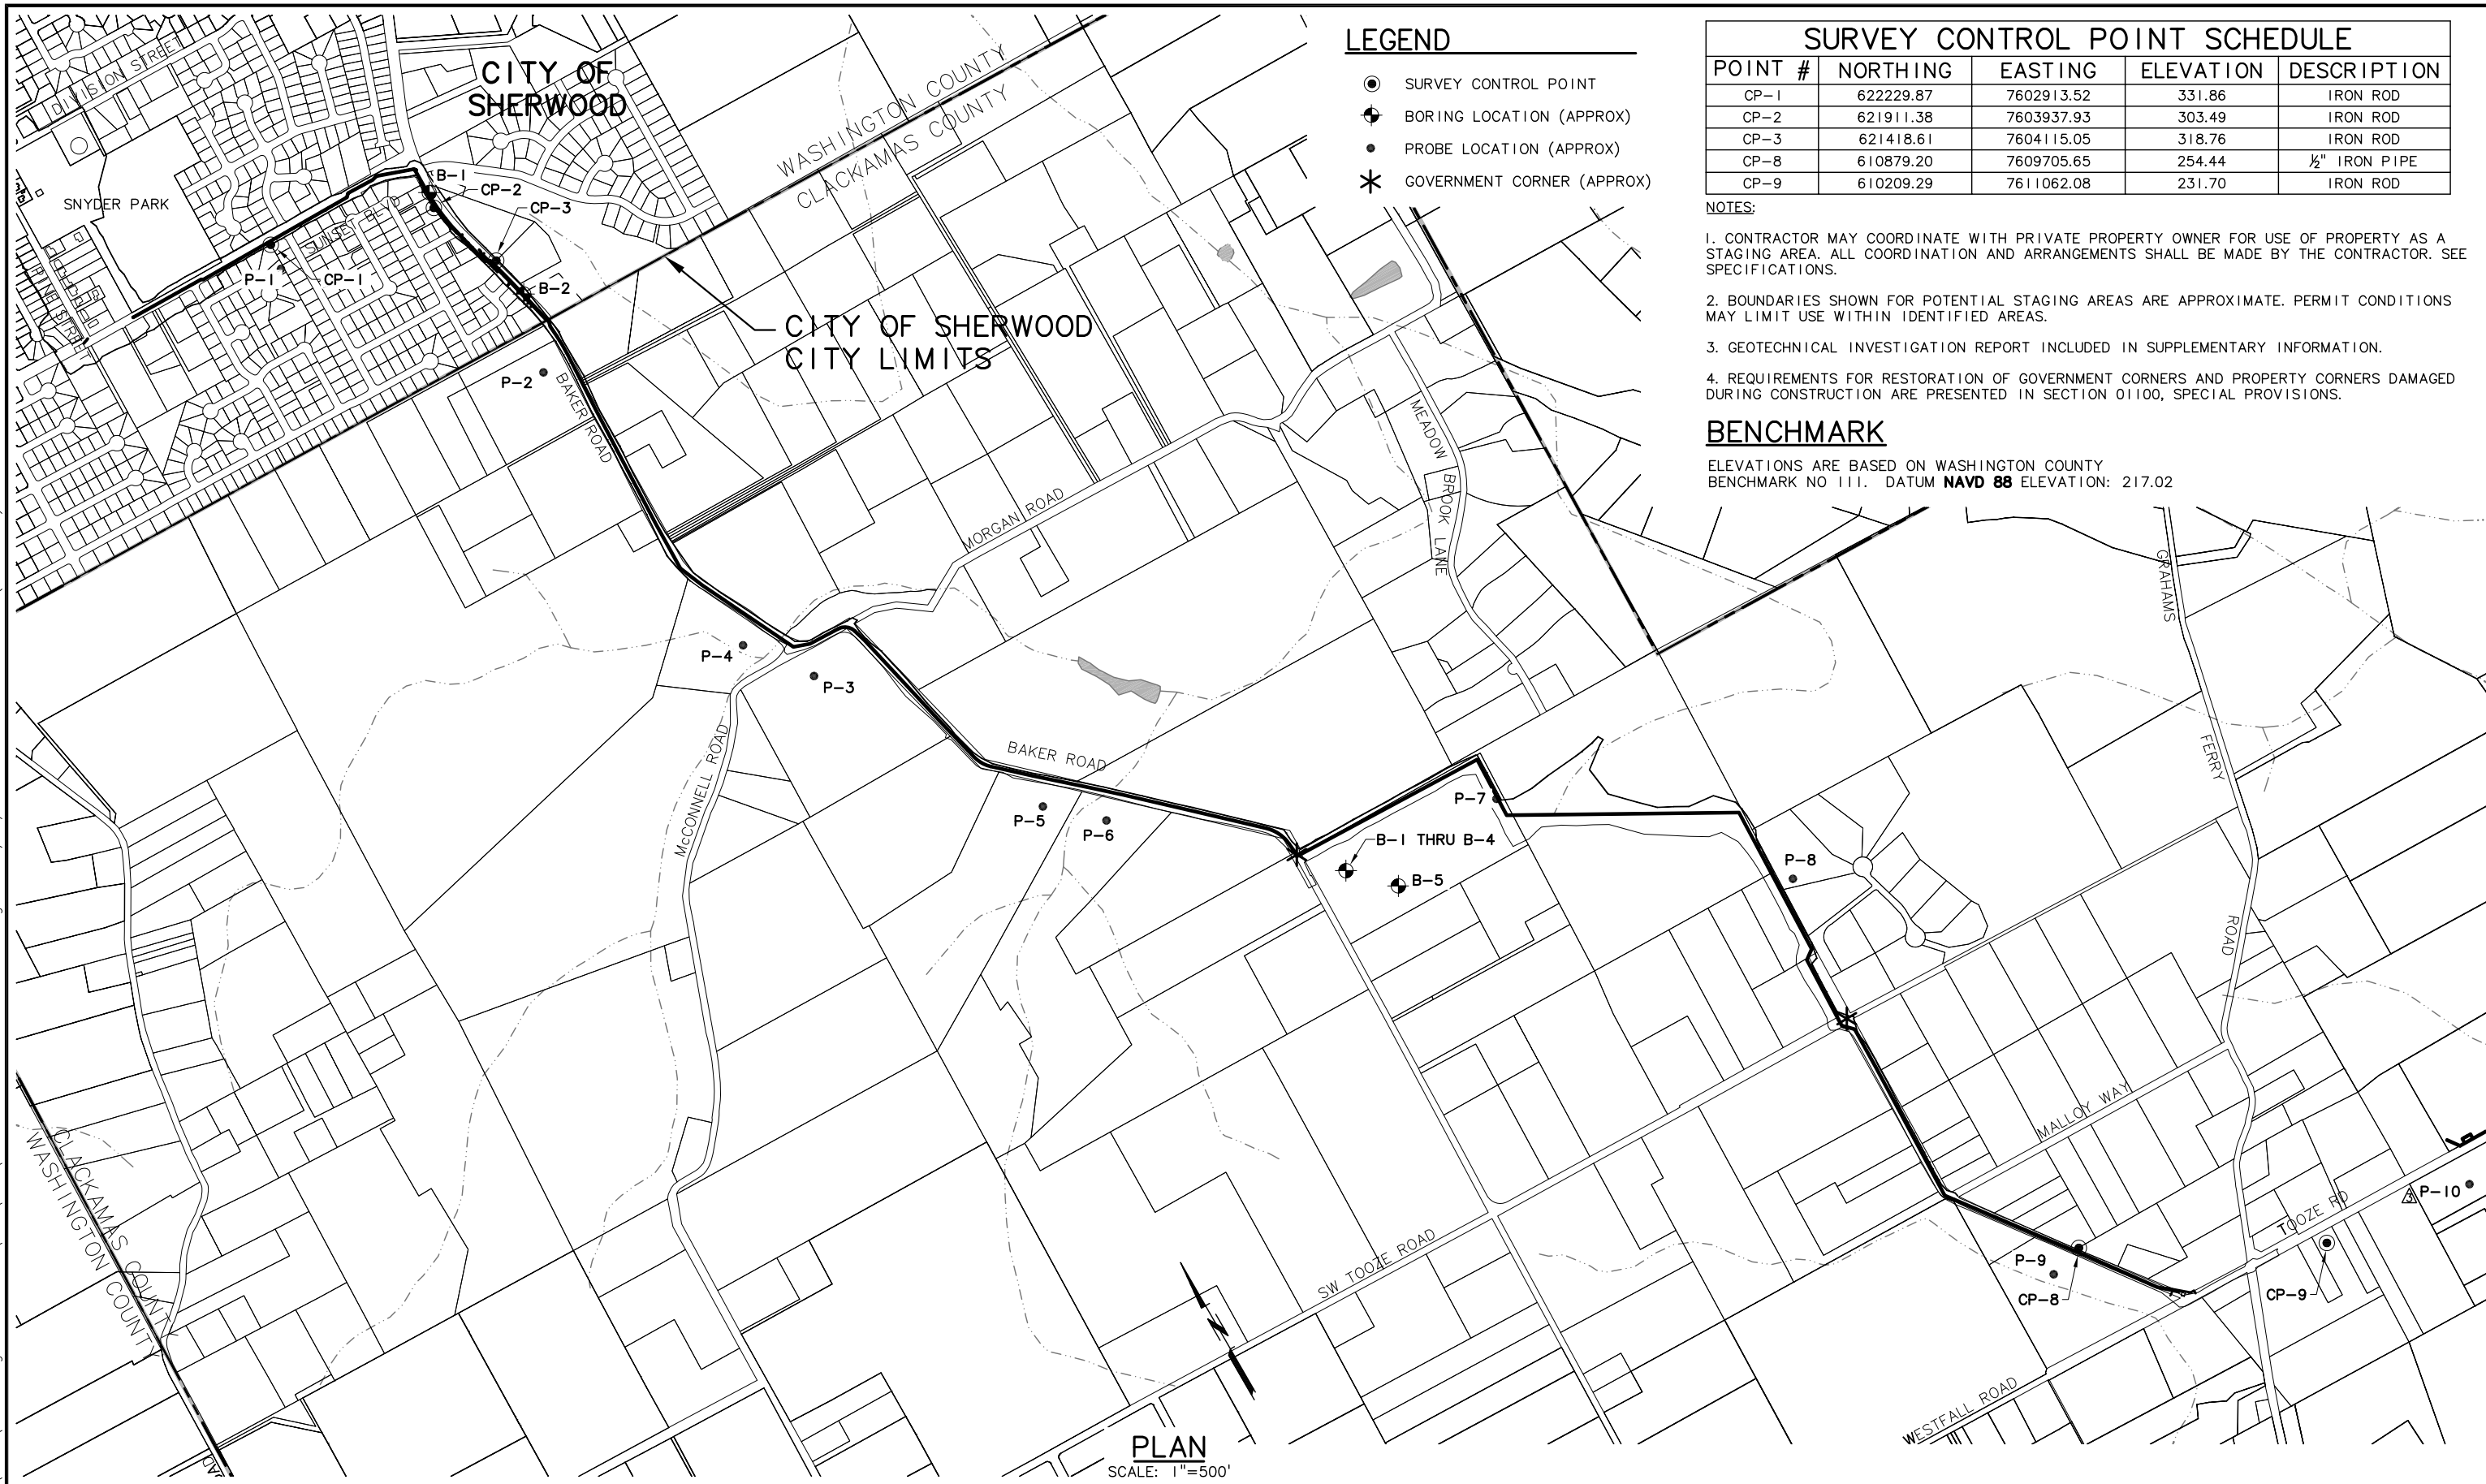

LEGEND

- SURVEY CONTROL POINT
- ⊕ BORING LOCATION (APPROX)
- PROBE LOCATION (APPROX)
- * GOVERNMENT CORNER (APPROX)

SURVEY CONTROL POINT SCHEDULE

POINT #	NORTHING	EASTING	ELEVATION	DESCRIPTION
CP-1	622229.87	7602913.52	331.86	IRON ROD
CP-2	621911.38	7603937.93	303.49	IRON ROD
CP-3	621418.61	7604115.05	318.76	IRON ROD
CP-8	610879.20	7609705.65	254.44	1/2" IRON PIPE
CP-9	610209.29	7611062.08	231.70	IRON ROD

NOTES:

1. CONTRACTOR MAY COORDINATE WITH PRIVATE PROPERTY OWNER FOR USE OF PROPERTY AS A STAGING AREA. ALL COORDINATION AND ARRANGEMENTS SHALL BE MADE BY THE CONTRACTOR. SEE SPECIFICATIONS.
2. BOUNDARIES SHOWN FOR POTENTIAL STAGING AREAS ARE APPROXIMATE. PERMIT CONDITIONS MAY LIMIT USE WITHIN IDENTIFIED AREAS.
3. GEOTECHNICAL INVESTIGATION REPORT INCLUDED IN SUPPLEMENTARY INFORMATION.
4. REQUIREMENTS FOR RESTORATION OF GOVERNMENT CORNERS AND PROPERTY CORNERS DAMAGED DURING CONSTRUCTION ARE PRESENTED IN SECTION 01100, SPECIAL PROVISIONS.

BENCHMARK

ELEVATIONS ARE BASED ON WASHINGTON COUNTY BENCHMARK NO 111. DATUM **NAVD 88** ELEVATION: 217.02

PLAN
SCALE: 1"=500'

NO.	DATE	BY	REVISION
3	08/22/11	BVO	RECORD DRAWING

NOTICE
0 1/2 1
IF THIS BAR DOES NOT MEASURE 1" THEN DRAWING IS NOT TO SCALE

SMG DESIGNED
DAK DRAWN
MLH CHECKED

RECORD DRAWING
SEE DISCLAIMER, SHEET 1.
VERSION 4.1
12-9-97

MSA Murray Smith & Associates, Inc.
Engineers/Planners
121 S.W. Salmon, Suite 900 PHONE 503-225-9010
Portland, Oregon 97204 FAX 503-225-9022




WATER SUPPLY IMPROVEMENT PROJECT TRANSMISSION PIPELINE


SURVEY CONTROL / GEOTECHNICAL EXPLORATION
PROJECT NO.: 07-0873.207 SCALE: AS SHOWN DATE: JUNE 2009

SHEET **G-7**
7 of 79

EROSION AND SEDIMENT CONTROL PLANS

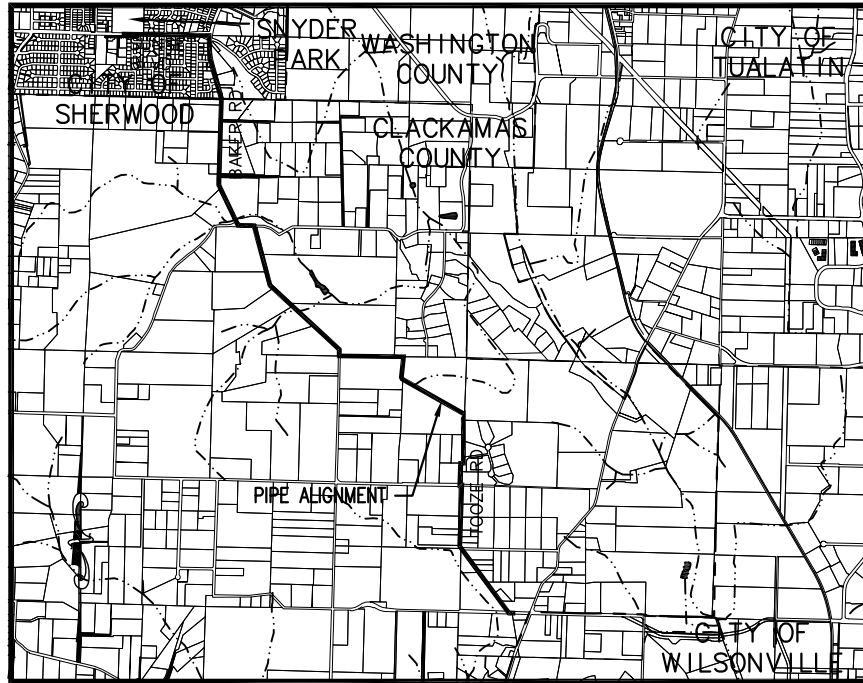

SITE MAP
SCALE: 1"=2000'

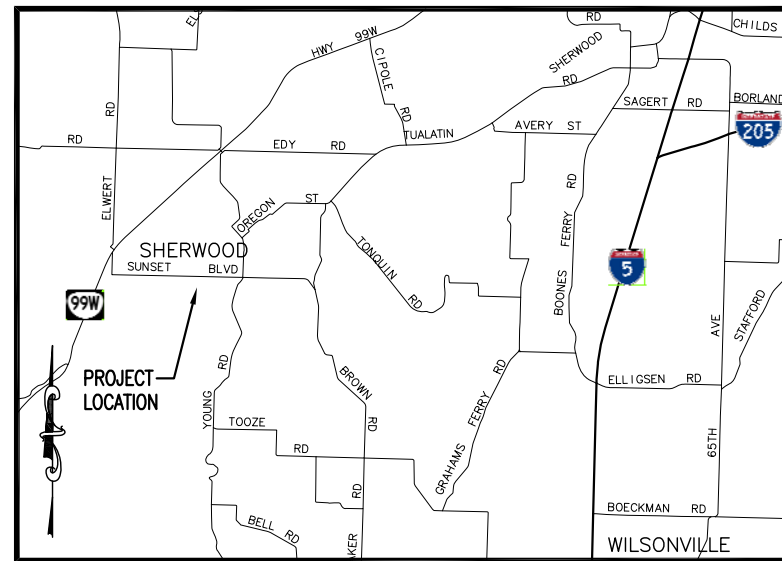

VICINITY MAP
SCALE: 1"=5000'

PROJECT LOCATION:

15365 SW SUNSET BLVD., SHERWOOD, WASHINGTON COUNTY, OREGON
LATITUDE = 45° 21' 07" N, LONGITUDE = 122° 50' 03" W

PROPERTY DESCRIPTION:

TAX LOT TL 21W320B 0088-10
LOCATED IN THE SOUTHWEST CORNER OF NW 1/4 SECTION 32 T2S R1W WILLAMETTE MERIDIAN, WASHINGTON COUNTY, OREGON

ATTENTION EXCAVATORS:

OREGON LAW REQUIRES YOU TO FOLLOW RULES ADOPTED BY THE OREGON UTILITY NOTIFICATION CENTER. THOSE RULES ARE SET FORTH IN OAR 952-001-0010 THROUGH OAR 952-001-0090. YOU MAY OBTAIN COPIES OF THESE RULES FROM THE CENTER BY CALLING 503-232-1987. IF YOU HAVE ANY QUESTIONS ABOUT THE RULES, YOU MAY CONTACT THE CENTER. YOU MUST NOTIFY THE CENTER AT LEAST TWO BUSINESS DAYS, BEFORE COMMENCING AN EXCAVATION. CALL 503-246-6699.

DEVELOPER NAME

CITY OF SHERWOOD
CONTACT: TOM PESSEMIER, P.E.
22560 SW PINE STREET
SHERWOOD, OR 97140
PHONE: (503) 625-5522
FAX: (503) 625-0629

PLANNING / ENGINEERING / SURVEYING FIRM

MURRAY, SMITH & ASSOCIATES
CONTACT: MATT L. HICKEY, P.E.
121 SW SALMON (SUITE 900)
PORTLAND, OR 97204
PHONE: (503) 225-9010
FAX: (503) 225-9022

NARRATIVE DESCRIPTIONS

EXISTING SITE CONDITIONS

* CLACKAMAS COUNTY, WASHINGTON COUNTY & CITY OF SHERWOOD ROADWAY AND RIGHT-OF-WAY

DEVELOPED CONDITIONS

* BURIED 48" DIAMETER STEEL PIPELINE WATER SYSTEM IMPROVEMENTS, ROADWAY

NATURE OF CONSTRUCTION ACTIVITY AND ESTIMATED TIME TABLE

- * CLEARING (APRIL 1ST, 2009 - APRIL 15TH, 2009)
- * MASS GRADING (APRIL 15TH, 2009 - MAY 15TH, 2009)
- * UTILITY INSTALLATION (APRIL 15TH, 2009 - FEBRUARY 15TH, 2010)
- * RESERVOIR / PUMP STATION CONSTRUCTION (JUNE 15TH, 2011 - MARCH 1ST, 2012)
- * STREET CONSTRUCTION (MAY 1ST, 2009 - JULY 15TH, 2009)
- * FINAL TANK START UP (MARCH 15TH, 2012 - APRIL 1ST, 2012)
- * FINAL GRADING (JUNE 1ST, 2012 - AUGUST 1ST, 2012)
- * FINAL STABILIZATION (AUGUST 2ND - SEPTEMBER 30TH)

TOTAL SITE AREA = 1,010,700 SF = 23.2 ACRES

TOTAL DISTURBED AREA = 152,500 SF = 3.5 ACRES

SITE SOIL CLASSIFICATION:

11C - CORNELIUS AND KINTON SILT LOAMS 7 TO 12%

ON-SITE SOILS HAVE A MODERATE EROSION POTENTIAL. UTILITY TRENCH AND SUBGRADE MATERIAL SHALL BE APPROVED CRUSHED ROCK FROM AN APPROVED SOURCE.

RECEIVING WATER BODIES:

ROCK CREEK

PERMITTEE'S SITE INSPECTOR:

DAVE SADLER
COMPANY/AGENCY: CITY OF SHERWOOD / HOPPER DENNIS JELLISSON
PHONE: 503-572-3425
FAX: 503-625-0679
E-MAIL: sdph@hjdjengineers.com

DESCRIPTION OF EXPERIENCE: 22 YEARS OF ODOT CONSTRUCTION AND EROSION CONTROL INSPECTION EXPERIENCE, 7 YEARS AS CITY CONSTRUCTION INSPECTOR, MULTIPLE EPSC CERTIFICATE HOURS.

INSPECTION FREQUENCY:

SITE CONDITION	MINIMUM FREQUENCY
1. ACTIVE PERIOD	DAILY WHEN STORMWATER RUNOFF, INCLUDING RUNOFF FROM SNOWMELT, IS OCCURRING.
2. PRIOR TO THE SITE BECOMING INACTIVE OR IN ANTICIPATION OF SITE INACCESSIBILITY.	ONCE TO ENSURE THAT EROSION AND SEDIMENT CONTROL MEASURES ARE IN WORKING ORDER. ANY NECESSARY MAINTENANCE AND REPAIR MUST BE MADE PRIOR TO LEAVING THE SITE.
3. INACTIVE PERIODS GREATER THAN SEVEN (7) CONSECUTIVE CALENDAR DAYS.	ONCE EVERY TWO (2) WEEKS.
4. PERIODS DURING WHICH THE SITE INACCESSIBLE DUE TO INCLEMENT WEATHER.	IF PRACTICAL, INSPECTIONS MUST OCCUR DAILY AT A RELEVANT AND ACCESSIBLE DISCHARGE POINT OR DOWNSTREAM LOCATION.

- * HOLD A PRE-CON MEETING OF PROJECT CONSTRUCTION PERSONNEL THAT INCLUDES THE EC INSPECTOR.
- * ALL INSPECTIONS MUST BE MADE IN ACCORDANCE WITH DEQ 1200 C PERMIT REQUIREMENTS.
- * INSPECTION LOGS MUST BE KEPT IN ACCORDANCE WITH DEQ'S 1200 C PERMIT REQUIREMENTS.
- * CHANGES TO THE APPROVED ESC PLAN MUST BE SUBMITTED TO DEQ IN THE FORM OF AN ACTION PLAN.

THE PERMITTEE IS REQUIRED TO MEET ALL THE CONDITIONS OF THE 1200C PERMIT. THIS ESCP AND GENERAL CONDITIONS HAVE BEEN DEVELOPED TO FACILITATE COMPLIANCE WITH THE 1200C PERMIT REQUIREMENTS. IN CASES OF DISCREPANCIES OR OMISSIONS, THE 1200C PERMIT REQUIREMENTS SUPERCEDE REQUIREMENTS OF THIS PLAN.

STANDARD EROSION AND SEDIMENT CONTROL PLAN DRAWING NOTES:

1. APPLY TEMPORARY AND PERMANENT SOIL STABILIZATION MEASURES ON ALL DISTURBED AREAS AS GRADING PROGRESSES. (SCH A.5.b.ii.6.)
2. CONSTRUCTION ACTIVITIES MUST AVOID OR MINIMIZE EXCAVATION AND CREATION OF BARE GROUND FROM OCTOBER 1 THROUGH MAY 31 EACH YEAR. (SCH A.7.a.i.)
3. DURING WET WEATHER PERIODS TEMPORARY STABILIZATION OF THE SITE MUST OCCUR AT THE END OF EACH WORK DAY IF RAINFALL IS FORECAST IN THE NEXT 24 HOURS. (SCH A.7.a.ii.)
4. ALL EROSION AND SEDIMENT CONTROLS NOT IN THE DIRECT PATH OF WORK MUST BE INSTALLED PRIOR TO ANY LAND DISTURBANCE. (SCH A.7.c.ii.)
5. PRESERVE EXISTING VEGETATION AND RE-VEGETATE OPEN AREAS WHEN PRACTICABLE BEFORE AND AFTER GRADING OR CONSTRUCTION (SCHA.7.c.iii.1)
6. ALL TEMPORARY SEDIMENT CONTROLS MUST REMAIN IN PLACE UNTIL PERMANENT VEGETATION OR OTHER PERMANENT COVERING OF EXPOSED SOIL IS ESTABLISHED. (SCH A.7.c.iii.3.)
7. SEDIMENT CONTROLS MUST BE INSTALLED AND MAINTAINED ON ALL DOWN GRADIENT SIDES OF THE CONSTRUCTION SITE AT ALL TIMES DURING CONSTRUCTION. (SCH A.7.d.i.(1))
8. ALL ACTIVE CATCH BASINS MUST HAVE SEDIMENT CONTROLS INSTALLED AND MAINTAINED AT ALL TIMES DURING CONSTRUCTION. (SCH A.7.d.i.(2))
9. WATER-TIGHT TRUCKS MUST BE USED TO TRANSPORT SATURATED SOILS FROM THE CONSTRUCTION SITE. AN APPROVED EQUIVALENT IS TO DRAIN THE SOIL ON-SITE AT A DESIGNATED LOCATION USING APPROPRIATE BMP'S. SOIL MUST BE DRAINED SUFFICIENTLY FOR MINIMAL SPILLAGE. (SCH A.7.d.iii.3)
10. TEMPORARY STABILIZATION OR COVERING OF SOIL STOCKPILES MUST OCCUR AT THE END OF EACH WORK DAY OR OTHER BMP'S MUST BE IMPLEMENTED TO PREVENT TURBID DISCHARGES TO SURFACE WATERS. (SCH A.7.e.ii.2.)
11. DEVELOP AND MAINTAIN ONSITE A WRITTEN SPILL PREVENTION AND RESPONSE PROCEDURE. (SCH A.7.e.iii.3)
12. ANY USE OF TOXIC OR OTHER HAZARDOUS MATERIALS MUST INCLUDE PROPER STORAGE, APPLICATION, AND DISPOSAL. (SCH A.7.e.iii.(2))
13. THE PERMITTEE MUST PROPERLY PREVENT AND MANAGE HAZARDOUS WASTE, USED OILS, CONTAMINATED SOILS, CONCRETE WASTE, SANITARY WASTE, LIQUID WASTE, OR OTHER TOXIC SUBSTANCES DISCOVERED OR GENERATED DURING CONSTRUCTION. (SCH A.7.e.i.1 AND SCH A.7.e.iii.4)
14. SIGNIFICANT AMOUNTS OF SEDIMENT WHICH LEAVE THE SITE MUST BE CLEANED UP WITHIN 24 HOURS AND PLACED BACK ON THE SITE AND STABILIZED OR PROPERLY DISPOSED. THE CAUSE OF THE SEDIMENT RELEASE MUST BE FOUND AND PREVENTED FROM CAUSING A REOCCURRENCE OF THE DISCHARGE WITHIN THE SAME 24 HOURS. ANY IN-STREAM CLEAN UP OF SEDIMENT SHALL BE PERFORMED ACCORDING TO THE OREGON DIVISION OF STATE LANDS REQUIRED TIME FRAME. (SCH A.7.f.i.1)
15. SEDIMENT MUST NOT BE INTENTIONALLY WASHED INTO STORM SEWERS, DRAINAGE WAYS, OR WATERBODIES. DRY SWEEPING MUST BE USED TO CLEAN UP RELEASED SEDIMENTS. (SCH A.7.f.i.2)
16. THE APPLICATION RATE OF FERTILIZERS USED TO REESTABLISH VEGETATION MUST FOLLOW THE MANUFACTURER'S RECOMMENDATIONS. NUTRIENT RELEASES FROM FERTILIZERS TO SURFACE WATERS MUST BE MINIMIZED. TIME RELEASE FERTILIZERS SHOULD BE USED AND CARE SHOULD BE TAKEN IN THE APPLICATION OF FERTILIZERS WITHIN ANY WATER WAY RIPARIAN ZONE. (SCH A.7.f.i.3.)
17. SEDIMENT MUST BE REMOVED FROM BEHIND SEDIMENT FENCE WHEN IT HAS REACHED A HEIGHT OF 3/4 THE HEIGHT OF THE FENCE ABOVE THE GROUND, AND BEFORE FENCE REMOVAL. (SCH A.7.f.ii.1.)
18. SEDIMENT MUST BE REMOVED FROM BEHIND BIO BAGS AND OTHER BARRIERS WHEN IT HAS REACHED A HEIGHT OF TWO (2) INCHES AND BEFORE BMP REMOVAL. (SCH A.7.f.ii.2.)
19. CLEANING OF TRAPPED CATCH BASINS MUST OCCUR WHEN THE SEDIMENT RETENTION CAPACITY HAS BEEN REDUCED BY FIFTY (50) PERCENT, AND AT COMPLETION OF PROJECT. (SCH A.7.f.ii.3.)
20. REMOVAL OF TRAPPED SEDIMENT IN A SEDIMENT BASIN OR SEDIMENT TRAP MUST OCCUR WHEN THE SEDIMENT RETENTION CAPACITY HAS BEEN REDUCED BY FIFTY (50) PERCENT, AND AT COMPLETION OF PROJECT. (SCH A.7.f.ii.3&4)
21. DEQ MUST APPROVE OF ANY TREATMENT SYSTEM AND OPERATIONAL PLAN THAT MAY BE NECESSARY TO TREAT CONTAMINATED CONSTRUCTION DEWATERING OR SEDIMENT AND TURBIDITY IN STORMWATER RUNOFF. (SCH A.7.f.iii.)
22. SHOULD ALL CONSTRUCTION ACTIVITIES CEASE FOR THIRTY (30) DAYS OR MORE, THE ENTIRE SITE MUST BE TEMPORARILY STABILIZED USING VEGETATION OR A HEAVY MULCH LAYER, TEMPORARY SEEDING, OR OTHER METHOD. (SCH A.8.a.)
23. SHOULD CONSTRUCTION ACTIVITIES CEASE FOR FIFTEEN (15) DAYS OR MORE ON ANY SIGNIFICANT PORTION OF A CONSTRUCTION SITE, TEMPORARY STABILIZATION IS REQUIRED FOR THAT PORTION OF THE SITE WITH STRAW, COMPOST, OR OTHER TACKIFIED COVERING THAT WILL PREVENT SOIL OR WIND EROSION UNTIL WORK RESUMES ON THAT PORTION OF THE SITE. (SCH A.8.b.)

LOCAL AGENCY-SPECIFIC EROSION CONTROL NOTES:

1. OWNER OR DESIGNATED PERSON SHALL BE RESPONSIBLE FOR PROPER INSTALLATION AND MAINTENANCE OF ALL EROSION AND SEDIMENT CONTROL MEASURES, IN ACCORDANCE WITH LOCAL, STATE, AND FEDERAL REGULATIONS.
2. PRIOR TO ANY LAND DISTURBING ACTIVITIES, THE BOUNDARIES OF THE CLEARING LIMITS, VEGETATED BUFFERS, AND ANY SENSITIVE AREAS SHOWN ON THIS PLAN SHALL BE CLEARLY DELINEATED IN THE FIELD. DURING THE CONSTRUCTION PERIOD, NO DISTURBANCE IS PERMITTED BEYOND THE CLEARING LIMITS. THE OWNER/PERMITTEE MUST MAINTAIN THE DELINEATION FOR THE DURATION OF THE PROJECT. NOTE: VEGETATED CORRIDORS TO BE DELINEATED WITH ORANGE CONSTRUCTION FENCE OR APPROVED EQUAL.
3. PRIOR TO ANY LAND DISTURBING ACTIVITIES, THE BMP'S THAT MUST BE INSTALLED ARE A GRAVEL CONSTRUCTION ENTRANCE, PERIMETER SEDIMENT CONTROL, AND INLET PROTECTION. THESE BMP'S MUST BE MAINTAINED FOR THE DURATION OF THE PROJECT.
4. IF VEGETATIVE SEED MIXES ARE SPECIFIED, SEEDING MUST TAKE PLACE NO LATER THAN SEPTEMBER 1; THE TYPE AND PERCENTAGES OF SEED IN THE MIX MUST BE IDENTIFIED ON THE PLANS.
5. ALL PUMPING OF SEDIMENT LADEN WATER SHALL BE DISCHARGED OVER AN UNDISTURBED, PREFERABLY VEGETATED AREA, AND THROUGH A SEDIMENT CONTROL BMP (i.e. FILTER BAG).
6. THE ESC PLAN MUST BE KEPT ON SITE. ALL MEASURES SHOWN ON THE PLAN MUST BE INSTALLED PROPERLY TO ENSURE THAT SEDIMENT OR SEDIMENT LADEN WATER DOES NOT ENTER A SURFACE WATER SYSTEM, ROADWAY, OR OTHER PROPERTIES.
7. THE ESC MEASURES SHOWN ON THIS PLAN ARE MINIMUM REQUIREMENTS FOR ANTICIPATED SITE CONDITIONS. DURING THE CONSTRUCTION PERIOD, THESE MEASURES SHALL BE UPGRADED AS NEEDED TO COMPLY WITH ALL APPLICABLE LOCAL, STATE, AND FEDERAL EROSION CONTROL REGULATIONS. CHANGES TO THE APPROVED ESC PLAN MUST BE SUBMITTED IN THE FORM OF AN ACTION PLAN TO DEQ PER THE 1200 C PERMIT.
8. IN AREAS SUBJECT TO WIND EROSION, APPROPRIATE BMP'S MUST BE USED WHICH MAY INCLUDE THE APPLICATION OF FINE WATER SPRAYING, PLASTIC SHEETING, MULCHING, OR OTHER APPROVED MEASURES.
9. ALL EXPOSED SOILS MUST BE COVERED DURING THE WET WEATHER PERIOD.

BMP MATRIX FOR CONSTRUCTION PHASES

REFER TO DEQ GUIDANCE MANUAL FOR A COMPREHENSIVE LIST OF AVAILABLE BMP'S.

	UTILITY INSTALLATION	STREET CONSTRUCTION	FINAL START UP	FINAL GRADING	WET WEATHER (OCT. 1 - MAY 31ST)
EROSION PREVENTION					
PRESERVE NATURAL VEGETATION	X	X	X	X	X
GROUND COVER		X		X	X
PLASTIC SHEETING					X
MATTING			X	X	X
DUST CONTROL	X	X	X	X	X
TEMPORARY/ PERMANENT SEEDING	X			X	X
OTHER:					
SEDIMENT CONTROL					
SEDIMENT FENCE (PERIMETER)	X	X	X	X	X
SEDIMENT FENCE (INTERIOR)			X	X	X
BIO BAGS	X			X	X
INLET PROTECTION	X	X	X	X	X
DEWATERING (GENERAL)	X	X	X	X	X
DEWATERING (ROCK CREEK BORE PITS)					X
TEMPORARY SEDIMENT BASIN			X		X
OTHER:					
RUN-OFF CONTROL					
CONSTRUCTION ENTRANCE	X	X	X	X	X
OUTLET PROTECTION	X	X		X	X
SURFACE ROUGHENING				X	
CHECK DAMS	X	X		X	
OTHER:					
POLLUTION PREVENTION					
PROPER SIGNAGE	X	X	X	X	X
HAZ WASTE MGMT	X	X	X	X	X
SPILL KIT ON-SITE	X	X	X	X	X
OTHER:					

** SIGNIFIES BMP THAT WILL BE INSTALLED PRIOR TO ANY GROUND DISTURBING ACTIVITY.

RATIONALE STATEMENT

A COMPREHENSIVE LIST OF AVAILABLE BEST MANAGEMENT PRACTICES (BMP) OPTIONS BASED ON DEQ'S GUIDANCE MANUAL HAS BEEN REVIEWED TO COMPLETE THIS EROSION AND SEDIMENT CONTROL PLAN. SOME OF THE ABOVE LISTED BMP'S WERE NOT CHOSEN BECAUSE THEY WERE DETERMINED TO NOT EFFECTIVELY MANAGE EROSION PREVENTION AND SEDIMENT CONTROL FOR THIS PROJECT BASED ON SPECIFIC SITE CONDITIONS, INCLUDING SOIL CONDITIONS TOPOGRAPHIC CONSTRAINTS, ACCESSIBILITY TO THE SITE, AND OTHER RELATED CONDITIONS, AS THE PROJECT PROGRESSES AND THERE IS A NEED TO REVISE THE ESC PLAN, AN ACTION PLAN WILL BE SUBMITTED.

MLH
INITIAL

SHEET INDEX

EROSION AND SEDIMENT CONTROL PLANS

- ESC-1 EROSION AND SEDIMENT CONTROL COVER SHEET
- ESC-2 EROSION AND SEDIMENT CONTROL NOTES AND LEGEND
- ESC-3 EROSION CONTROL MEASURES-1
- ESC-4 EROSION CONTROL MEASURES-2
- ESC-5 EROSION AND SEDIMENT CONTROL DETAILS-1
- ESC-6 EROSION AND SEDIMENT CONTROL DETAILS-2

G:\PDX_Projects\07.0873\207 Design-Final Plans\CAD\DOR\07-0873-207-OR-ESC-1-R.dwg ESC-1 8/29/2011 1:51 PM DAK 18.1s (LMS Tech)

NO.	DATE	BY	REVISION
1	08/22/11	BVO	RECORD DRAWING

NOTICE

0 1/2 1

IF THIS BAR DOES NOT MEASURE 1" THEN DRAWING IS NOT TO SCALE

LLA DESIGNED
DAK DRAWN
MLH CHECKED

RECORD DRAWING

SEE DISCLAIMER, SHEET 1.

VERSION 4.1
12-9-97

MSA Murray Smith & Associates, Inc.
Engineers/Planners

121 S.W. Salmon, Suite 900 PHONE 503-225-9010
Portland, Oregon 97204 FAX 503-225-9022

WATER SUPPLY IMPROVEMENT PROJECT TRANSMISSION PIPELINE

City of Sherwood Oregon

EROSION AND SEDIMENT CONTROL COVER SHEET

PROJECT NO.: 07-0873.209 SCALE: AS SHOWN DATE: JUNE 2009

SHEET

ESC-1

14 of 79








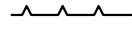
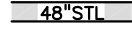
PRE-CONSTRUCTION EROSION & SEDIMENTATION CONTROL NOTES:

- ALL BASE ESC MEASURES (INLET PROTECTION, PERIMETER SEDIMENT CONTROL, GRAVEL CONSTRUCTION ENTRANCES, ETC.) MUST BE IN PLACE, FUNCTIONAL, AND APPROVED IN AN INITIAL INSPECTION, PRIOR TO COMMENCEMENT OF CONSTRUCTION ACTIVITIES.
- SEDIMENT BARRIERS APPROVED FOR USE INCLUDE SEDIMENT FENCE, BERMS CONSTRUCTED OUT OF MULCH, CHIPPINGS, OR OTHER SUITABLE MATERIAL, STRAW WATTLES, OR OTHER APPROVED MATERIALS.
- SENSITIVE RESOURCES INCLUDING, BUT NOT LIMITED TO, TREES, WETLANDS, AND RIPARIAN PROTECTION AREAS SHALL BE CLEARLY DELINEATED WITH ORANGE CONSTRUCTION FENCING OR CHAIN LINK FENCING IN A MANNER THAT IS CLEARLY VISIBLE TO ANYONE IN THE AREA. NO ACTIVITIES ARE PERMITTED TO OCCUR BEYOND THE CONSTRUCTION BARRIER.
- CONSTRUCTION ENTRANCES SHALL BE INSTALLED AT THE BEGINNING OF CONSTRUCTION AND MAINTAINED FOR THE DURATION OF THE PROJECT. ADDITIONAL MEASURES INCLUDING, BUT NOT LIMITED TO, STREET SWEEPING, AND VACUUMING, MAY BE REQUIRED TO INSURE THAT ALL PAVED AREAS ARE KEPT CLEAN FOR THE DURATION OF THE PROJECT.
- RUN-ON AND RUN-OFF CONTROLS SHALL BE IN PLACE AND FUNCTIONING PRIOR TO BEGINNING SUBSTANTIAL CONSTRUCTION ACTIVITIES. RUN-ON AND RUN-OFF CONTROL MEASURES INCLUDE: SLOPE DRAINS (WITH OUTLET PROTECTION), CHECK DAMS, SURFACE ROUGHENING, AND BANK STABILIZATION.
- LIMIT SPEED OF VEHICLES ON SITE AND MOISTEN HAUL ROADS AS NECESSARY TO CONTROL DUST.

GRADING, STREET AND UTILITY EROSION AND SEDIMENT CONSTRUCTION NOTES:


- SEED USED FOR TEMPORARY OR PERMANENT SEEDING SHALL BE COMPOSED OF ONE OF THE FOLLOWING MIXTURES, UNLESS OTHERWISE AUTHORIZED:
 - DWARF GRASS MIX (MIN. 100 LB./AC.)
 - DWARF PERENNIAL RYEGRASS (80% BY WEIGHT)
 - CREeping RED FESCUE (20% BY WEIGHT)
 - STANDARD HEIGHT GRASS MIX (MIN. 100LB./AC.)
 - ANNUAL RYEGRASS (40% BY WEIGHT)
 - TURF-TYPE FESCUE (60% BY WEIGHT)
- SLOPE TO RECEIVE TEMPORARY OR PERMANENT SEEDING SHALL HAVE THE SURFACE ROUGHENED BY MEANS OF TRACK-WALKING OR THE USE OF OTHER APPROVED IMPLEMENTS. SURFACE ROUGHENING IMPROVES SEED BEDDING AND REDUCES RUN-OFF VELOCITY.
- LONG TERM SLOPE STABILIZATION MEASURES SHALL INCLUDE THE ESTABLISHMENT OF PERMANENT VEGETATIVE COVER VIA SEEDING WITH APPROVED MIX AND APPLICATION RATE.
- TEMPORARY SLOPE STABILIZATION MEASURES SHALL INCLUDE: COVERING EXPOSED SOIL WITH PLASTIC SHEETING, STRAW MULCHING, WOOD CHIPS, OR OTHER APPROVED MEASURES.
- STOCKPILED SOIL OR STRIPPINGS SHALL BE PLACED IN A STABLE LOCATION AND CONFIGURATION. DURING "WET WEATHER" PERIODS, STOCKPILES SHALL BE COVERED WITH PLASTIC SHEETING OR STRAW MULCH. SEDIMENT FENCE IS REQUIRED AROUND THE PERIMETER OF THE STOCKPILE.
- EXPOSED CUT OR FILL AREAS SHALL BE STABILIZED THROUGH THE USE OF TEMPORARY SEEDING AND MULCHING, EROSION CONTROL BLANKETS OR MATS, MID-SLOPE SEDIMENT FENCES OR WATTLES, OR OTHER APPROPRIATE MEASURES. SLOPES EXCEEDING 25% MAY REQUIRE ADDITIONAL EROSION CONTROL MEASURES.
- AREAS SUBJECT TO WIND EROSION SHALL USE APPROPRIATE DUST CONTROL MEASURES INCLUDING THE APPLICATION OF A FINE SPRAY OF WATER, PLASTIC SHEETING, STRAW MULCHING, OR OTHER APPROVED MEASURES.
- CONSTRUCTION ENTRANCES SHALL BE INSTALLED AT THE BEGINNING OF CONSTRUCTION AND MAINTAINED FOR THE DURATION OF THE PROJECT. ADDITIONAL MEASURES INCLUDING, BUT NOT LIMITED TO, TIRE WASHES, STREET SWEEPING, AND VACUUMING MAY BE REQUIRED TO INSURE THAT ALL PAVED AREAS ARE KEPT CLEAN FOR THE DURATION OF THE PROJECT.
- ACTIVE INLETS TO STORM WATER SYSTEMS SHALL BE PROTECTED THROUGH THE USE OF APPROVED INLET PROTECTION MEASURES. ALL INLET PROTECTION MEASURES ARE TO BE REGULARLY INSPECTED AND MAINTAINED AS NEEDED.
- SATURATED MATERIALS THAT ARE HAULED OFF-SITE MUST BE TRANSPORTED IN WATER-TIGHT TRUCKS TO ELIMINATE SPILLAGE OF SEDIMENT AND SEDIMENT-LADEN WATER.
- AN AREA SHALL BE PROVIDED FOR THE WASHING OUT OF CONCRETE TRUCKS IN A LOCATION THAT DOES NOT PROVIDE RUN-OFF THAT CAN ENTER THE STORM WATER SYSTEM. IF THE CONCRETE WASH-OUT AREA CAN NOT BE CONSTRUCTED GREATER THAN 50' FROM ANY DISCHARGE POINT, SECONDARY MEASURES SUCH AS BERMS OR TEMPORARY SETTLING PITS MAY BE REQUIRED. THE WASH-OUT SHALL BE LOCATED WITHIN SIX FEET OF TRUCK ACCESS AND BE CLEANED WHEN IT REACHES 50% OF THE CAPACITY. SUITABLE CONCRETE WASH-OUT AREAS WILL BE IDENTIFIED BY CONTRACTOR AND APPROVED BY EROSION CONTROL INSPECTOR.
- SWEEPINGS FROM EXPOSED AGGREGATE CONCRETE SHALL NOT BE TRANSFERRED TO THE STORM WATER SYSTEM. SWEEPINGS SHALL BE PICKED UP AND DISPOSED IN THE TRASH.
- AVOID PAVING IN WET WEATHER WHEN PAVING CHEMICALS CAN RUN-OFF INTO THE STORM WATER SYSTEM.
- USE BMPs SUCH AS CHECK-DAMS, BERMS, AND INLET PROTECTION TO PREVENT RUN-OFF FROM REACHING DISCHARGE POINTS.
- COVER CATCH BASINS, MANHOLES, AND OTHER DISCHARGE POINTS WHEN APPLYING SEAL COAT, TACK COAT, ETC. TO PREVENT INTRODUCING THESE MATERIALS TO THE STORM WATER SYSTEM.
- INLET PROTECTION SHALL BE IN-PLACE IMMEDIATELY FOLLOWING PAVING ACTIVITIES.

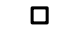LEGEND

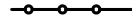- EXISTING CONTOURS (1') 
- EXISTING CONTOURS (5') 
- INLET PROTECTION 
- DRAINAGE FLOW DIRECTION 
- SEDIMENT FENCING 
- CONSTRUCTION FENCING (ORANGE) 
- CHECK DAM 
- WATTLES 
- PROPOSED WATERLINE 

C:\Users\dak\AppData\local\temp\AcPublish_3656\07-0873-207-OR-ESC-2-6-R.dwg ESC-2 8/29/2011 2:22 PM DAK 18.1s (LMS Tech)

NO.	DATE	BY	REVISION
1	08/22/11	BVO	RECORD DRAWING

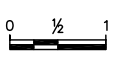NOTICE

 IF THIS BAR DOES NOT MEASURE 1" THEN DRAWING IS NOT TO SCALE

LLA
DESIGNED
 DAK
DRAWN
 MLH
CHECKED

RECORD DRAWING
 SEE DISCLAIMER, SHEET 1.
 VERSION 4.1
 12-9-97



Murray Smith & Associates, Inc.
Engineers/Planners
 121 S.W. Salmon, Suite 900 PHONE 503-225-9010
 Portland, Oregon 97204 FAX 503-225-9022




WATER SUPPLY IMPROVEMENT PROJECT TRANSMISSION PIPELINE


EROSION AND SEDIMENT CONTROL NOTES AND LEGEND

PROJECT NO.: 07-0873.209 SCALE: AS SHOWN DATE: JUNE 2009


SHEET
ESC-2
 15 of 79

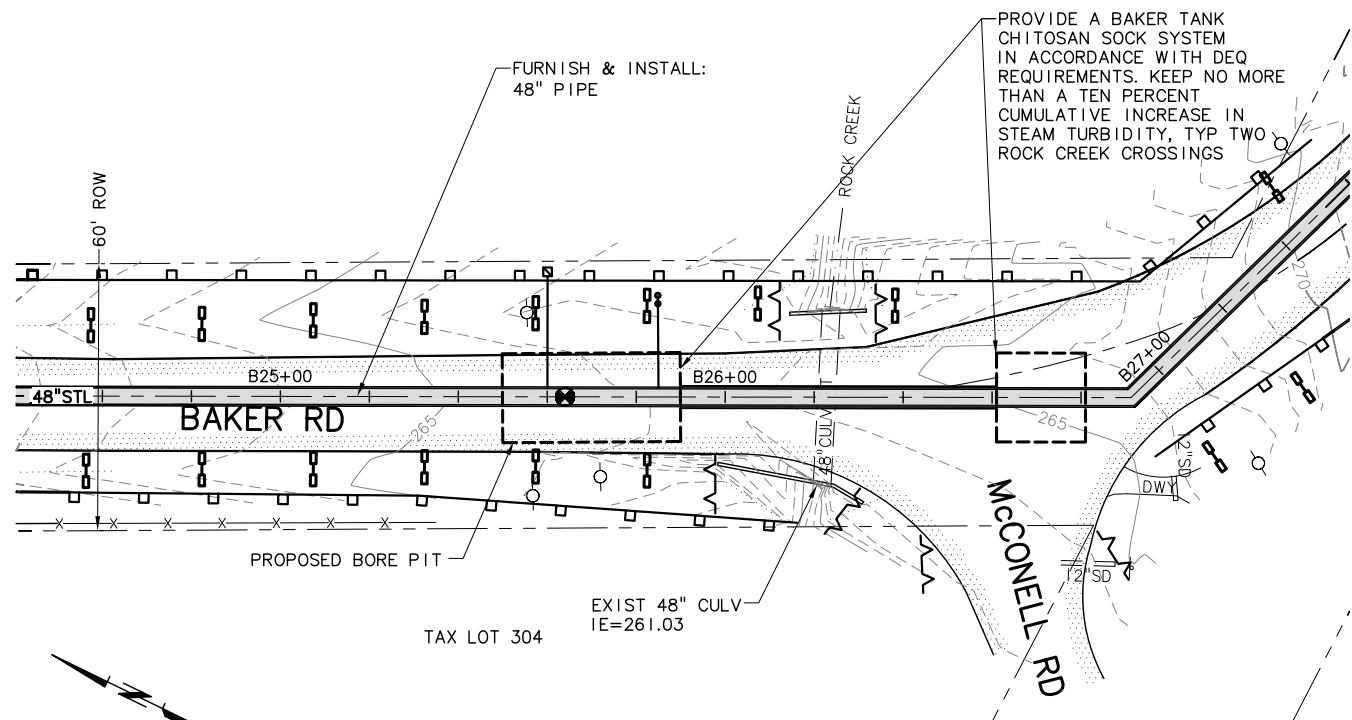

TYPICAL BORED & JACKED CROSSING AND EROSION CONTROL MEASURE
STA B24+60 TO STA B27+60
 SCALE: 1"=20'

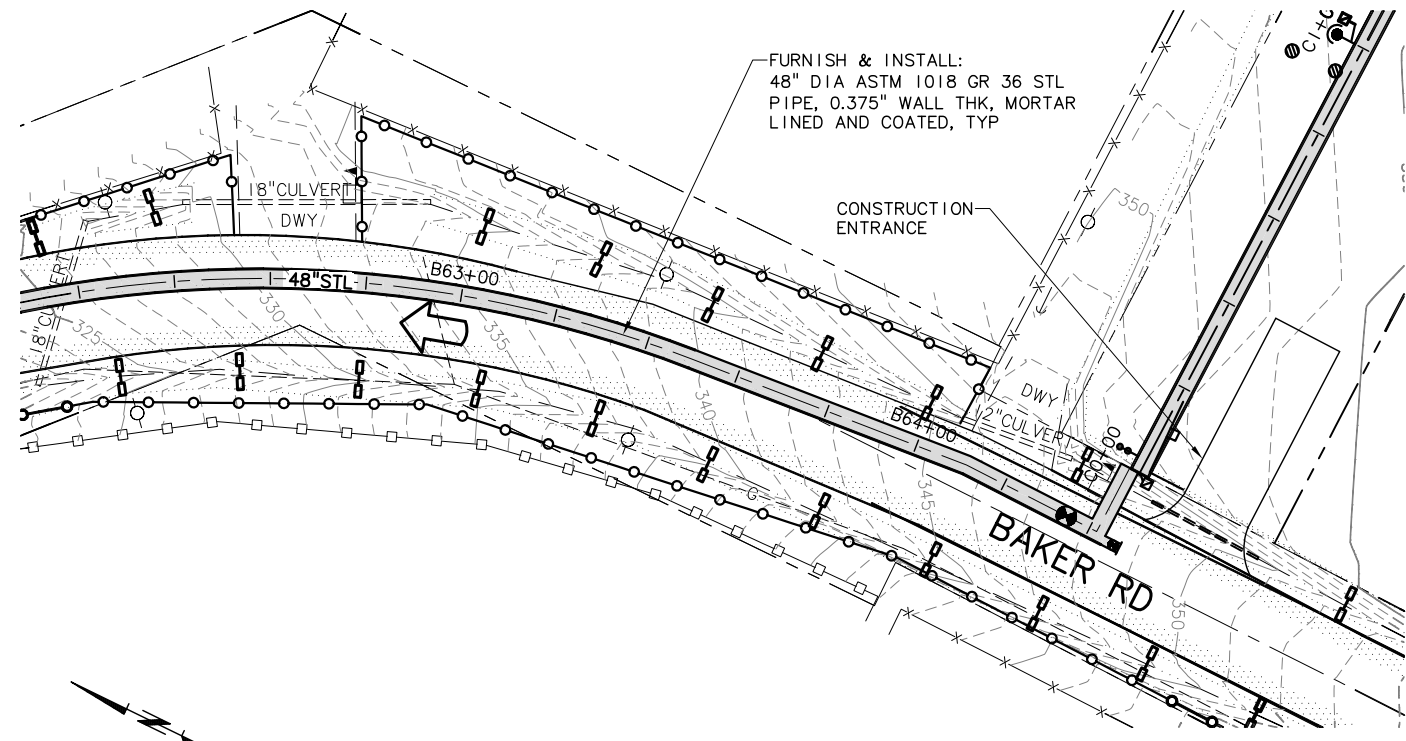


TYPICAL CONSTRUCTION ACCESS TO CROSS-COUNTRY ALIGNMENT & EROSION
STA B62+10 TO STA B64+70
 SCALE: 1"=20'

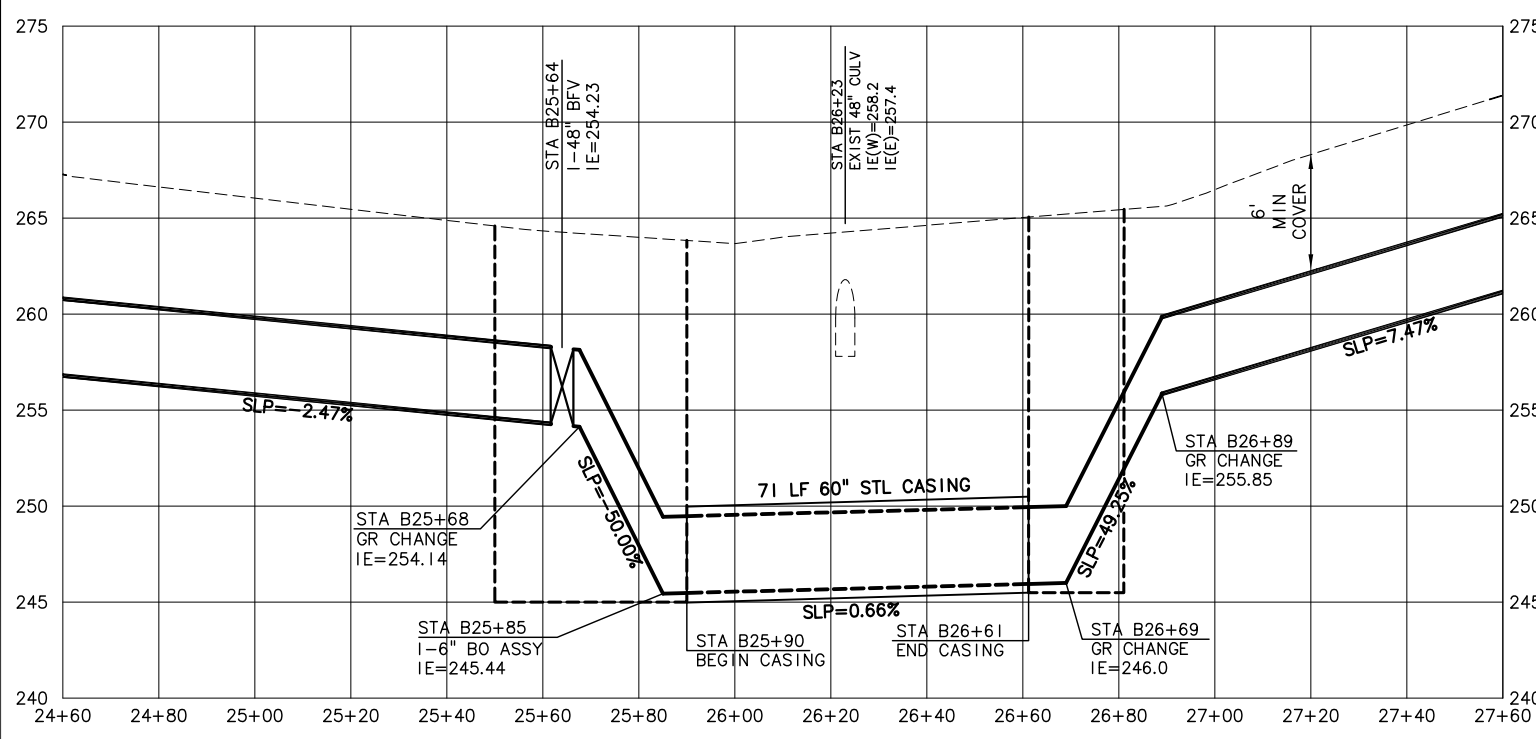

NOTES:

1. OWNER HAS OBTAINED A JOINT PERMIT (NO. NWP-2008-634), FROM US CORP OF ENGINEERS AND OREGON DEPARTMENT OF STATE LANDS FOR REMOVAL AND FILL WITHIN A WETLAND. CONTRACTOR TO COMPLY WITH ALL CONDITIONS OF THE PERMIT. A COPY OF THE PERMIT IS LOCATED WITHIN THE SUPPLEMENTARY INFORMATION.

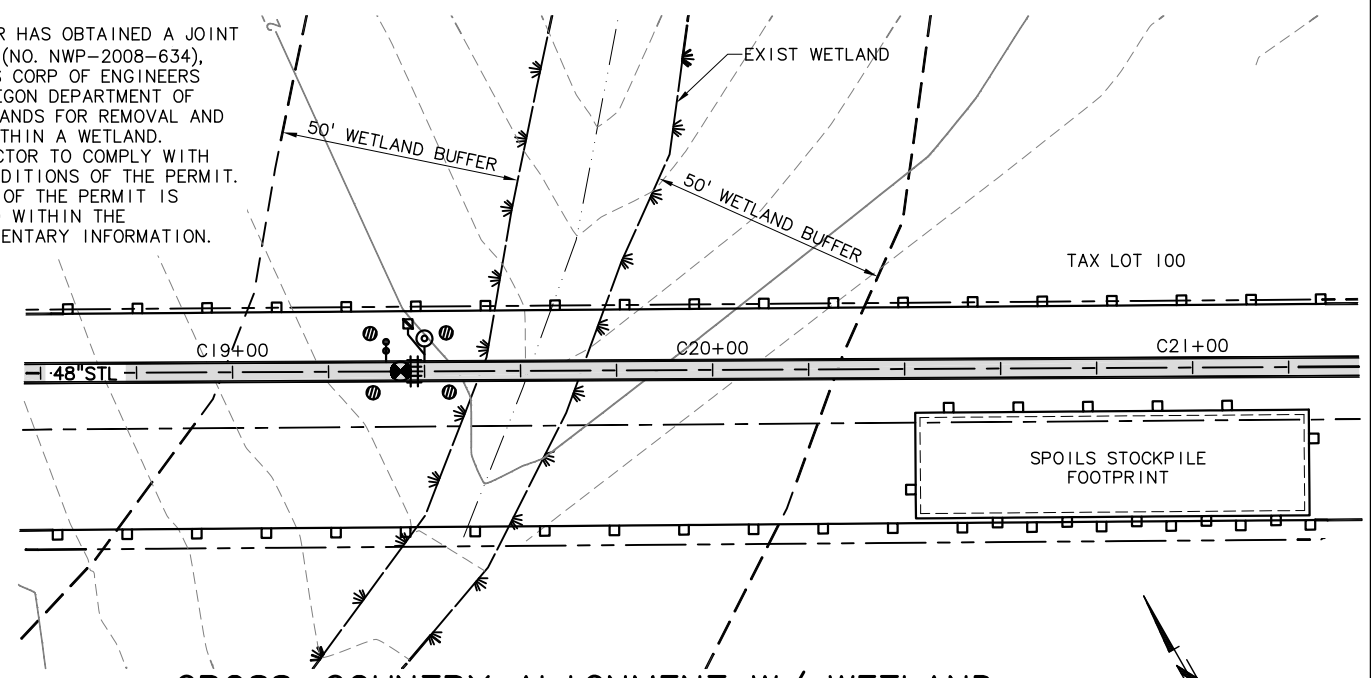

CROSS-COUNTRY ALIGNMENT W/ WETLAND CROSSING & EROSION CONTROL MEASURES
STA C18+60 TO STA C21+30
 SCALE: 1"=20'

C:\Users\dak\AppData\Local\Temp\AcPublish_3656\07-0873-207-OR-ESC-2-6-R.dwg ESC-4 8/29/2011 2:22 PM DAK 18.1s (LMS Tech)

NO.	DATE	BY	REVISION
1	08/22/11	BVO	RECORD DRAWING

NOTICE

0 1/2 1

IF THIS BAR DOES NOT MEASURE 1" THEN DRAWING IS NOT TO SCALE

LLA DESIGNED
 DAK DRAWN
 MLH CHECKED

RECORD DRAWING

SEE DISCLAIMER, SHEET 1.

VERSION 4.1
 12-9-97

MSA Murray Smith & Associates, Inc.
 Engineers/Planners

121 S.W. Salmon, Suite 900
 Portland, Oregon 97204

PHONE 503-225-9010
 FAX 503-225-9022

WATER SUPPLY IMPROVEMENT PROJECT TRANSMISSION PIPELINE


City of Sherwood Oregon

EROSION AND SEDIMENT CONTROL MEASURES-2


PROJECT NO.: 07-0873.209 SCALE: AS SHOWN DATE: JUNE 2009

SHEET
ESC-4
 17 of 79


C:\Users\dak\AppData\Local\Temp\AcPublish_3656\07-0873-207-OR-ESC-2-6-R.dwg ESC-5 8/29/2011 2:22 PM DAK 18.1 s (LWS Tech)

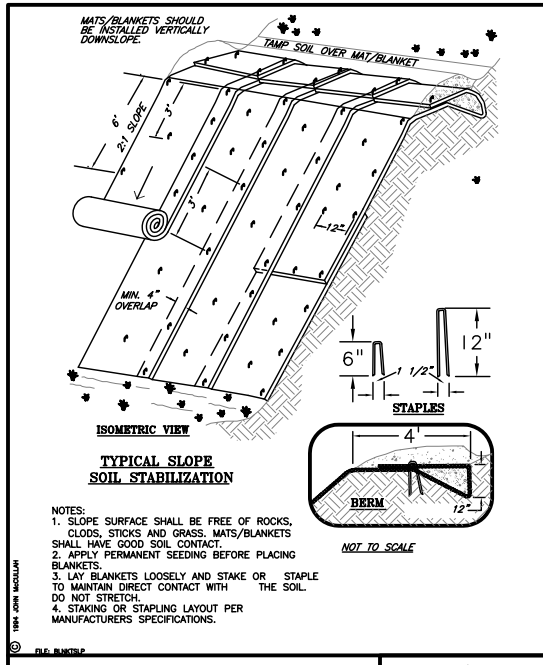


MATTING SLOPE INSTALLATION
DRAWING NO. 805 REVISED 12-06
CleanWater Services
Our commitment is clear.

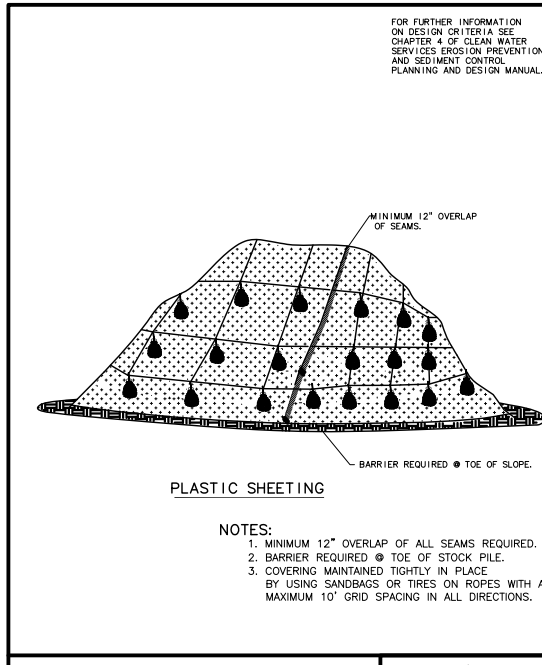


PLASTIC SHEETING
DRAWING NO. 810 REVISED 12-06
CleanWater Services
Our commitment is clear.

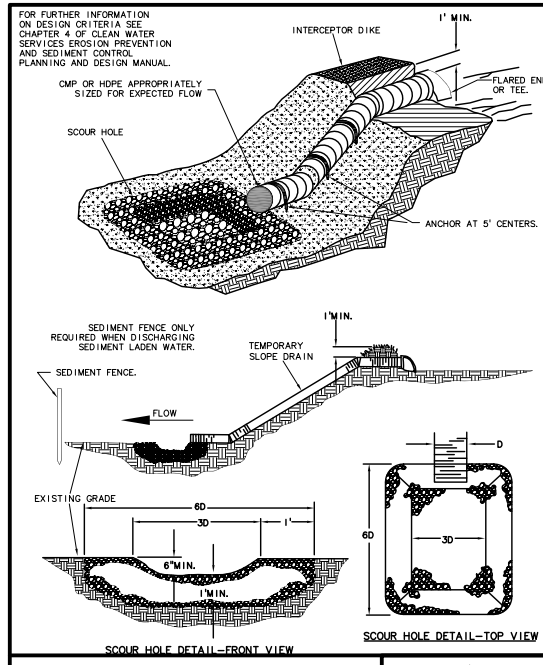


PIPE SLOPE DRAIN
DRAWING NO. 815 REVISED 12-06
CleanWater Services
Our commitment is clear.

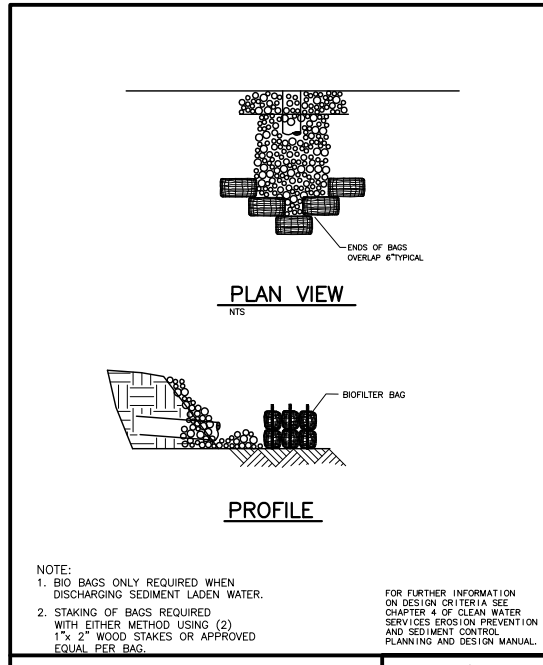


OUTLET PROTECTION RIP RAP
Detail Drawing 820 REVISED 12-06
CleanWater Services
Our commitment is clear.

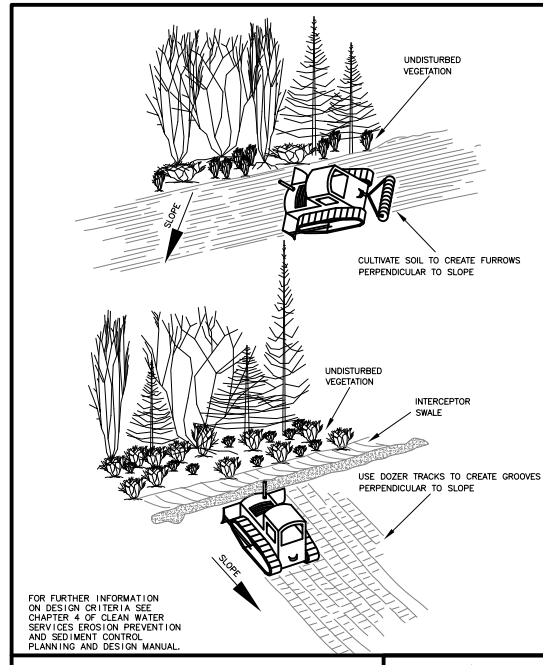


SURFACE ROUGHENING CAT TRACKING
DRAWING NO. 830 REVISED 12-06
CleanWater Services
Our commitment is clear.

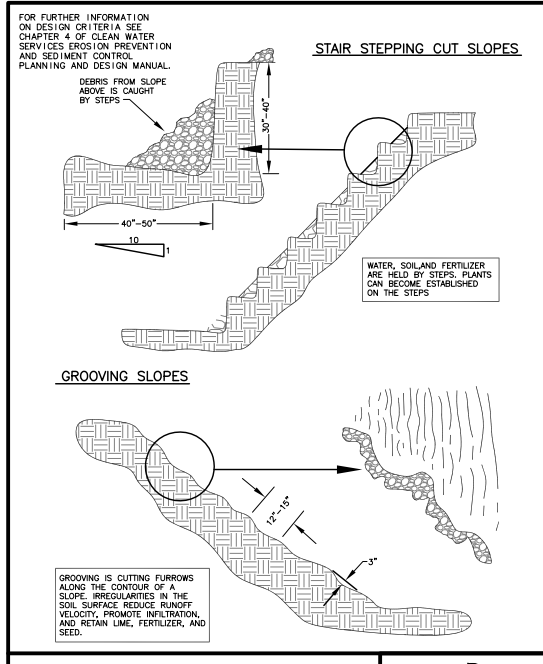


SURFACE ROUGHENING STAIR STEPPING/GROOVING SLOPES
DRAWING NO. 835 REVISED 12-06
CleanWater Services
Our commitment is clear.

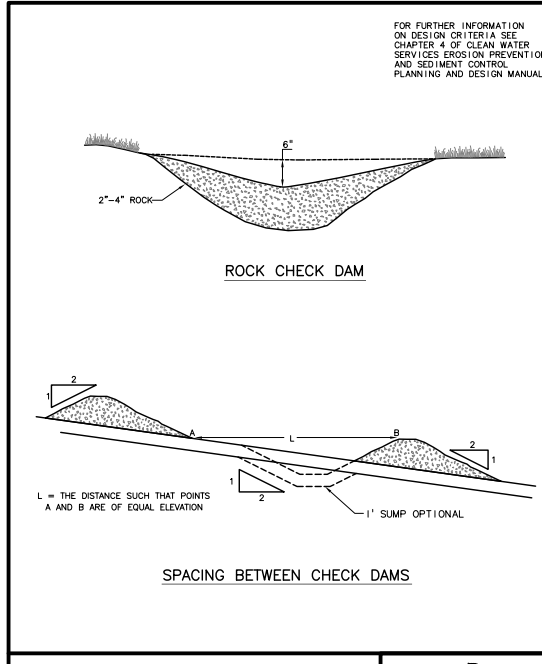


CHECK DAM ROCK
DRAWING NO. 840 REVISED 12-06
CleanWater Services
Our commitment is clear.

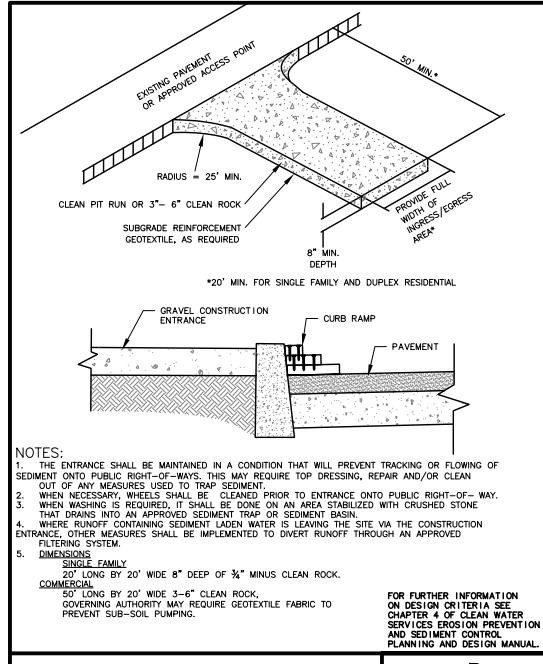

CONSTRUCTION ENTRANCE
Detail Drawing 855 REVISED 12-06
CleanWater Services
Our commitment is clear.

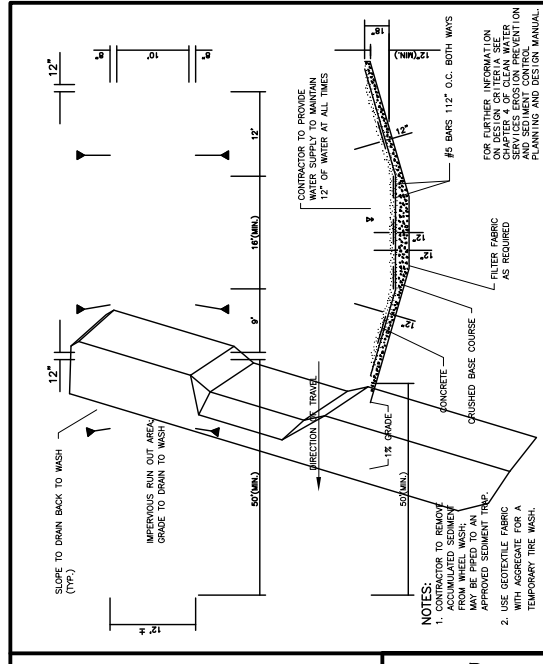

TIRE WASH-(DRIVE-THROUGH)
DRAWING NO. 870 REVISED 12-06
CleanWater Services
Our commitment is clear.

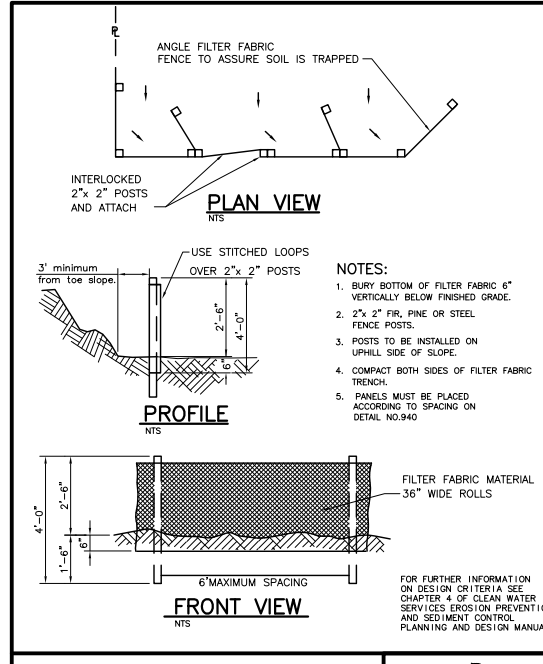

SEDIMENT FENCE
DRAWING NO. 875 REVISED 12-06
CleanWater Services
Our commitment is clear.

NOTICE

0 1/2 1

IF THIS BAR DOES NOT MEASURE 1" THEN DRAWING IS NOT TO SCALE

LLA	DESIGNED
DAK	DRAWN
MLH	CHECKED

RECORD DRAWING

SEE DISCLAIMER, SHEET 1.

VERSION 4.1
12-9-97

MSA Murray Smith & Associates, Inc.
Engineers/Planners

121 S.W. Salmon, Suite 900 PHONE 503-225-9010
Portland, Oregon 97204 FAX 503-225-9022










WATER SUPPLY IMPROVEMENT PROJECT TRANSMISSION PIPELINE

EROSION AND SEDIMENT CONTROL DETAILS-1

PROJECT NO.: 07-0873.209 SCALE: AS SHOWN DATE: JUNE 2009

C:\Users\dak\AppData\local\temp\AcPublish\07-0873-207-OR-ESC-2-6-R.dwg ESC-6 8/29/2011 2:22 PM DAK 18.1s (LMS Tech)

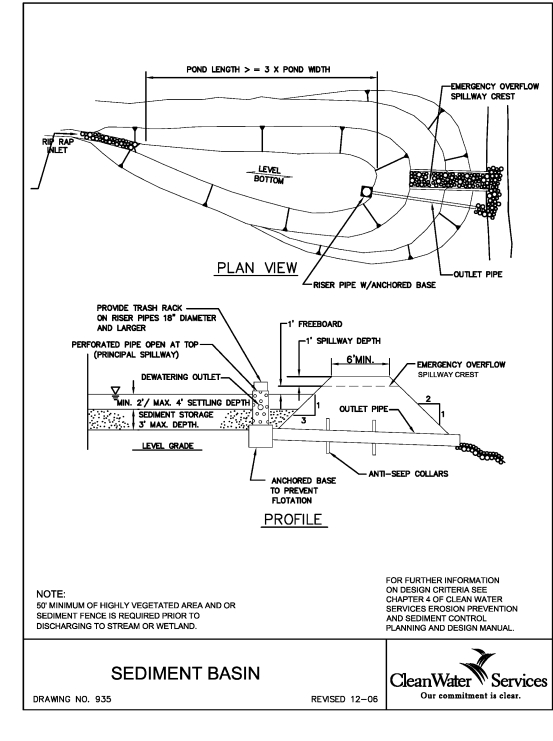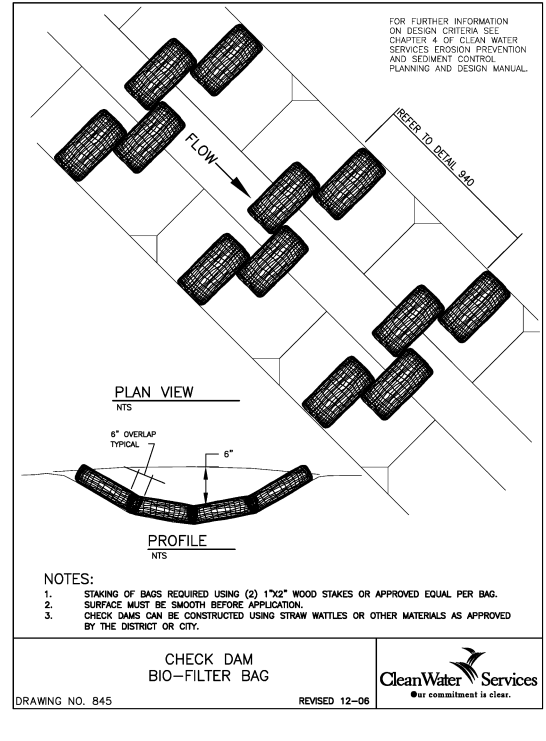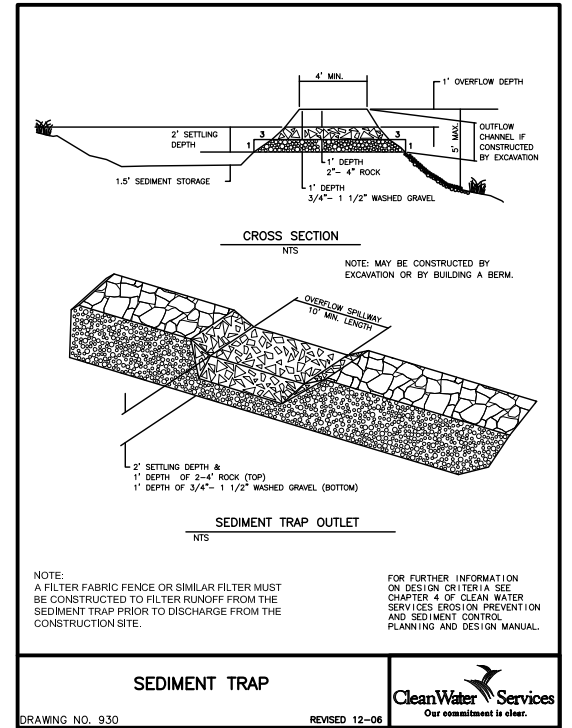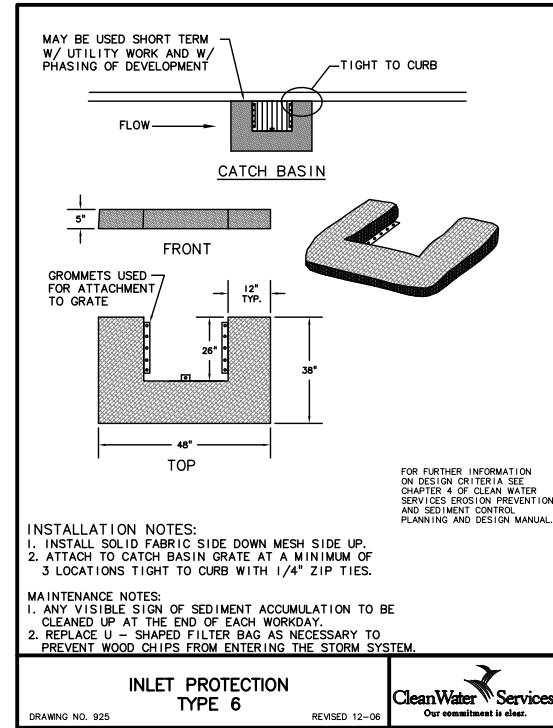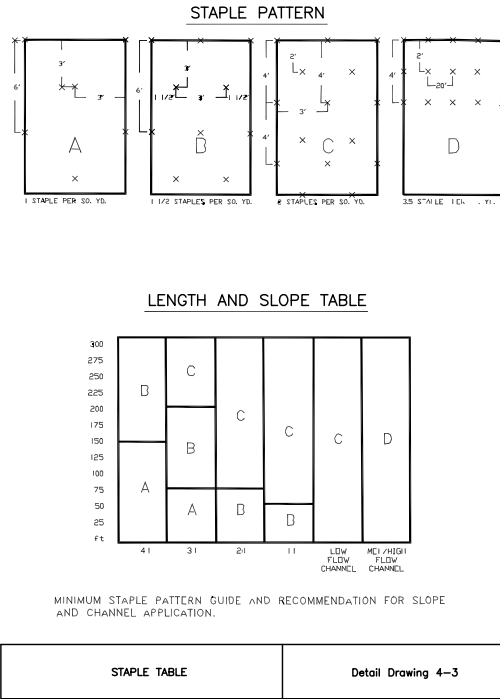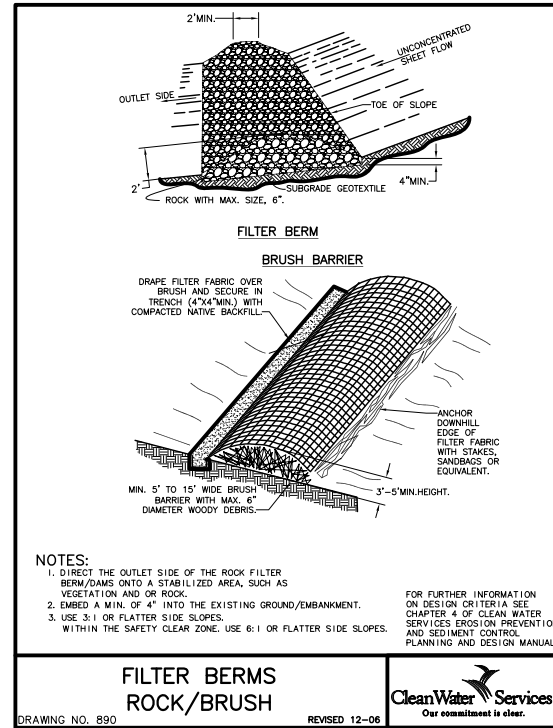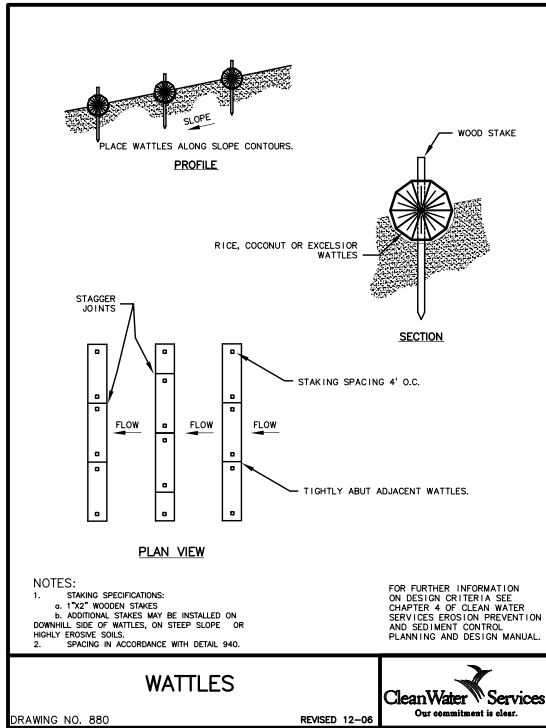

FOR FURTHER INFORMATION ON DESIGN CRITERIA SEE CHAPTER 4 OF CLEAN WATER SERVICES EROSION PREVENTION AND SEDIMENT CONTROL PLANNING AND DESIGN MANUAL.

DITCH GRADE	6 INCH	12 INCH	18 INCH
6%	NOT ALLOWED	16 FT O.C.	26 FT O.C.
5%	NOT ALLOWED	20 FT	30 FT
4%	NOT ALLOWED	26 FT	40 FT
3%	15 FT	33 FT	50 FT
2%	25 FT	50 FT	80 FT


FOR FURTHER INFORMATION ON DESIGN CRITERIA SEE CHAPTER 4 OF CLEAN WATER SERVICES EROSION PREVENTION AND SEDIMENT CONTROL PLANNING AND DESIGN MANUAL.

% SLOPE	SLOPE	MAXIMUM SPACING ON SLOPE
10% OR FLATTER	10:1 OR FLATTER	300 FT
>10% OR <15%	>10:1 OR <7.5:1	150 FT
>15% OR <20%	>7.5:1 OR <5:1	100 FT
>20% OR <30%	>5:1 OR <3.5:1	50 FT
>30% OR <50%	>3.5:1 OR <2:1	25 FT

FOR MORE INFORMATION REGARDING THESE TABLES SEE CHAPTER 4 TABLES 4.3 AND 4.7 OF CLEAN WATER SERVICES EROSION PREVENTION AND SEDIMENT CONTROL DESIGN MANUAL.

SPACING TABLES
DRAWING NO. 940 REVISED 12-06

CleanWater Services
Our commitment is clear.

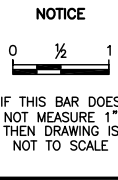

LLA
DESIGNED
DAK
DRAWN
MLH
CHECKED

**RECORD
DRAWING**
SEE DISCLAIMER,
SHEET 1.
VERSION 4.1
12-9-97

MSA Murray Smith & Associates, Inc.
Engineers/Planners
121 S.W. Salmon, Suite 900 PHONE 503-225-9010
Portland, Oregon 97204 FAX 503-225-9022




**WATER SUPPLY
IMPROVEMENT
PROJECT
TRANSMISSION
PIPELINE**

**EROSION AND SEDIMENT CONTROL
DETAILS-2**
PROJECT NO.: 07-0873.209 SCALE: AS SHOWN DATE: JUNE 2009

SHEET
ESC-6
19 of 79

C:\Users\dak\appdata\local\temp\AcPublish_3656\07-0873-207-OR-TC-R.dwg TC-1 8/29/2011 1:30 PM DAK 18.1s (LMS Tech)

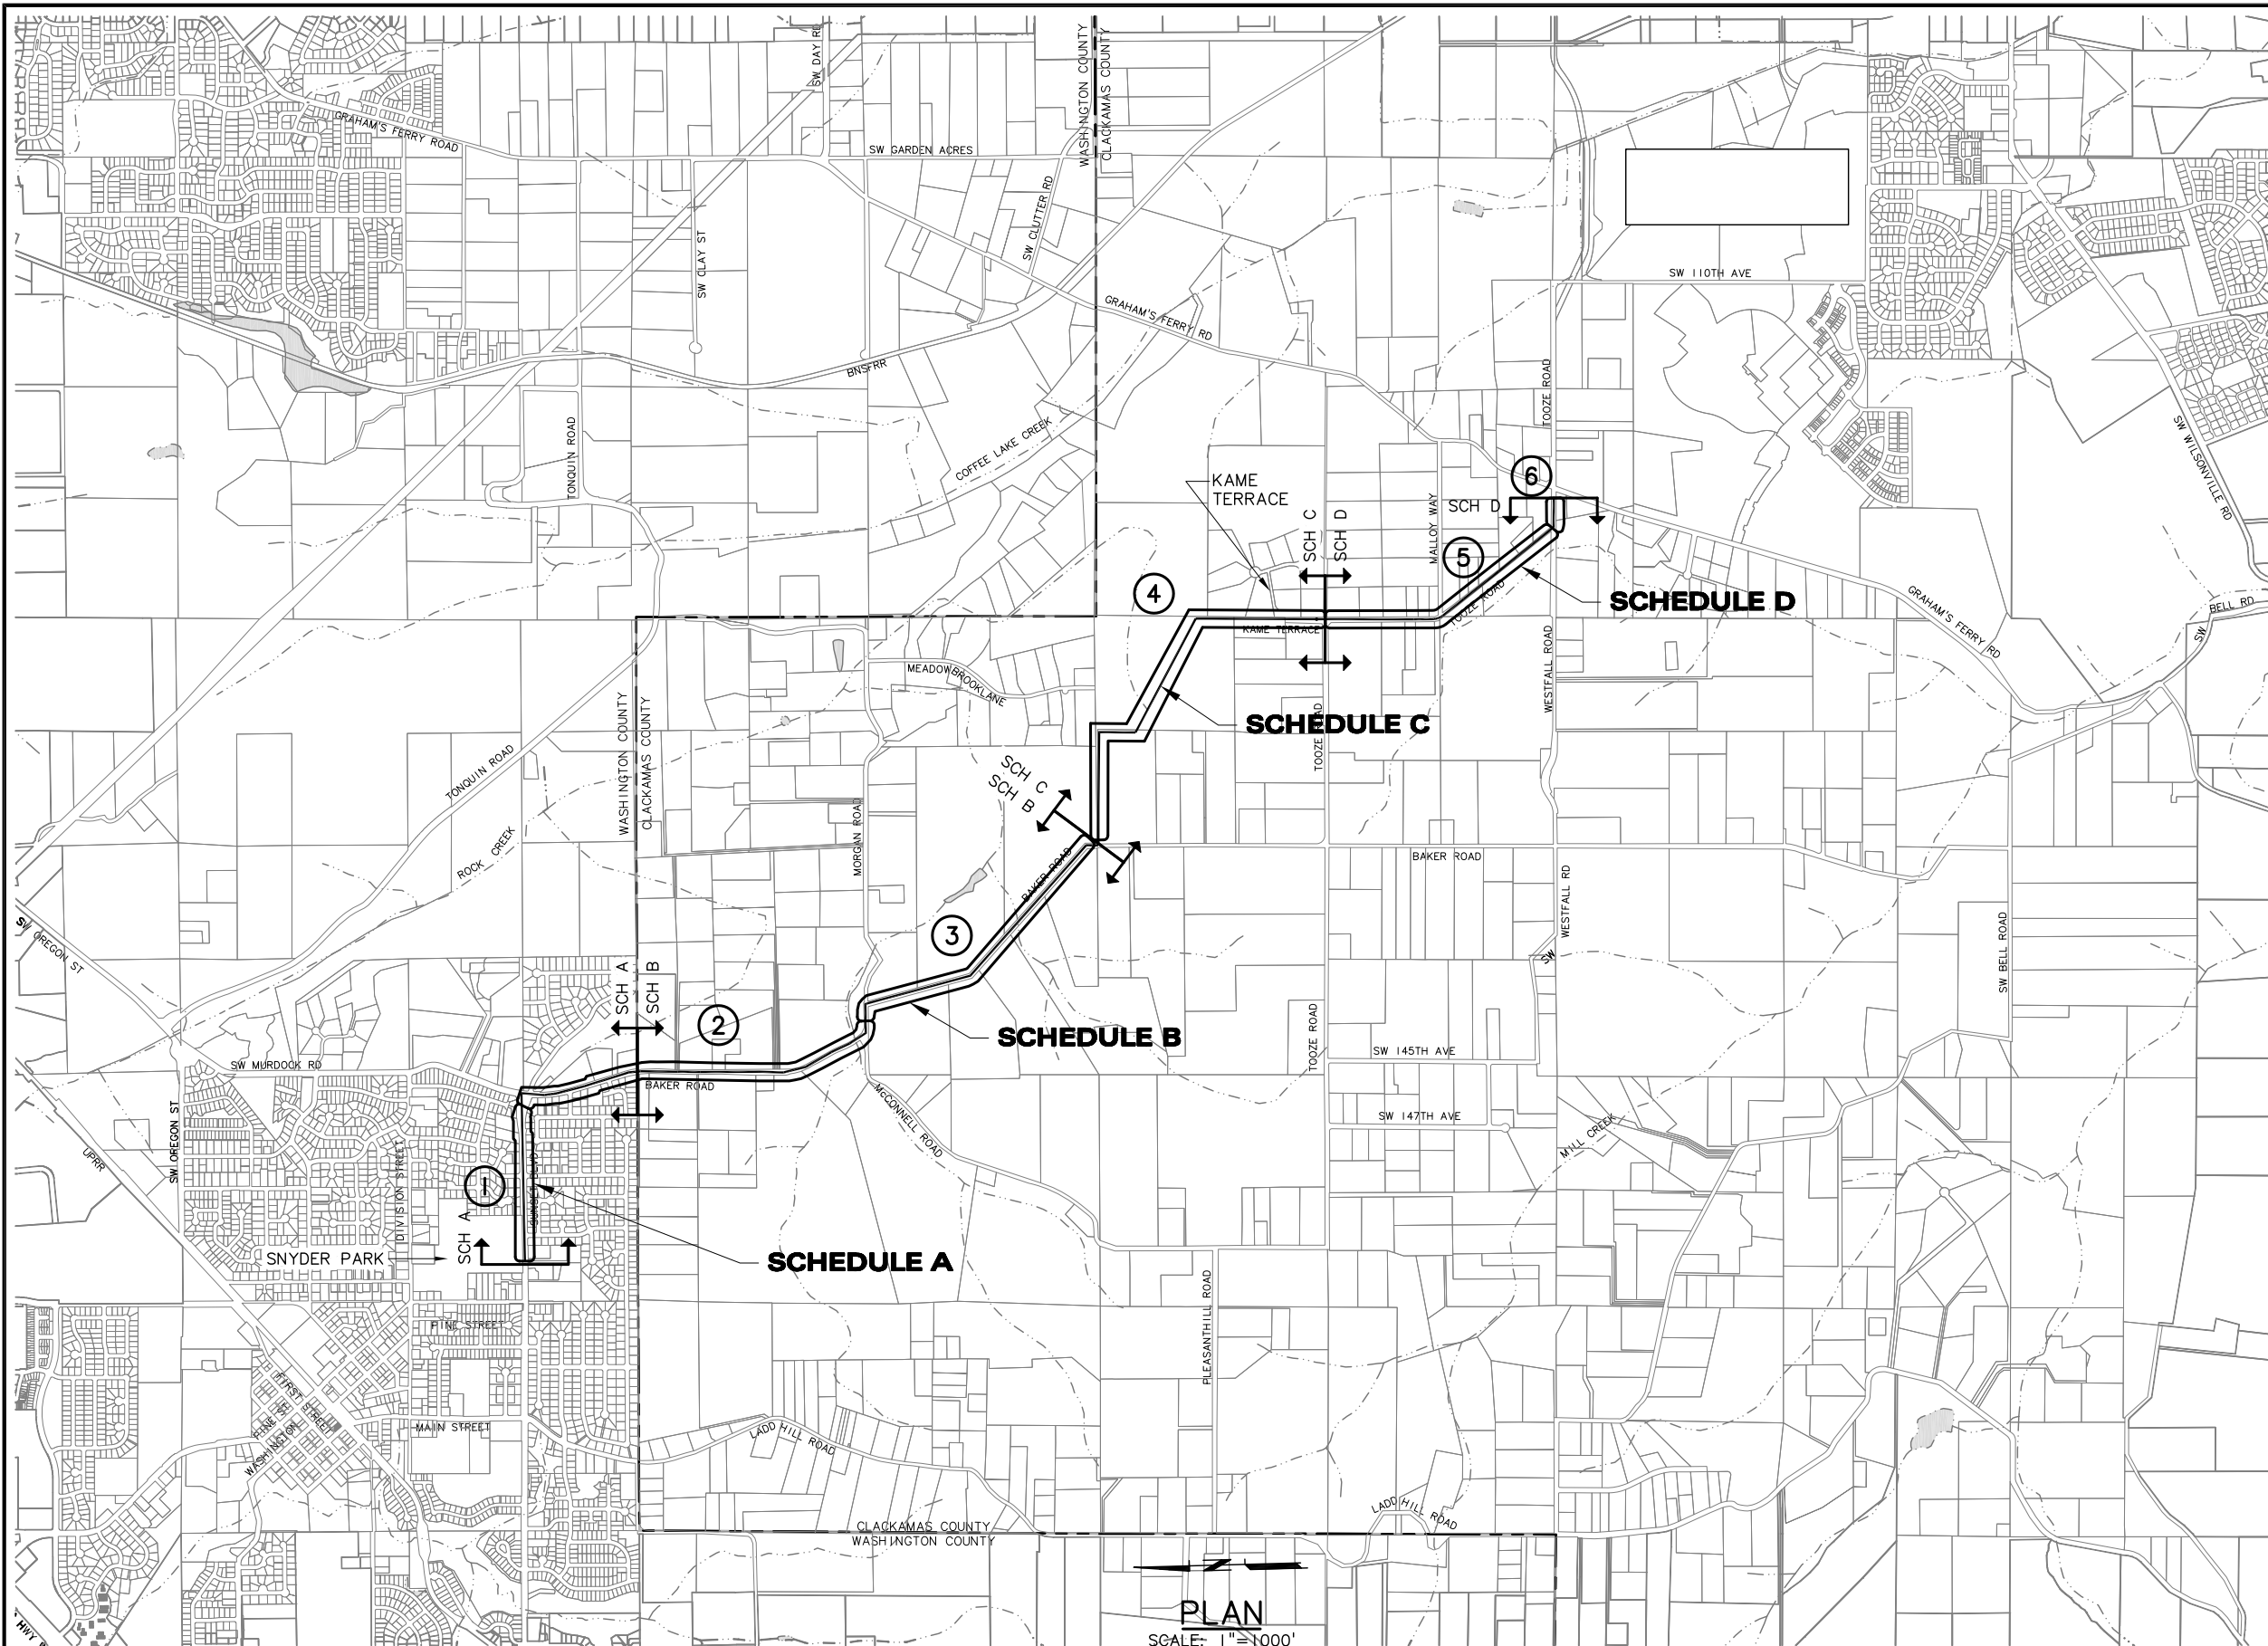

NOTES:

- TEMPORARY TRAFFIC CONTROL SHALL BE IN ACCORDANCE WITH THESE PLANS, CITY AND COUNTY REQUIREMENTS AND THE LATEST VERSION OF THE MANUAL ON UNIFORM TRAFFIC CONTROL DEVICES (MUTCD)

CONSTRUCTION SCHEDULES:

SCHEDULE A: FROM PINE ST AT SNYDER PARK, TO BAKER/MURDOCK ROAD AT THE CITY LIMITS/COUNTY LINE

SCHEDULE B: BAKER/MURDOCK ROAD FROM CITY LIMITS/ COUNTY LINE TO 1.3 MILES SOUTH OF THE COUNTY LINE

SCHEDULE C: PRIVATE PROPERTY

SCHEDULE D: TOOZE RD FROM KAME TERRACE TO 262' WEST OF INTERSECTION WITH GRAHAM'S FERRY ROAD

- COUNTY ROADS SHALL NOT BE SHUT DOWN TO THROUGH TRAFFIC FOR MORE THAN SIX MONTHS CONSECUTIVELY. CONTRACTOR TO COMPLY BY CLACKAMAS COUNTY REQUIREMENTS. CLOSURE FOR MORE THAN SIX MONTHS CONSECUTIVELY WILL REQUIRE APPROVAL OF THE CLACKAMAS COUNTY BOARD OF COMMISSIONERS.

- STREET CLOSURE/DETOUR PHASING:**
- ① SUNSET BLVD – REF. TC-2
 - ② BAKER ROAD NORTH OF MCCONNELL – REF. TC-3
 - ③ BAKER ROAD – SOUTH OF MCCONNELL – REF. TC-4
 - ④ PRIVATE PROPERTY (NO ROAD CLOSURE)
 - ⑤ TOOZE ROAD NORTH OF WESTFALL ROAD – REF. TC-5
 - ⑥ TOOZE ROAD EAST OF WESTFALL ROAD – REF. TC-6

PLAN
SCALE: 1" = 1000'

NO.	DATE	BY	REVISION
1	08/22/11	BVO	RECORD DRAWING

NOTICE

0 1/2 1

IF THIS BAR DOES NOT MEASURE 1" THEN DRAWING IS NOT TO SCALE

SMG DESIGNED
DAK DRAWN
MLH CHECKED

RECORD DRAWING

SEE DISCLAIMER, SHEET 1.

VERSION 4.1
12-9-97

MSA Murray, Smith & Associates, Inc.
Engineers/Planners

121 S.W. Salmon, Suite 900 PHONE 503-225-9010
Portland, Oregon 97204 FAX 503-225-9022




WATER SUPPLY IMPROVEMENT PROJECT TRANSMISSION PIPELINE

PRELIMINARY TRAFFIC CONTROL PLAN OVERVIEW

PROJECT NO.: 07-0873.207 SCALE: AS SHOWN DATE: JUNE 2009

SHEET
TC-1
8 of 79

C:\Users\dak\appdata\local\temp\AcPublish_3656\07-0873-207-OR-TC-R.dwg TC-2 8/29/2011 1:30 PM DAK 18.1s (LMS Tech)

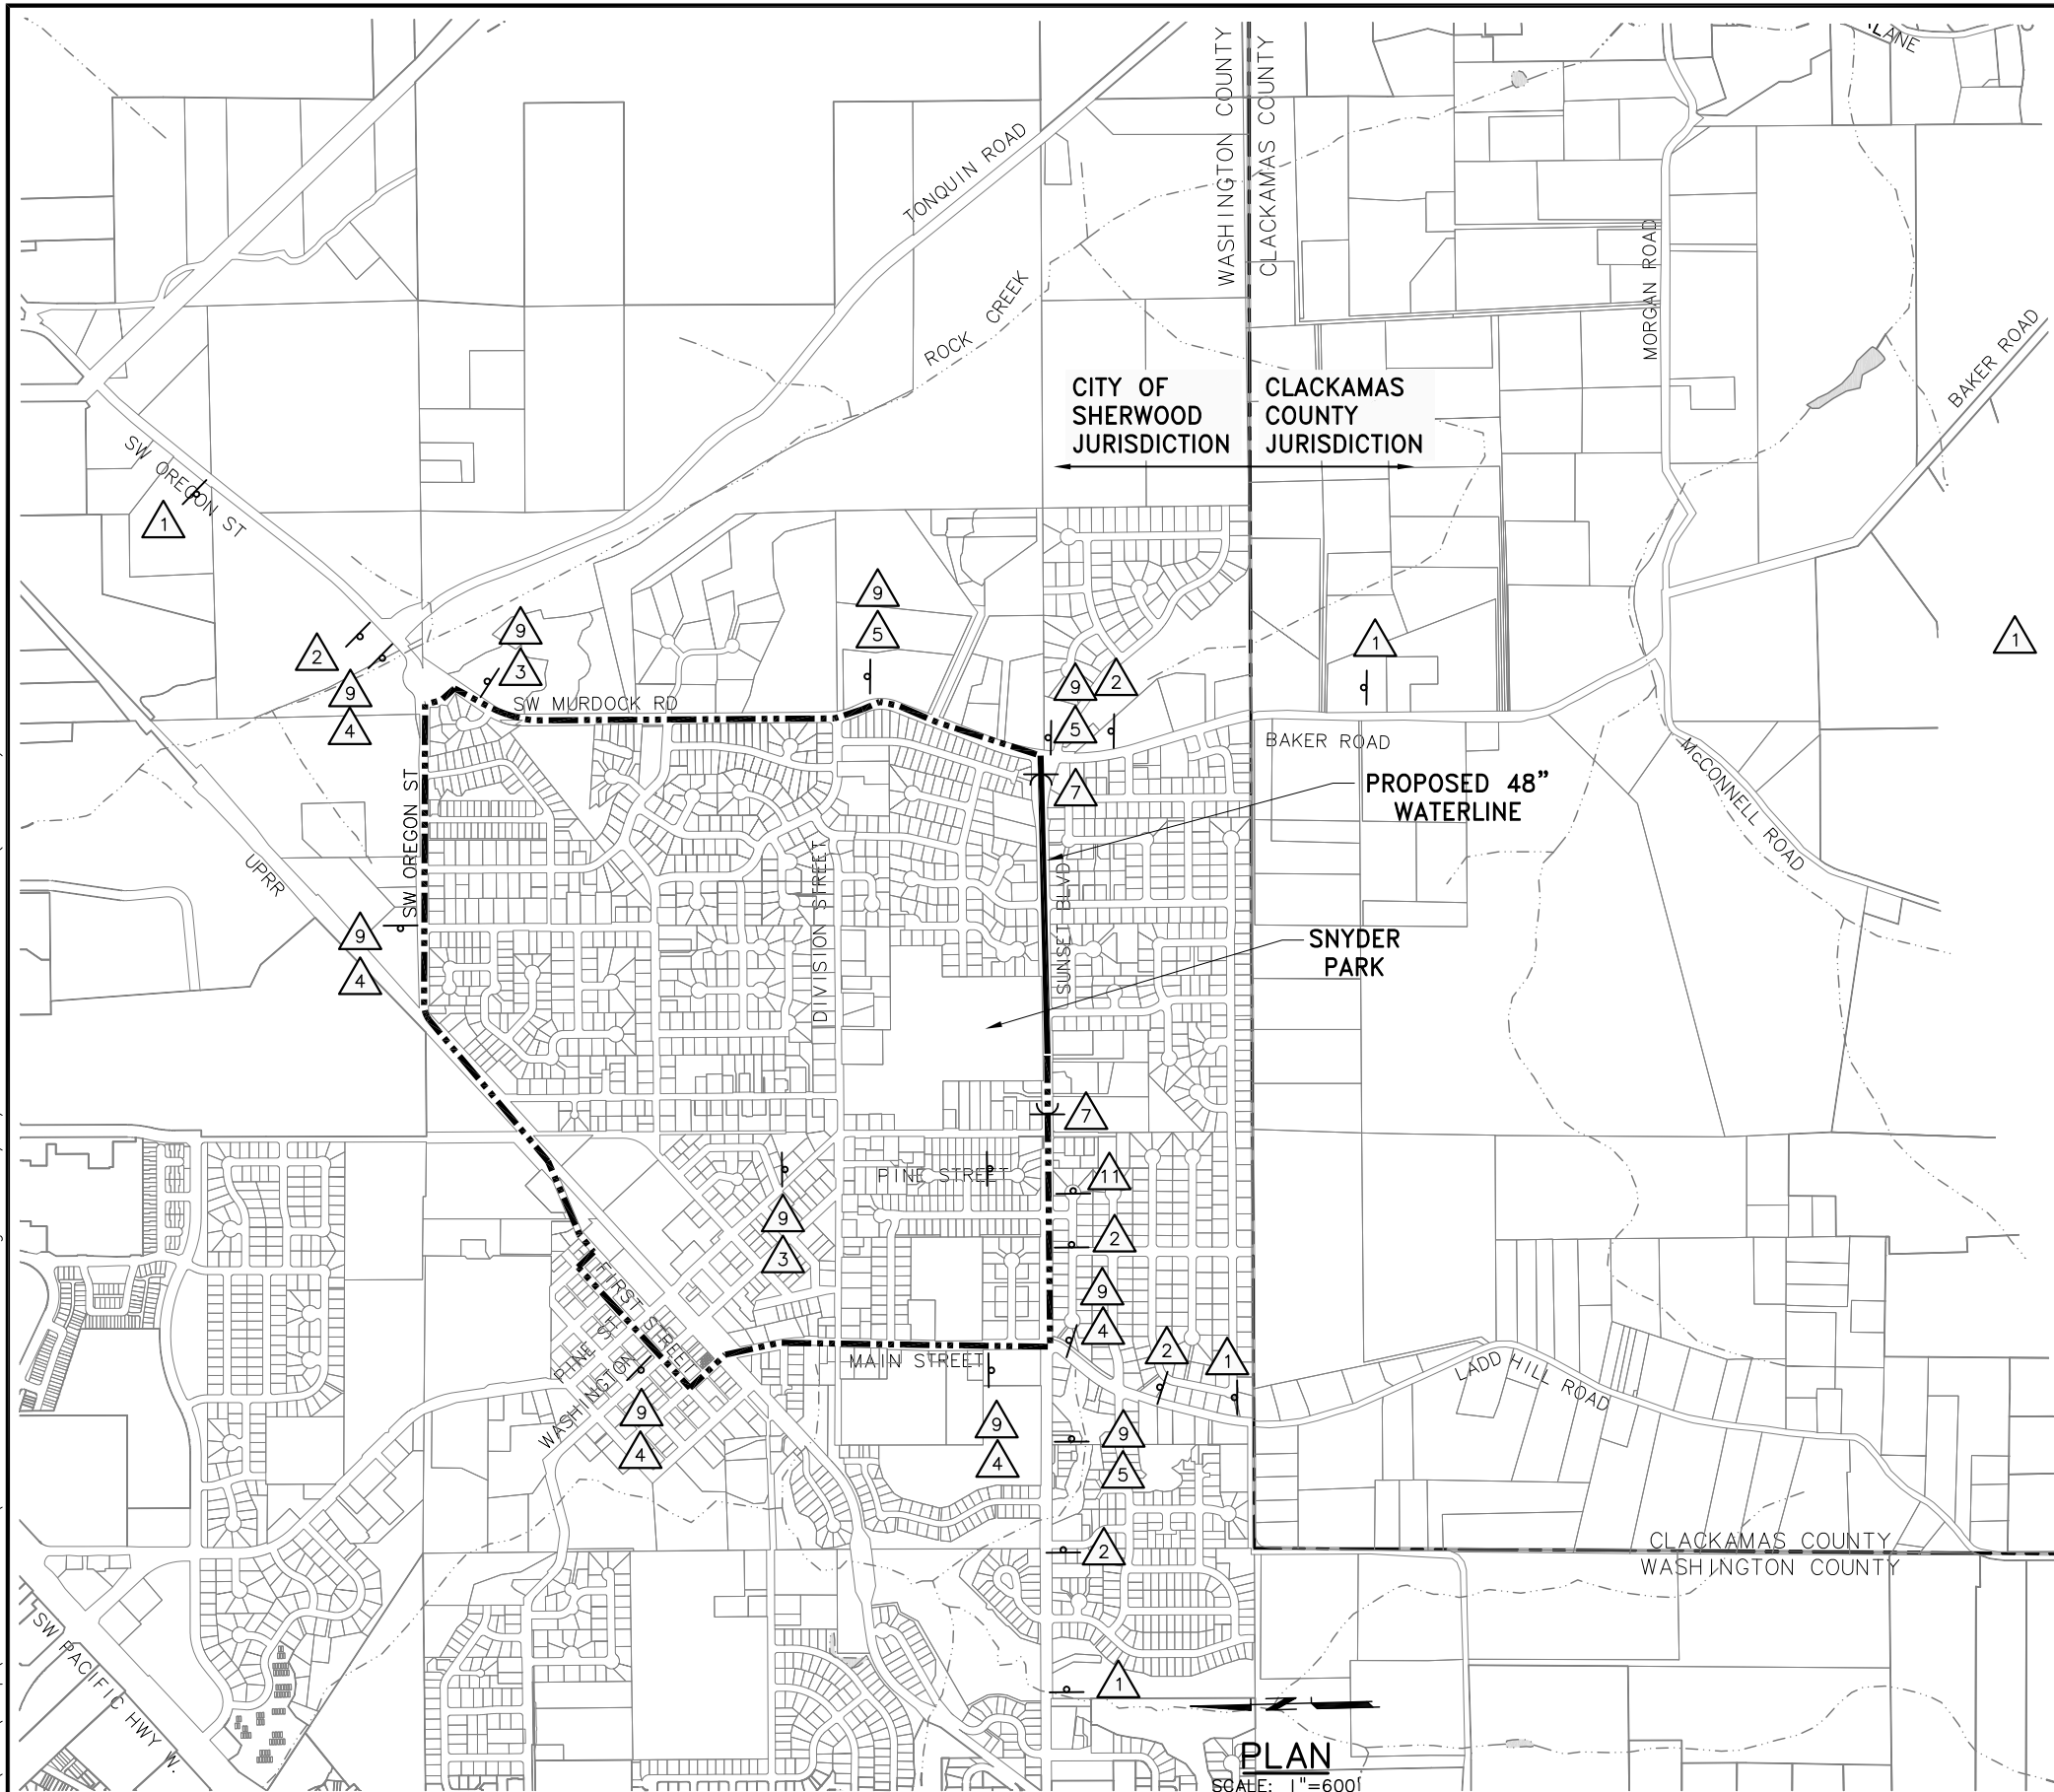

PLAN
SCALE: 1"=600'

SIGN LEGEND

TEMPORARY TYPE 3 BARRICADE
SCALE: NTS

SUNSET BLVD CLOSED BAKER TO PINE XXX TO XXX

LEGEND

- PIPE INSTALLATION
- DETOUR ROUTE
- TEMP TRAFFIC CONTROL SIGN
- TEMP TYPE III BARRICADE. SEE DETAIL THIS SHT.

NOTE:
PROVIDE FLAGGING TO PROMOTE TRAFFIC MOVEMENT AT 4-WAY STOPS ON SW FIRST STREET AT PINE, WASHINGTON AND MAIN DURING HEAVY TRAFFIC TIMES BETWEEN 7:00 AM AND 9:00 AM AND 3:00 PM AND 6:00 PM ON WEEKDAYS.

NO.	DATE	BY	REVISION
1	08/22/11	BVO	RECORD DRAWING

NOTICE

0 1/2 1

IF THIS BAR DOES NOT MEASURE 1" THEN DRAWING IS NOT TO SCALE

SMG DESIGNED
DAK DRAWN
MLH CHECKED

RECORD DRAWING

SEE DISCLAIMER, SHEET 1.

VERSION 4.1
12-9-97

MSA Murray Smith & Associates, Inc.
Engineers/Planners

121 S.W. Salmon, Suite 900 PHONE 503-225-9010
Portland, Oregon 97204 FAX 503-225-9022

City of Sherwood Oregon

WATER SUPPLY IMPROVEMENT PROJECT TRANSMISSION PIPELINE


PRELIMINARY TRAFFIC CONTROL PLAN

SUNSET BLVD CLOSURE

PROJECT NO.: 07-0873.207 SCALE: AS SHOWN DATE: JUNE 2009

SHEET
TC-2
9 of 79

C:\Users\dak\appdata\local\temp\AcPublish_3656\07-0873-207-OR-TC-R.dwg TC-3 8/29/2011 1:30 PM DAK 18.1s (LMS Tech)

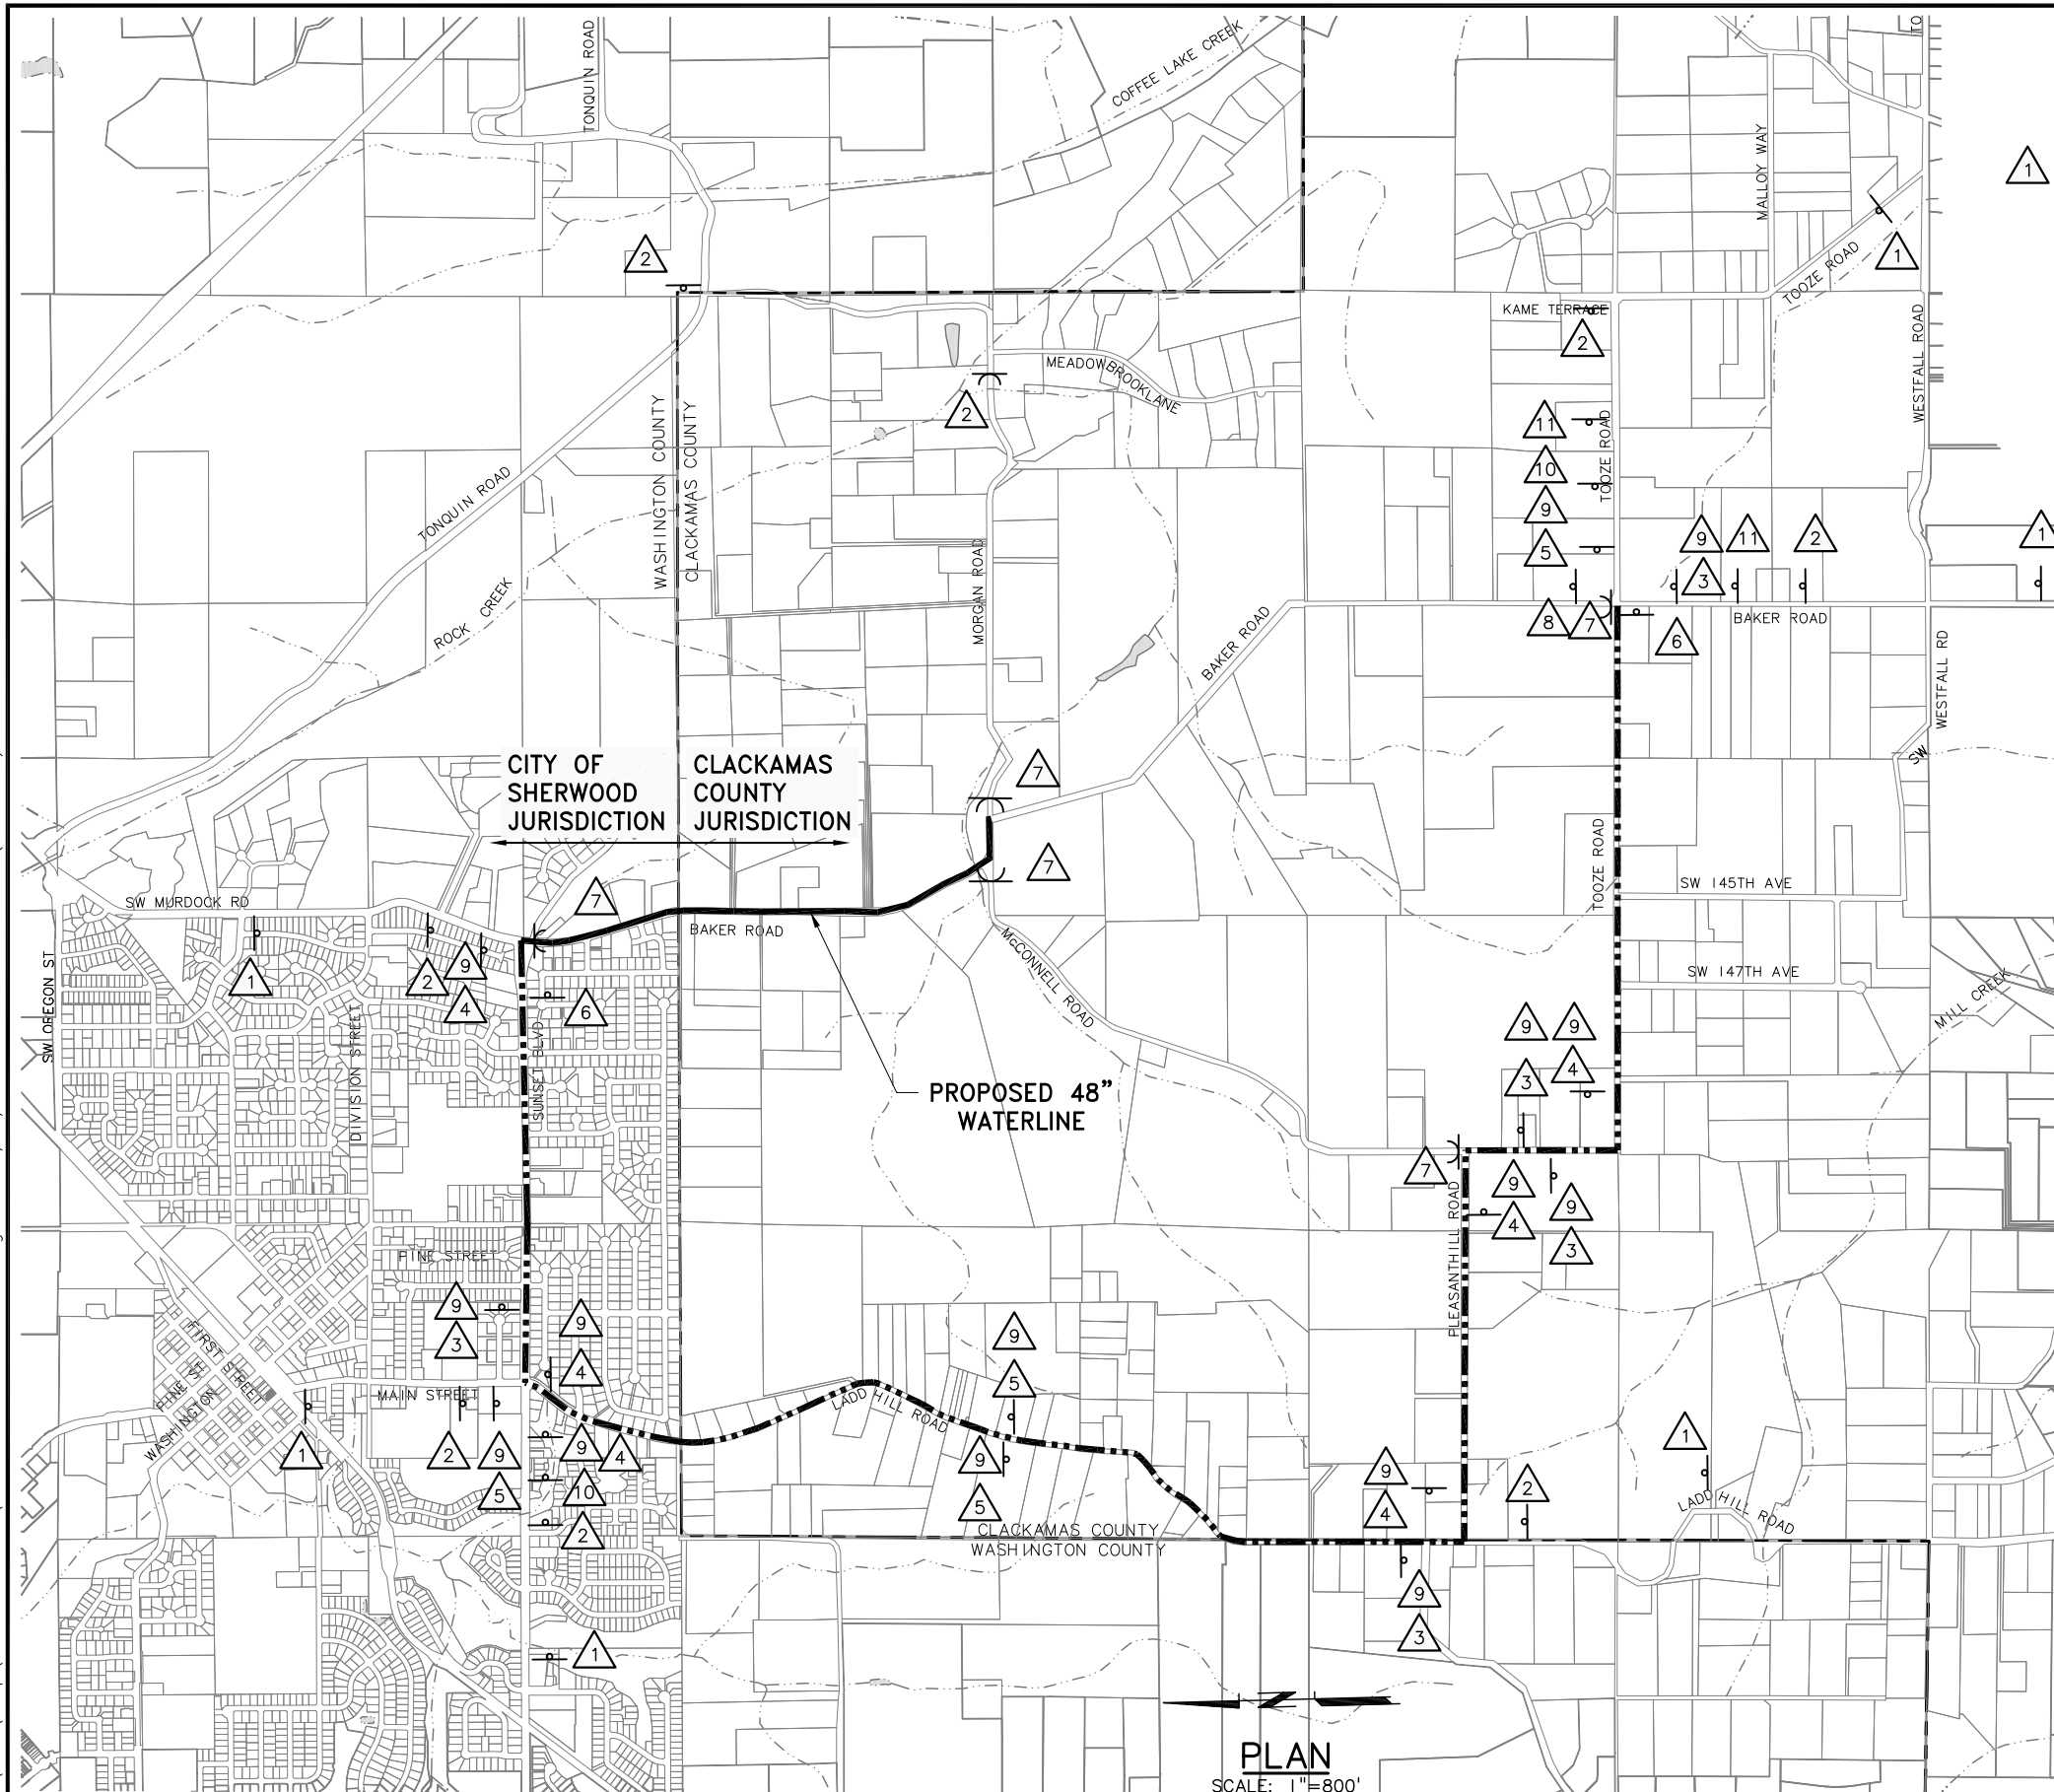

PLAN
SCALE: 1"=800'

8'-0"

12"

4'-0"

TRANSMISSION PIPELINE IMPROVEMENTS
Duration: xxxxxxxx to xxxxxxxx
Owner: CITY OF SHERWOOD
Contact: Craig Sheldon, Public Works, (503) 625-5722
Engineer: Murray Smith and Associates, Inc.
Contractor: xxxxxxxx xxxxxxxx
Emergency Contact: xxxxxxxx-xxxx

SIGN LEGEND

3

4

5

6

7

8

9

10

11

7'-6"

3'-0"

BAKER RD CLOSED
MCCONNELL TO SUNSET
XXX TO XXX

6"C

6"C

6"C

DETOUR

M4-9L
30"x24"

DETOUR

M4-9R
30"x24"

DETOUR

M3
30"x36"

END
DETOUR

M4-8a
30"x24"

ROAD CLOSED
LOCAL ACCESS ONLY

R11-3a
60"x30"

ROAD CLOSED
1/2 MILES AHEAD
LOCAL ACCESS ONLY

R11-3a
60"x30"

BAKER RD

6"C

3'-6"

DETOUR
AHEAD

W 20-2
36"x36"

ROAD
CLOSED
AHEAD

W 20-3
36"x36"

NOTE:
DURATION OF ROAD CLOSURE NOT TO EXCEED SIX (6) CONSECUTIVE MONTHS WITHOUT PRIOR WRITTEN APPROVAL FROM COUNTY.

LEGEND

PIPE INSTALLATION

DETOUR ROUTE

TEMP TRAFFIC CONTROL SIGN

TEMP TYPE III BARRICADE.
(SEE TC-2 FOR DETAILS.)

NO.	DATE	BY	REVISION
1	08/22/11	BVO	RECORD DRAWING

NOTICE

0 1/2 1

IF THIS BAR DOES NOT MEASURE 1" THEN DRAWING IS NOT TO SCALE

SMG DESIGNED

DAK DRAWN

MLH CHECKED

RECORD DRAWING

SEE DISCLAIMER, SHEET 1.

VERSION 4.1
12-9-97

MSA Murray Smith & Associates, Inc.
Engineers/Planners

121 S.W. Salmon, Suite 900 PHONE 503-225-9010
Portland, Oregon 97204 FAX 503-225-9022




WATER SUPPLY IMPROVEMENT PROJECT
TRANSMISSION PIPELINE

PRELIMINARY TRAFFIC CONTROL PLAN
BAKER ROAD
NORTH OF MCCONNELL CLOSURE

PROJECT NO.: 07-0873.207 SCALE: AS SHOWN DATE: JUNE 2009

C:\Users\dak\appdata\local\temp\AcPublish_3656\07-0873-207-OR-TC-R.dwg TC-4 8/29/2011 1:30 PM DAK 18.1s (LMS Tech)

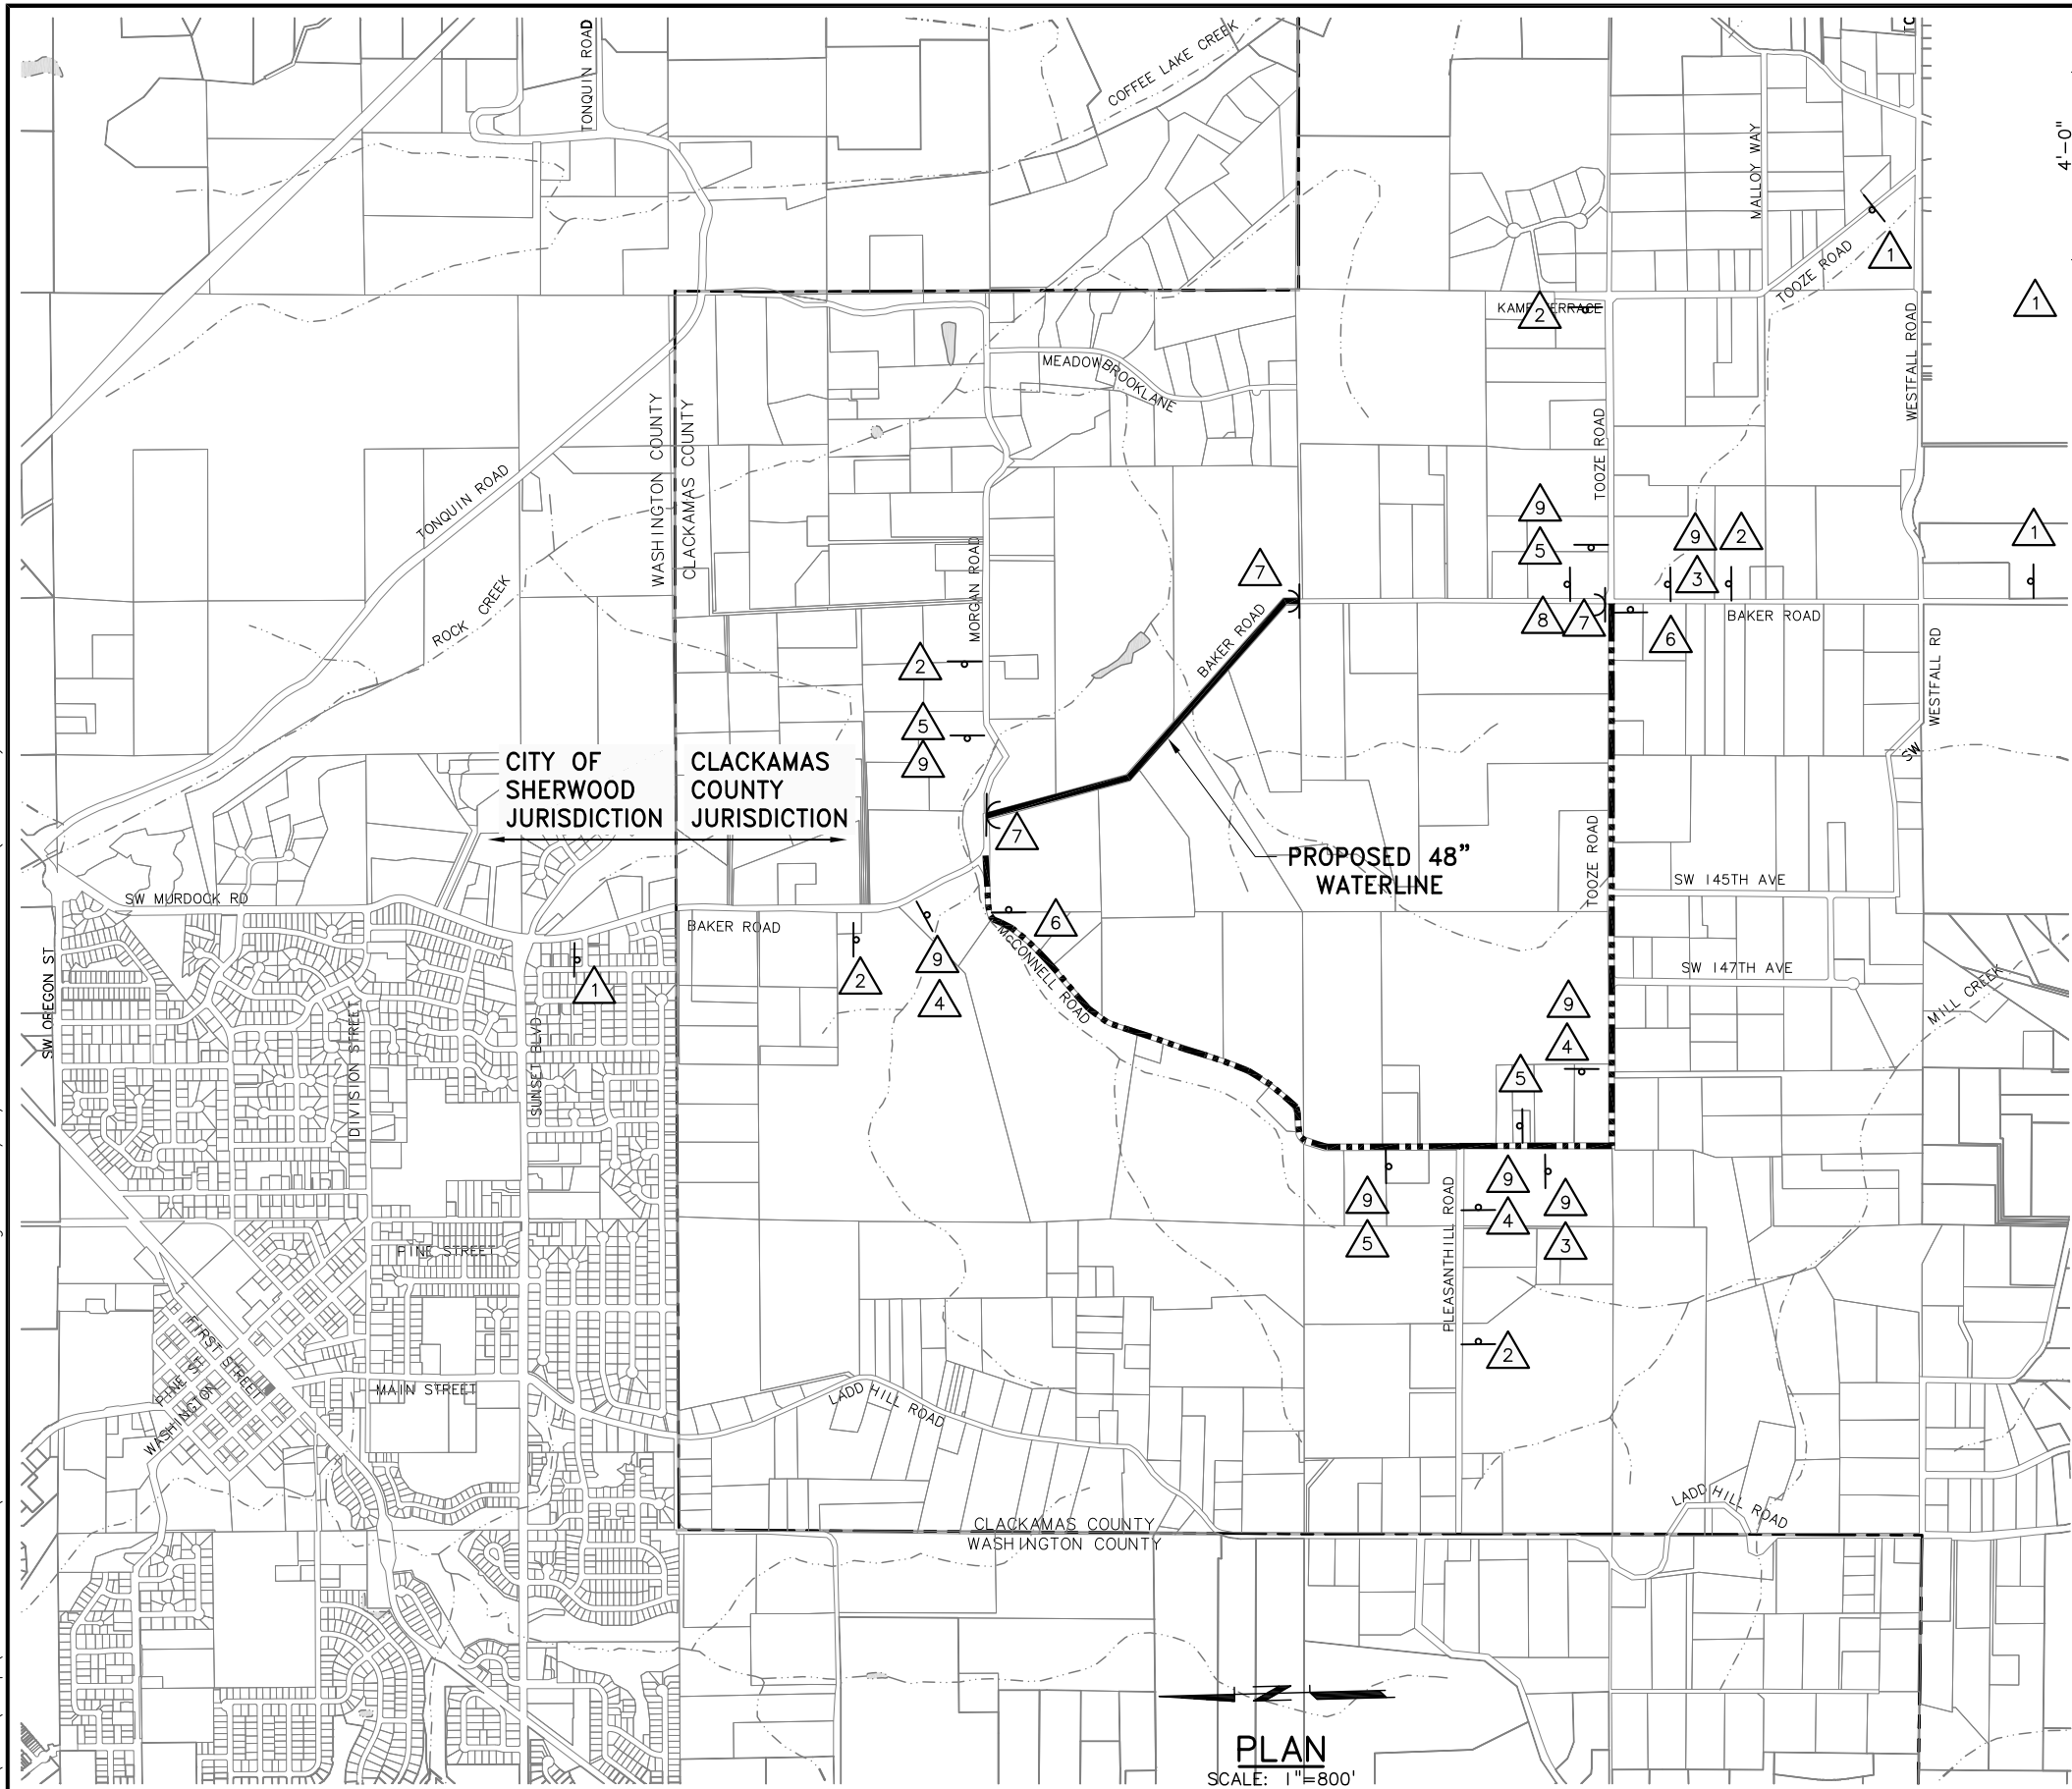

PLAN
SCALE: 1"=800'

TRANSMISSION PIPELINE IMPROVEMENTS
Duration: xxxxxxxx to xxxxxxxx

Owner: CITY OF SHERWOOD
Contact: Craig Sheldon, Public Works, (503) 625-5722
Engineer: Murray Smith and Associates, Inc.
Contractor: xxxxxxxx xxxxxxxx
Emergency Contact: xxxxxxxx-xxxx

SIGN LEGEND

- 3 M4-9L 30"x24"
- 4 M4-9R 30"x24"
- 5 M3 30"x36"
- 6 M4-8a 30"x24"
- 7 R11-3a 60"x30"
- 8 R11-3a 60"x30"
- 9 I6"C 3'-6"
- 10 W 20-2 36"x36"
- 11 W 20-3 36"x36"

**BAKER RD CLOSED
TOOZE TO MCCONNELL
XXX TO XXX**

NOTE:
DURATION OF ROAD CLOSURE NOT TO EXCEED SIX (6) CONSECUTIVE MONTHS WITHOUT PRIOR WRITTEN APPROVAL FROM COUNTY.

LEGEND

- PIPE INSTALLATION
- DETOUR ROUTE
- TEMP TRAFFIC CONTROL SIGN
- TEMP TYPE III BARRICADE. (SEE TC-2 FOR DETAILS.)

NO.	DATE	BY	REVISION
1	08/22/11	BVO	RECORD DRAWING

NOTICE

0 1/2 1

IF THIS BAR DOES NOT MEASURE 1" THEN DRAWING IS NOT TO SCALE

SMG DESIGNED
DAK DRAWN
MLH CHECKED

RECORD DRAWING

SEE DISCLAIMER, SHEET 1.

VERSION 4.1
12-9-97

MSA Murray Smith & Associates, Inc.
Engineers/Planners

121 S.W. Salmon, Suite 900 PHONE 503-225-9010
Portland, Oregon 97204 FAX 503-225-9022




**WATER SUPPLY IMPROVEMENT PROJECT
TRANSMISSION PIPELINE**

**PRELIMINARY TRAFFIC CONTROL PLAN
BAKER ROAD
SOUTH OF MCCONNELL CLOSURE**

PROJECT NO.: 07-0873.207 SCALE: AS SHOWN DATE: JUNE 2009

C:\Users\dak\appdata\local\temp\AcPublish_3656\07-0873-207-OR-TC-R.dwg TC-5 8/29/2011 1:30 PM DAK 18.1s (LMS Tech)

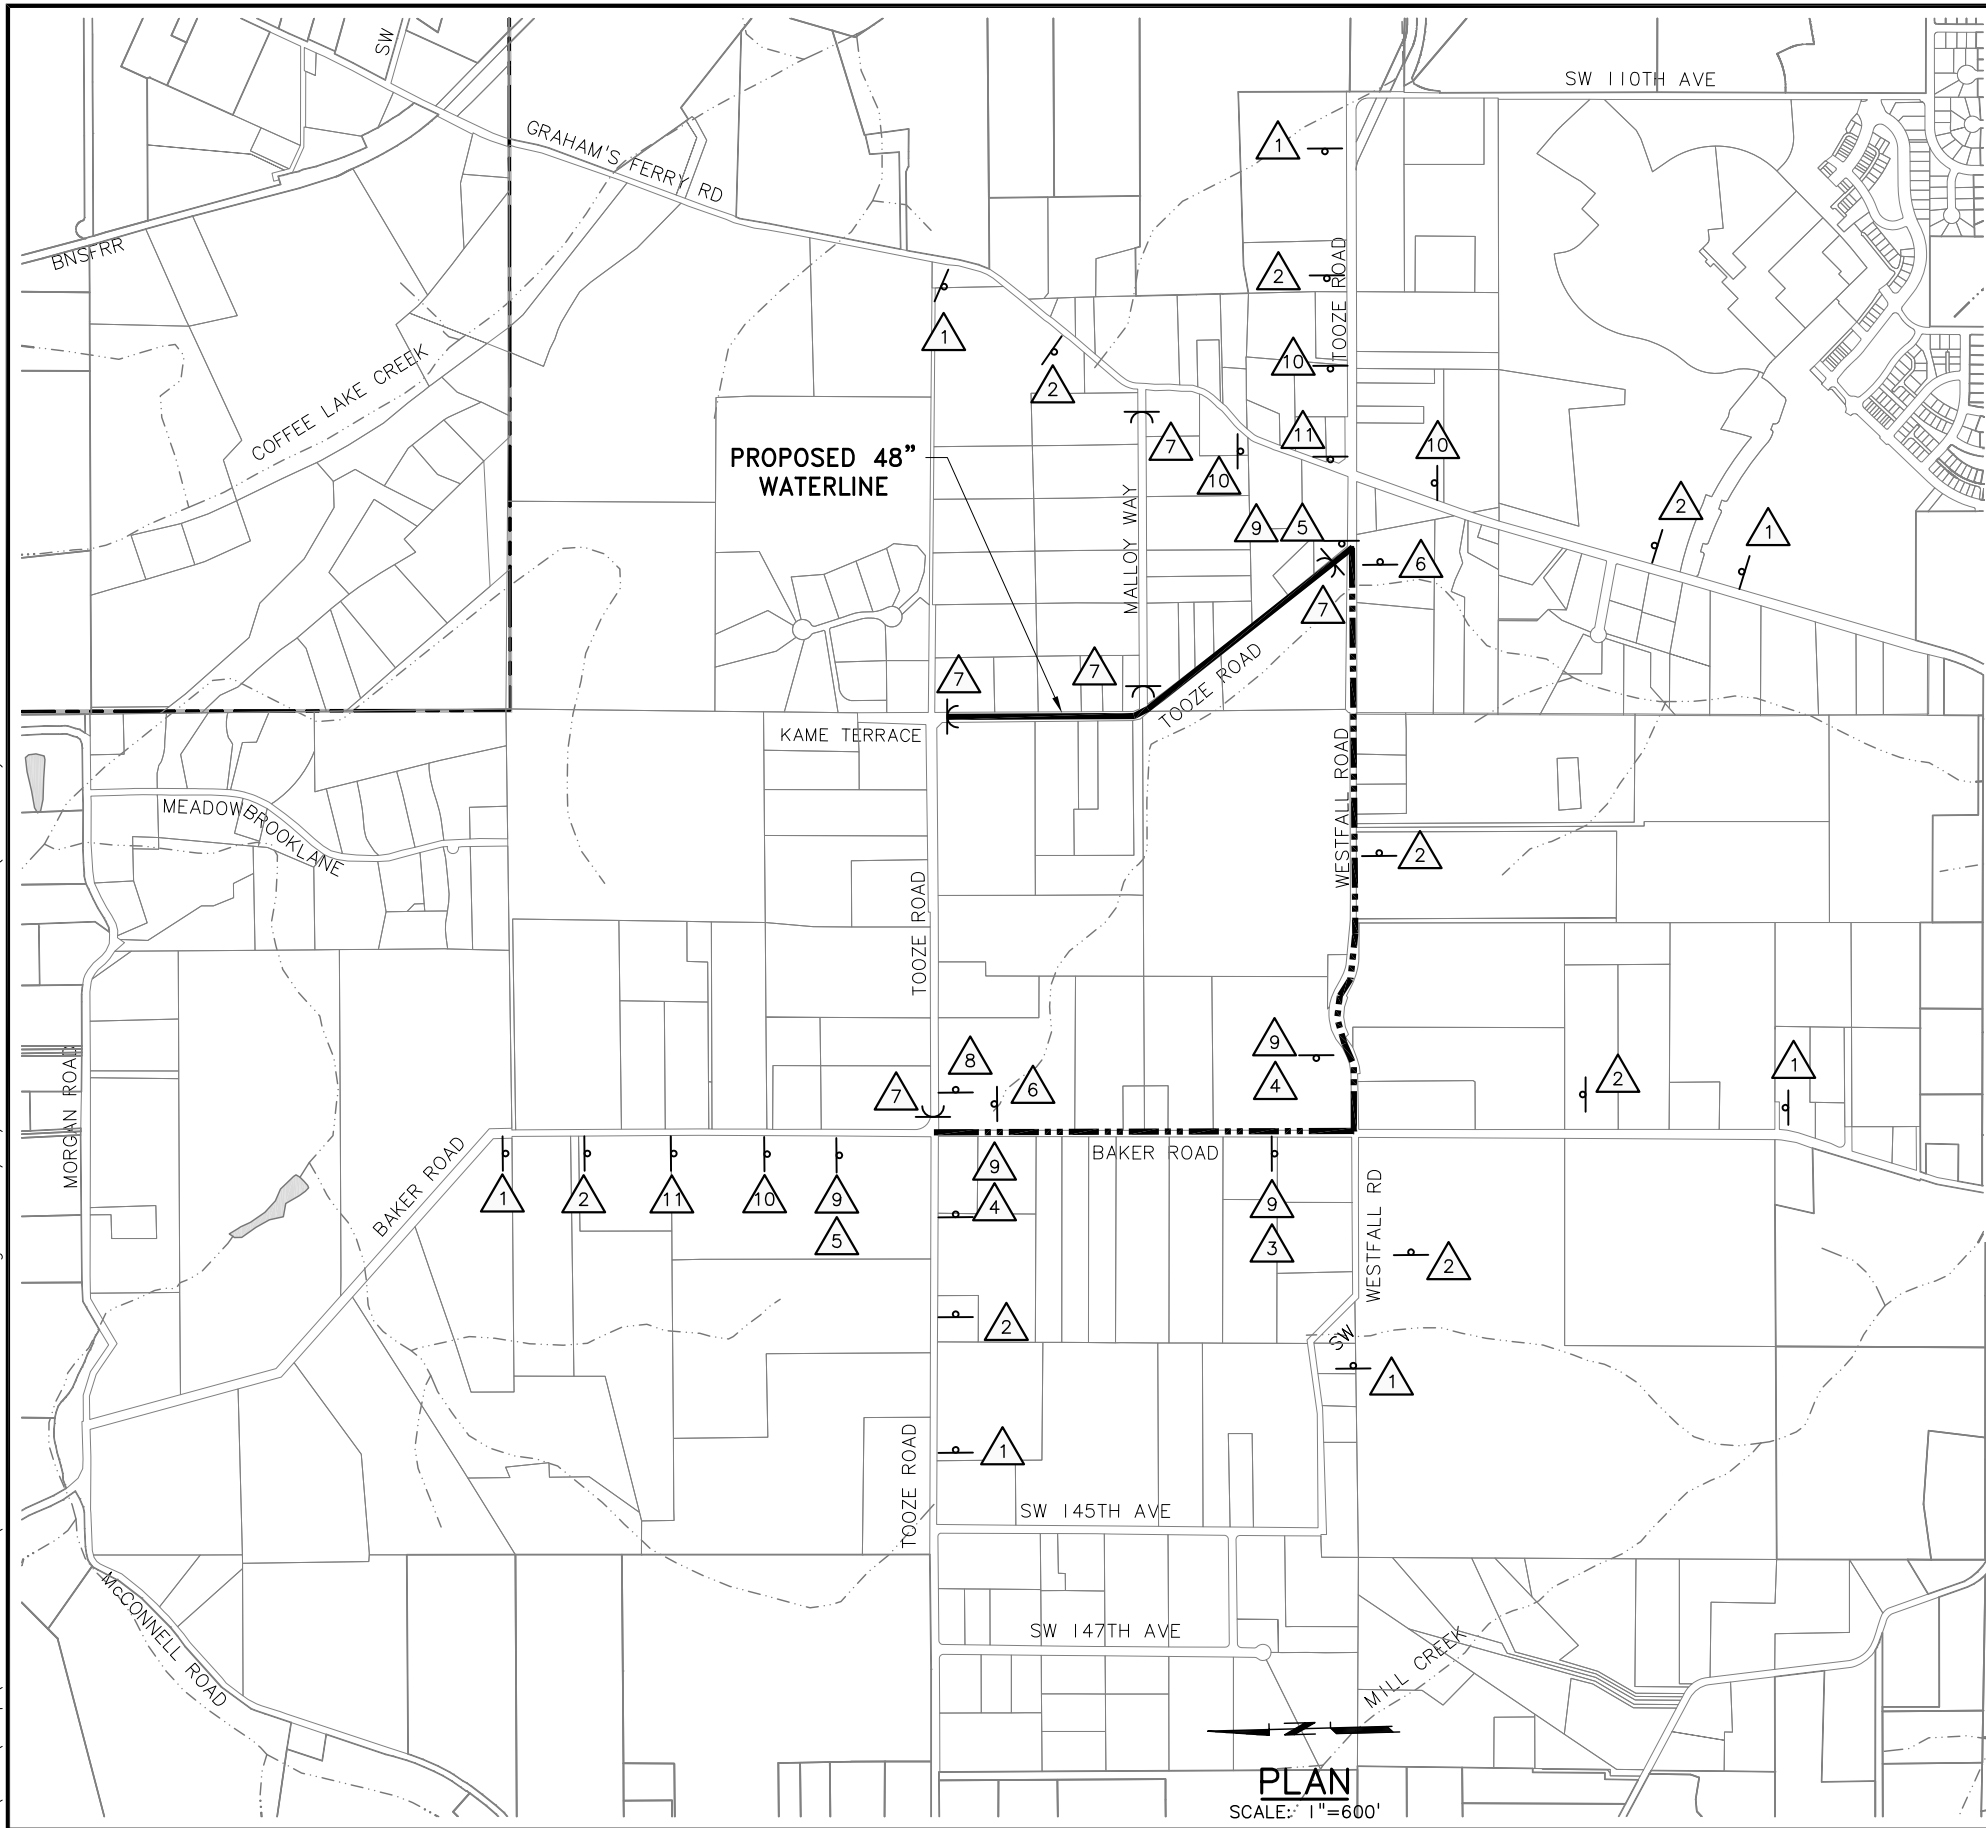

PLAN
SCALE: 1"=600'

TRANSMISSION PIPELINE IMPROVEMENTS
Duration: xxxxxxxx to xxxxxxxx

Owner: CITY OF SHERWOOD
Contact: Craig Sheldon, Public Works, (503) 625-5722
Engineer: Murray Smith and Associates, Inc.
Contractor: xxxxxxxx xxxxxxxx
Emergency Contact: xxxxxxxx-xxxx

SIGN LEGEND

- DETOUR**
M4-9L
30"x24"
- DETOUR**
M4-9R
30"x24"
- DETOUR**
M3
30"x36"
- END DETOUR**
M4-8a
30"x24"
- ROAD CLOSED**
LOCAL ACCESS ONLY
R11-3a
60"x30"
- ROAD CLOSED**
1/2 MILES AHEAD
LOCAL ACCESS ONLY
R11-3a
60"x30"
- TOOZE RD**
I6"C
3'-6"
- DETOUR AHEAD**
W 20-2
36"x36"
- ROAD CLOSED AHEAD**
W 20-3
36"x36"

LEGEND

- PIPE INSTALLATION
- DETOUR ROUTE
- TEMP TRAFFIC CONTROL SIGN
- TEMP TYPE III BARRICADE.
(SEE TC-2 FOR DETAILS.)

NOTE:
DURATION OF ROAD CLOSURE NOT TO EXCEED SIX (6) CONSECUTIVE MONTHS WITHOUT PRIOR WRITTEN APPROVAL FROM COUNTY.

NO.	DATE	BY	REVISION
1	08/22/11	BVO	RECORD DRAWING

NOTICE

0 1/2 1

IF THIS BAR DOES NOT MEASURE 1" THEN DRAWING IS NOT TO SCALE

SMG DESIGNED
DAK DRAWN
MLH CHECKED

RECORD DRAWING

SEE DISCLAIMER, SHEET 1.

VERSION 4.1
12-9-97

MSA Murray Smith & Associates, Inc.
Engineers/Planners

121 S.W. Salmon, Suite 900 PHONE 503-225-9010
Portland, Oregon 97204 FAX 503-225-9022




WATER SUPPLY IMPROVEMENT PROJECT TRANSMISSION PIPELINE


PRELIMINARY TRAFFIC CONTROL PLAN
TOOZE ROAD
NORTH OF WESTFALL CLOSURE

PROJECT NO.: 07-0873.207 SCALE: AS SHOWN DATE: JUNE 2009

C:\Users\dak\appdata\local\temp\AcPublish_3656\07-0873-207-OR-TC-R.dwg TC-6 8/29/2011 1:30 PM DAK 18.1s (LMS Tech)

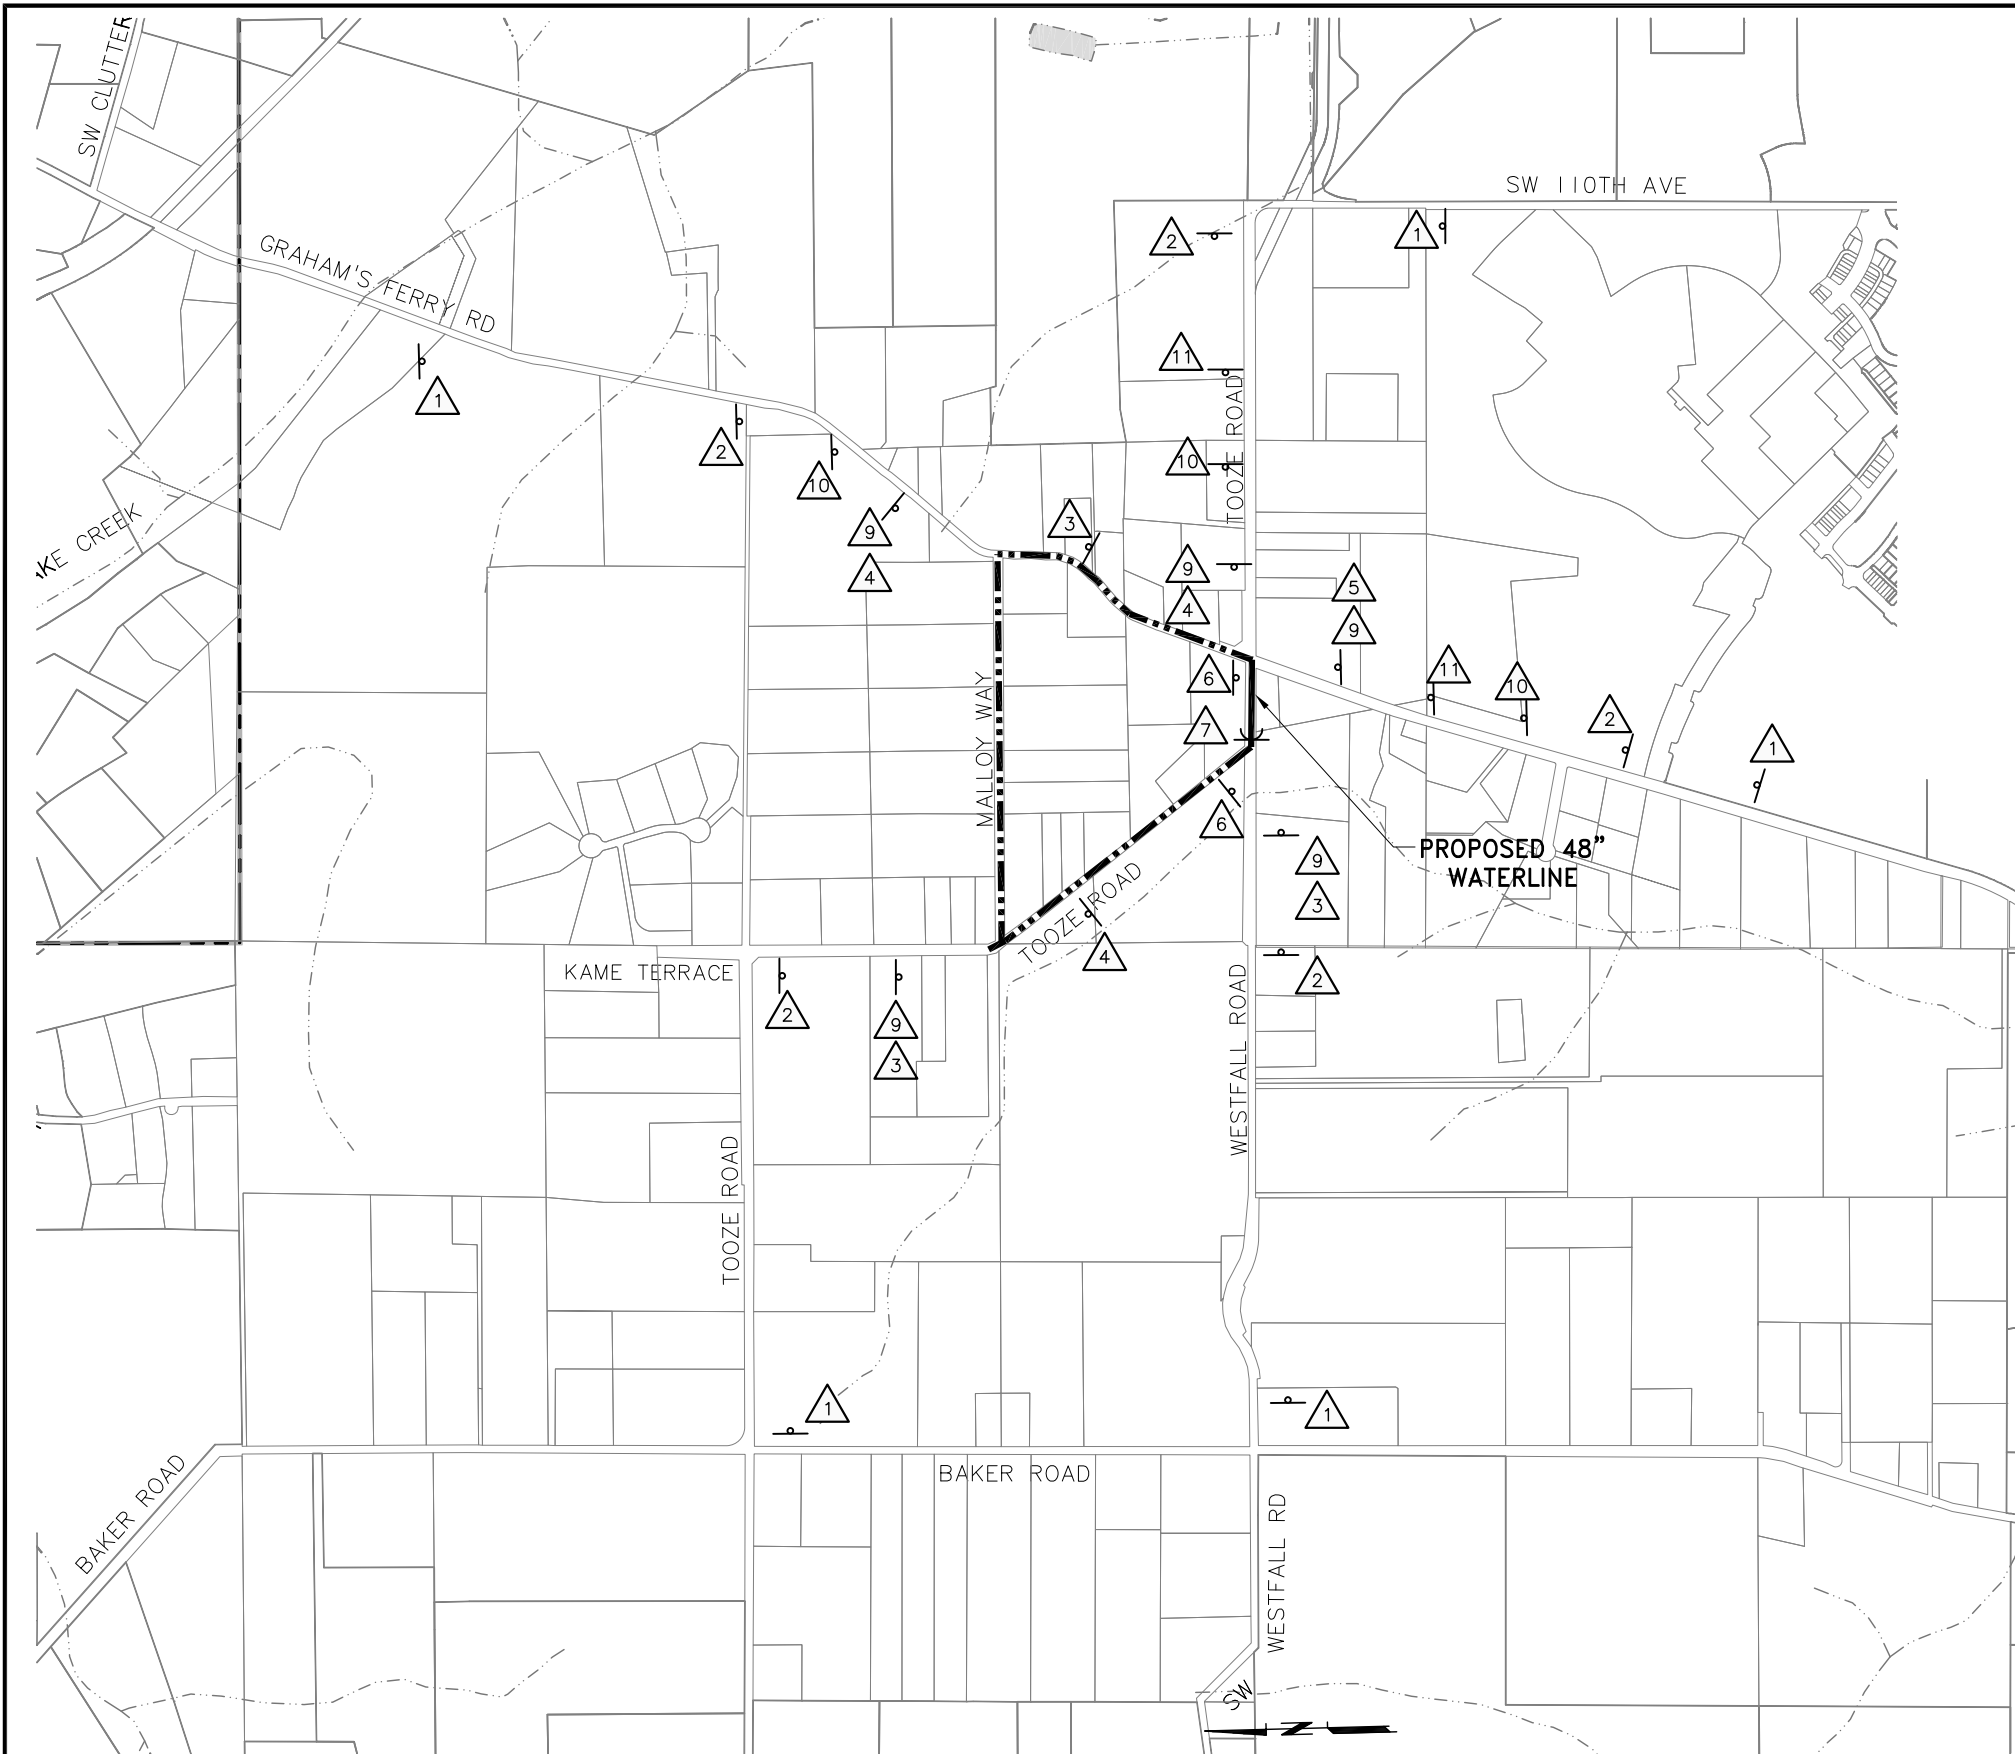

PLAN
SCALE: 1"=500'

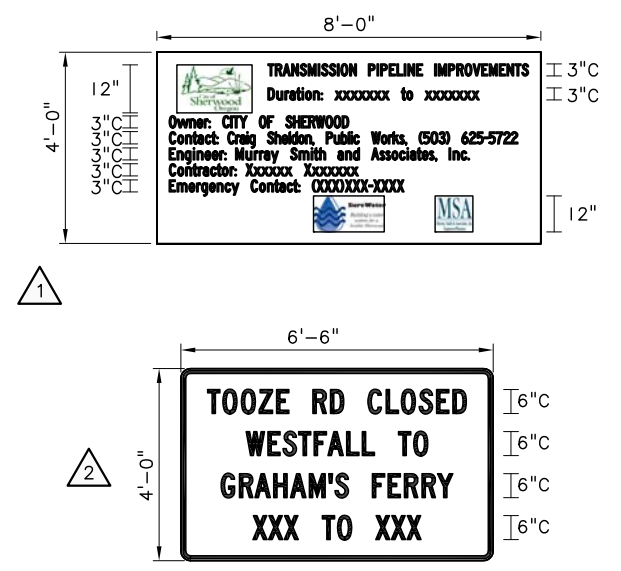

NOTE:
DURATION OF ROAD CLOSURE NOT TO EXCEED SIX (6) CONSECUTIVE MONTHS WITHOUT PRIOR WRITTEN APPROVAL FROM COUNTY.

- LEGEND**
- PIPE INSTALLATION
 - DETOUR ROUTE
 - TEMP TRAFFIC CONTROL SIGN
 - TEMP TYPE III BARRICADE. (SEE TC-2 FOR DETAILS.)

- SIGN LEGEND**
- DETOUR**
M4-9L
30"x24"
 - DETOUR**
M4-9R
30"x24"
 - DETOUR**
M3
30"x36"
 - END DETOUR**
M4-8a
30"x24"
 - ROAD CLOSED**
LOCAL ACCESS ONLY
R11-3a
60"x30"
 - ROAD CLOSED**
1/2 MILES AHEAD
LOCAL ACCESS ONLY
R11-3a
60"x30"
 - TOOZE RD**
I6"C
3'-6"
 - DETOUR AHEAD**
W 20-2
36"x36"
 - ROAD CLOSED AHEAD**
W 20-3
36"x36"

NO.	DATE	BY	REVISION
1	08/22/11	BVO	RECORD DRAWING

NOTICE
0 1/2 1
IF THIS BAR DOES NOT MEASURE 1" THEN DRAWING IS NOT TO SCALE

SMG DESIGNED
DAK DRAWN
MLH CHECKED

RECORD DRAWING
SEE DISCLAIMER, SHEET 1.
VERSION 4.1
12-9-97

MSA Murray Smith & Associates, Inc.
Engineers/Planners
121 S.W. Salmon, Suite 900 PHONE 503-225-9010
Portland, Oregon 97204 FAX 503-225-9022




WATER SUPPLY IMPROVEMENT PROJECT TRANSMISSION PIPELINE

**PRELIMINARY TRAFFIC CONTROL PLAN
TOOZE ROAD
EAST OF WESTFALL CLOSURE**
PROJECT NO.: 07-0873.207 SCALE: AS SHOWN DATE: JUNE 2009

SHEET
TC-6
13 of 79

C:\PDX\Projects\07\0873\207 Design-Final Plans\CAD\07-0873-207-OR-CIVIL A-R.dwg C-1 9/8/2011 11:55 AM DAK 18.lis (LMS Tech)

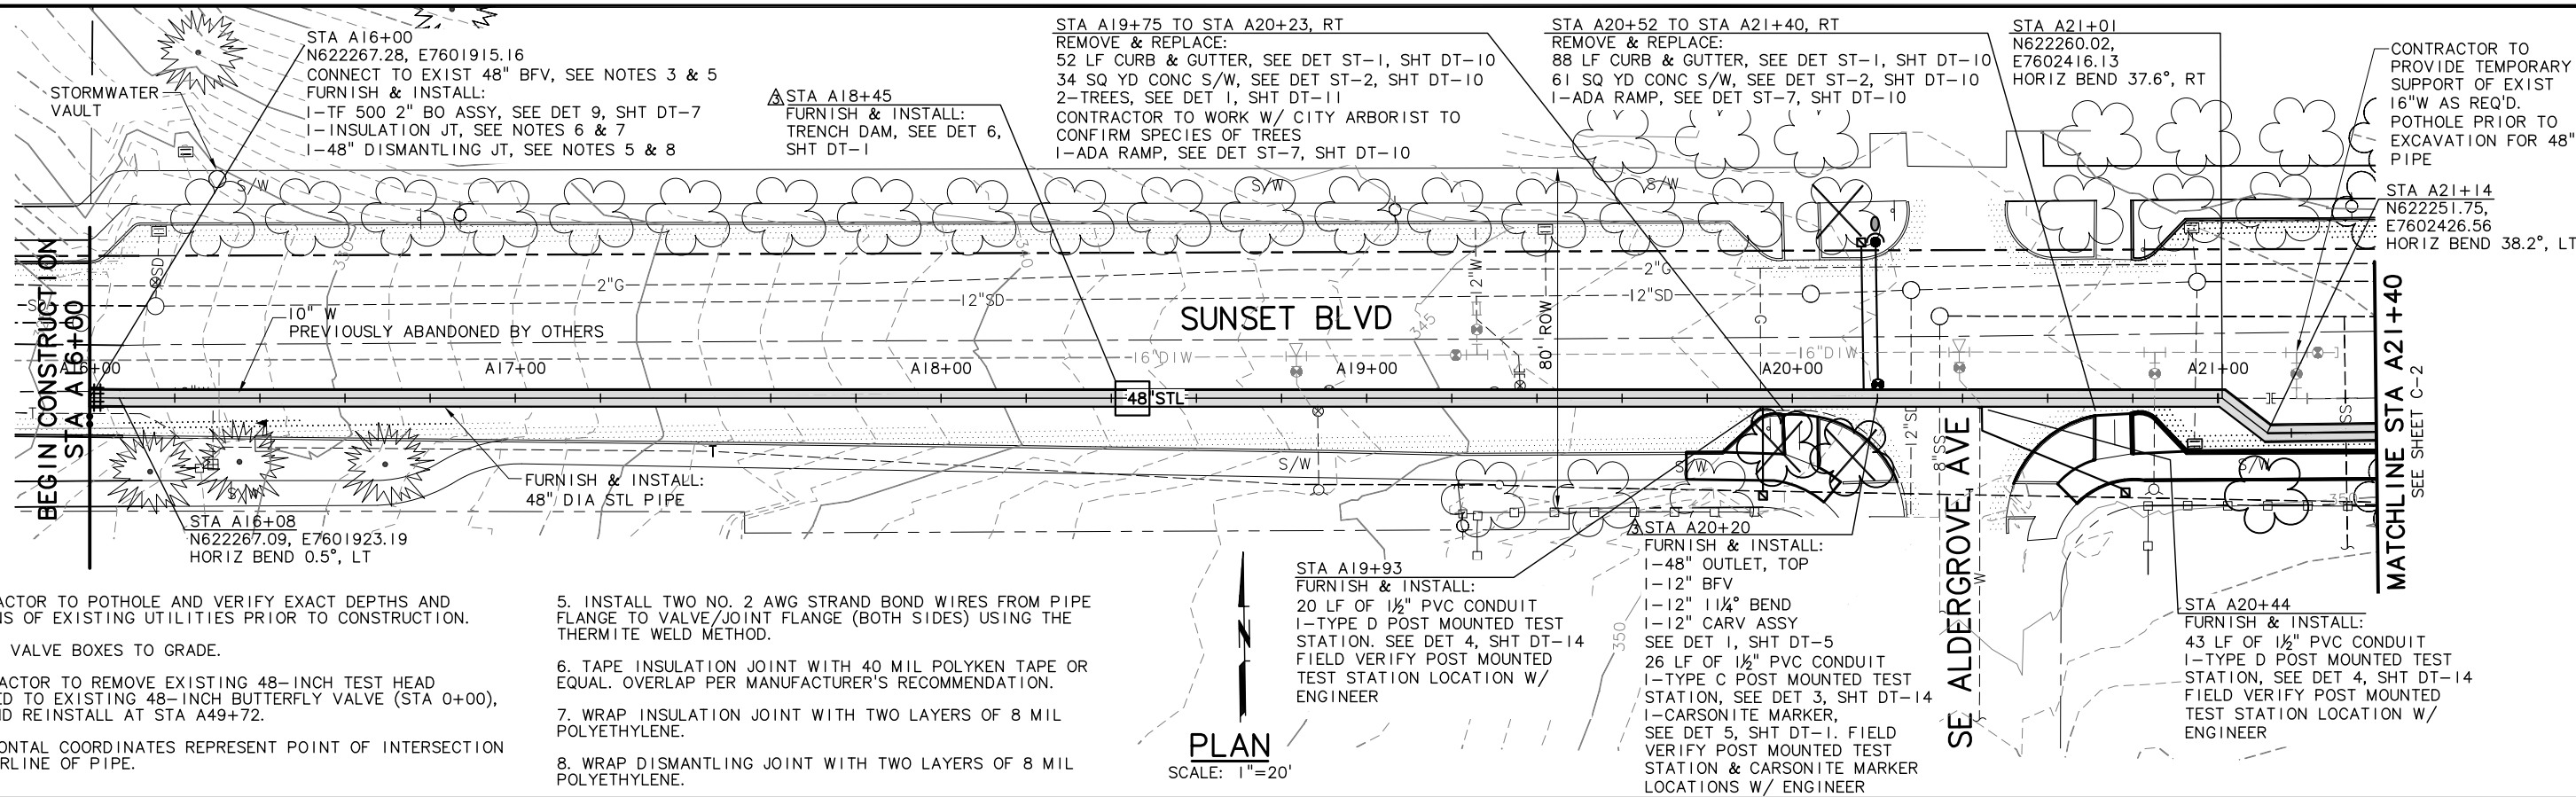


NOTES:

1. CONTRACTOR TO POTHOLE AND VERIFY EXACT DEPTHS AND LOCATIONS OF EXISTING UTILITIES PRIOR TO CONSTRUCTION.
2. ADJUST VALVE BOXES TO GRADE.
3. CONTRACTOR TO REMOVE EXISTING 48-INCH TEST HEAD CONNECTED TO EXISTING 48-INCH BUTTERFLY VALVE (STA 0+00), STORE AND REINSTALL AT STA A49+72.
4. HORIZONTAL COORDINATES REPRESENT POINT OF INTERSECTION OF CENTERLINE OF PIPE.
5. INSTALL TWO NO. 2 AWG STRAND BOND WIRES FROM PIPE FLANGE TO VALVE/Joint FLANGE (BOTH SIDES) USING THE THERMITE WELD METHOD.
6. TAPE INSULATION JOINT WITH 40 MIL POLYKEN TAPE OR EQUAL. OVERLAP PER MANUFACTURER'S RECOMMENDATION.
7. WRAP INSULATION JOINT WITH TWO LAYERS OF 8 MIL POLYETHYLENE.
8. WRAP DISMANTLING JOINT WITH TWO LAYERS OF 8 MIL POLYETHYLENE.

PLAN

SCALE: 1"=20'

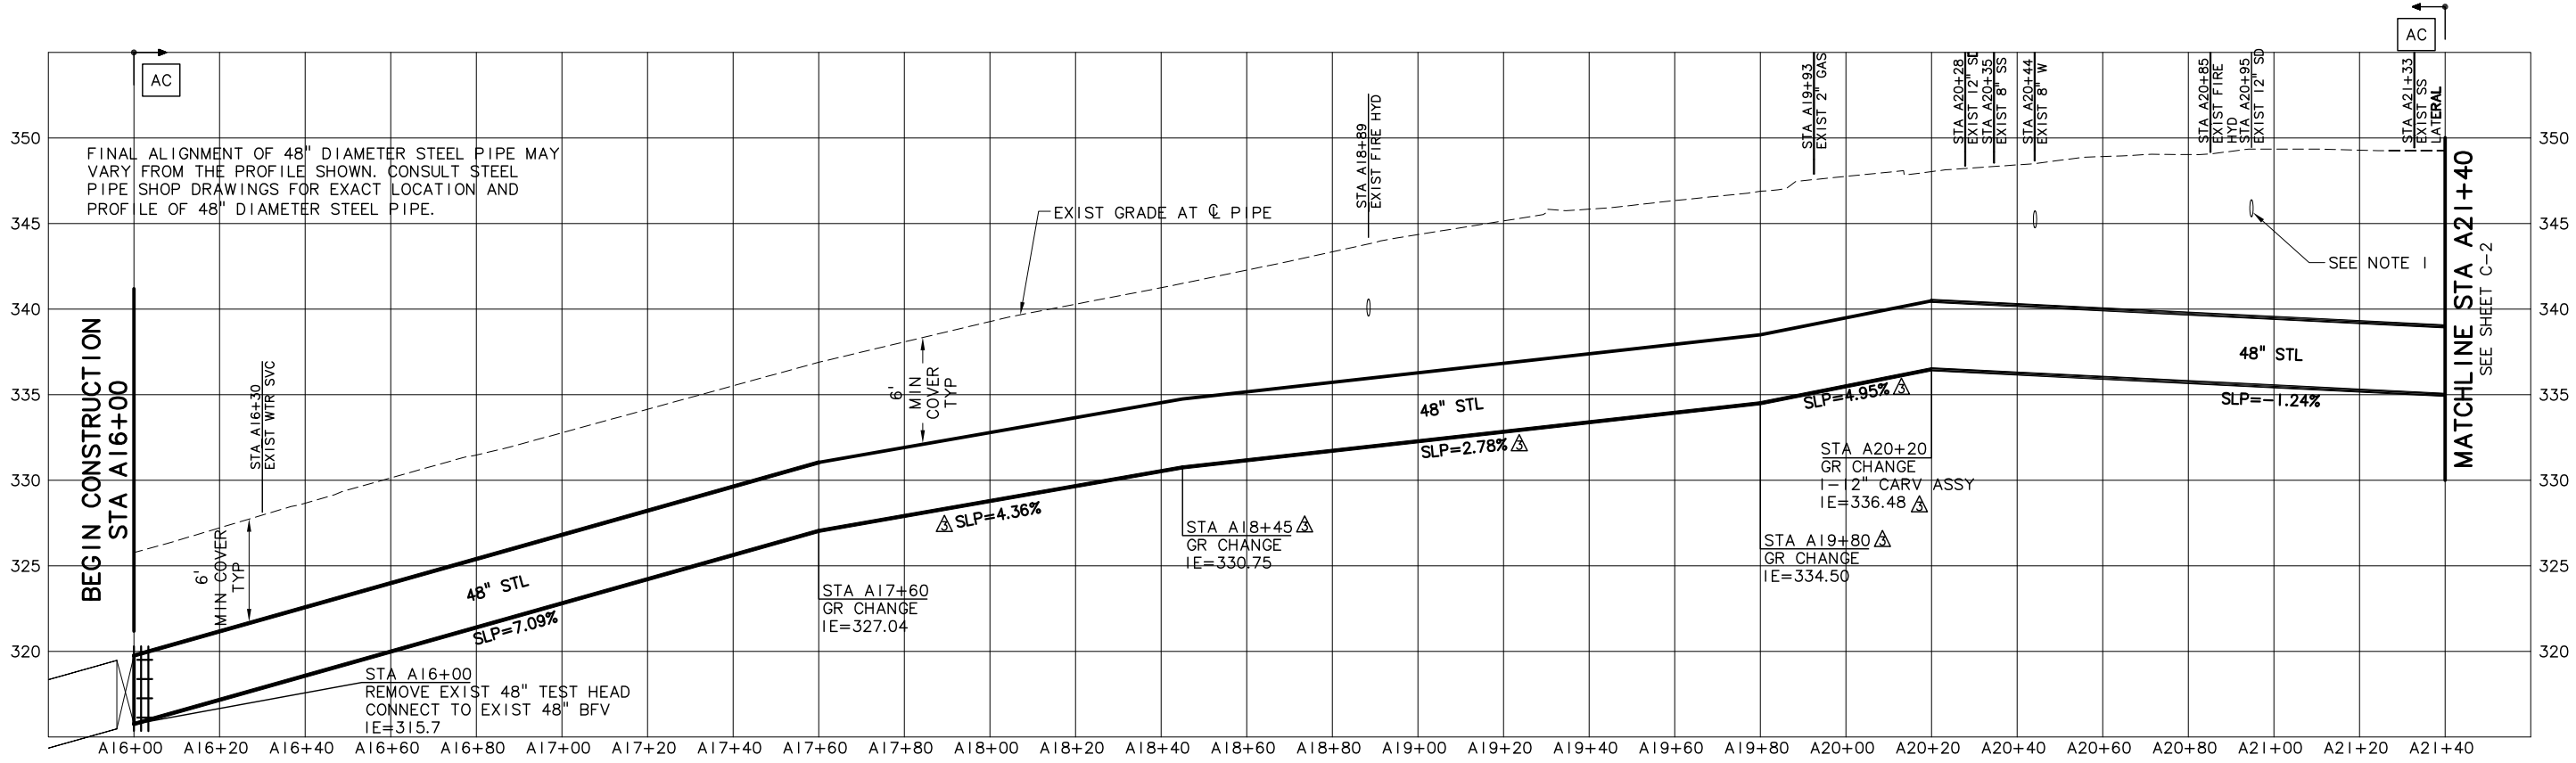

PROFILE

SCALE: 1"=20' HORIZ 1"=5' VERT

NO.	DATE	BY	REVISION
1	08/22/11	BVO	RECORD DRAWING

NOTICE

0 1/2 1

IF THIS BAR DOES NOT MEASURE 1" THEN DRAWING IS NOT TO SCALE

SMG DESIGNED
DAK DRAWN
MLH CHECKED

RECORD DRAWING

SEE DISCLAIMER, SHEET 1.

VERSION 4.1
12-9-97

MSA Murray Smith & Associates, Inc.
Engineers/Planners

121 S.W. Salmon, Suite 900
Portland, Oregon 97204

PHONE 503-225-9010
FAX 503-225-9022

City of Sherwood Oregon

WATER SUPPLY IMPROVEMENT PROJECT TRANSMISSION PIPELINE


WATERLINE SCHEDULE A PLAN AND PROFILE STA A16+00 TO STA A21+40

PROJECT NO.: 07-0873.207 SCALE: AS SHOWN DATE: JUNE 2009


SHEET **C-1** 20 of 79

C:\PDX\Projects\07\0873\207 Design-Final Plans\CAD\07-0873-207-OR-CIVIL A-R.dwg C-2 9/12/2011 4:11 PM DAK 18.1s (LMS Tech)

- NOTES:
1. CONTRACTOR TO POTHOLE AND VERIFY EXACT DEPTHS AND LOCATIONS OF EXISTING UTILITIES PRIOR TO CONSTRUCTION.
 2. ADJUST VALVE BOXES TO GRADE.

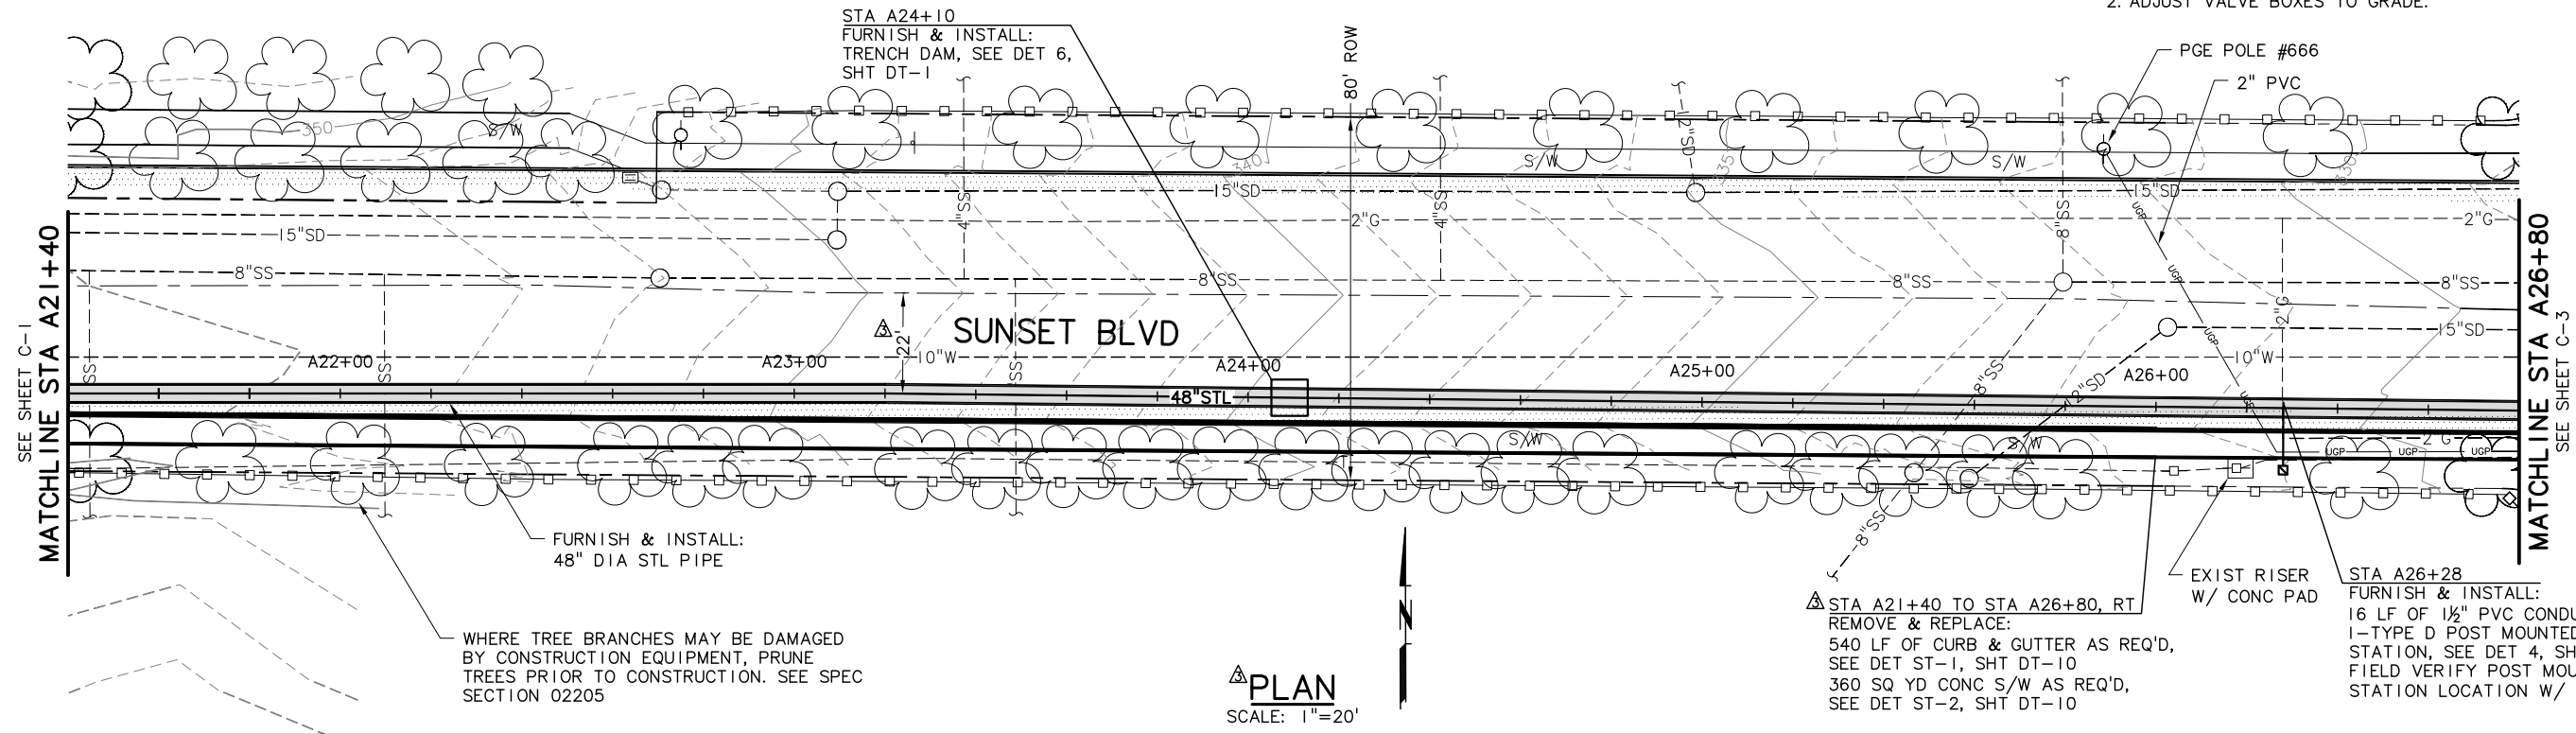

PLAN
SCALE: 1"=20'

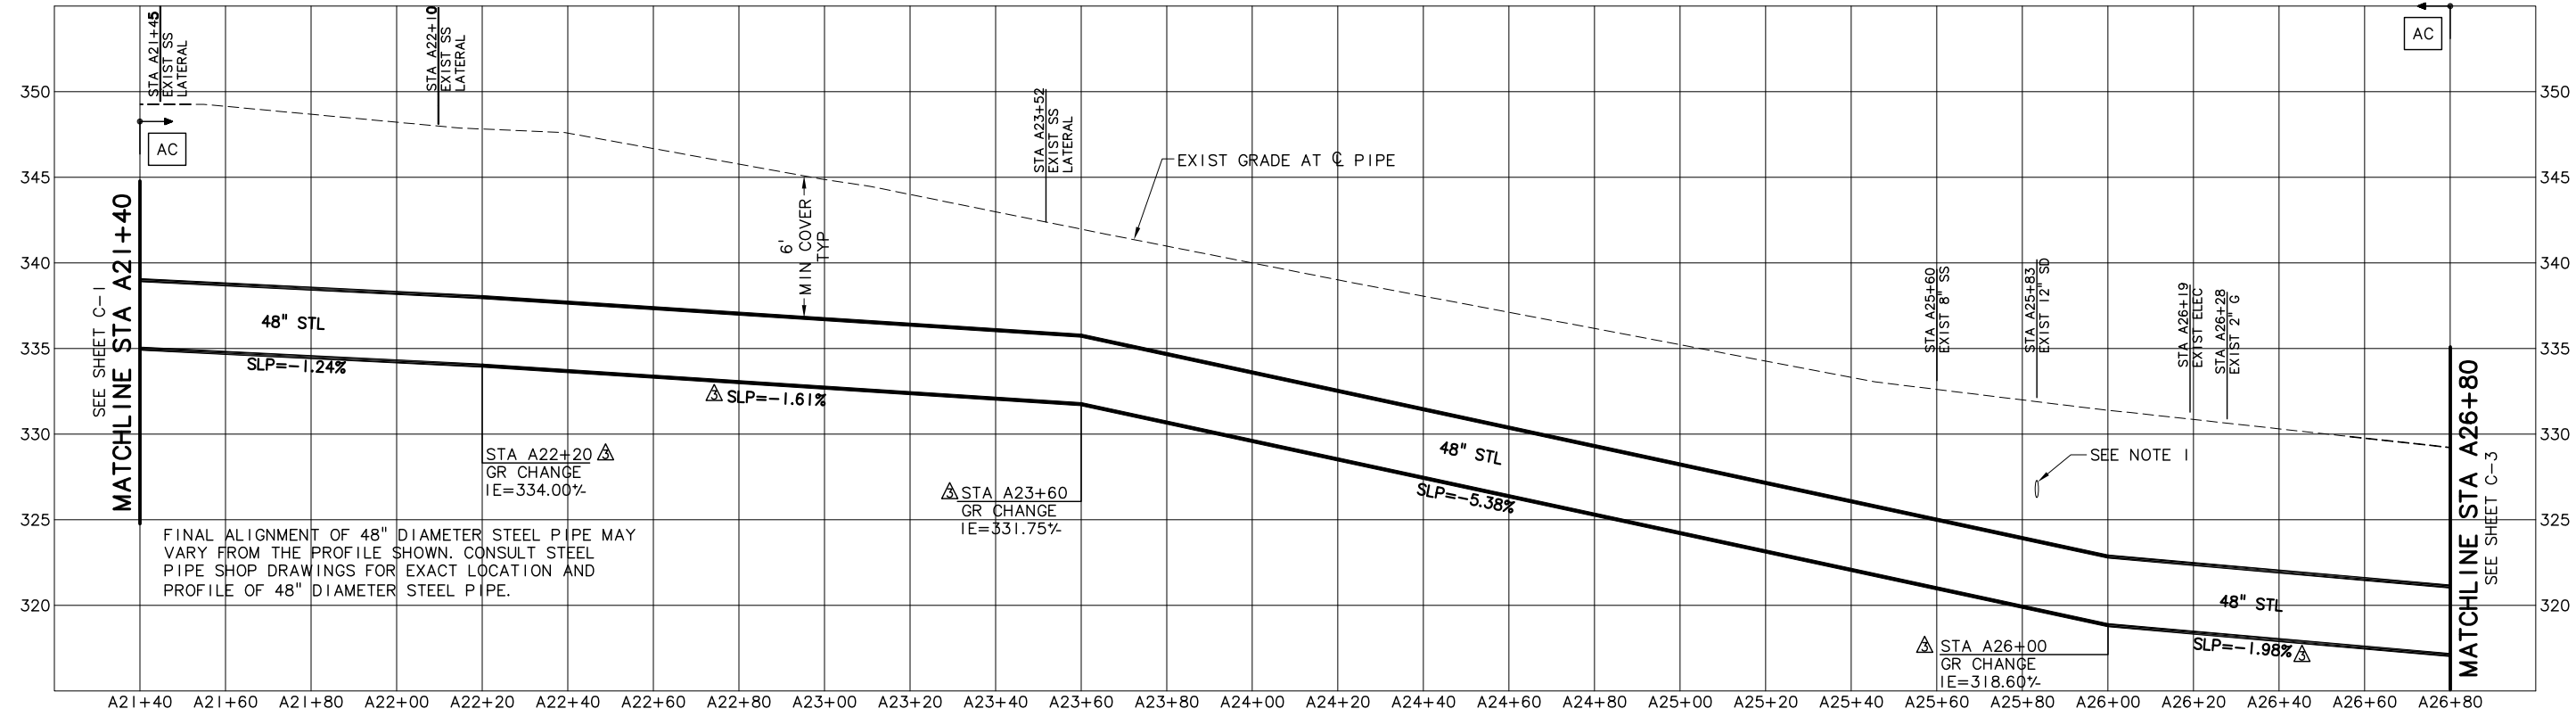

PROFILE
SCALE: 1"=20' HORIZ 1"=5' VERT

NO.	DATE	BY	REVISION
1	08/22/11	BVO	RECORD DRAWING

NOTICE

0 1/2 1

IF THIS BAR DOES NOT MEASURE 1" THEN DRAWING IS NOT TO SCALE

SMG DESIGNED
DAK DRAWN
MLH CHECKED

RECORD DRAWING

SEE DISCLAIMER, SHEET 1.

VERSION 4.1
12-9-97

MSA Murray Smith & Associates, Inc.
Engineers/Planners

121 S.W. Salmon, Suite 900
Portland, Oregon 97204

PHONE 503-225-9010
FAX 503-225-9022



City of Sherwood Oregon

WATER SUPPLY IMPROVEMENT PROJECT TRANSMISSION PIPELINE

WATERLINE SCHEDULE A PLAN AND PROFILE STA A21+40 TO STA A26+80


PROJECT NO.: 07-0873.207 SCALE: AS SHOWN DATE: JUNE 2009

G:\PDX_Projects\07_0873\207_Design-Final_Plans\CAD\DOR\07-0873-207-OR-CIVIL A-R.dwg C-3 9/12/2011 4:13 PM DAK J8.1s (LMS Tech)

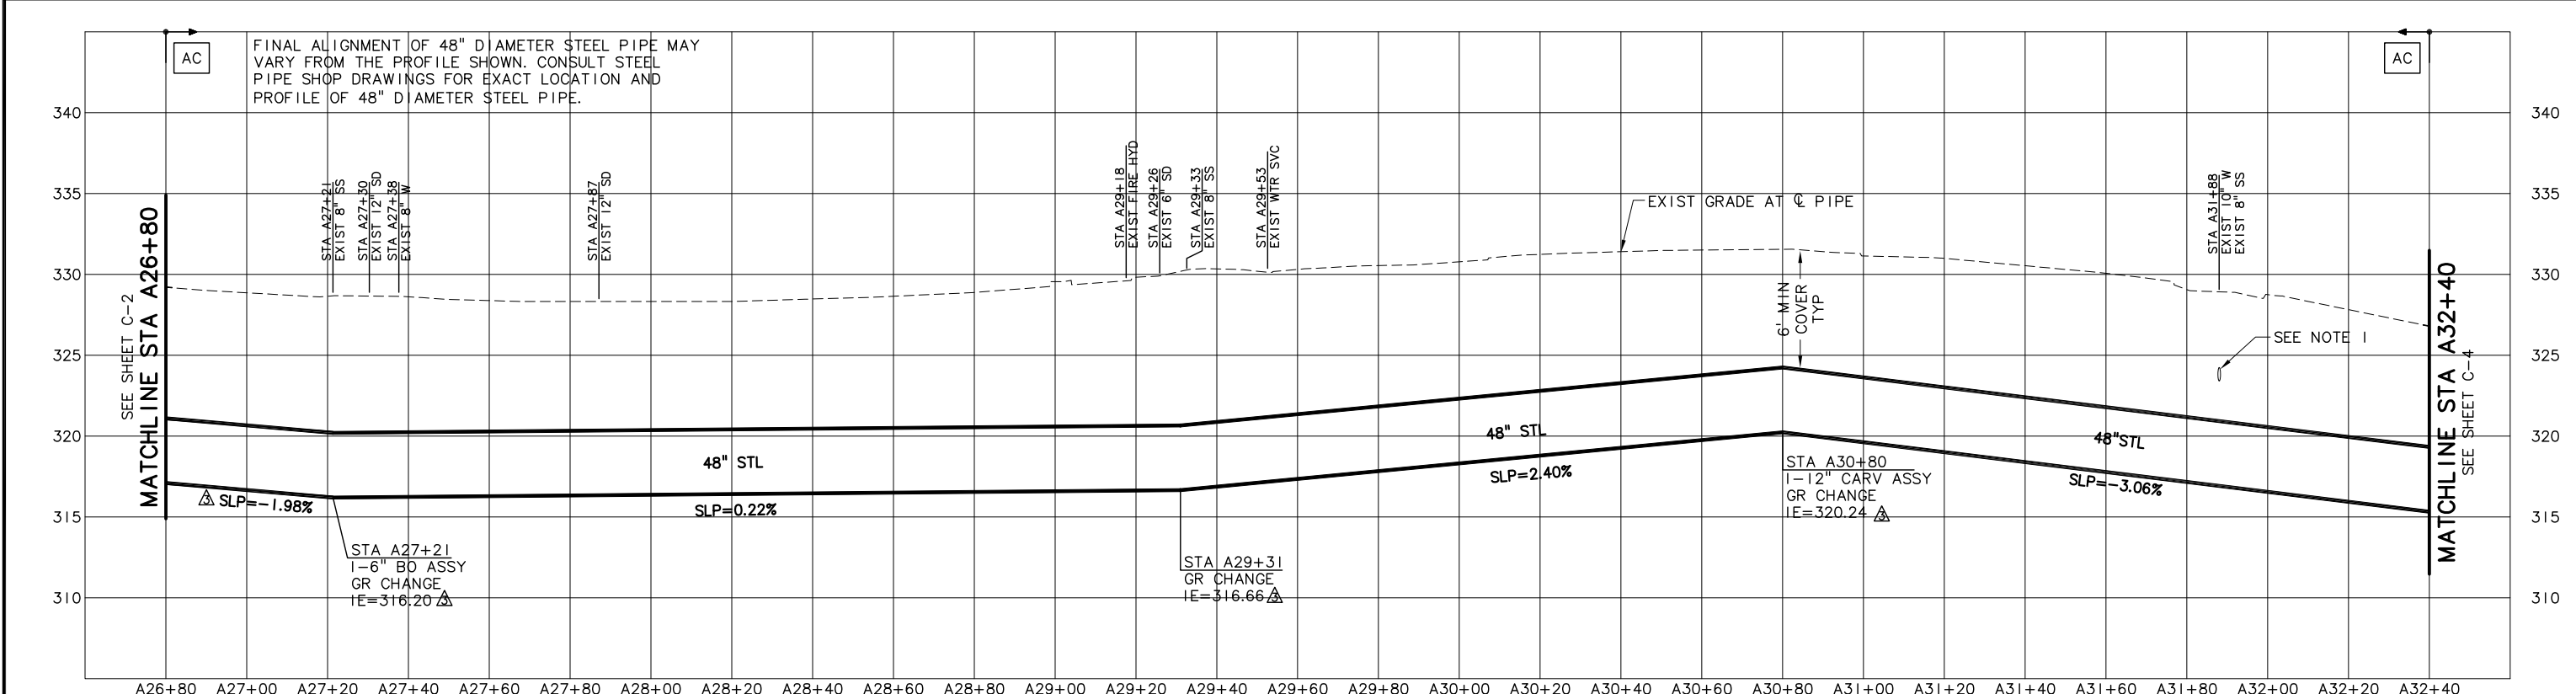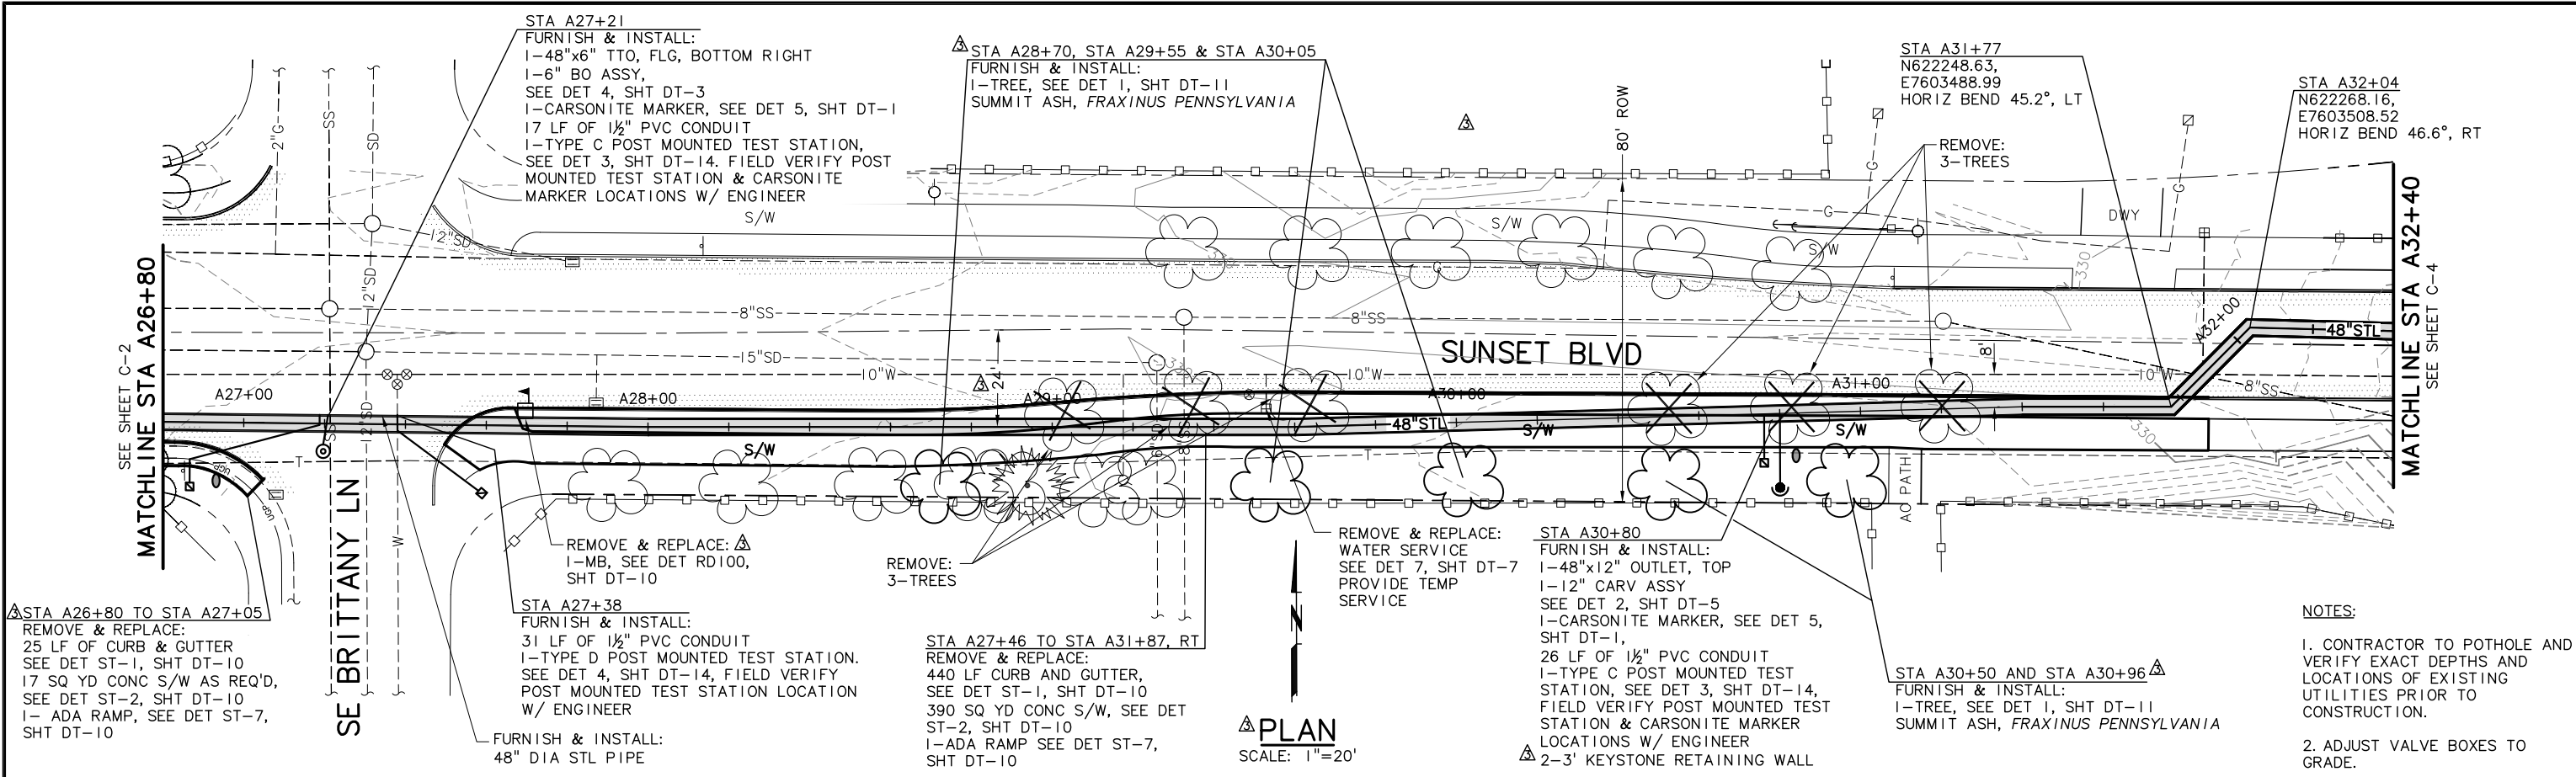


<p>NOTICE</p> <p>0 1/2 1</p> <p>IF THIS BAR DOES NOT MEASURE 1" THEN DRAWING IS NOT TO SCALE</p>	<p>SMG DESIGNED</p> <p>DAK DRAWN</p> <p>MLH CHECKED</p>	<p>RECORD DRAWING</p> <p>SEE DISCLAIMER, SHEET 1.</p> <p>VERSION 4.1</p> <p>12-9-97</p>	<p>Murray Smith & Associates, Inc. Engineers/Planners</p> <p>121 S.W. Salmon, Suite 900 PHONE 503-225-9010 Portland, Oregon 97204 FAX 503-225-9022</p>	<p>City of Sherwood Oregon</p>	<p>WATER SUPPLY IMPROVEMENT PROJECT TRANSMISSION PIPELINE</p>	<p>WATERLINE SCHEDULE A PLAN AND PROFILE</p> <p>STA A26+80 TO STA A32+40</p>	<p>SHEET</p> <p style="font-size: 24pt; font-weight: bold;">C-3</p> <p>22 of 79</p>				
<table border="1" style="width: 100%; border-collapse: collapse;"> <thead> <tr> <th style="width: 5%;">NO.</th> <th style="width: 10%;">DATE</th> <th style="width: 10%;">BY</th> <th style="width: 75%;">REVISION</th> </tr> </thead> <tbody> <tr> <td>1</td> <td>08/22/11</td> <td>BVO</td> <td>RECORD DRAWING</td> </tr> </tbody> </table>		NO.	DATE	BY	REVISION	1	08/22/11	BVO	RECORD DRAWING	<p>PROJECT NO.: 07-0873.207 SCALE: AS SHOWN DATE: JUNE 2009</p>	
NO.	DATE	BY	REVISION								
1	08/22/11	BVO	RECORD DRAWING								

C:\PDX\Projects\07\0873\207 Design-Final Plans\CAD\07-0873-207-OR-CIVIL A - C-4-R.dwg C-4 9/8/2011 2:10 PM DAK 18.1s (LMS Tech)

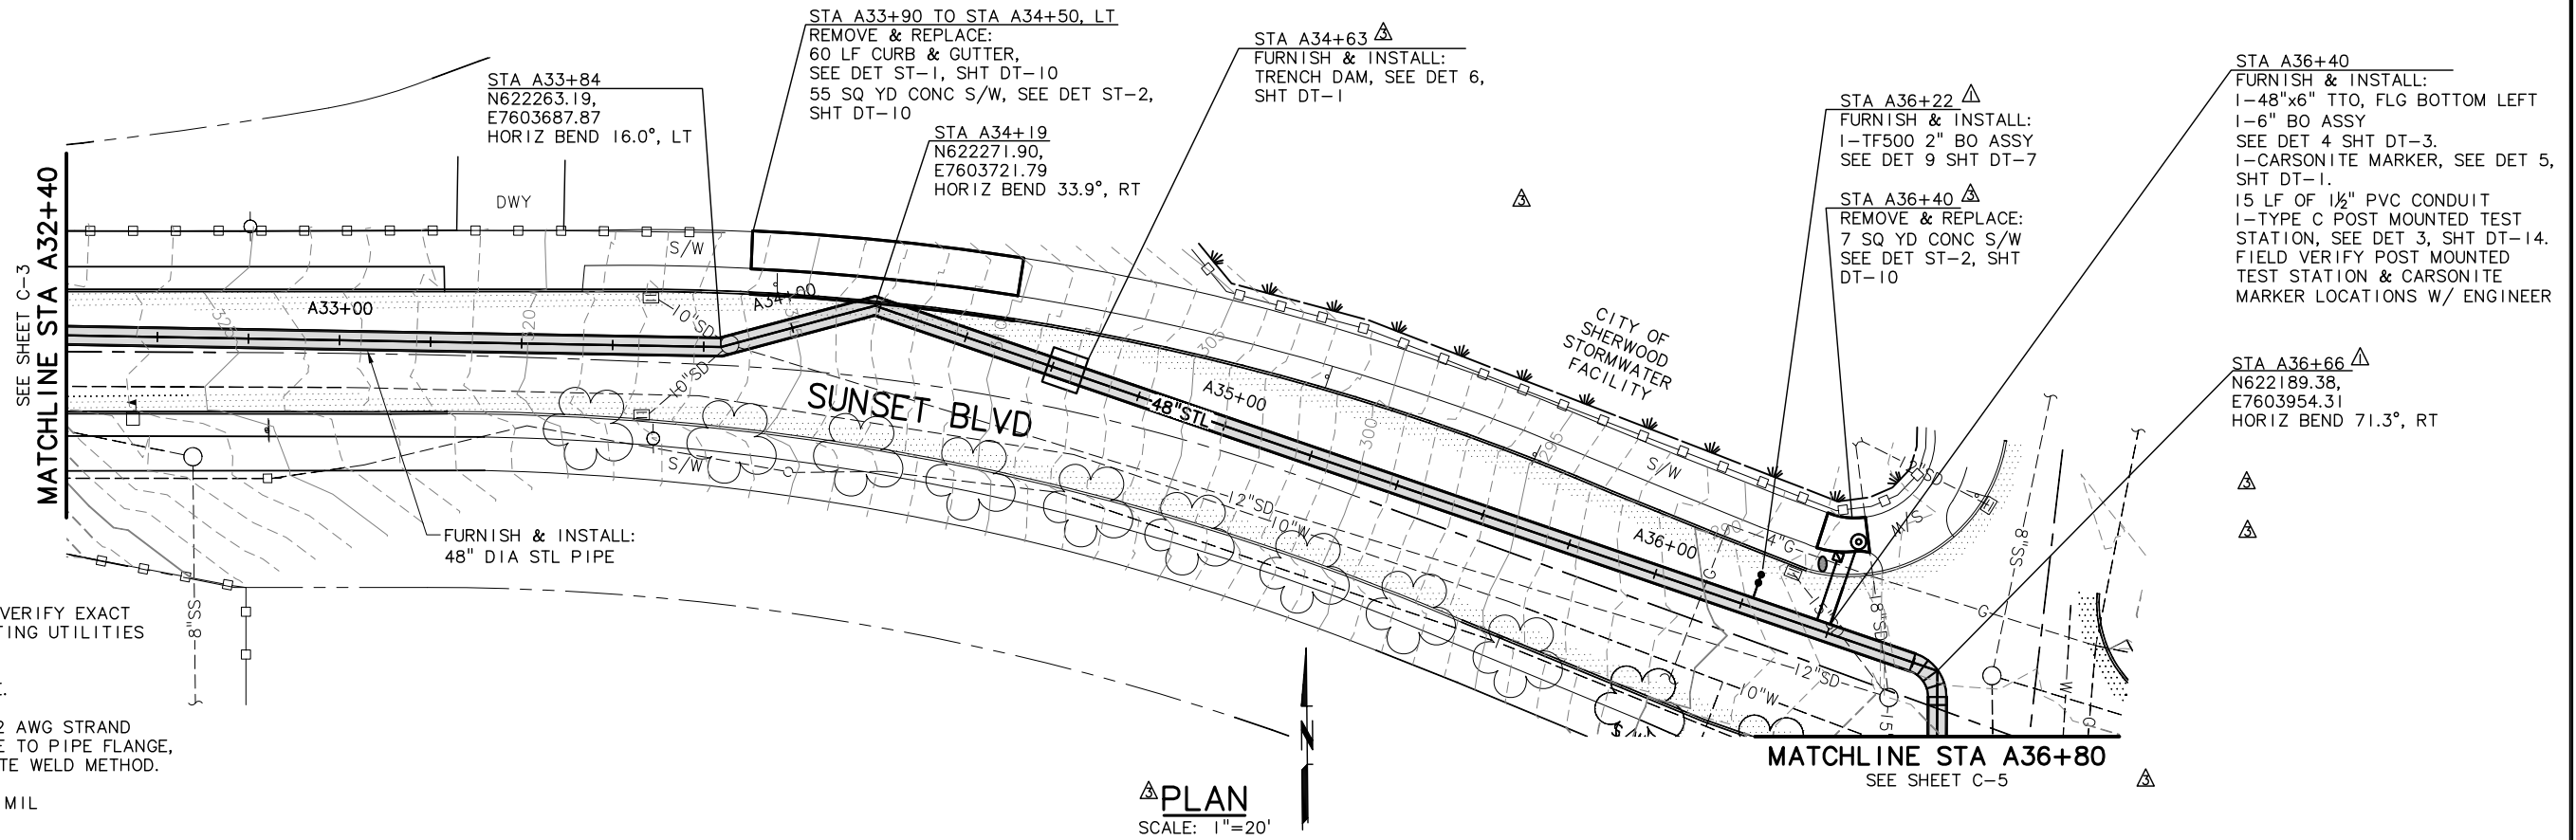

NOTES:

1. CONTRACTOR TO POTHOLE AND VERIFY EXACT DEPTHS AND LOCATIONS OF EXISTING UTILITIES PRIOR TO CONSTRUCTION.
2. ADJUST VALVE BOXES TO GRADE.
3. FURNISH & INSTALL TWO NO. 2 AWG STRAND WIRES FROM VALVE/JOINT FLANGE TO PIPE FLANGE, (BOTH SIDES) USING THE THERMITE WELD METHOD.
4. WRAP WITH TWO LAYERS OF 8 MIL POLYETHYLENE.

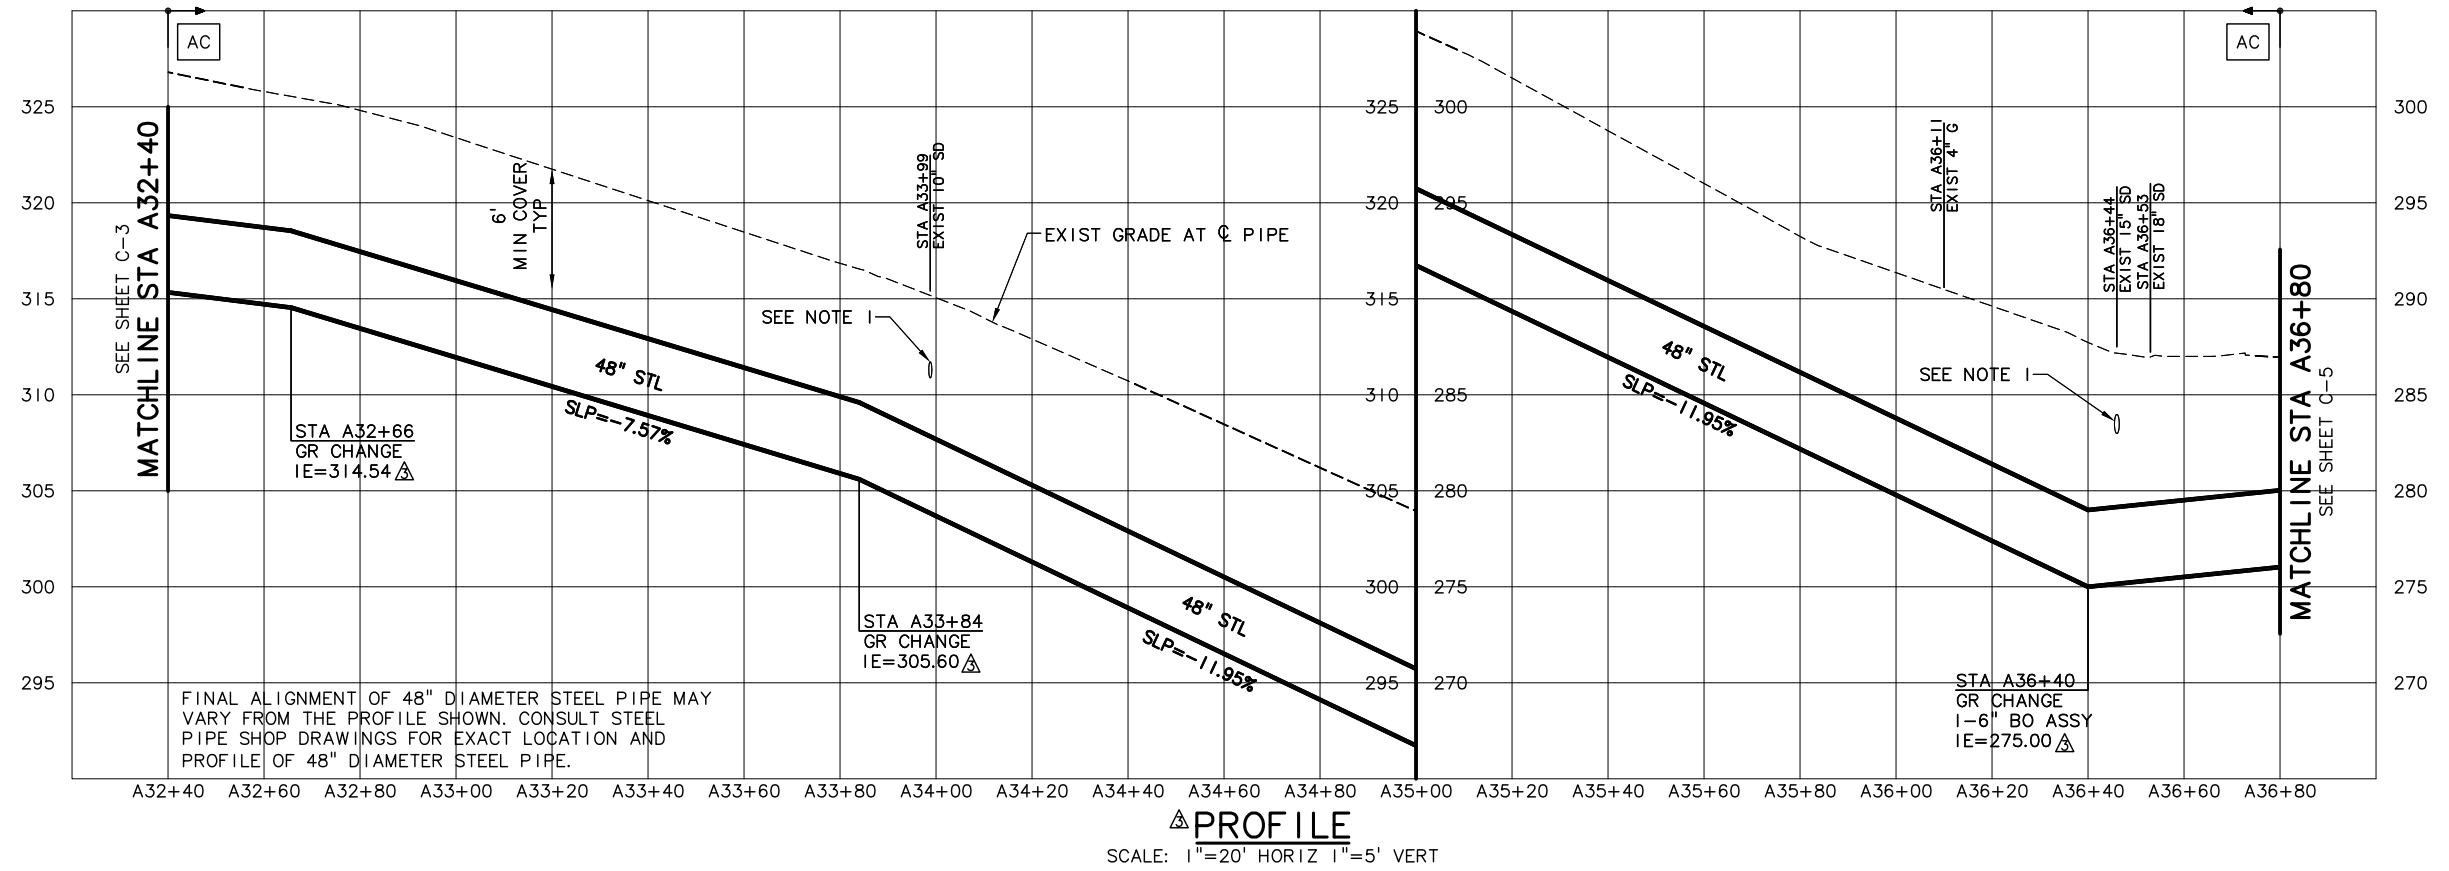

NO.	DATE	BY	REVISION
1	08/22/11	BVO	RECORD DRAWING
2	09/14/09	SMG	RFI #1

NOTICE

0 1/2 1

IF THIS BAR DOES NOT MEASURE 1" THEN DRAWING IS NOT TO SCALE

SMG DESIGNED
DAK DRAWN
MLH CHECKED

RECORD DRAWING

SEE DISCLAIMER, SHEET 1.

VERSION 4.1
12-9-97

MSA Murray Smith & Associates, Inc.
Engineers/Planners

121 S.W. Salmon, Suite 900
Portland, Oregon 97204

PHONE 503-225-9010
FAX 503-225-9022





WATER SUPPLY IMPROVEMENT PROJECT TRANSMISSION PIPELINE

**WATERLINE SCHEDULE A
PLAN AND PROFILE
STA A32+40 TO STA A36+80**

PROJECT NO.: 07-0873.207 SCALE: AS SHOWN DATE: JUNE 2009

SHEET
C-4
23 of 79

C:\Users\dak\appdata\local\temp\AcPublish_5992\07-0873-207-OR-CIVIL A-R.dwg C-5 9/8/2011 11:24 AM DAK 18.1s (LMS Tech)

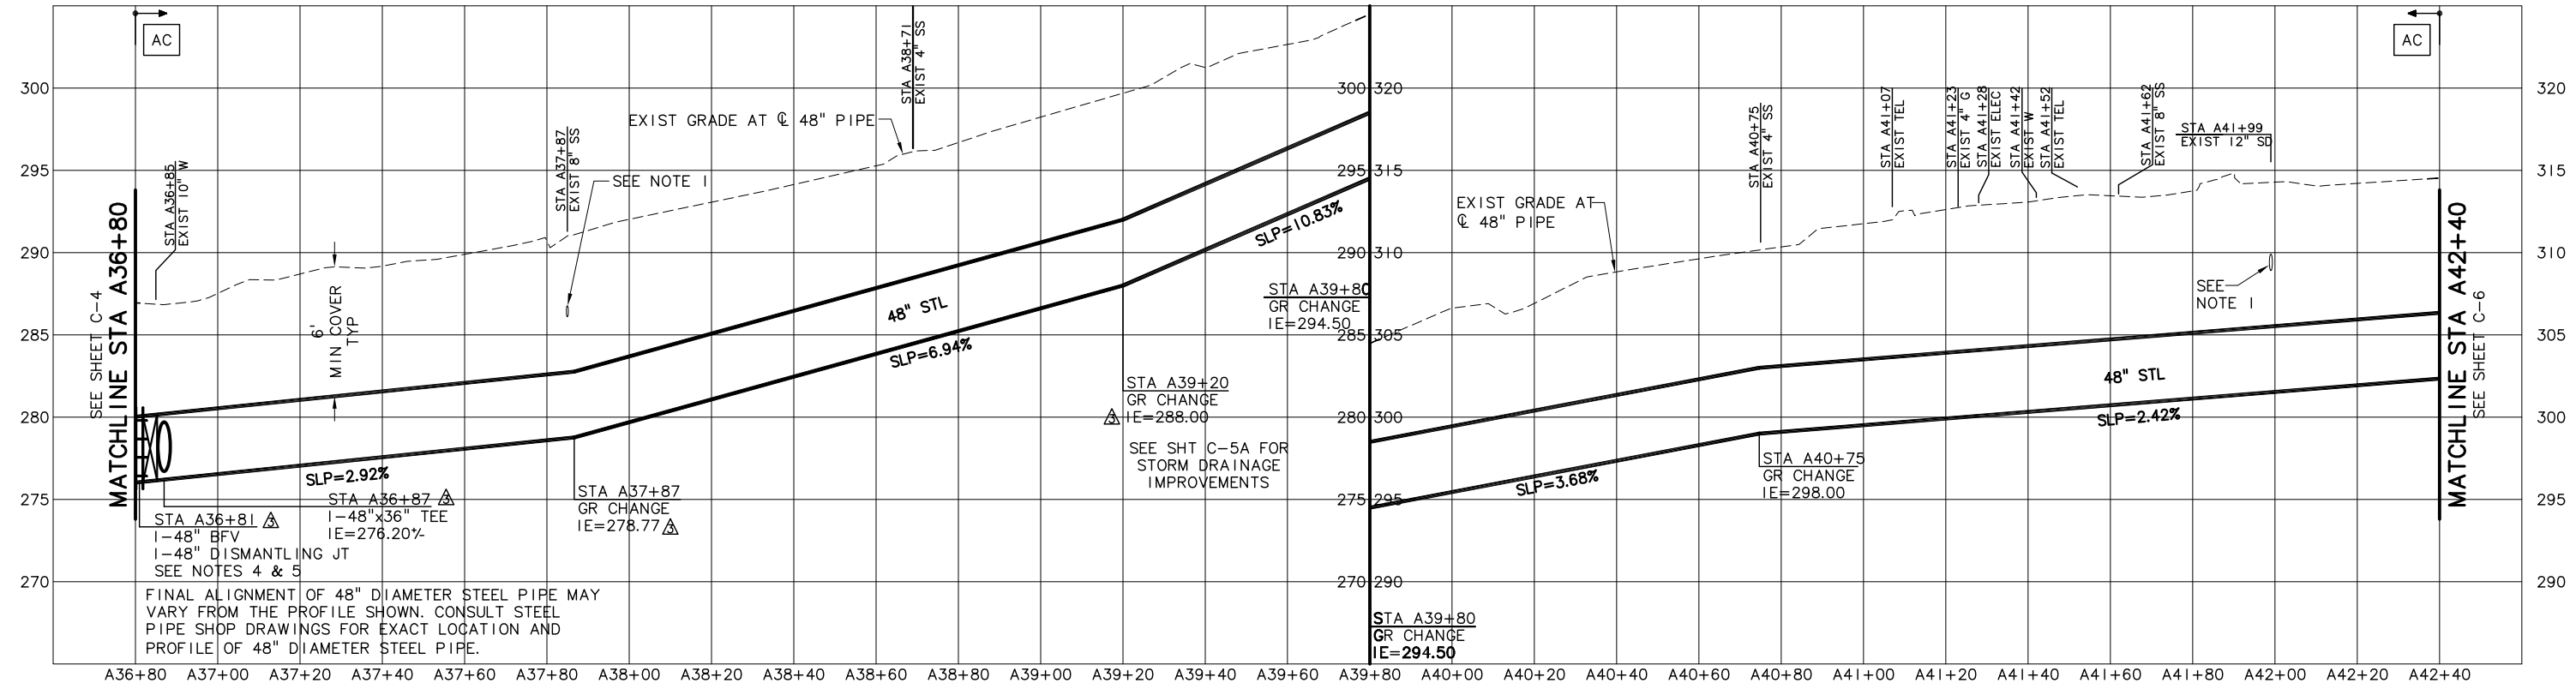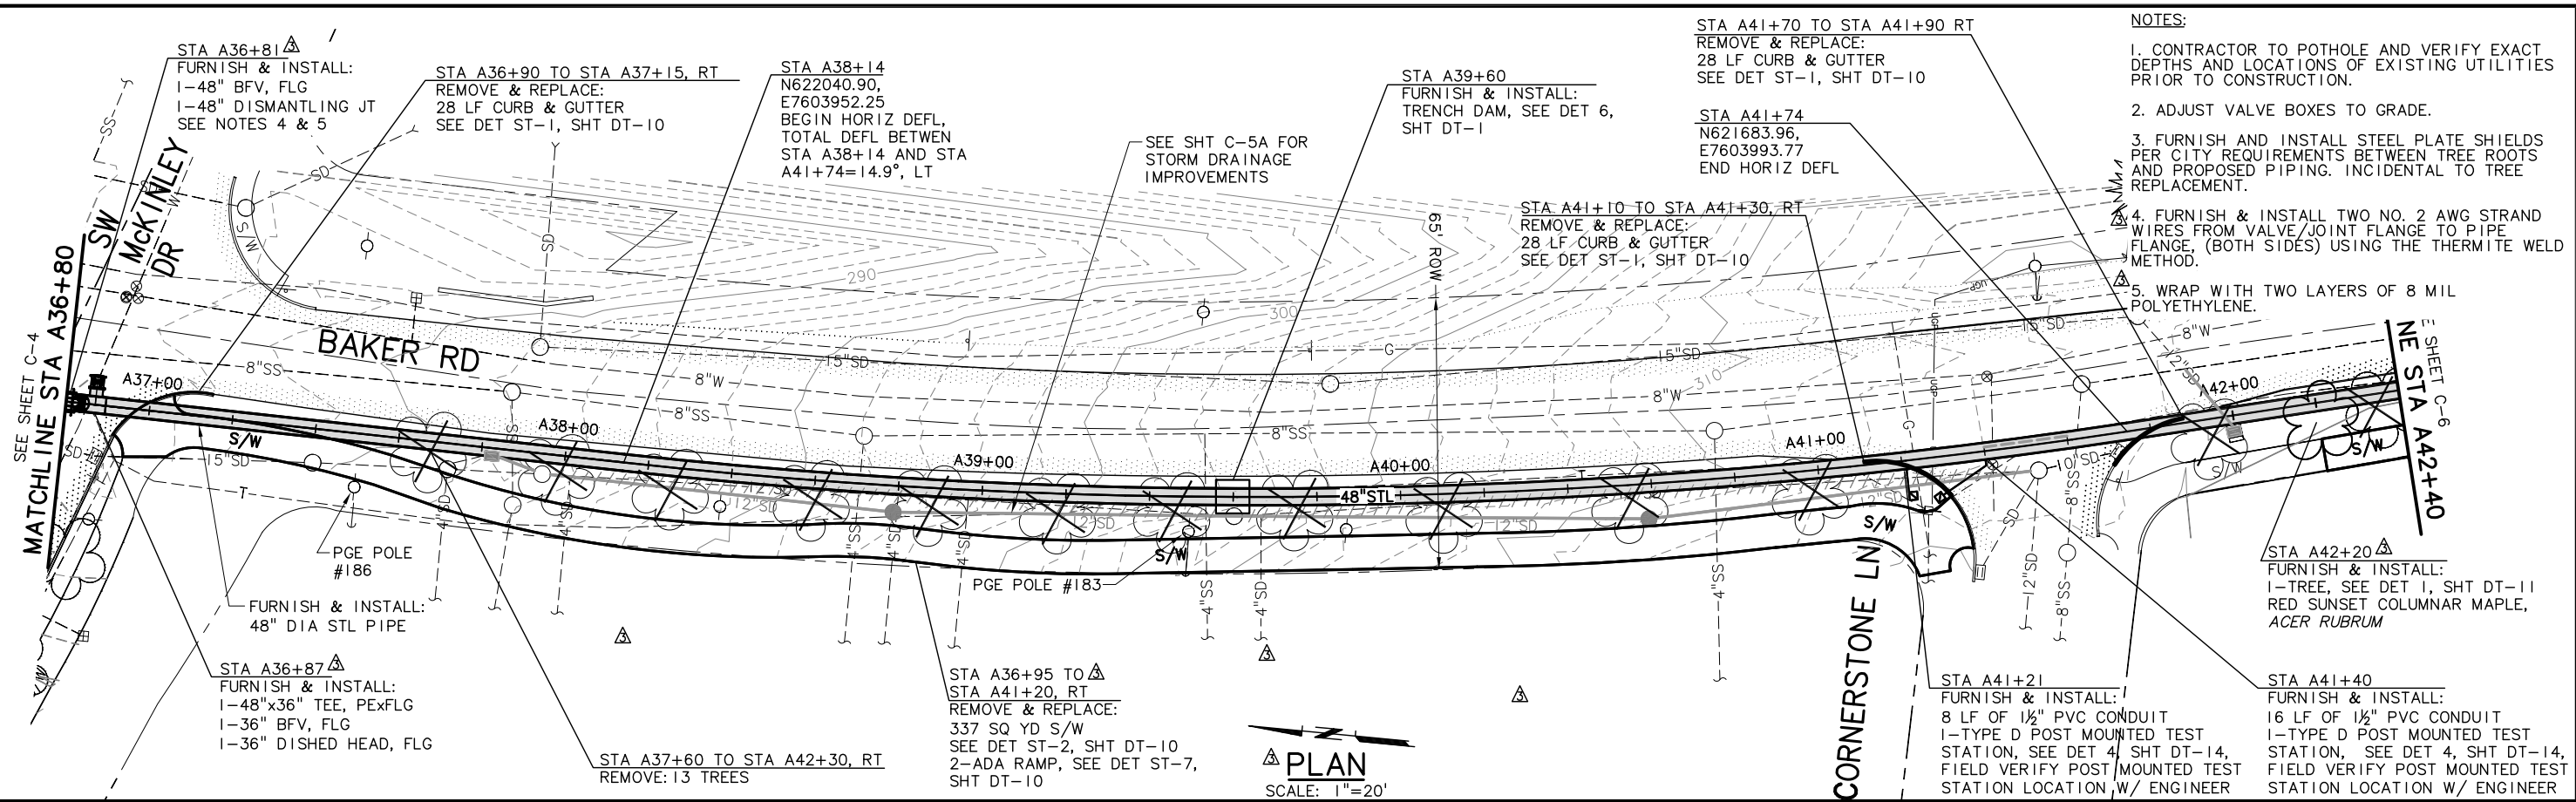

NO.	DATE	BY	REVISION
1	08/22/11	BVO	RECORD DRAWING

NOTICE

0 1/2 1

IF THIS BAR DOES NOT MEASURE 1" THEN DRAWING IS NOT TO SCALE

SMG DESIGNED
DAK DRAWN
MLH CHECKED

RECORD DRAWING

SEE DISCLAIMER, SHEET 1.

VERSION 4.1
12-9-97

MSA Murray Smith & Associates, Inc.
Engineers/Planners

121 S.W. Salmon, Suite 900
Portland, Oregon 97204

PHONE 503-225-9010
FAX 503-225-9022

City of Sherwood Oregon



WATER SUPPLY IMPROVEMENT PROJECT TRANSMISSION PIPELINE

WATERLINE SCHEDULE A 48" WATER PLAN AND PROFILE STA A36+80 TO STA A42+40

PROJECT NO.: 07-0873.207 SCALE: AS SHOWN DATE: JUNE 2009

SHEET **C-5** 24 of 79

C:\PDX\Projects\07\0873\207 Design-Final Plans\CAD\07-0873-207-OR-CIVIL A - C-5A-R.dwg C-5A 9/8/2011 10:19 AM DAK 18.1s (LMS Tech)

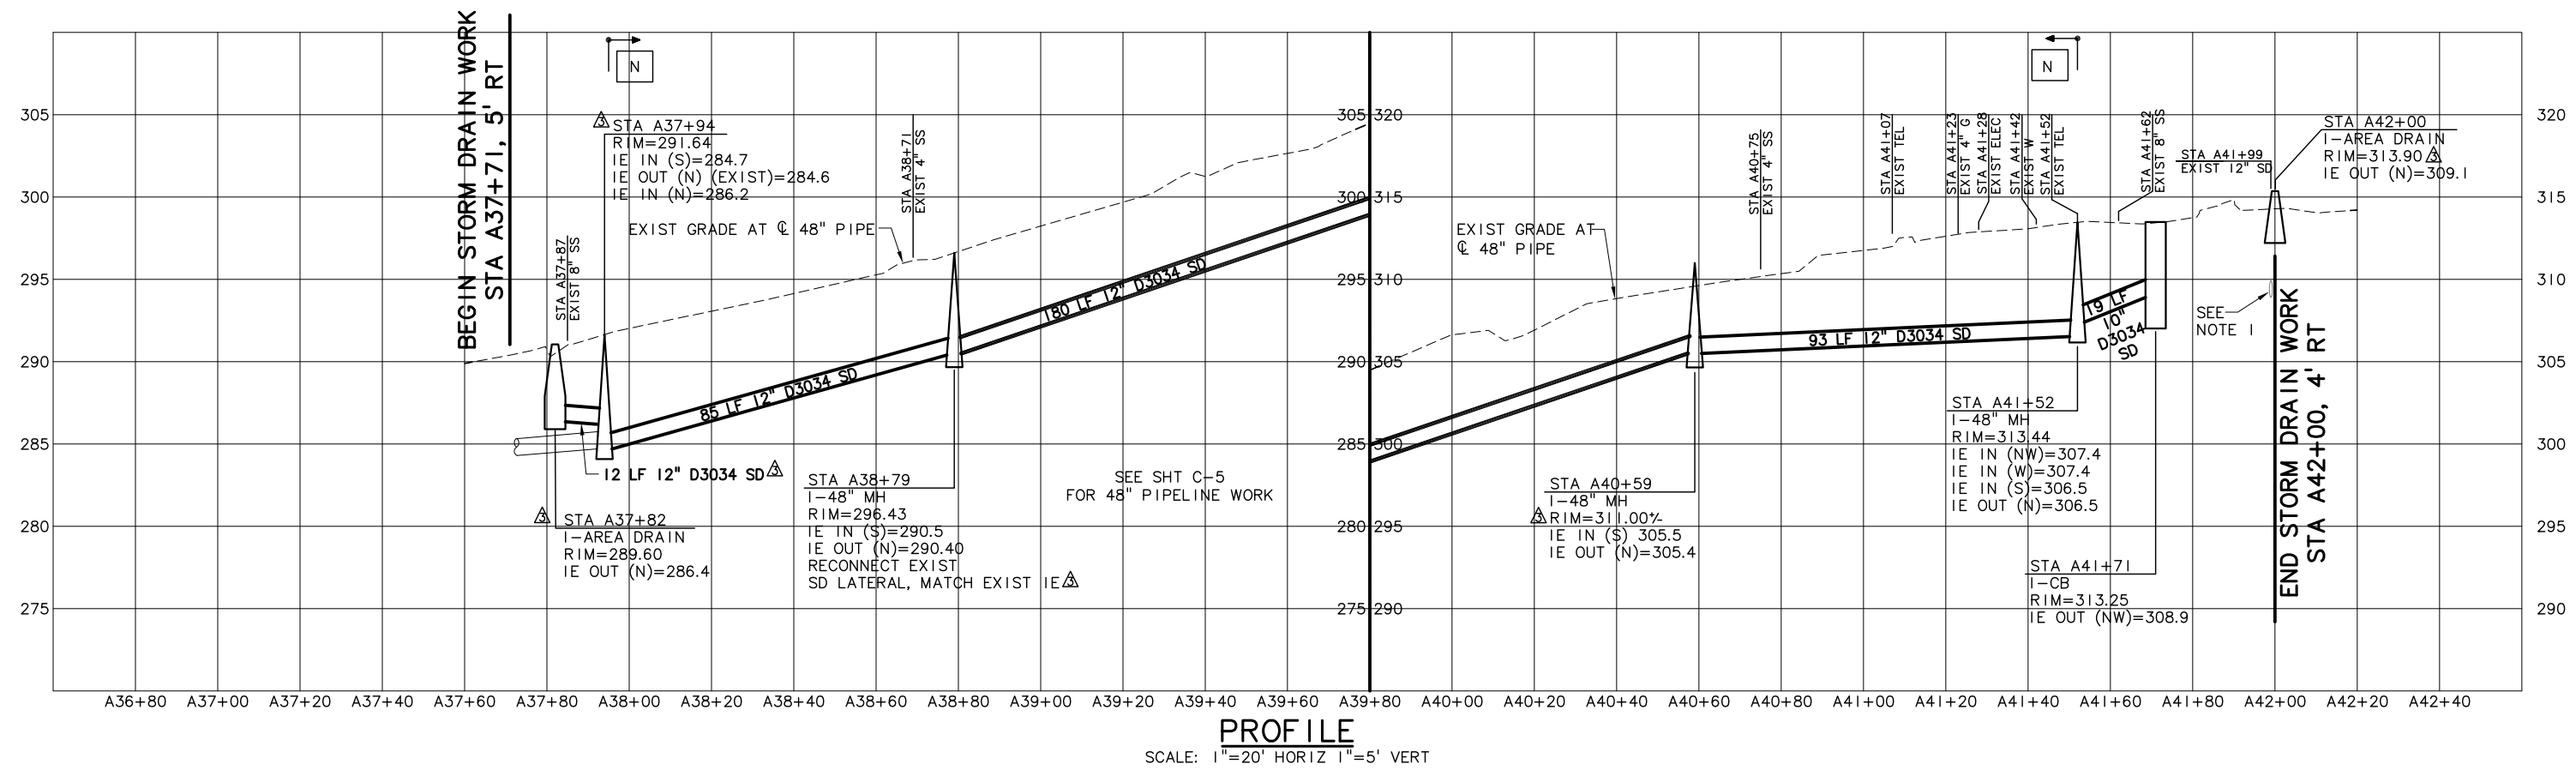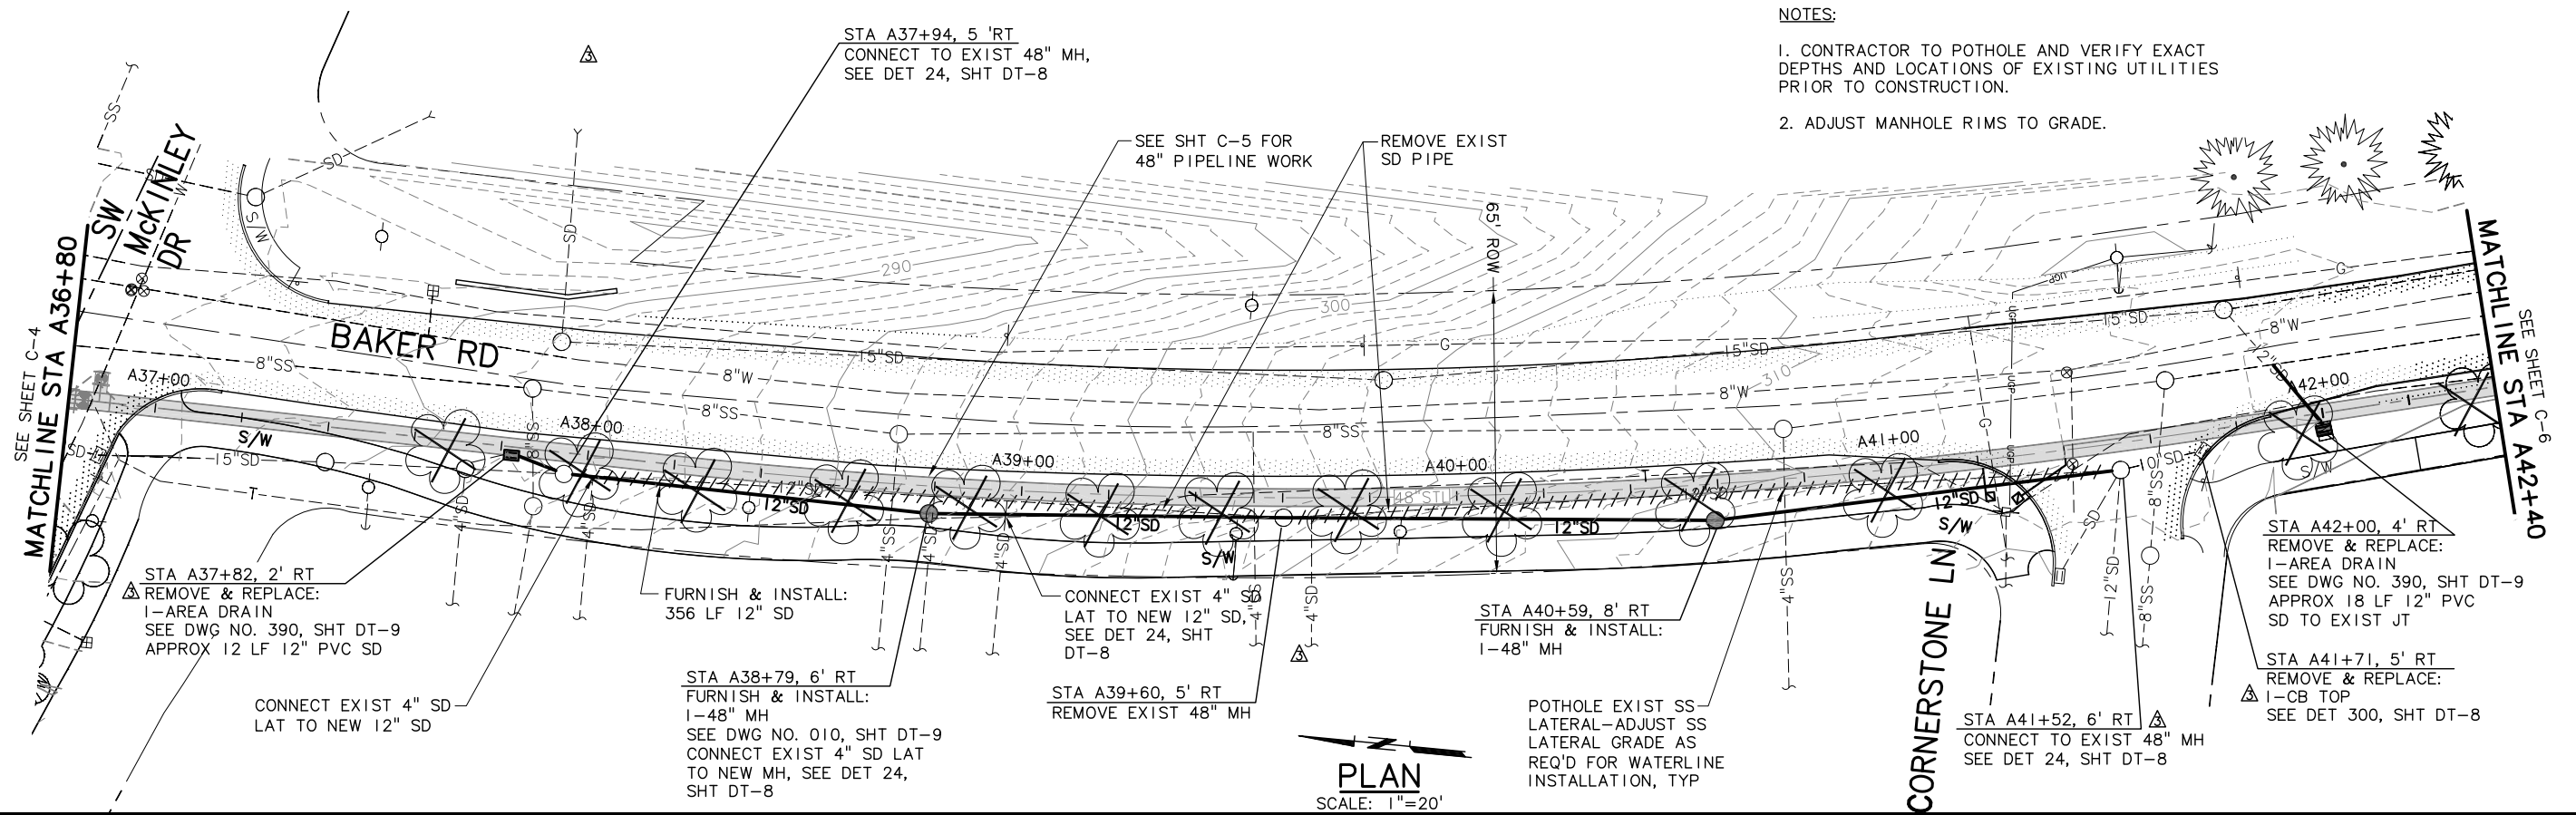

NO.	DATE	BY	REVISION
1	08/22/11	BVO	RECORD DRAWING

NOTICE

0 1/2 1

IF THIS BAR DOES NOT MEASURE 1" THEN DRAWING IS NOT TO SCALE

SMG DESIGNED
DAK DRAWN
MLH CHECKED

RECORD DRAWING

SEE DISCLAIMER, SHEET 1.

VERSION 4.1
12-9-97

MSA Murray Smith & Associates, Inc.
Engineers/Planners

121 S.W. Salmon, Suite 900
Portland, Oregon 97204

PHONE 503-225-9010
FAX 503-225-9022

City of Sherwood Oregon

WATER SUPPLY IMPROVEMENT PROJECT

TRANSMISSION PIPELINE


WATERLINE SCHEDULE A

12" SD PLAN AND PROFILE

STA A37+95 TO STA A41+52


PROJECT NO.: 07-0873.207 SCALE: AS SHOWN DATE: JUNE 2009

C:\PDX_Projects\07_0873\207_Design-Final_Plans\CAD\07-0873-207-OR-CIVIL A - C-6A_C-7A-R.dwg C-6A 9/8/2011 10:08 AM DAK 18.1s (LMS Tech)

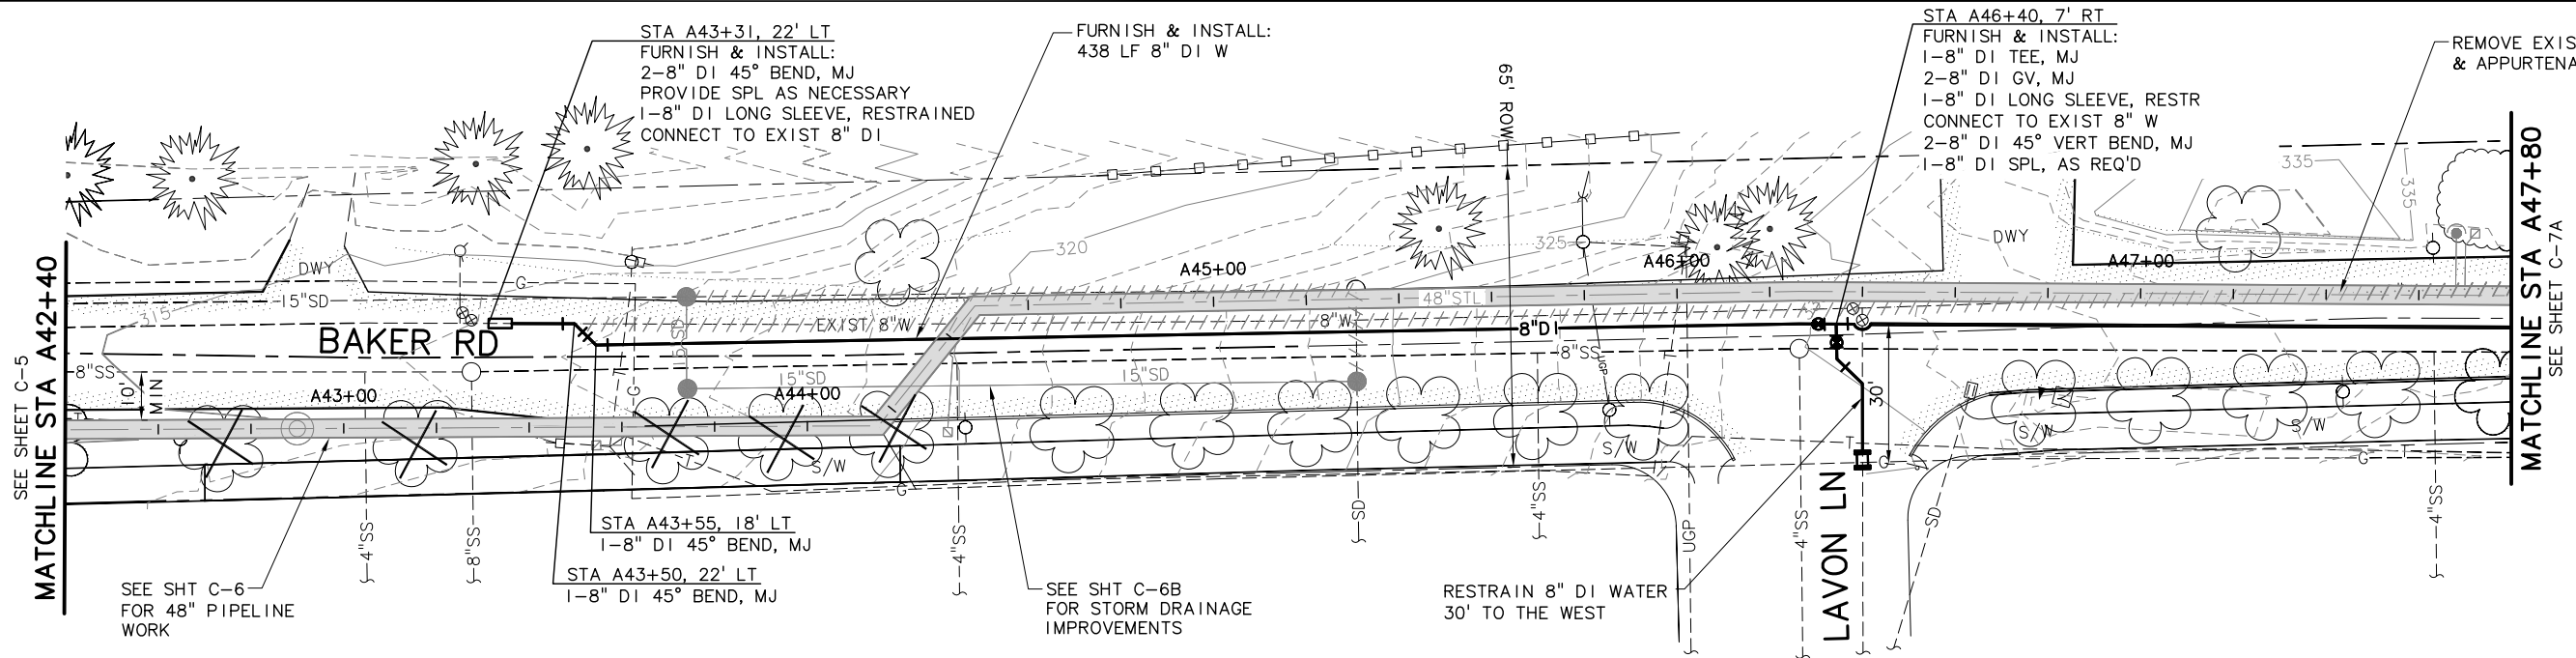

PLAN
SCALE: 1"=20'

NOTE:
I. ADJUST VALVE BOXES TO GRADE.

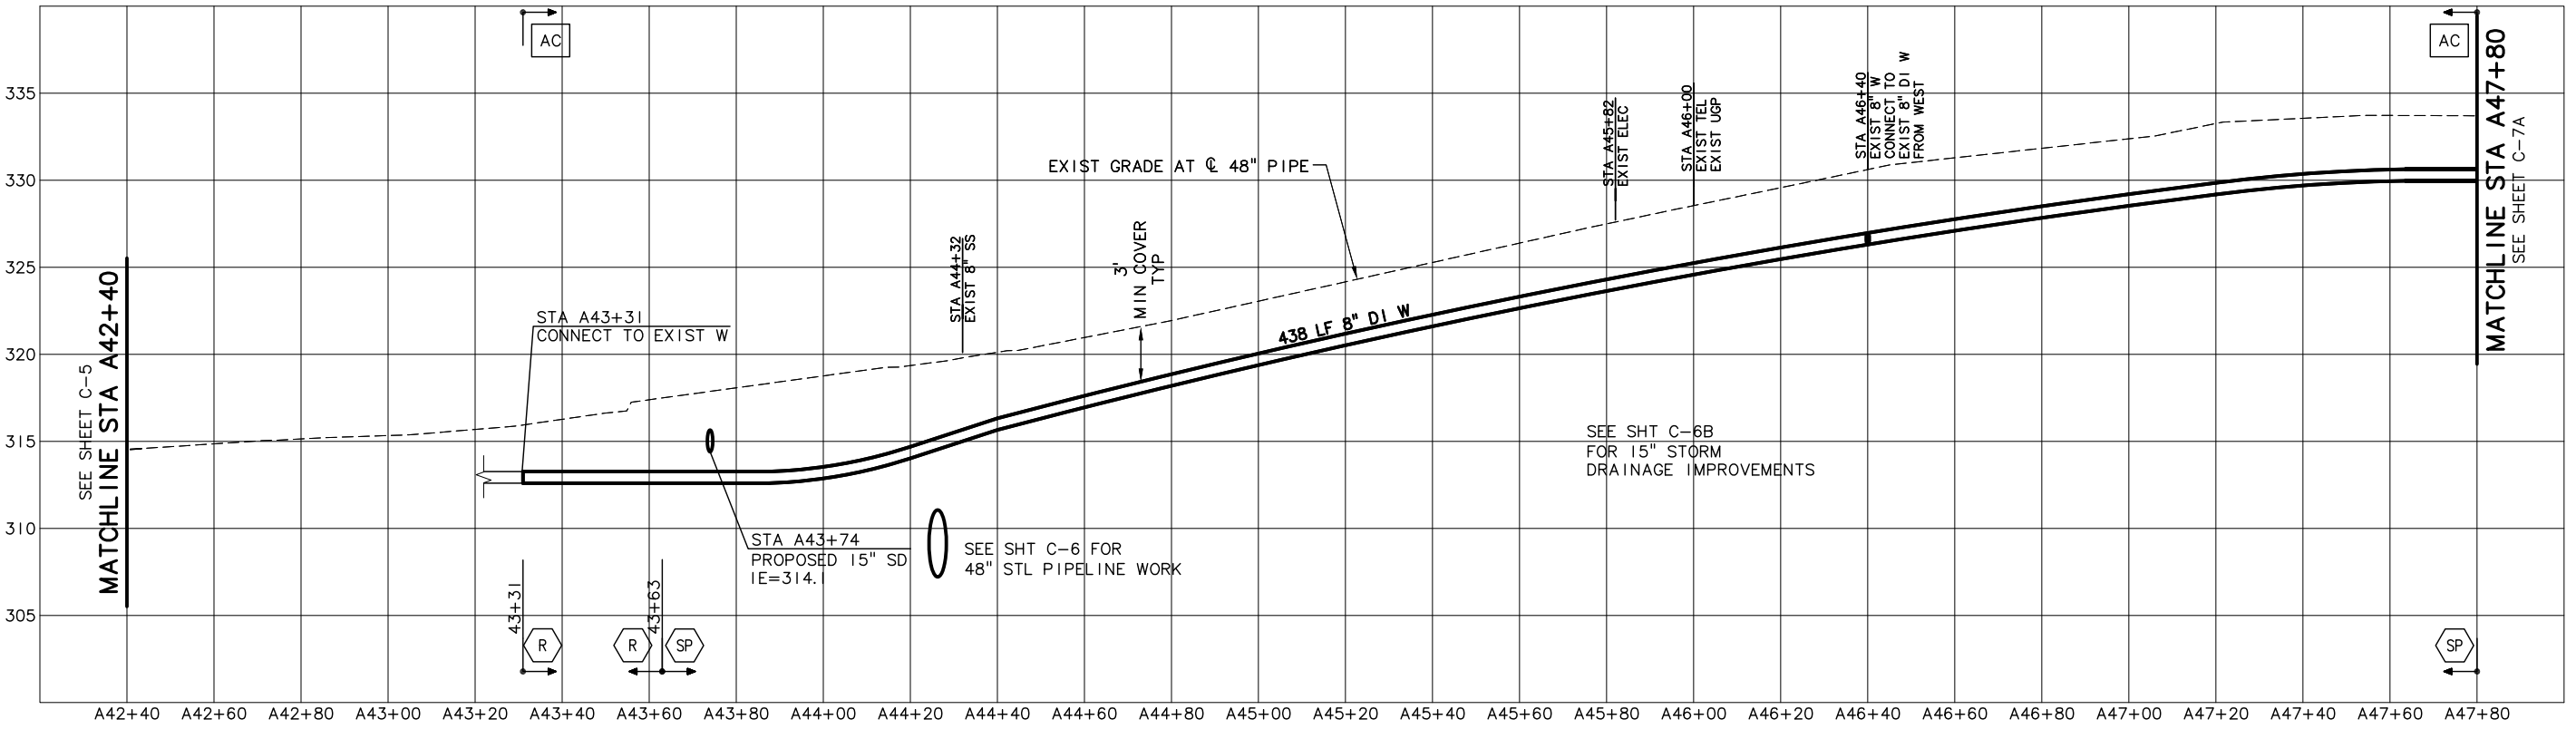

PROFILE
SCALE: 1"=20' HORIZ 1"=5' VERT

NO.	DATE	BY	REVISION
1	08/22/11	BVO	RECORD DRAWING

NOTICE

0 1/2 1

IF THIS BAR DOES NOT MEASURE 1" THEN DRAWING IS NOT TO SCALE

SMG DESIGNED
DAK DRAWN
MLH CHECKED

RECORD DRAWING

SEE DISCLAIMER, SHEET 1.

VERSION 4.1
12-9-97

MSA Murray Smith & Associates, Inc.
Engineers/Planners

121 S.W. Salmon, Suite 900
Portland, Oregon 97204

PHONE 503-225-9010
FAX 503-225-9022

City of Sherwood Oregon


WATER SUPPLY IMPROVEMENT PROJECT TRANSMISSION PIPELINE

**WATERLINE SCHEDULE A
8" WATER PLAN AND PROFILE
STA A43+92 TO STA A47+80**

PROJECT NO.: 07-0873.207 SCALE: AS SHOWN DATE: JUNE 2009


SHEET
C-6A
27 of 79

C:\PDX_Projects\07_0873\207_Design-Final_Plans\CAD\DOR\07-0873-207-OR-CIVIL A - C-6B-R.dwg 9/8/2011 10:09 AM DAK 18.1s (LMS Tech)

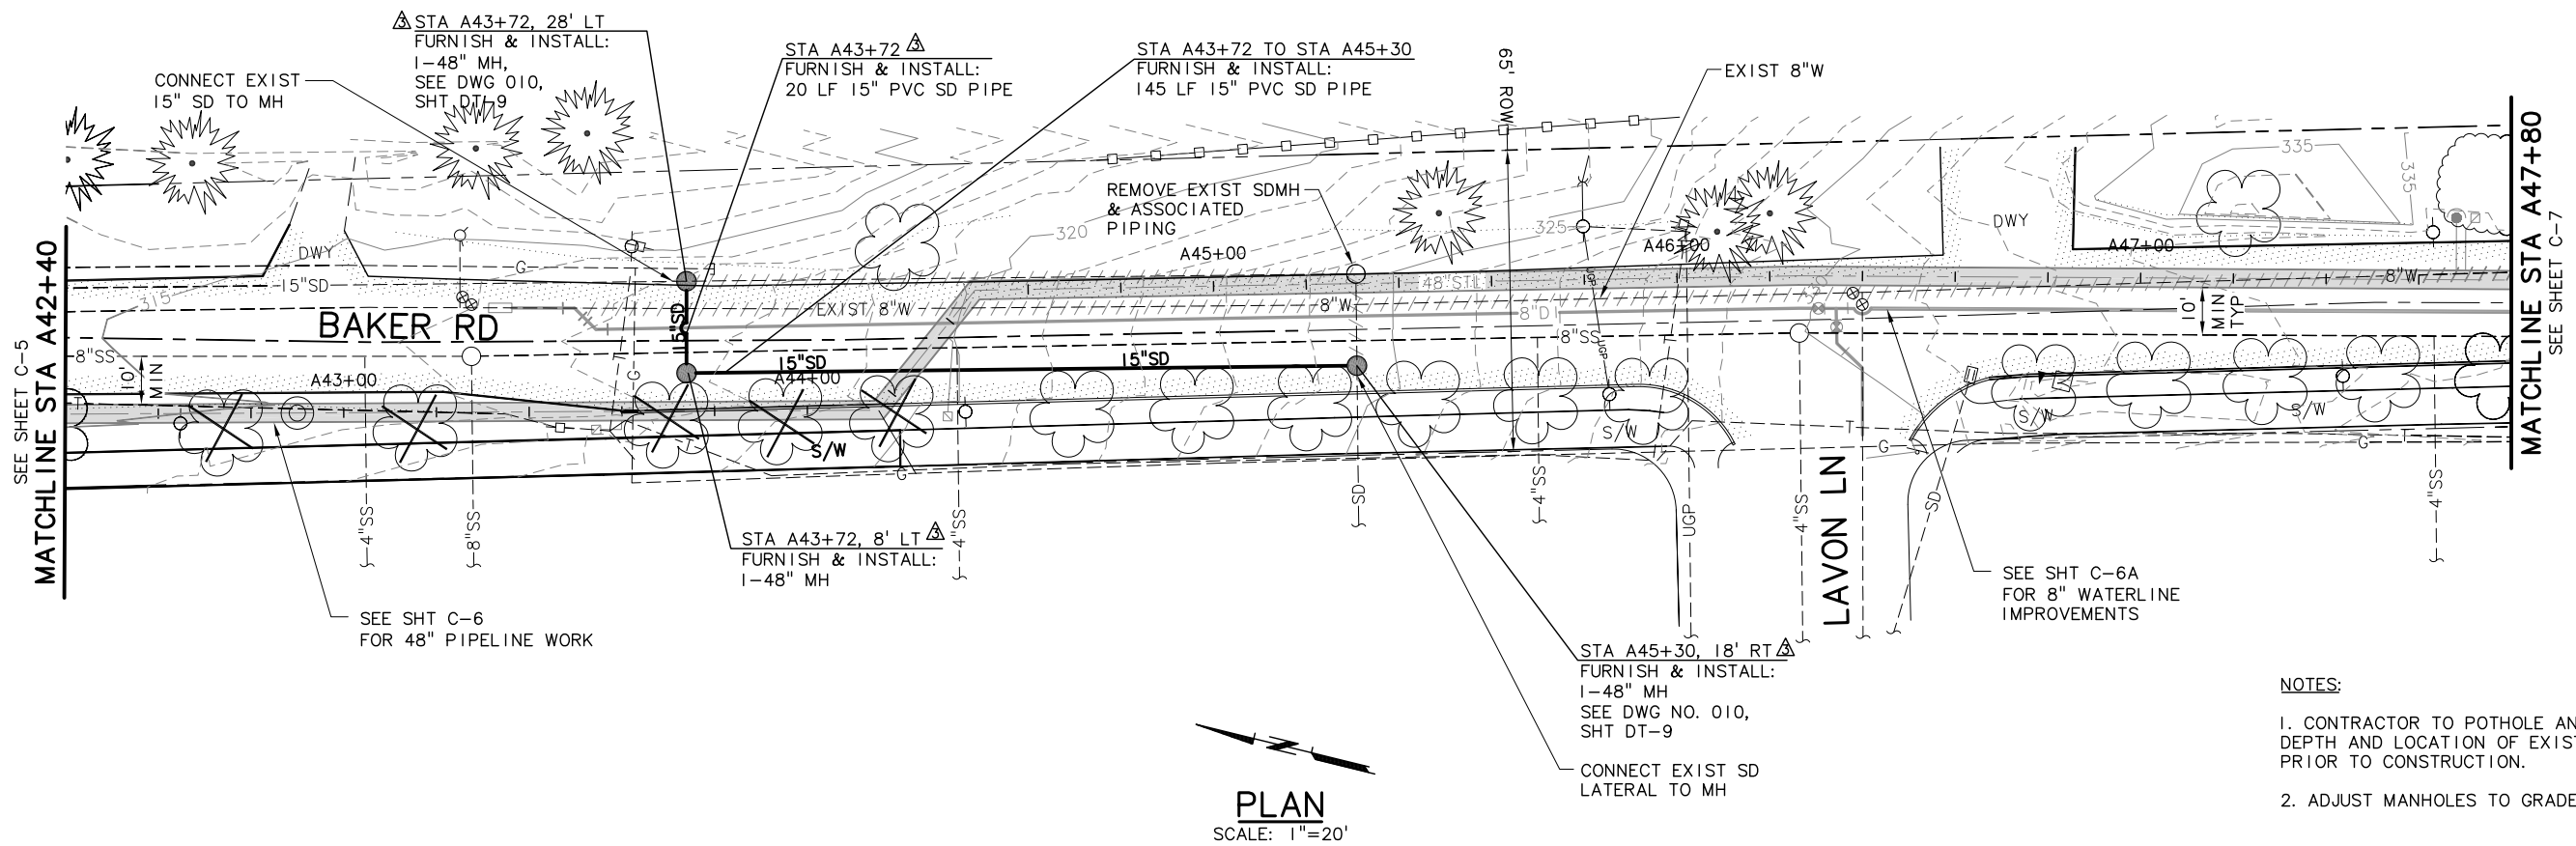

PLAN
SCALE: 1"=20'

- NOTES:**
1. CONTRACTOR TO POTHOLE AND VERIFY EXACT DEPTH AND LOCATION OF EXISTING UTILITIES PRIOR TO CONSTRUCTION.
 2. ADJUST MANHOLES TO GRADE.

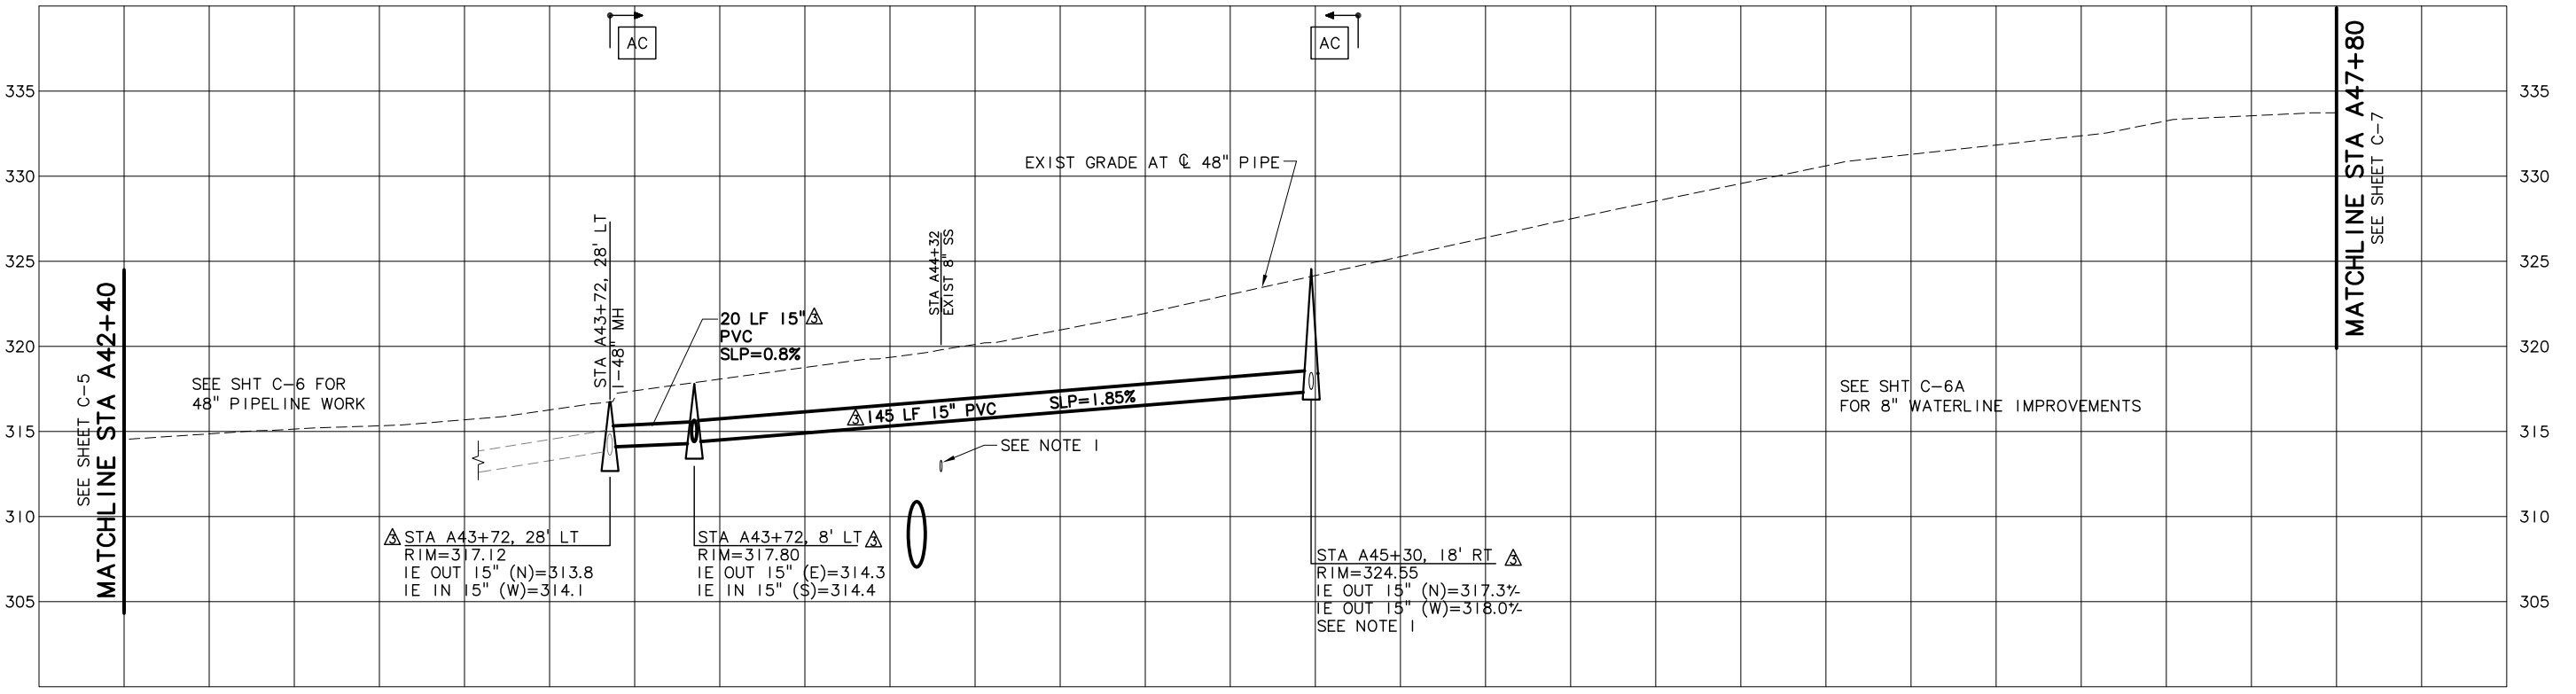

PROFILE
SCALE: 1"=20' HORIZ 1"=5' VERT

NO.	DATE	BY	REVISION
1	08/22/11	BVO	RECORD DRAWING

NOTICE

0 1/2 1

IF THIS BAR DOES NOT MEASURE 1" THEN DRAWING IS NOT TO SCALE

SMG DESIGNED
DAK DRAWN
MLH CHECKED

RECORD DRAWING

SEE DISCLAIMER, SHEET 1.

VERSION 4.1
12-9-97

MSA Murray Smith & Associates, Inc.
Engineers/Planners

121 S.W. Salmon, Suite 900 PHONE 503-225-9010
Portland, Oregon 97204 FAX 503-225-9022

City of Sherwood Oregon


WATER SUPPLY IMPROVEMENT PROJECT TRANSMISSION PIPELINE

**WATERLINE SCHEDULE A
15" SD PLAN AND PROFILE
STA A43+74 TO STA A45+31**

PROJECT NO.: 07-0873.207 SCALE: AS SHOWN DATE: JUNE 2009


SHEET
C-6B
28 of 79

C:\Users\dak\appdata\local\temp\AcPublish_5992\07-0873-207-OR-CIVIL A-R.dwg C-7 9/8/2011 11:24 AM DAK 18.1s (LMS Tech)

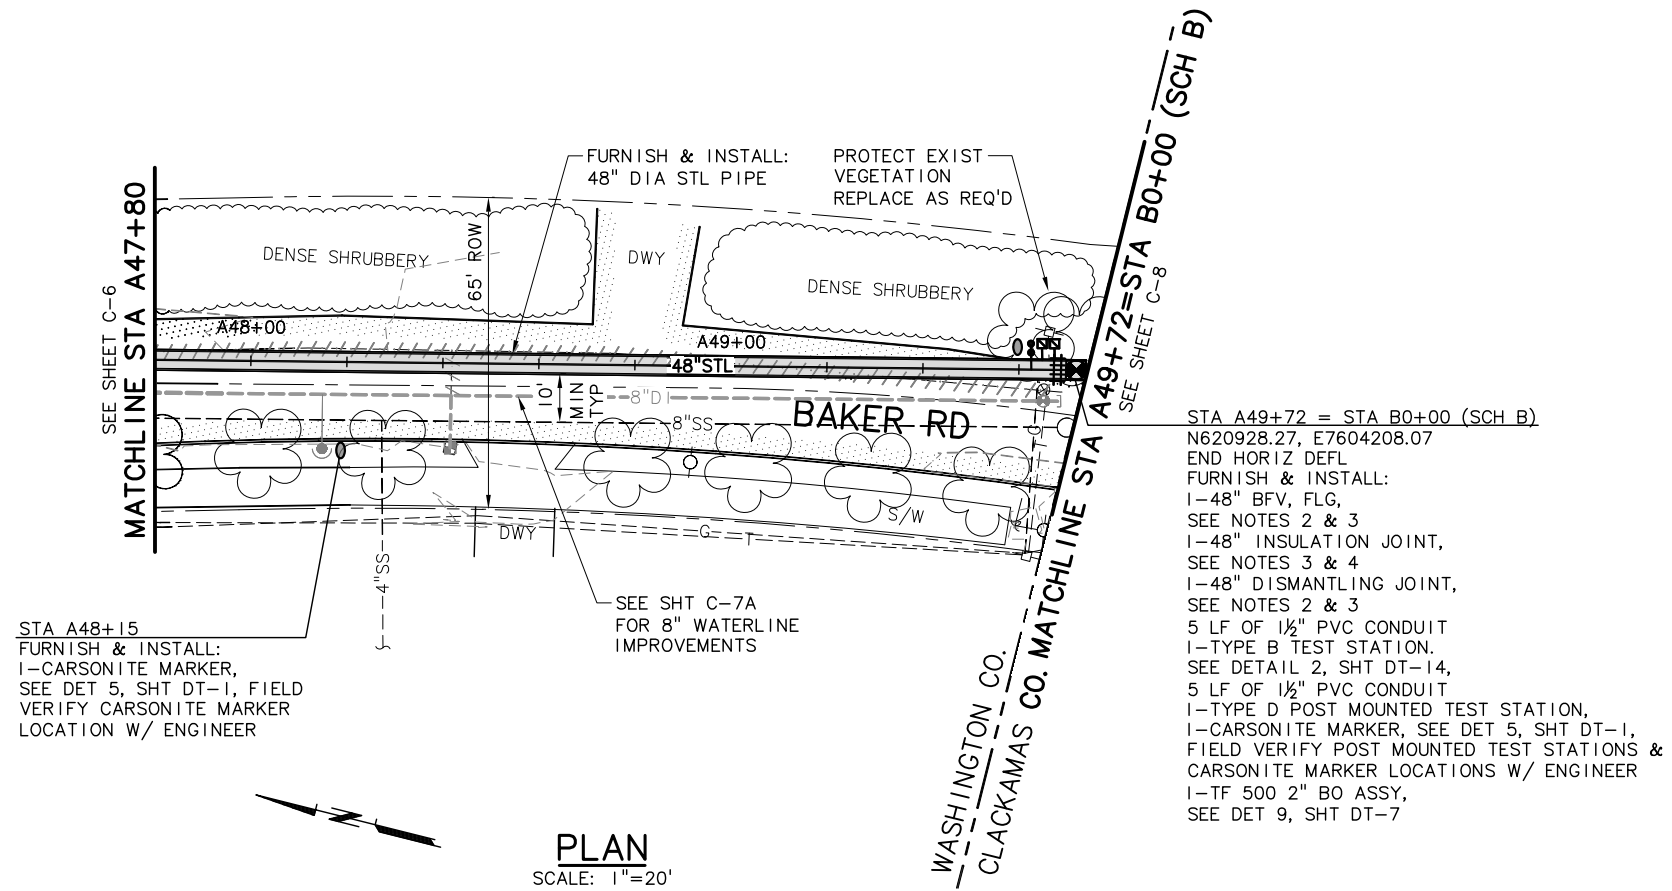

NOTES:

1. ADJUST VALVE BOXES TO GRADE.
2. INSTALL TWO NO. 2 AWG STRAND WIRES FROM PIPE FLANGE TO VALVE/JOINT FLANGE USING THE THERMITE WELD METHOD.
3. WRAP WITH 2 LAYERS OF 8 MIL POLYETHYLENE.
4. TAPE INSULATION JOINT WITH 40 MIL POLYKEN TAPE, OR EQUAL. OVERLAP PER MANUFACTURER'S RECOMMENDATION.

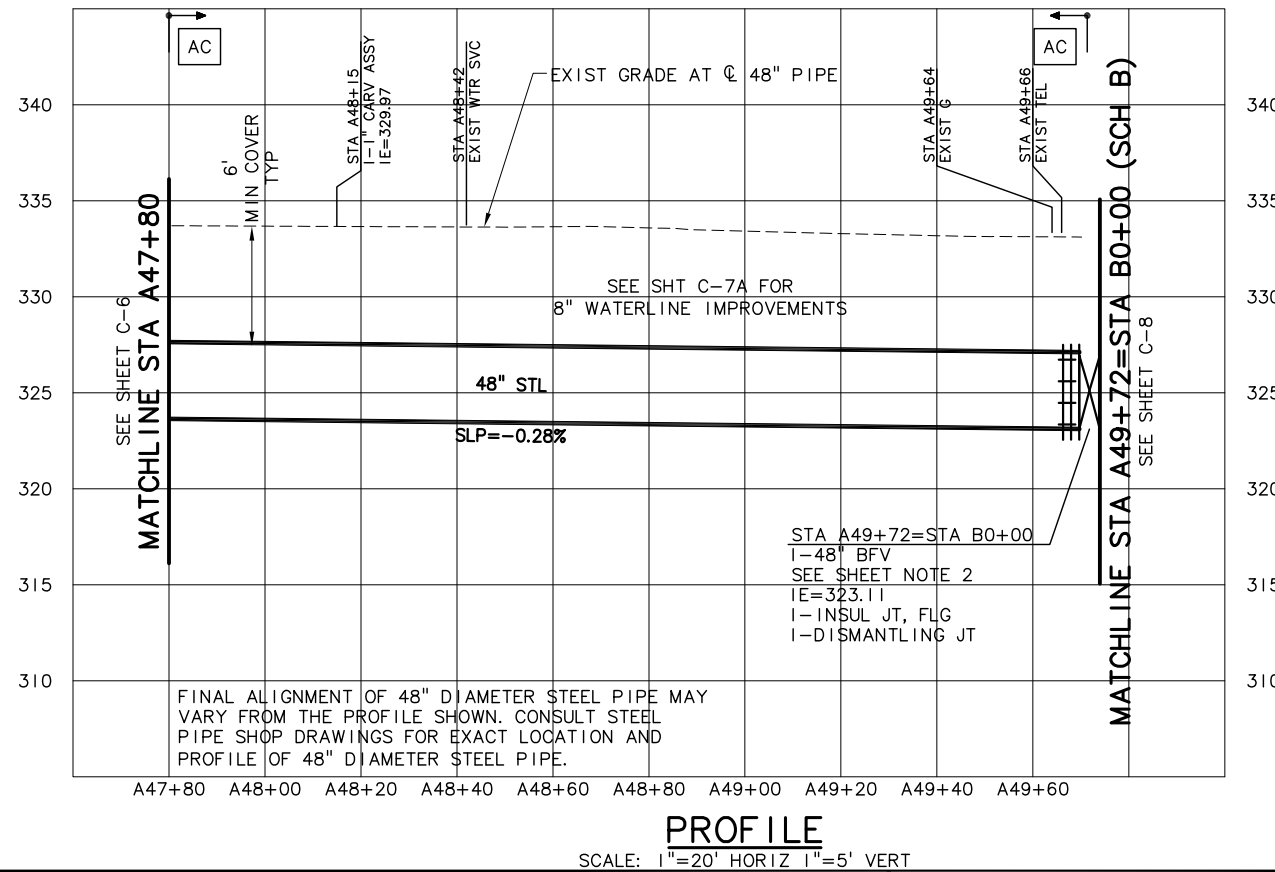

NO.	DATE	BY	REVISION
1	08/22/11	BVO	RECORD DRAWING

NOTICE

0 1/2 1

IF THIS BAR DOES NOT MEASURE 1" THEN DRAWING IS NOT TO SCALE

SMG
DESIGNED

DAK
DRAWN

MLH
CHECKED

RECORD DRAWING

SEE DISCLAIMER, SHEET 1.

VERSION 4.1
12-9-97

MSA Murray Smith & Associates, Inc.
Engineers/Planners

121 S.W. Salmon, Suite 900 PHONE 503-225-9010
Portland, Oregon 97204 FAX 503-225-9022

City of Sherwood Oregon


WATER SUPPLY IMPROVEMENT PROJECT TRANSMISSION PIPELINE

**WATERLINE SCHEDULE A
48" WATER PLAN AND PROFILE
STA A47+80 TO STA A49+72**


PROJECT NO.: 07-0873.207 SCALE: AS SHOWN DATE: JUNE 2009

SHEET
C-7
29 of 79

C:\PDX_Projects\07_0873\207_Design-Final_Plans\CAD\DOR\07-0873-207-OR-CIVIL A - C-6A_C-7A-R.dwg C-7A 9/8/2011 10:08 AM DAK 18.1s (LMS Tech)

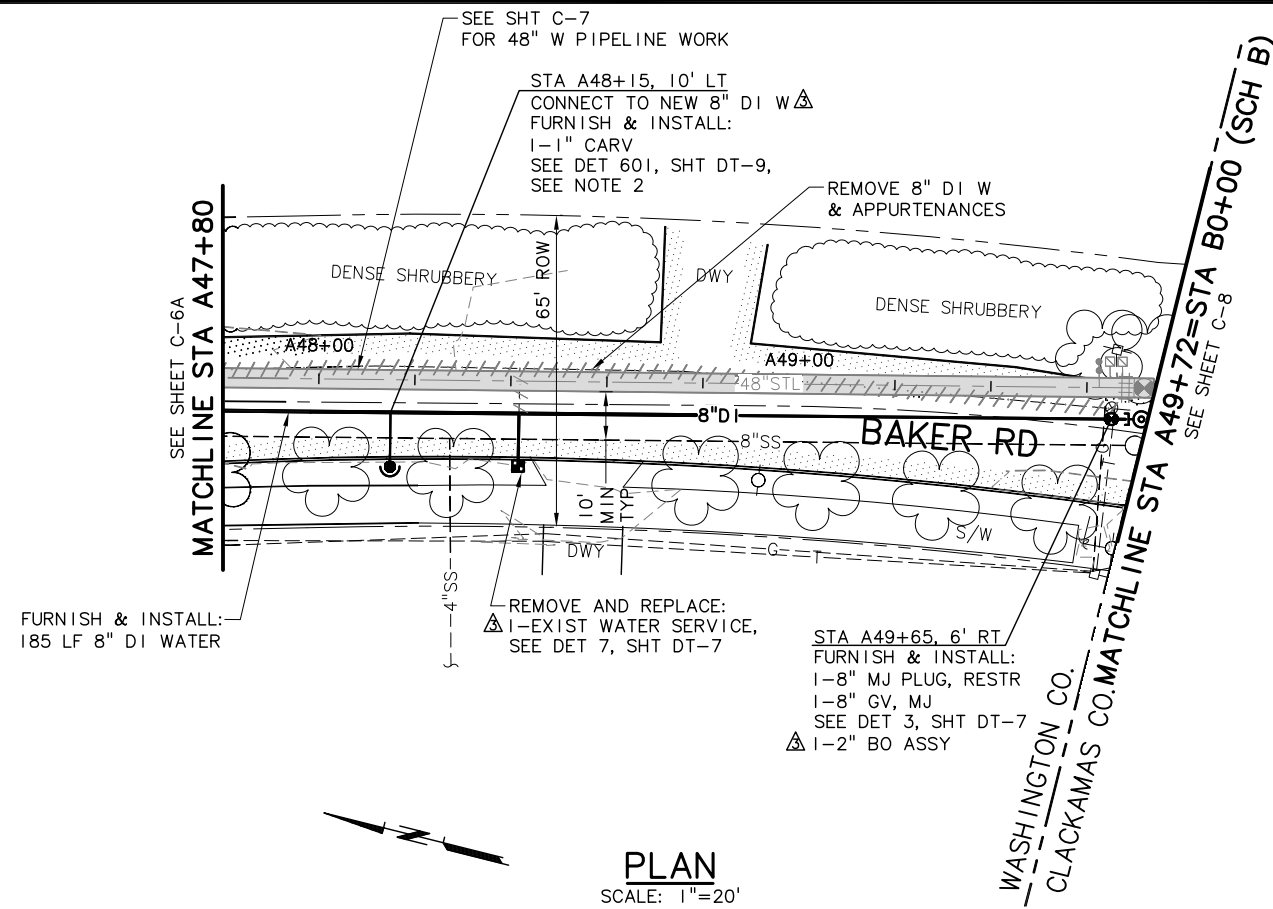

- NOTES:**
- ADJUST VALVE BOXES TO GRADE.
 - PLACE AIR RELEASE VALVE PIPING IN SERVICE LINE TRENCH

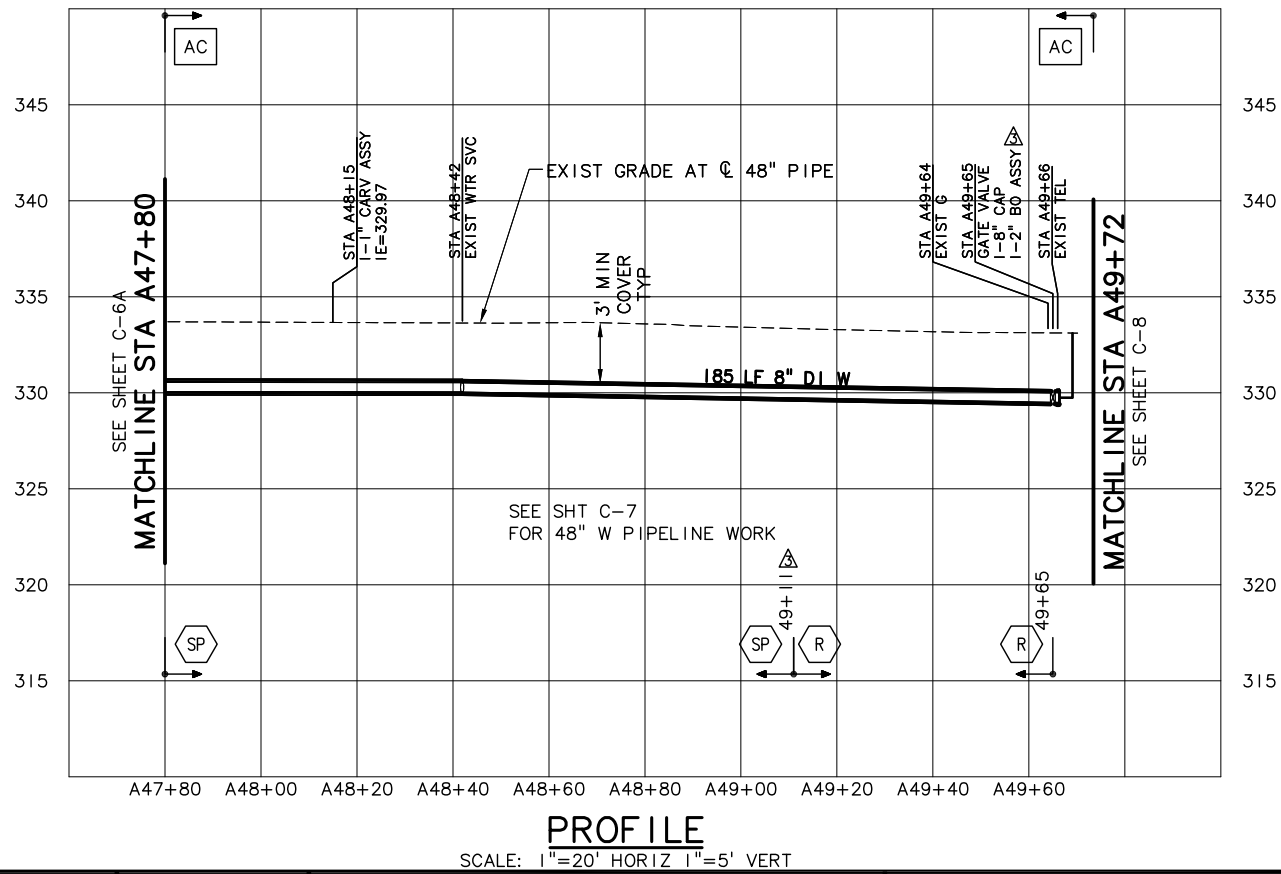

NO.	DATE	BY	REVISION
1	08/22/11	BVO	RECORD DRAWING

NOTICE

0 1/2 1

IF THIS BAR DOES NOT MEASURE 1" THEN DRAWING IS NOT TO SCALE

SMG DESIGNED
DAK DRAWN
MLH CHECKED

RECORD DRAWING

SEE DISCLAIMER, SHEET 1.

VERSION 4.1
12-9-97

MSA Murray Smith & Associates, Inc.
Engineers/Planners

121 S.W. Salmon, Suite 900 PHONE 503-225-9010
Portland, Oregon 97204 FAX 503-225-9022

City of Sherwood Oregon


WATER SUPPLY IMPROVEMENT PROJECT TRANSMISSION PIPELINE

**WATERLINE SCHEDULE A
8\"/>**

PROJECT NO.: 07-0873.207 SCALE: AS SHOWN DATE: JUNE 2009

SHEET
C-7A
30 of 79

C:\Users\dak\AppData\Local\temp\AcPublish_1580\07-0873-207-OR-CIVIL B-R.dwg C-8 9/8/2011 10:22 AM DAK 18.1s (LMS Tech)

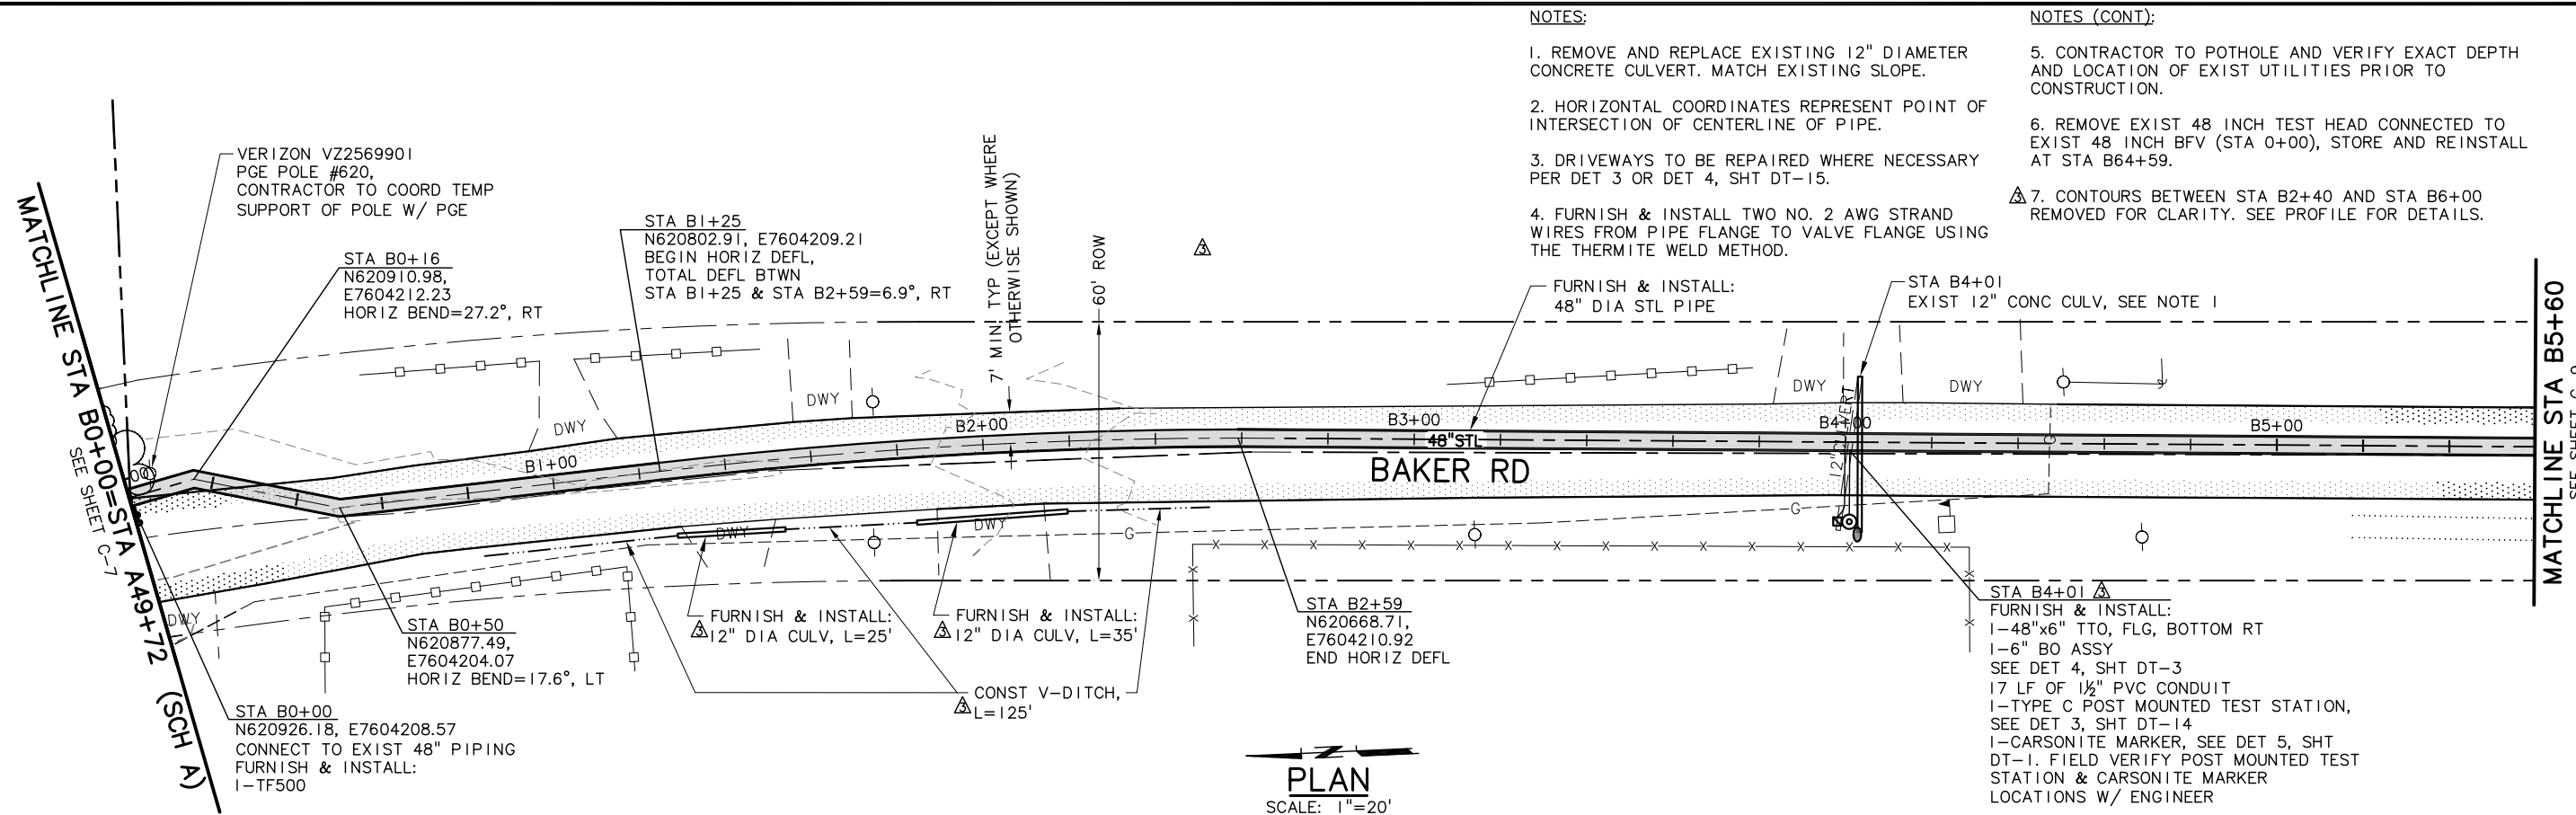


NOTES:

1. REMOVE AND REPLACE EXISTING 12" DIAMETER CONCRETE CULVERT. MATCH EXISTING SLOPE.
2. HORIZONTAL COORDINATES REPRESENT POINT OF INTERSECTION OF CENTERLINE OF PIPE.
3. DRIVEWAYS TO BE REPAIRED WHERE NECESSARY PER DET 3 OR DET 4, SHT DT-15.
4. FURNISH & INSTALL TWO NO. 2 AWG STRAND WIRES FROM PIPE FLANGE TO VALVE FLANGE USING THE THERMITE WELD METHOD.

NOTES (CONT):

5. CONTRACTOR TO POTHOLE AND VERIFY EXACT DEPTH AND LOCATION OF EXIST UTILITIES PRIOR TO CONSTRUCTION.
6. REMOVE EXIST 48 INCH TEST HEAD CONNECTED TO EXIST 48 INCH BFV (STA 0+00), STORE AND REINSTALL AT STA B64+59.
7. CONTOURS BETWEEN STA B2+40 AND STA B6+00 REMOVED FOR CLARITY. SEE PROFILE FOR DETAILS.

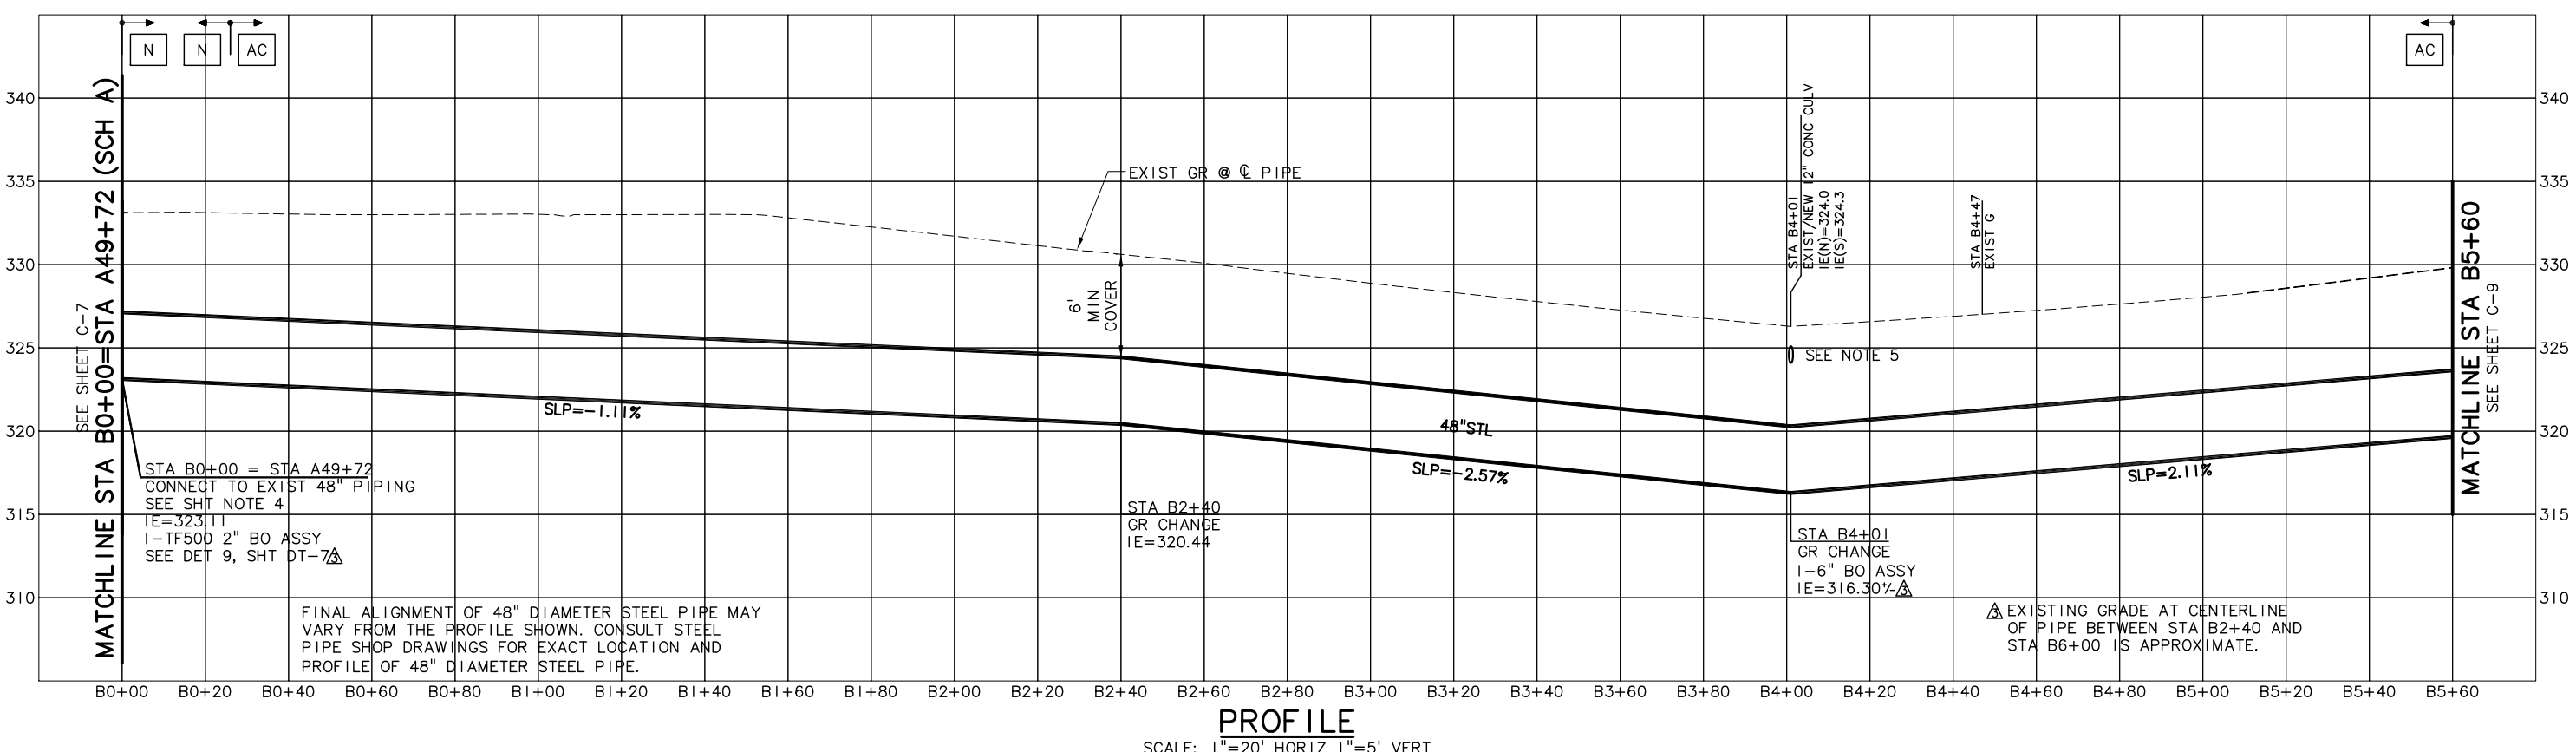

NO.	DATE	BY	REVISION
1	08/22/11	BVO	RECORD DRAWING

NOTICE

0 1/2 1

IF THIS BAR DOES NOT MEASURE 1" THEN DRAWING IS NOT TO SCALE

SMG DESIGNED
DAK DRAWN
MLH CHECKED

RECORD DRAWING

SEE DISCLAIMER, SHEET 1.

VERSION 4.1
12-9-97

MSA Murray Smith & Associates, Inc.
Engineers/Planners

121 S.W. Salmon, Suite 900 PHONE 503-225-9010
Portland, Oregon 97204 FAX 503-225-9022

City of Sherwood Oregon

WATER SUPPLY IMPROVEMENT PROJECT TRANSMISSION PIPELINE

WATERLINE SCHEDULE B PLAN AND PROFILE STA B0+00 TO STA B5+60

PROJECT NO.: 07-0873.207 SCALE: AS SHOWN DATE: JUNE 2009

SHEET C-8
31 of 79


NOTES:

1. HORIZONTAL COORDINATES REPRESENT POINT OF INTERSECTION OF CENTERLINE OF PIPE.


2. DRIVEWAYS TO BE REPAIRED WHERE NECESSARY PER DET 3 OR DET 4, SHT DT-15.

3. CONTOURS BETWEEN STA B2+40 AND STA B6+00 REMOVED FOR CLARITY. SEE PROFILE FOR DETAILS.

STA B9+40
 FURNISH & INSTALL:
 1-48"x10" OUTLET, TOP
 1-10" GV, FLG
 1-10" SURGE CRITICAL CARV ASSY
 SEE DET 1, SHT DT-5
 38 LF OF 1/2" PVC CONDUIT
 1-TYPE C POST MOUNTED TEST STATION,
 SEE DET 3, SHT DT-14
 1-CARSONITE MARKER, SEE DET 5, SHT
 DT-1, FIELD VERIFY POST MOUNTED TEST
 STATION AND CARSONITE MARKER
 LOCATIONS W/ ENGINEER

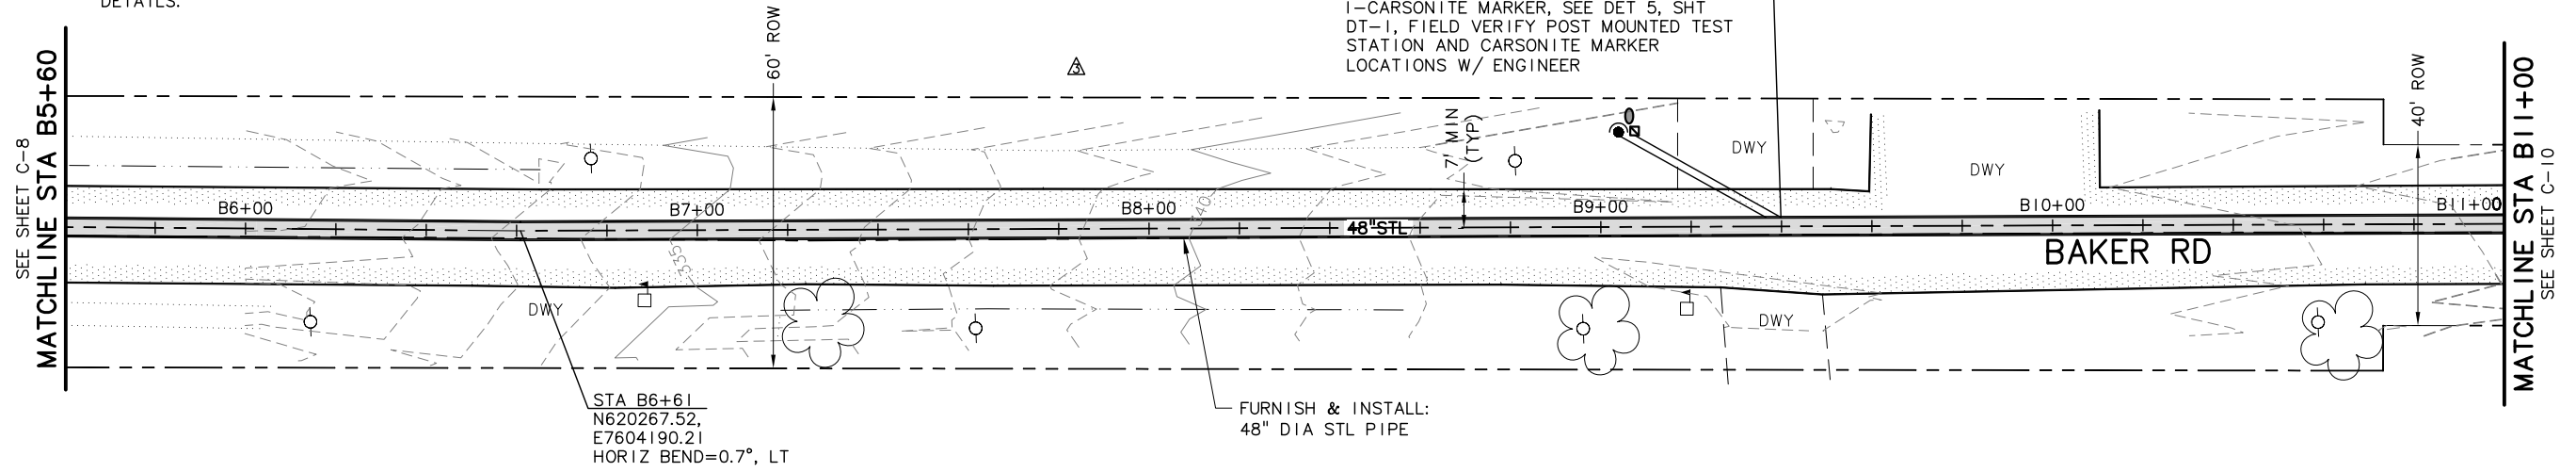

PLAN
 SCALE: 1"=20'

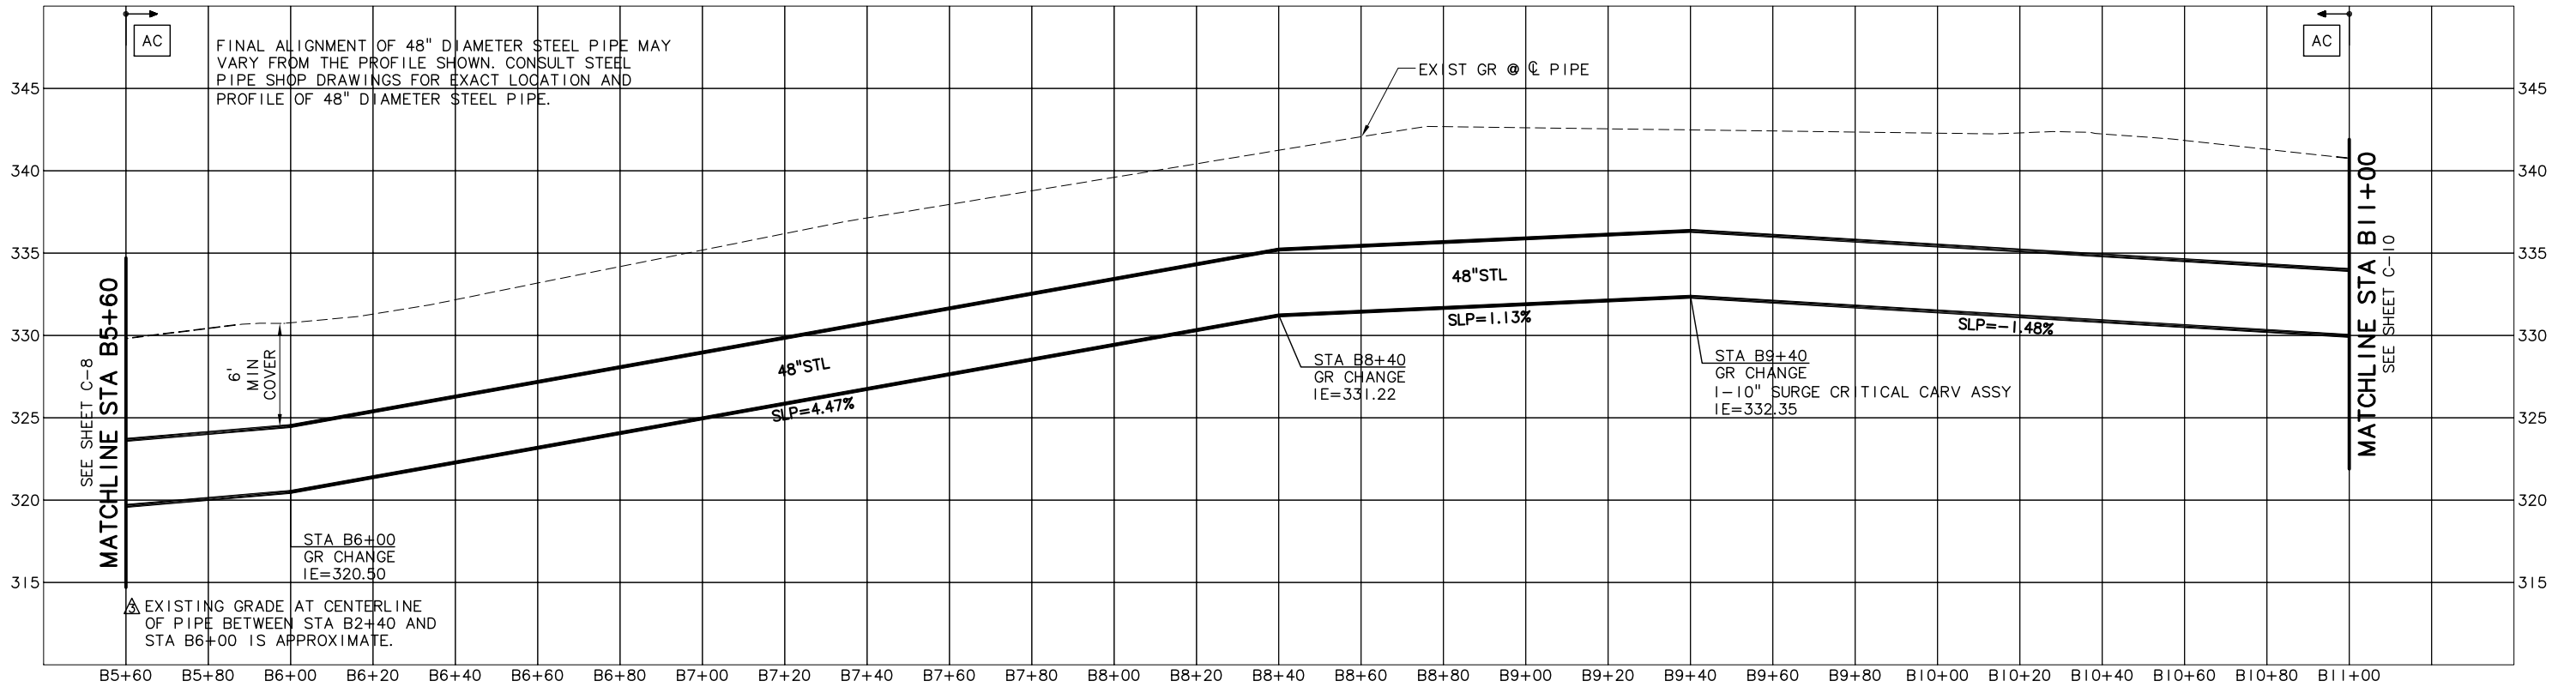

PROFILE
 SCALE: 1"=20' HORIZ 1"=5' VERT

C:\Users\dak\AppData\Local\Temp\AcPublish_1580\07-0873-207-OR-CIVIL B-R.dwg C-9 9/8/2011 10:22 AM DAK 18.1s (LMS Tech)

NO.	DATE	BY	REVISION
1	08/22/11	BVO	RECORD DRAWING

NOTICE

0 1/2 1

IF THIS BAR DOES NOT MEASURE 1" THEN DRAWING IS NOT TO SCALE

SMG DESIGNED
 DAK DRAWN
 MLH CHECKED

RECORD DRAWING
 SEE DISCLAIMER, SHEET 1.
 VERSION 4.1
 12-9-97

MSA Murray Smith & Associates, Inc.
 Engineers/Planners
 121 S.W. Salmon, Suite 900 PHONE 503-225-9010
 Portland, Oregon 97204 FAX 503-225-9022



WATER SUPPLY IMPROVEMENT PROJECT TRANSMISSION PIPELINE



WATERLINE SCHEDULE B PLAN AND PROFILE STA B5+60 TO STA B11+00

PROJECT NO.: 07-0873.207 SCALE: AS SHOWN DATE: JUNE 2009

SHEET
C-9
 32 of 79

NOTES:

1. DRIVEWAYS TO BE REPAIRED WHERE NECESSARY PER DET 3 OR DET 4, SHT DT-15.
2. HORIZONTAL COORDINATES REPRESENT POINT OF INTERSECTION OF CENTERLINE OF PIPE.

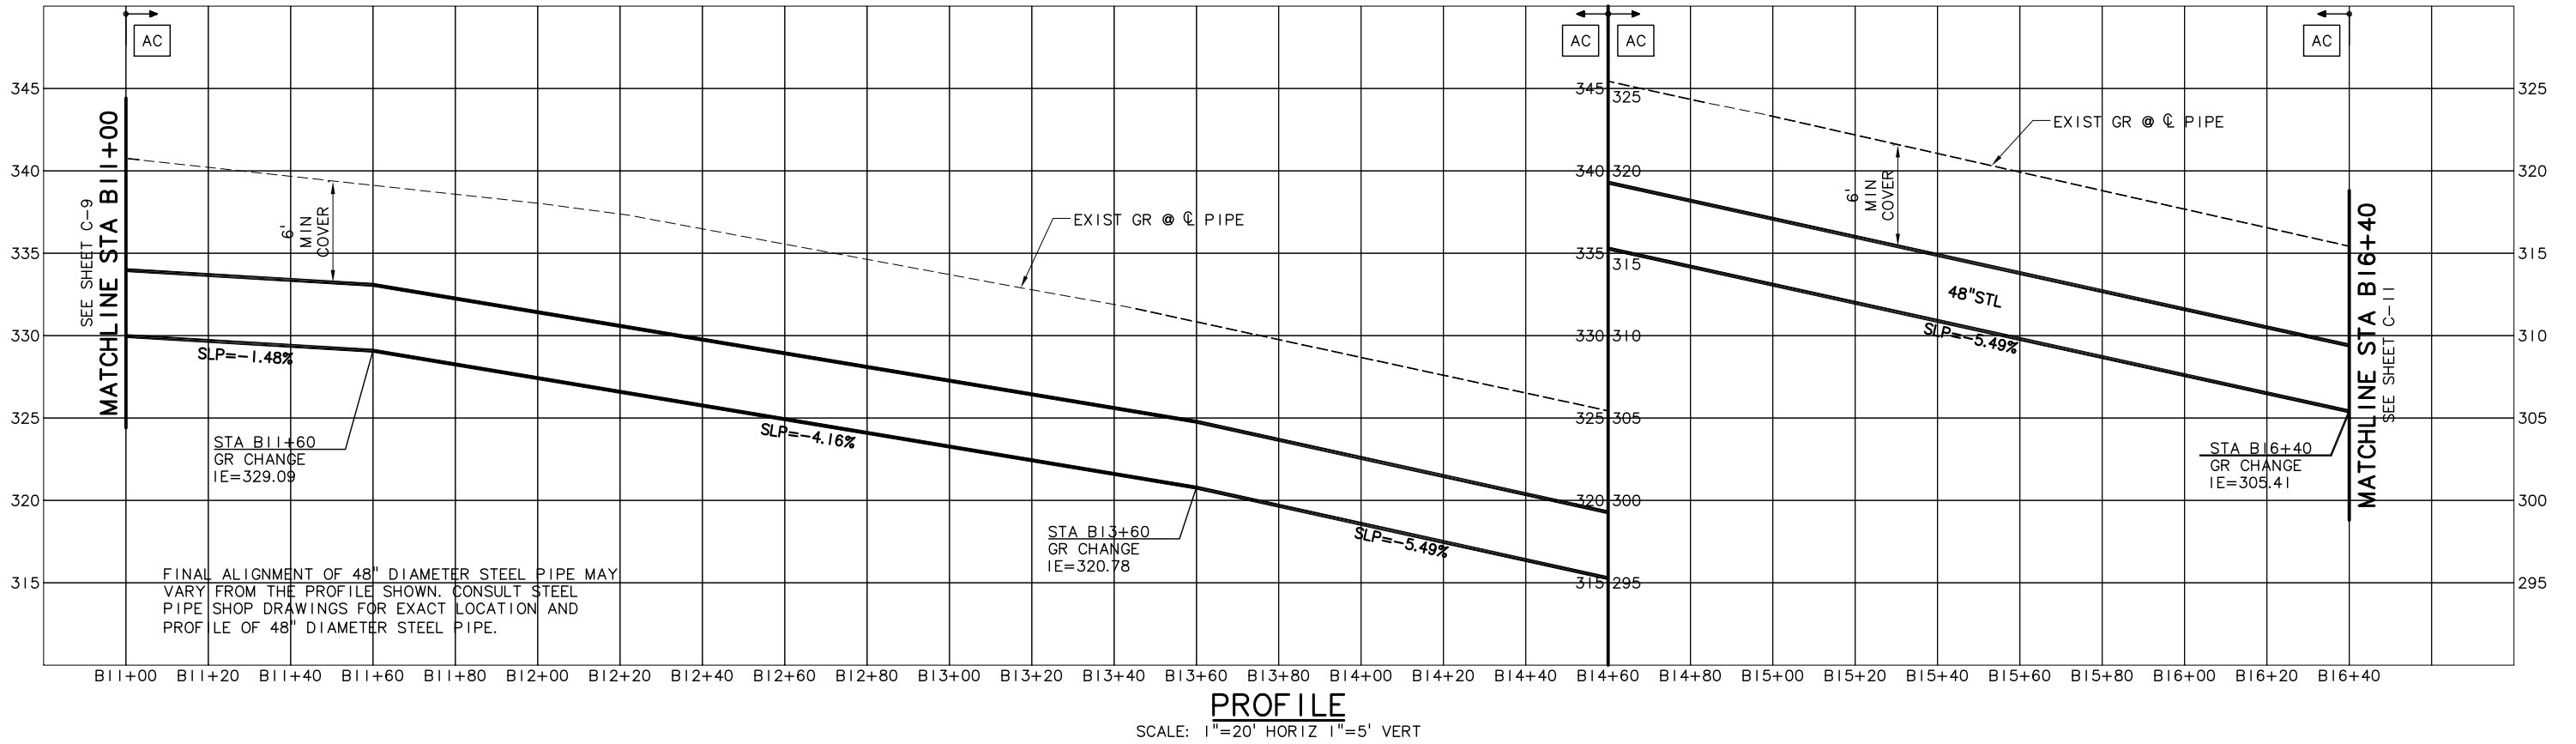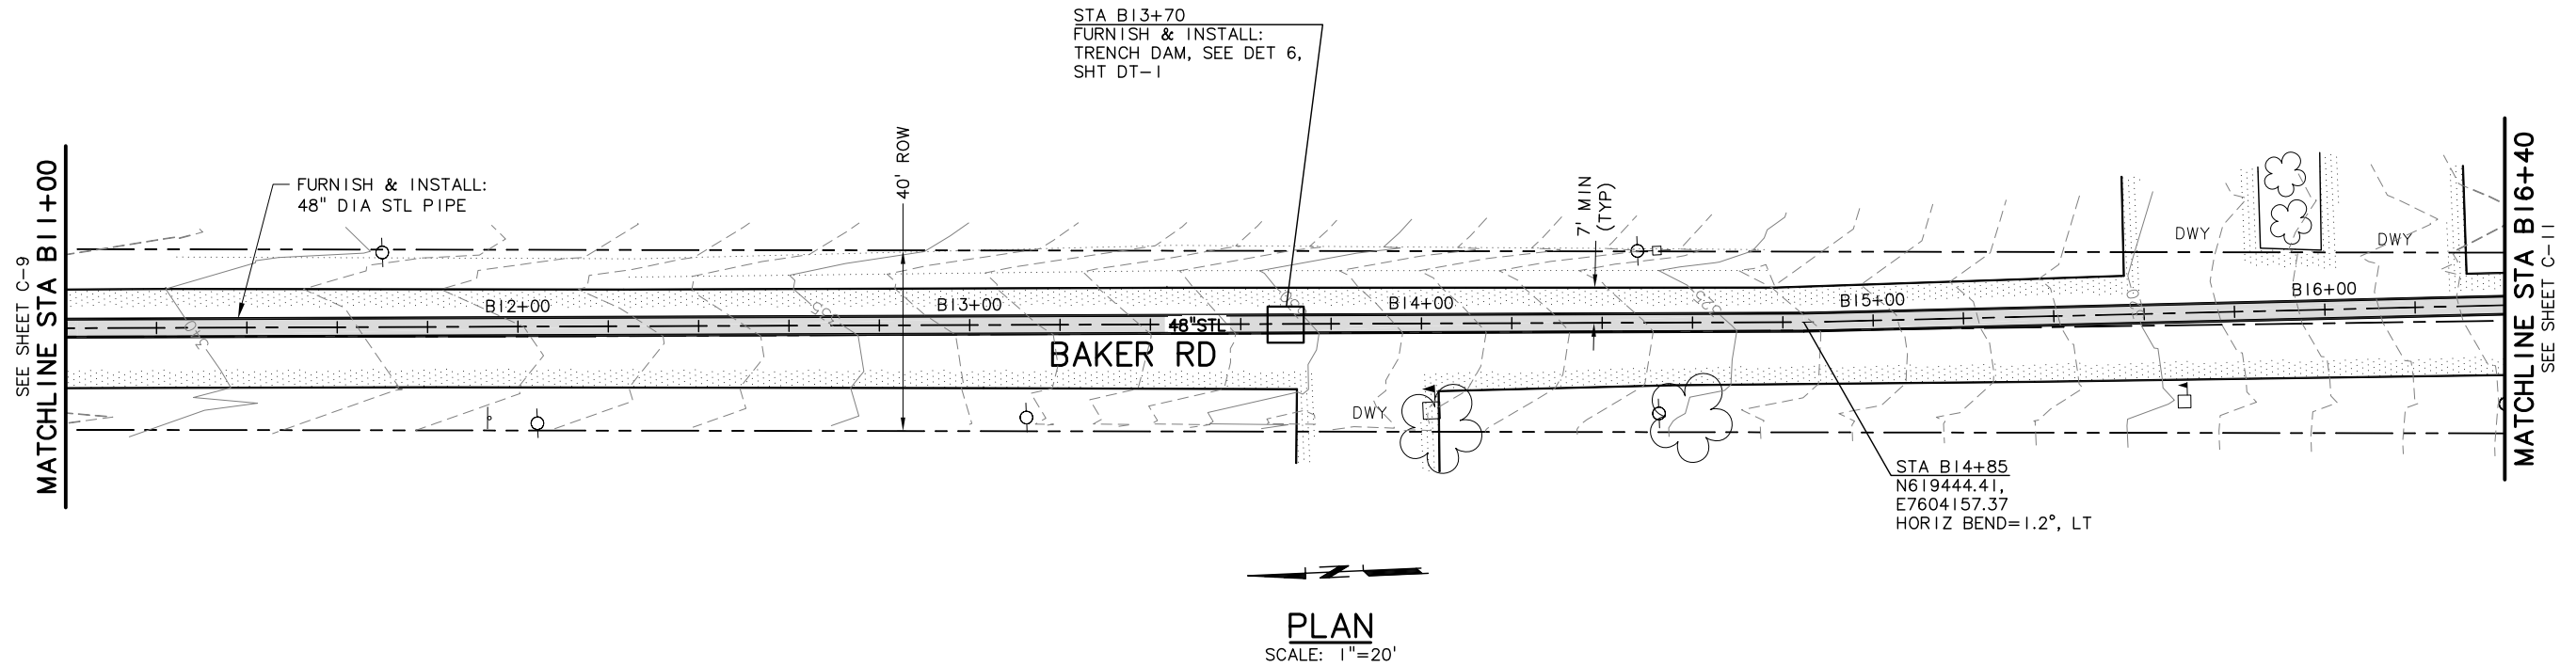

C:\Users\dak\AppData\Local\Temp\AcPublish_1580\07-0873-207-OR-CIVIL B-R.dwg C-10 9/8/2011 10:22 AM DAK 18.1s (LMS Tech)

NO.	DATE	BY	REVISION
1	08/22/11	BVO	RECORD DRAWING

NOTICE

0 1/2 1

IF THIS BAR DOES NOT MEASURE 1" THEN DRAWING IS NOT TO SCALE

SMG DESIGNED
DAK DRAWN
MLH CHECKED

RECORD DRAWING

SEE DISCLAIMER, SHEET 1.

VERSION 4.1
12-9-97

MSA Murray Smith & Associates, Inc.
Engineers/Planners

121 S.W. Salmon, Suite 900 PHONE 503-225-9010
Portland, Oregon 97204 FAX 503-225-9022

City of Sherwood Oregon


WATER SUPPLY IMPROVEMENT PROJECT TRANSMISSION PIPELINE

**WATERLINE SCHEDULE B
PLAN AND PROFILE
STA B11+00 TO STA B16+40**

PROJECT NO.: 07-0873.207 SCALE: AS SHOWN DATE: JUNE 2009


SHEET
C-10
33 of 79

C:\Users\dak\AppData\Local\temp\AcPublish_1580\07-0873-207-OR-CIVIL B-R.dwg C-11 9/8/2011 10:22 AM DAK 18.1s (LMS Tech)

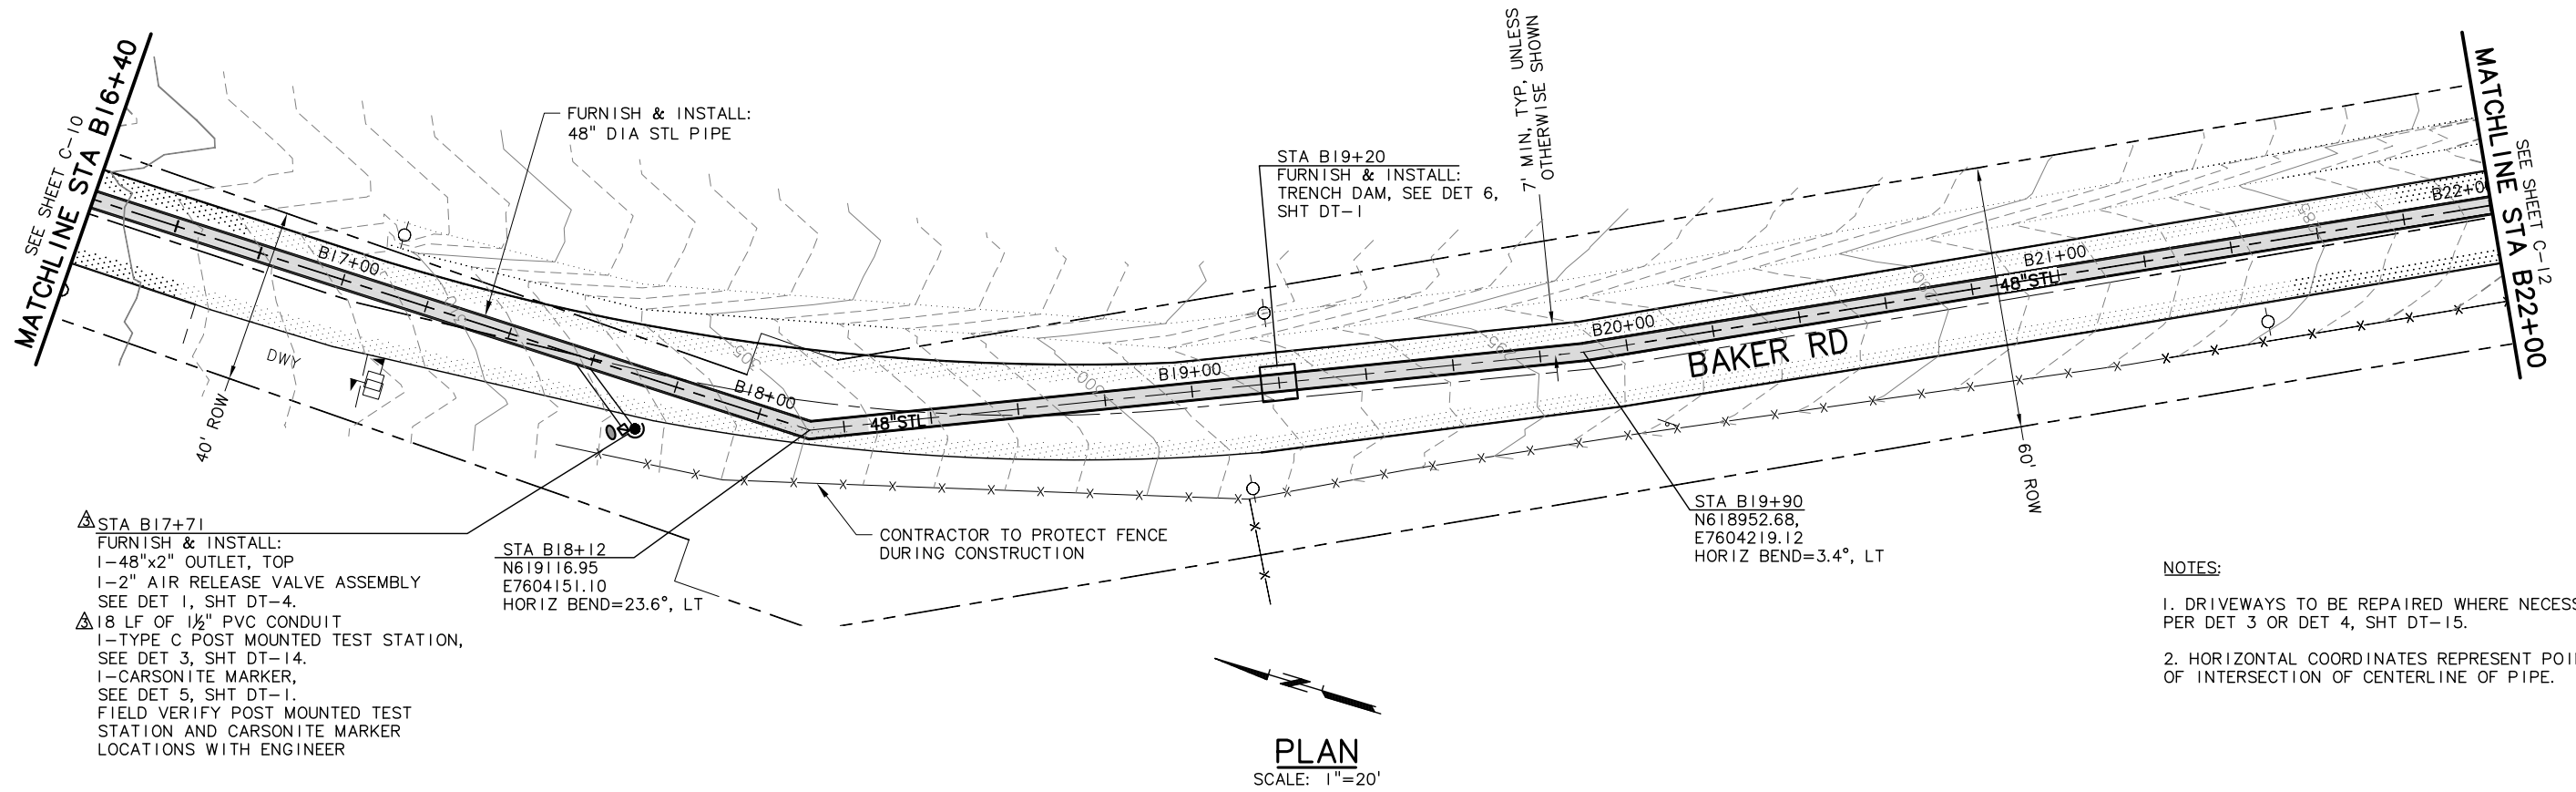

- NOTES:**
1. DRIVEWAYS TO BE REPAIRED WHERE NECESSARY PER DET 3 OR DET 4, SHT DT-15.
 2. HORIZONTAL COORDINATES REPRESENT POINT OF INTERSECTION OF CENTERLINE OF PIPE.

PLAN
SCALE: 1"=20'

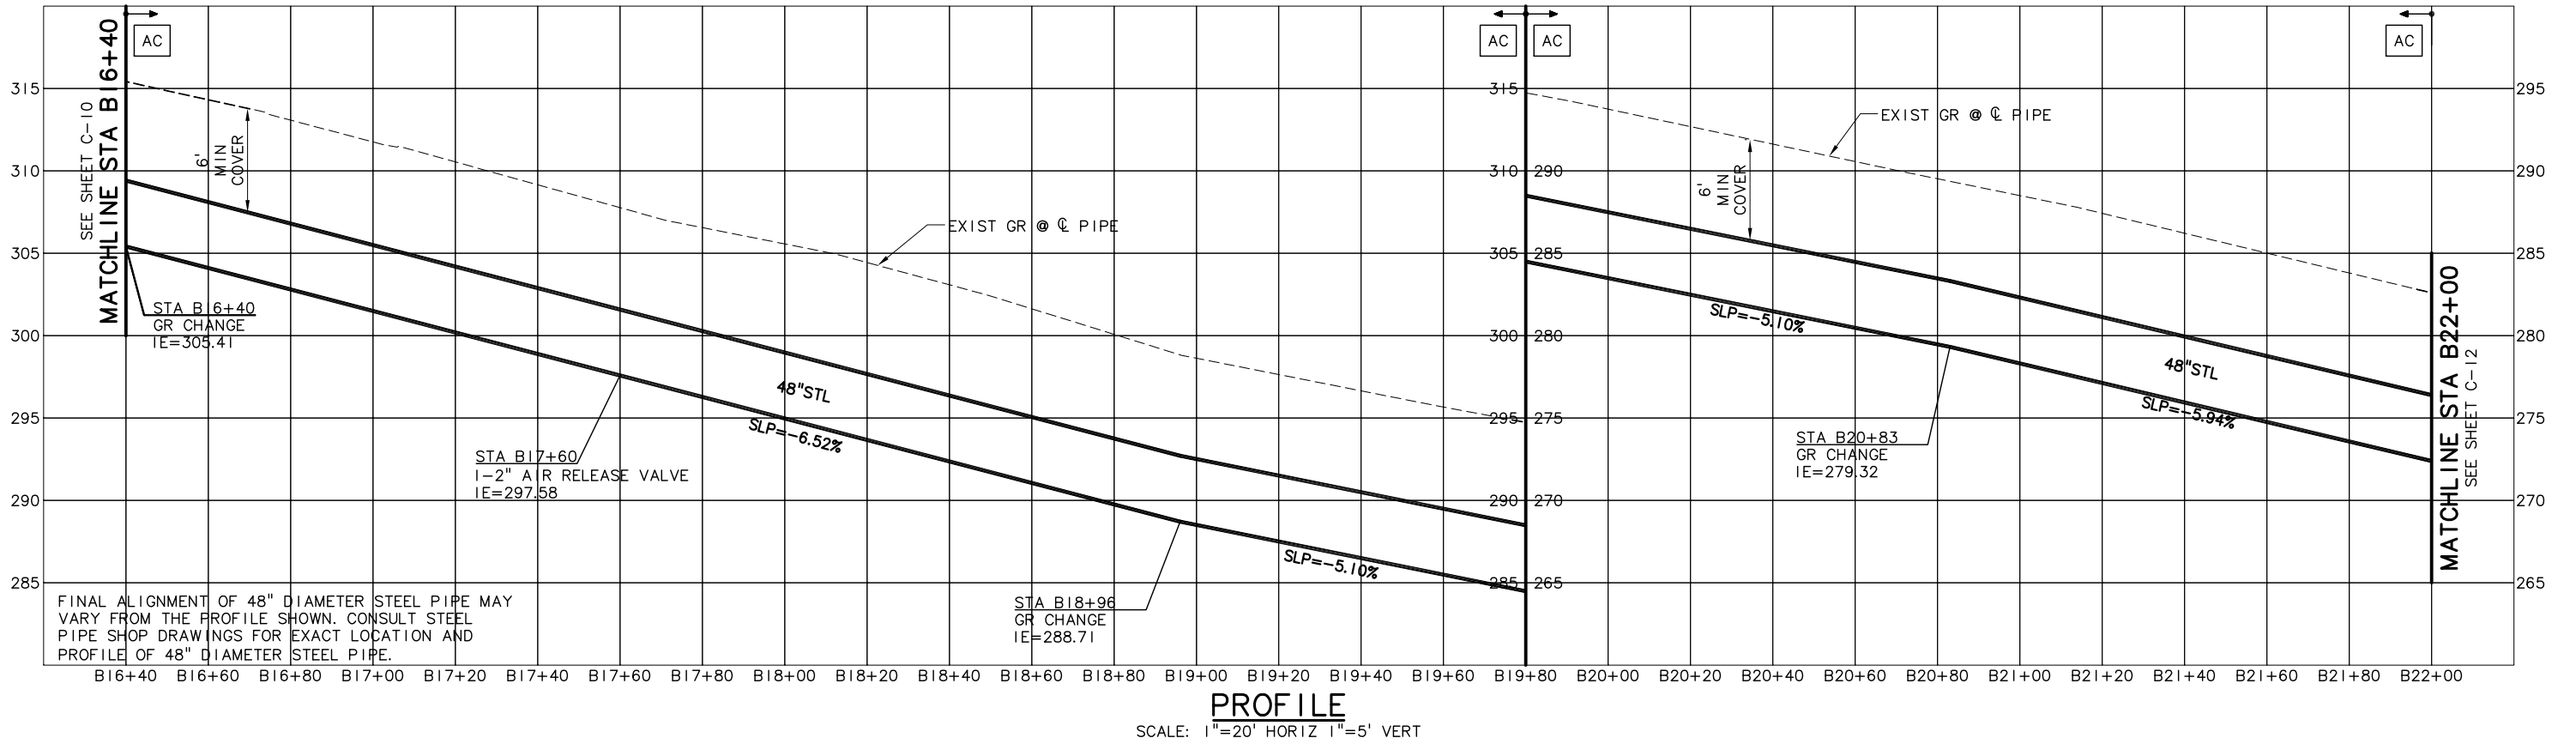

PROFILE
SCALE: 1"=20' HORIZ 1"=5' VERT

NO.	DATE	BY	REVISION
1	08/22/11	BVO	RECORD DRAWING

NOTICE

0 1/2 1

IF THIS BAR DOES NOT MEASURE 1" THEN DRAWING IS NOT TO SCALE

SMG DESIGNED
DAK DRAWN
MLH CHECKED

RECORD DRAWING
SEE DISCLAIMER, SHEET 1.
VERSION 4.1
12-9-97

MSA Murray Smith & Associates, Inc.
Engineers/Planners
121 S.W. Salmon, Suite 900 PHONE 503-225-9010
Portland, Oregon 97204 FAX 503-225-9022



WATER SUPPLY IMPROVEMENT PROJECT TRANSMISSION PIPELINE


WATERLINE SCHEDULE B PLAN AND PROFILE STA B16+40 TO STA B22+00

PROJECT NO.: 07-0873.207 SCALE: AS SHOWN DATE: JUNE 2009

SHEET C-11
34 of 79


NOTES:

1. HORIZONTAL COORDINATES REPRESENT POINT OF INTERSECTION OF CENTERLINE OF PIPE.
2. COORDINATE PROTECTION, RELOCATION OR REPLACEMENT OF EXIST UTILITY POLE W/ PGE.
3. FROM STA B25+71 TO STA B26+92, WALL THICKNESS OF 48" STEEL PIPE TO BE 0.375".
4. FURNISH & INSTALL TWO NO. 2 AWG STRAND BOND WIRES FROM PIPE FLANGE TO VALVE/JOINT FLANGE (BOTH SIDES) USING THE THERMITE WELD METHOD.
5. DRIVEWAYS TO BE REPAIRED WHERE NECESSARY PER DET 3 OR DET 4, SHT DT-15.
6. WRAP WITH TWO LAYERS OF 8 MIL POLYETHYLENE.

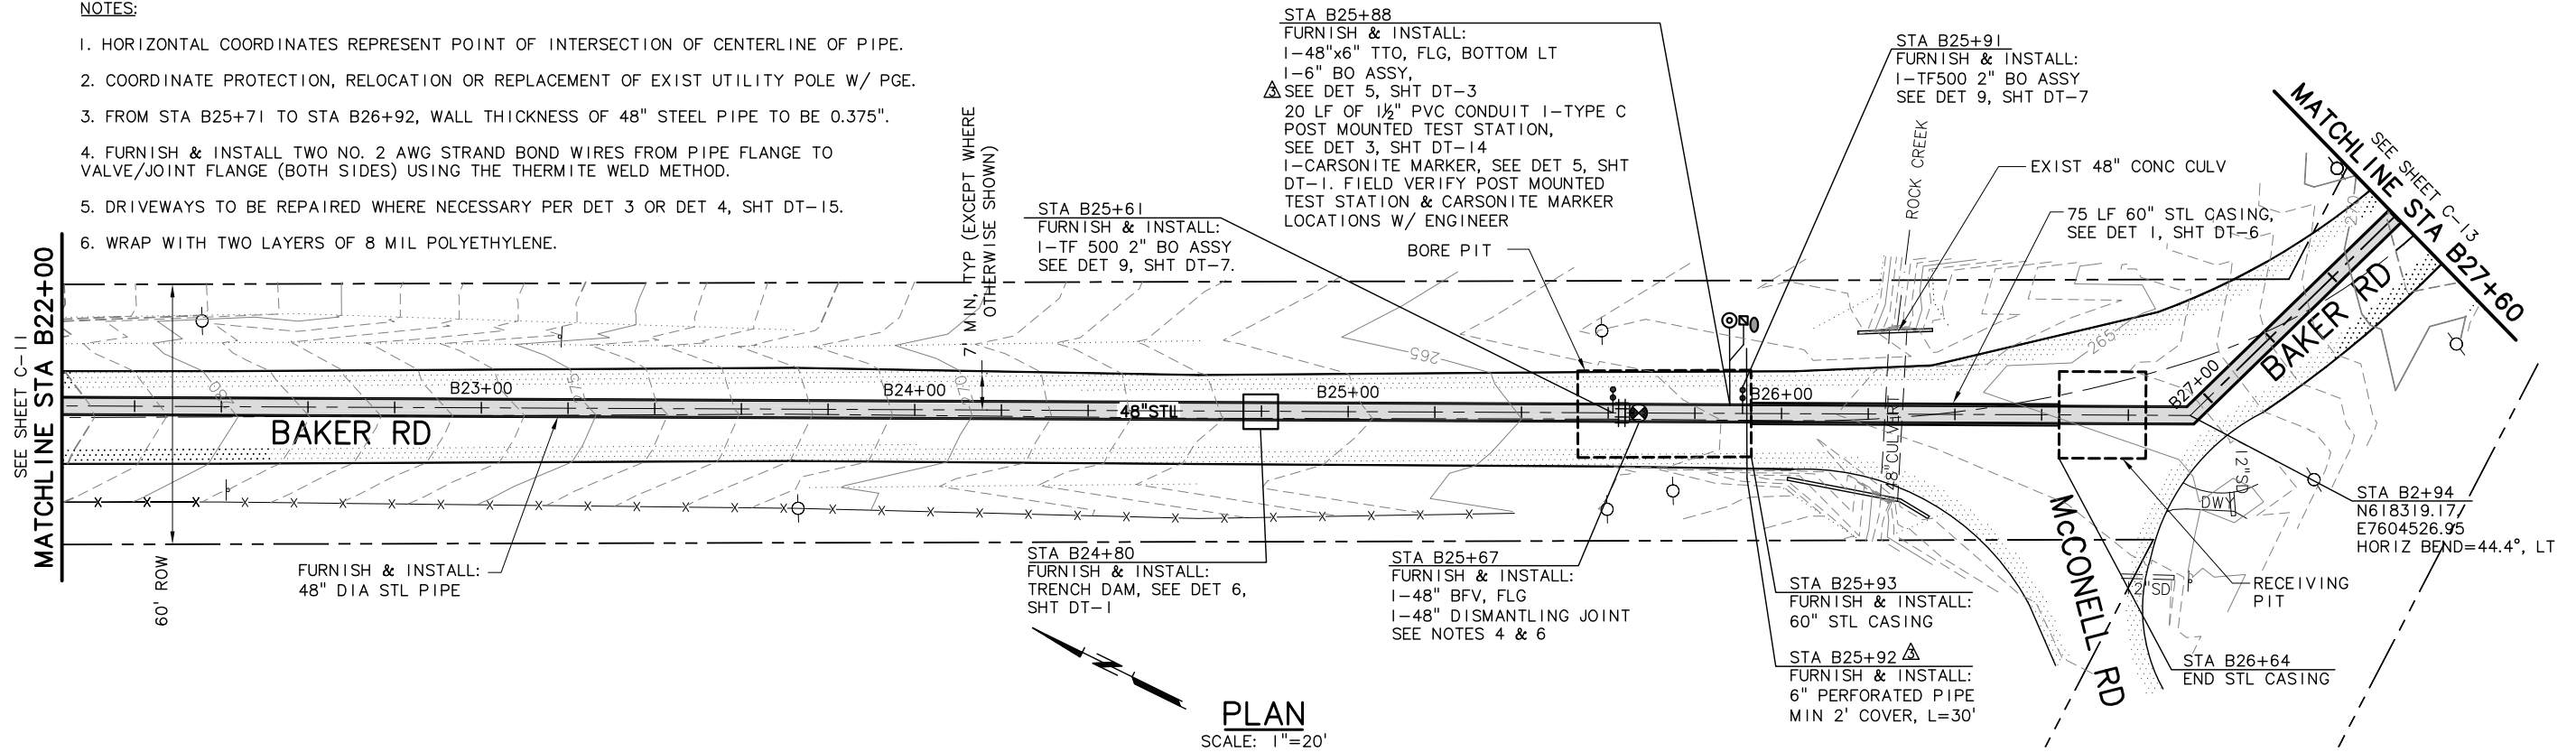

PLAN

SCALE: 1"=20'

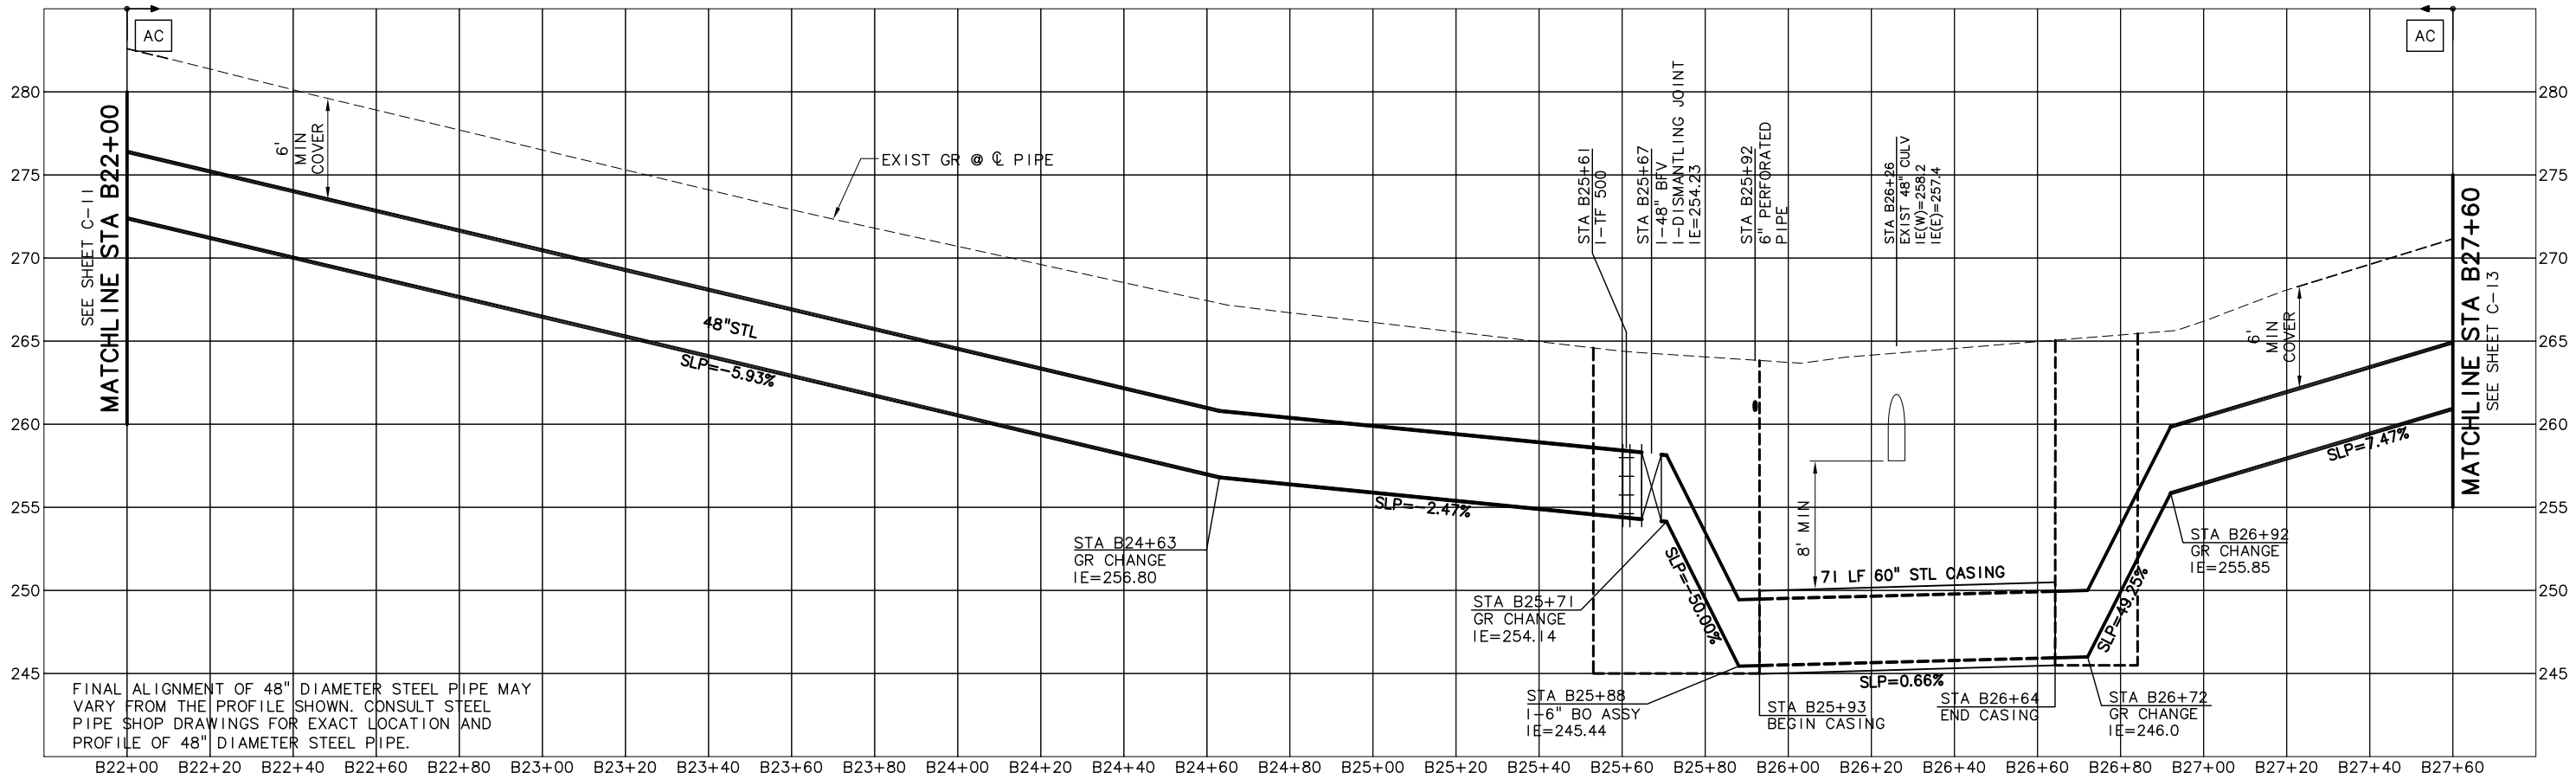

PROFILE

SCALE: 1"=20' HORIZ 1"=5' VERT

FINAL ALIGNMENT OF 48" DIAMETER STEEL PIPE MAY VARY FROM THE PROFILE SHOWN. CONSULT STEEL PIPE SHOP DRAWINGS FOR EXACT LOCATION AND PROFILE OF 48" DIAMETER STEEL PIPE.

C:\Users\dak\AppData\Local\Temp\AcPublish_1580\07-0873-207-OR-CIVIL B-R.dwg C-12 9/8/2011 10:22 AM DAK 18.1s (LMS Tech)

NO.	DATE	BY	REVISION
1	08/22/11	BVO	RECORD DRAWING

NOTICE

0 1/2 1

IF THIS BAR DOES NOT MEASURE 1" THEN DRAWING IS NOT TO SCALE

SMG DESIGNED
DAK DRAWN
MLH CHECKED

RECORD DRAWING

SEE DISCLAIMER, SHEET 1.

VERSION 4.1
12-9-97

MSA Murray Smith & Associates, Inc.
Engineers/Planners

121 S.W. Salmon, Suite 900 PHONE 503-225-9010
Portland, Oregon 97204 FAX 503-225-9022

City of Sherwood Oregon

WATER SUPPLY IMPROVEMENT PROJECT TRANSMISSION PIPELINE


WATERLINE SCHEDULE B PLAN AND PROFILE STA B22+00 TO STA B27+60

PROJECT NO.: 07-0873.207 SCALE: AS SHOWN DATE: JUNE 2009

SHEET **C-12**


35 of 79

C:\Users\dak\AppData\Local\Temp\AcPublish_1580\07-0873-207-OR-CIVIL B-R.dwg C-13 9/8/2011 10:22 AM DAK 18.1s (LMS Tech)

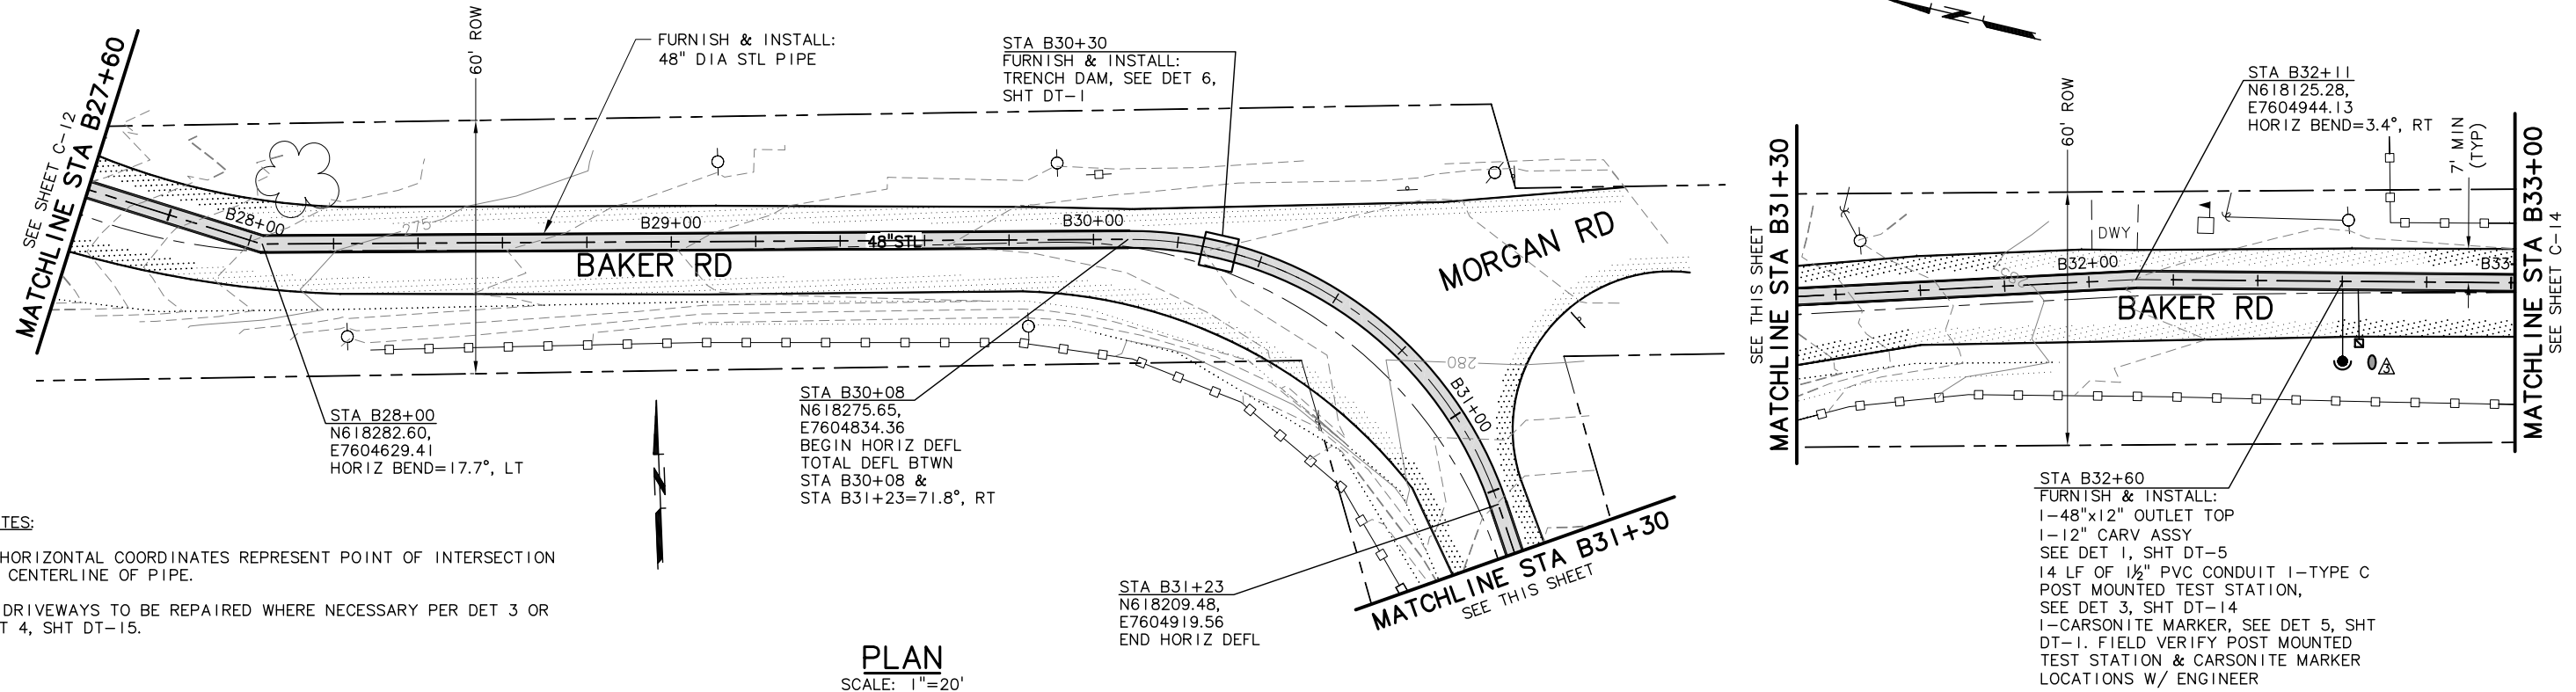

- NOTES:**
- HORIZONTAL COORDINATES REPRESENT POINT OF INTERSECTION OF CENTERLINE OF PIPE.
 - DRIVEWAYS TO BE REPAIRED WHERE NECESSARY PER DET 3 OR DET 4, SHT DT-15.

PLAN
SCALE: 1"=20'

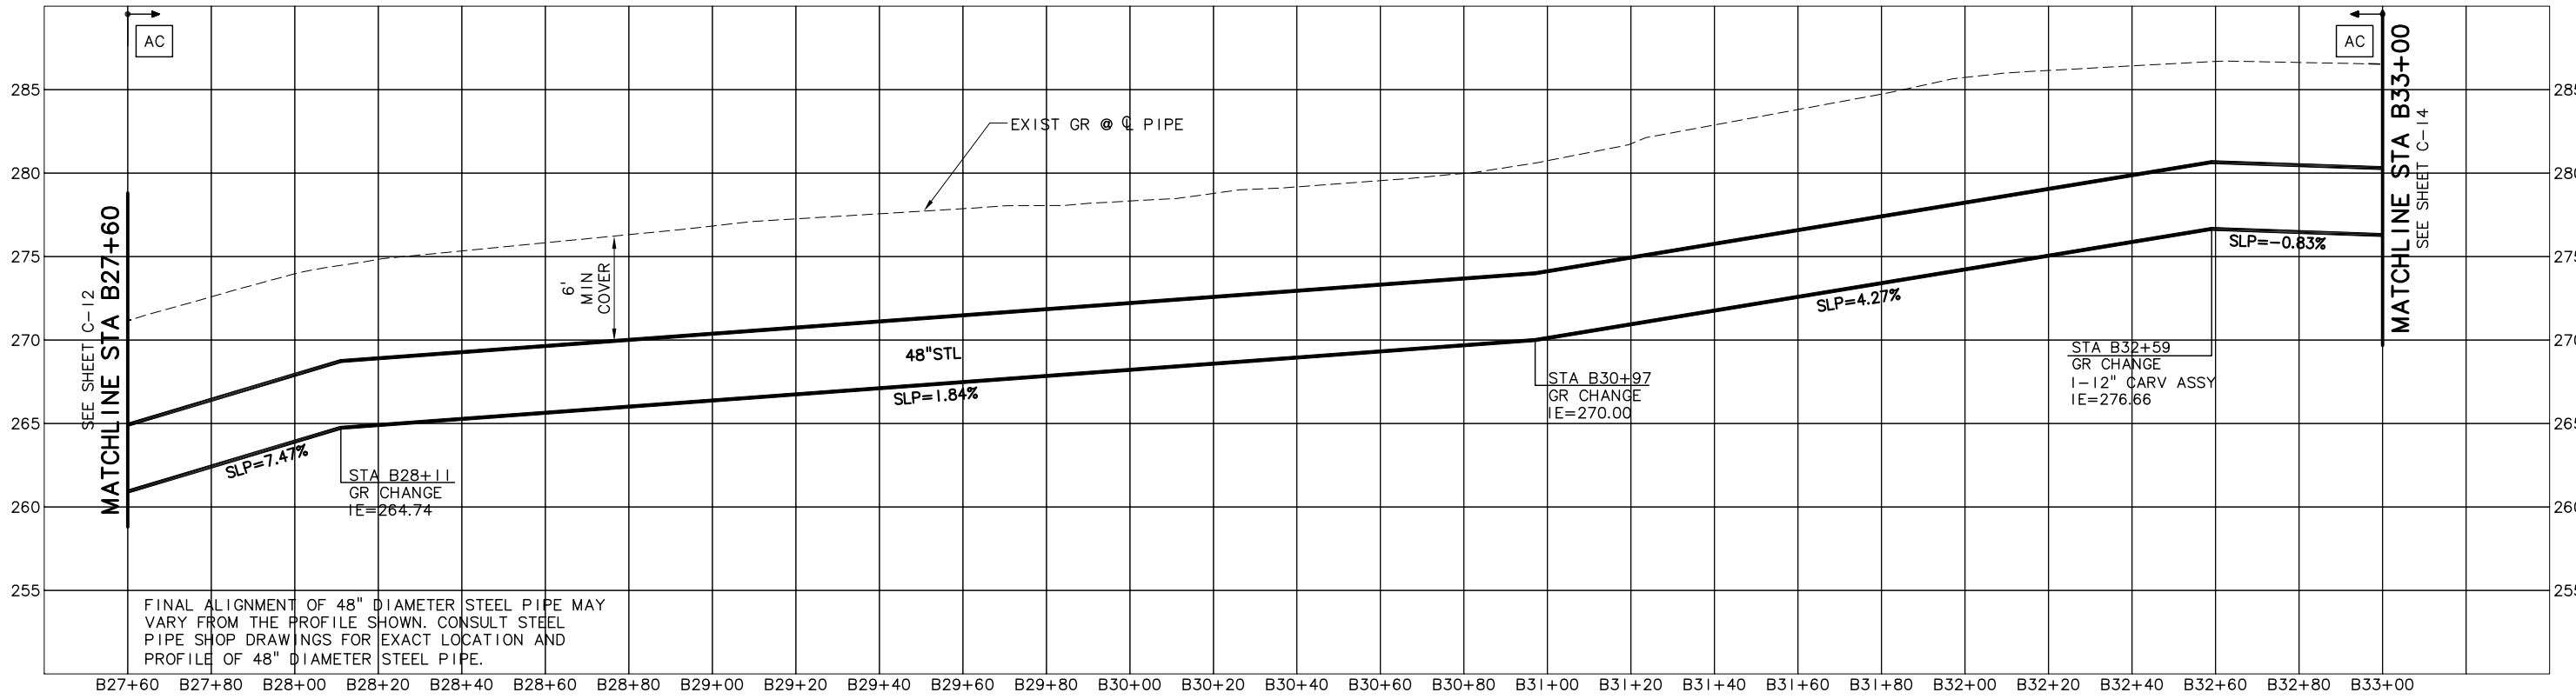

PROFILE
SCALE: 1"=20' HORIZ 1"=5' VERT

FINAL ALIGNMENT OF 48" DIAMETER STEEL PIPE MAY VARY FROM THE PROFILE SHOWN. CONSULT STEEL PIPE SHOP DRAWINGS FOR EXACT LOCATION AND PROFILE OF 48" DIAMETER STEEL PIPE.

NO.	DATE	BY	REVISION
1	08/22/11	BVO	RECORD DRAWING

NOTICE

0 1/2 1

IF THIS BAR DOES NOT MEASURE 1" THEN DRAWING IS NOT TO SCALE

SMG DESIGNED
DAK DRAWN
MLH CHECKED

RECORD DRAWING

SEE DISCLAIMER, SHEET 1.

VERSION 4.1
12-9-97

MSA Murray Smith & Associates, Inc.
Engineers/Planners

121 S.W. Salmon, Suite 900 PHONE 503-225-9010
Portland, Oregon 97204 FAX 503-225-9022



WATER SUPPLY IMPROVEMENT PROJECT TRANSMISSION PIPELINE


**WATERLINE SCHEDULE B
PLAN AND PROFILE
STA B27+60 TO STA B33+00**

PROJECT NO.: 07-0873.207 SCALE: AS SHOWN DATE: JUNE 2009


SHEET
C-13
36 of 79

NOTE:

1. DRIVEWAYS TO BE REPAIRED WHERE NECESSARY PER DET 3 OR DET 4, SHT DT-15.

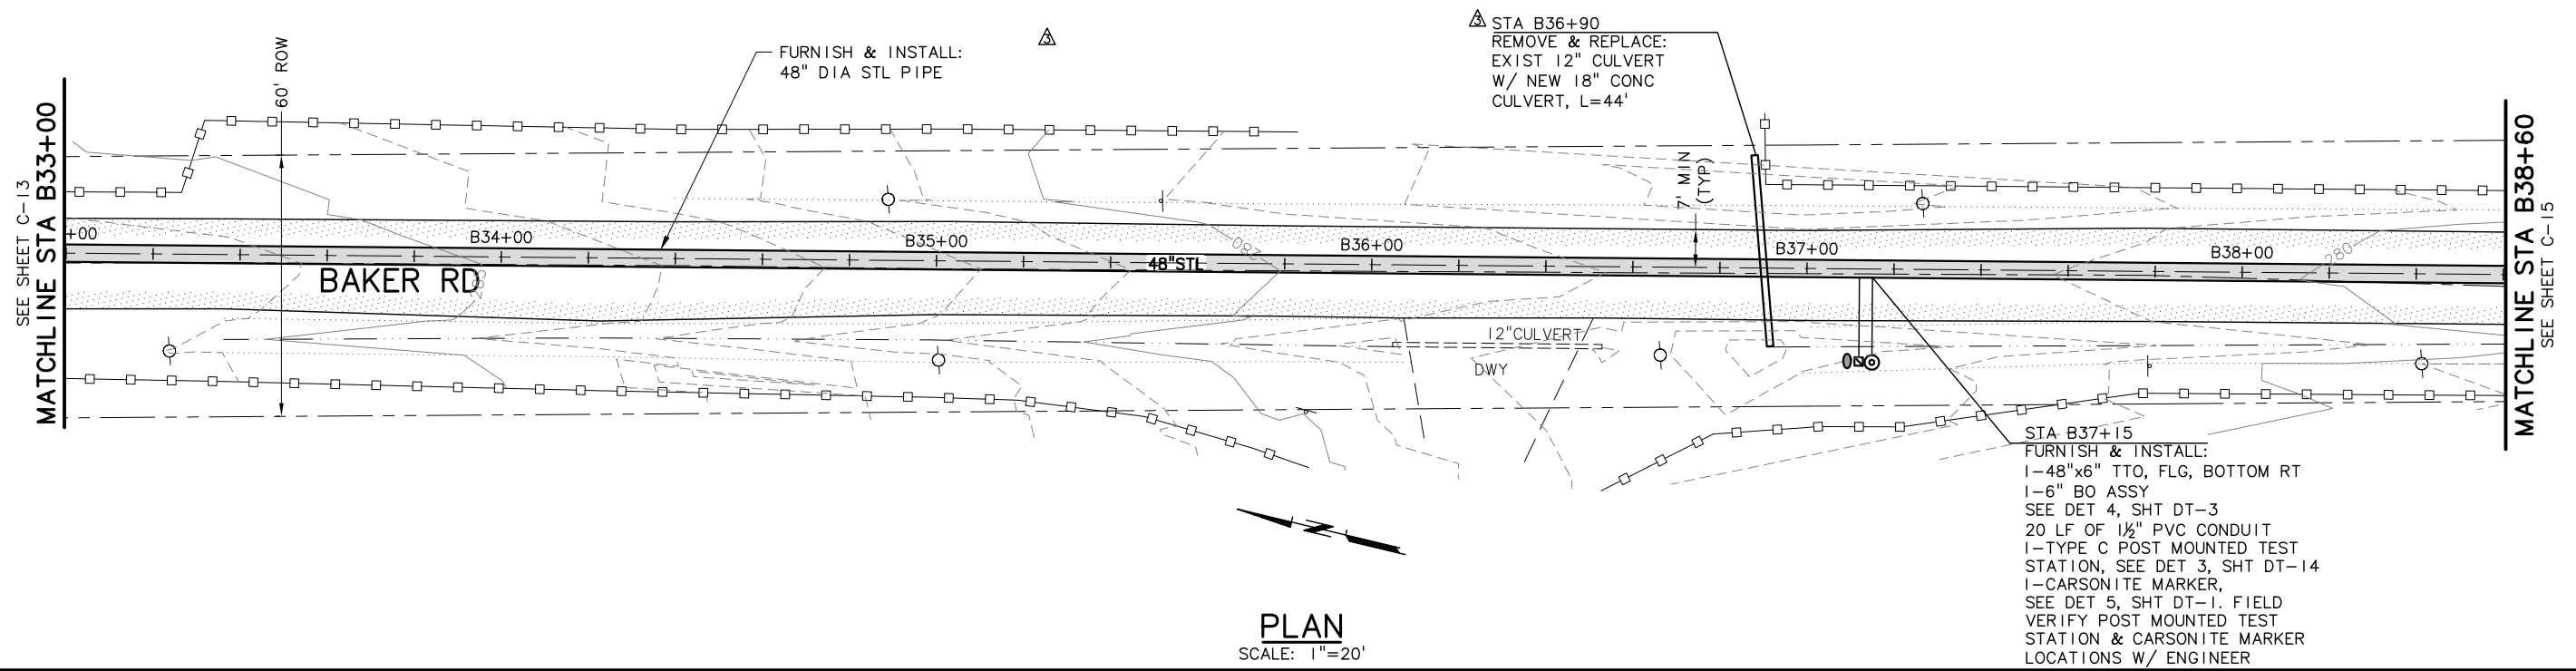

PLAN
SCALE: 1"=20'

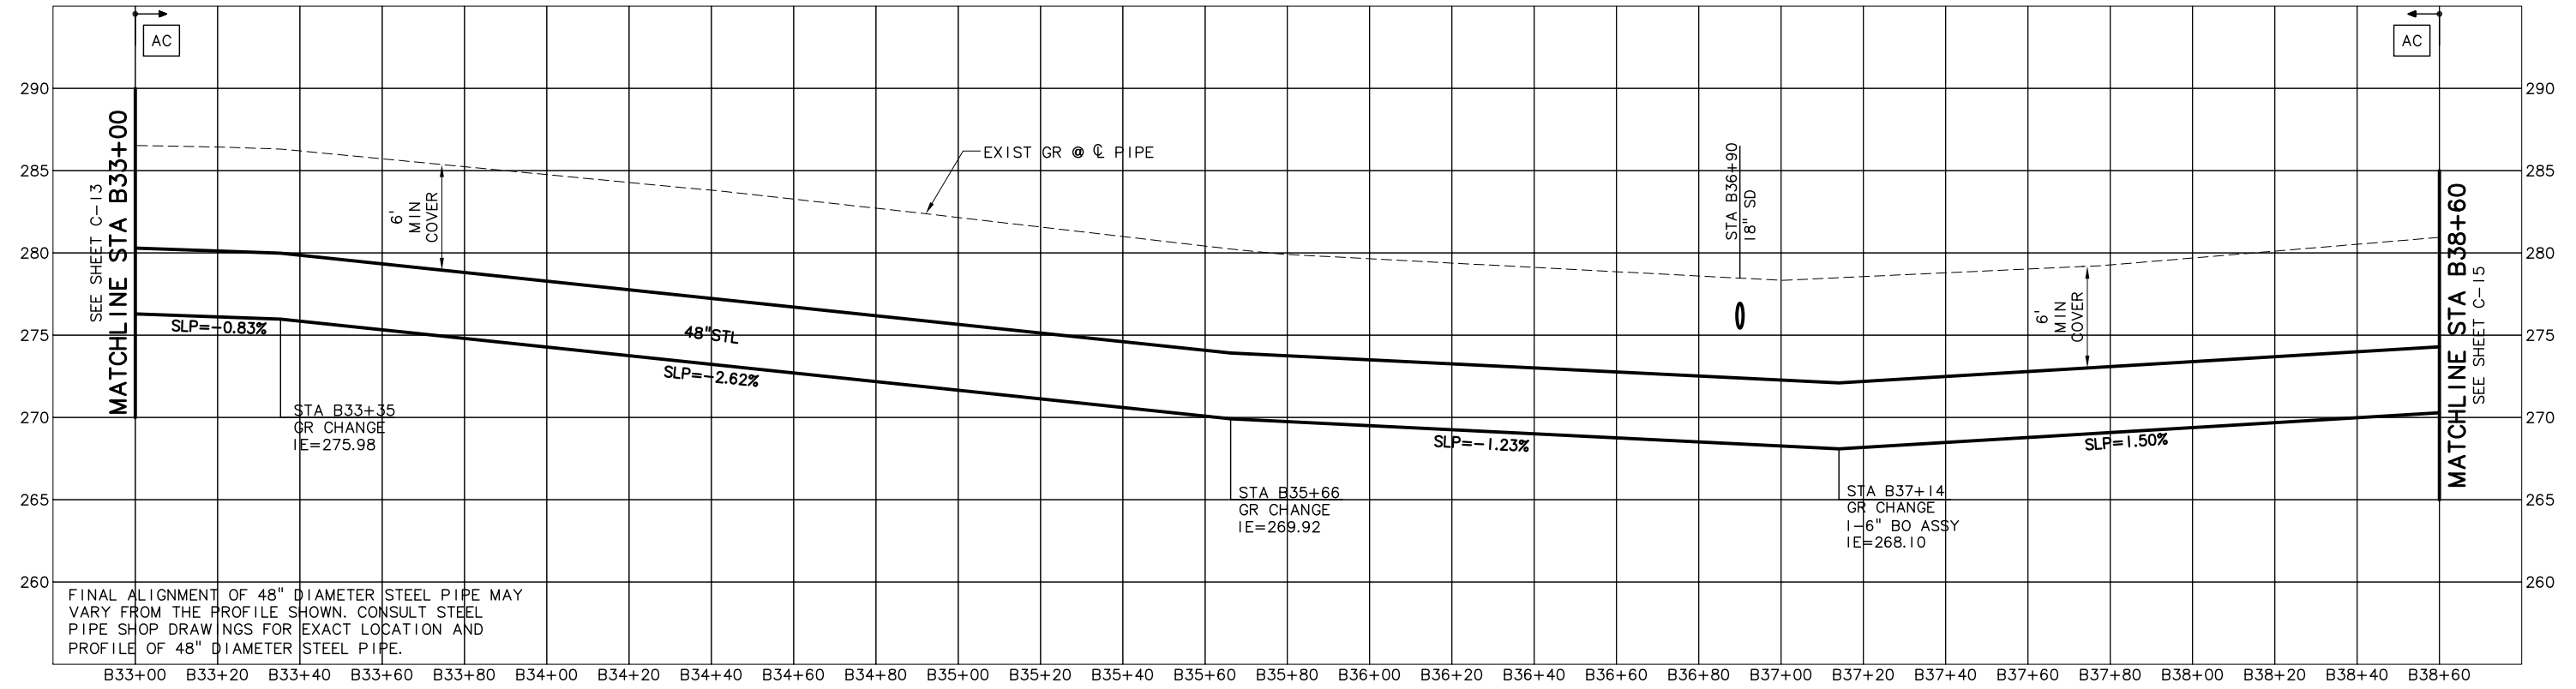

PROFILE
SCALE: 1"=20' HORIZ 1"=5' VERT

C:\Users\dak\AppData\Local\temp\AcPublish_1580\07-0873-207-OR-CIVIL B-R.dwg C-14 9/8/2011 10:22 AM DAK 18.1s (LMS Tech)

NO.	DATE	BY	REVISION
1	08/22/11	BVO	RECORD DRAWING

NOTICE

0 1/2 1

IF THIS BAR DOES NOT MEASURE 1" THEN DRAWING IS NOT TO SCALE

SMG DESIGNED
DAK DRAWN
MLH CHECKED

RECORD DRAWING

SEE DISCLAIMER, SHEET 1.

VERSION 4.1
12-9-97

MSA Murray Smith & Associates, Inc.
Engineers/Planners

121 S.W. Salmon, Suite 900 PHONE 503-225-9010
Portland, Oregon 97204 FAX 503-225-9022

City of Sherwood Oregon

WATER SUPPLY IMPROVEMENT PROJECT TRANSMISSION PIPELINE

WATERLINE SCHEDULE B PLAN AND PROFILE

STA B33+00 TO STA B38+60

PROJECT NO.: 07-0873.207 SCALE: AS SHOWN DATE: JUNE 2009

SHEET

C-14

37 of 79

NOTES:

1. DRIVEWAYS TO BE REPAIRED WHERE NECESSARY PER DET 3 OR DET 4, SHT DT-15.
2. HORIZONTAL COORDINATES REPRESENT POINT OF INTERSECTION OF CENTERLINE OF PIPE.

STA B43+43
 FURNISH & INSTALL:
 1-48"x10" OUTLET, TOP
 1-10" CARV ASSY
 SEE DET 1, SHT DT-5
 10 LF OF 1/2" PVC CONDUIT
 1-TYPE C POST MOUNTED TEST STATION, SEE DET 3, SHT DT-14
 1-CARSONITE MARKER, SEE DET 5, SHT DT-1. FIELD VERIFY POST MOUNTED TEST STATION & CARSONITE MARKER LOCATIONS W/ ENGINEER

STA B43+61
 N617021.72,
 E7605239.94
 END HORIZ DEFL

STA B42+40
 N617123.56,
 E7605178.85
 BEGIN HORIZ DEFL
 TOTAL DEFL BTWN
 STA B42+40 AND
 STA B43+61=33.7°, LT


STA B38+90
 N617464.13,
 E7605095.59
 HORIZ BEND=0.8°, LT

FURNISH & INSTALL:
 48" DIA STL PIPE


STA B43+60
 FURNISH & INSTALL:
 1-MANWAY VAULT ASSY
 SEE DET 1, SHT DT-2

SEE SHEET C-14
 MATCHLINE STA B38+60

MATCHLINE STA B44+00
 SEE SHEET C-16

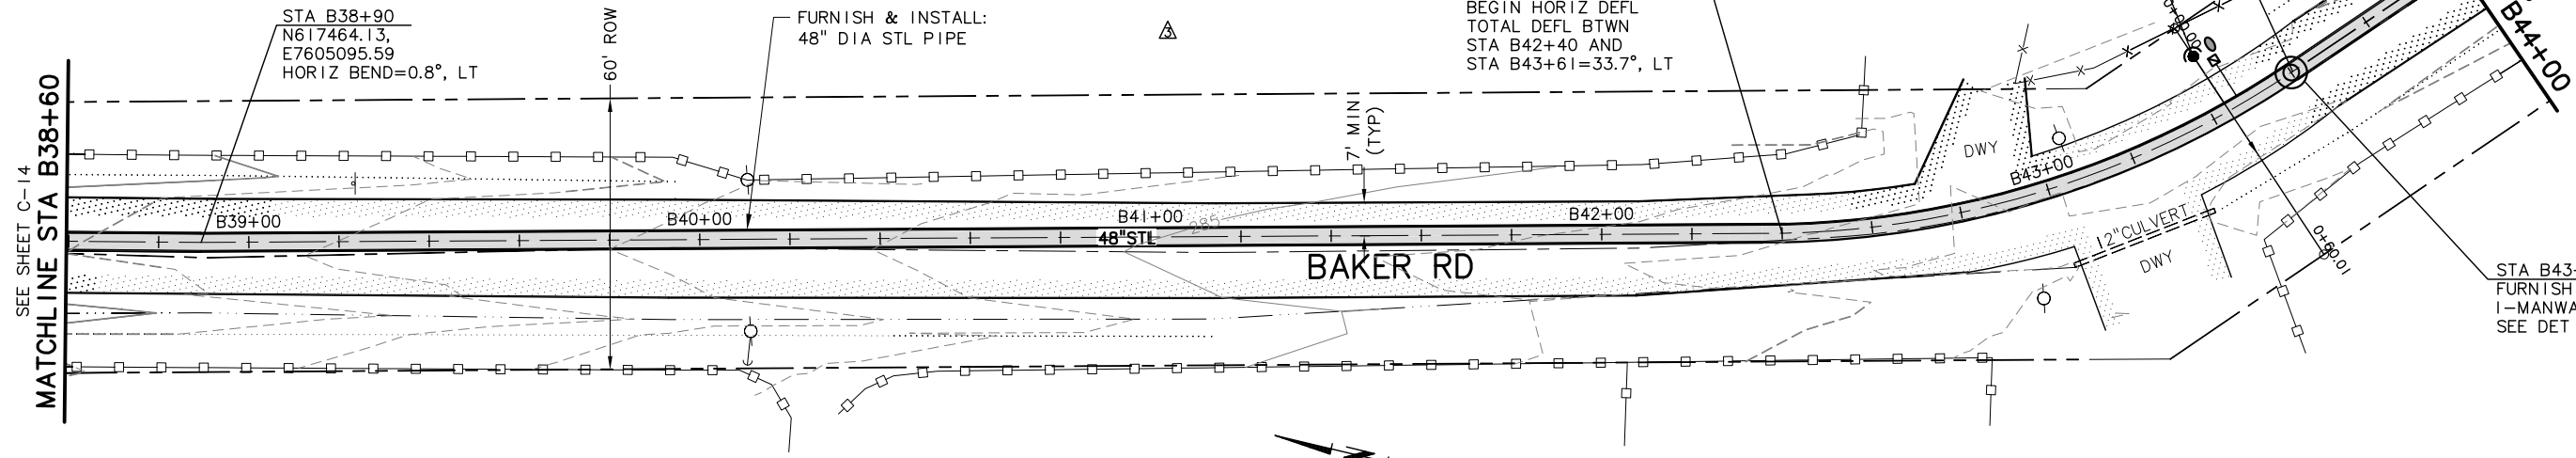

PLAN
 SCALE: 1"=20'

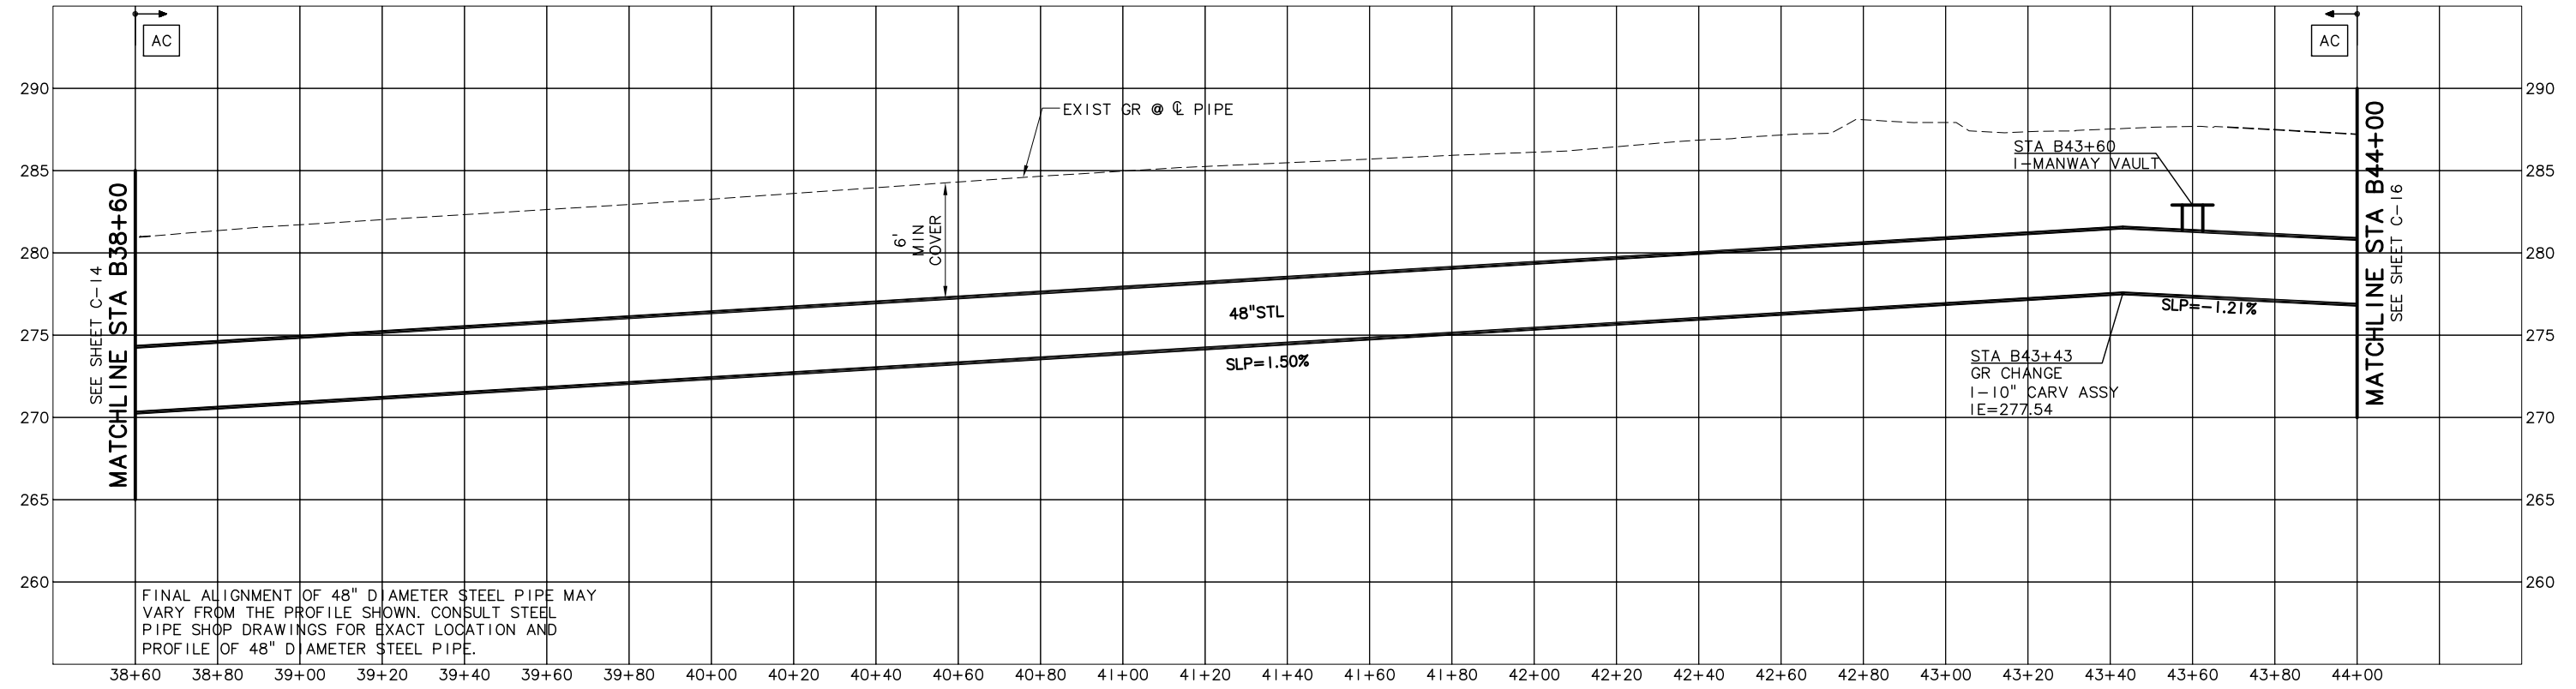

PROFILE
 SCALE: 1"=20' HORIZ 1"=5' VERT

FINAL ALIGNMENT OF 48" DIAMETER STEEL PIPE MAY VARY FROM THE PROFILE SHOWN. CONSULT STEEL PIPE SHOP DRAWINGS FOR EXACT LOCATION AND PROFILE OF 48" DIAMETER STEEL PIPE.

C:\Users\dak\AppData\Local\temp\AcPublish_1580\07-0873-207-OR-CIVIL B-R.dwg C-15 9/8/2011 10:22 AM DAK 18.1s (LMS Tech)

NO.	DATE	BY	REVISION
1	08/22/11	BVO	RECORD DRAWING

NOTICE

0 1/2 1

IF THIS BAR DOES NOT MEASURE 1" THEN DRAWING IS NOT TO SCALE

SMG DESIGNED
 DAK DRAWN
 MLH CHECKED

RECORD DRAWING
 SEE DISCLAIMER, SHEET 1.
 VERSION 4.1
 12-9-97

MSA Murray Smith & Associates, Inc.
 Engineers/Planners
 121 S.W. Salmon, Suite 900 PHONE 503-225-9010
 Portland, Oregon 97204 FAX 503-225-9022



WATER SUPPLY IMPROVEMENT PROJECT TRANSMISSION PIPELINE

WATERLINE SCHEDULE B PLAN AND PROFILE STA B38+60 TO STA B44+00


PROJECT NO.: 07-0873.207 SCALE: AS SHOWN DATE: JUNE 2009

SHEET
C-15
 38 of 79


C:\Users\dak\AppData\Local\Temp\AcPublish_1580\07-0873-207-OR-CIVIL B-R.dwg C-16 9/8/2011 10:22 AM DAK 18.1s (LMS Tech)

NOTES:

1. DRIVEWAYS TO BE REPAIRED WHERE NECESSARY PER DET 3 OR DET 4, SHT DT-15.
2. HORIZONTAL COORDINATES REPRESENT POINT OF INTERSECTION OF CENTERLINE OF PIPE.

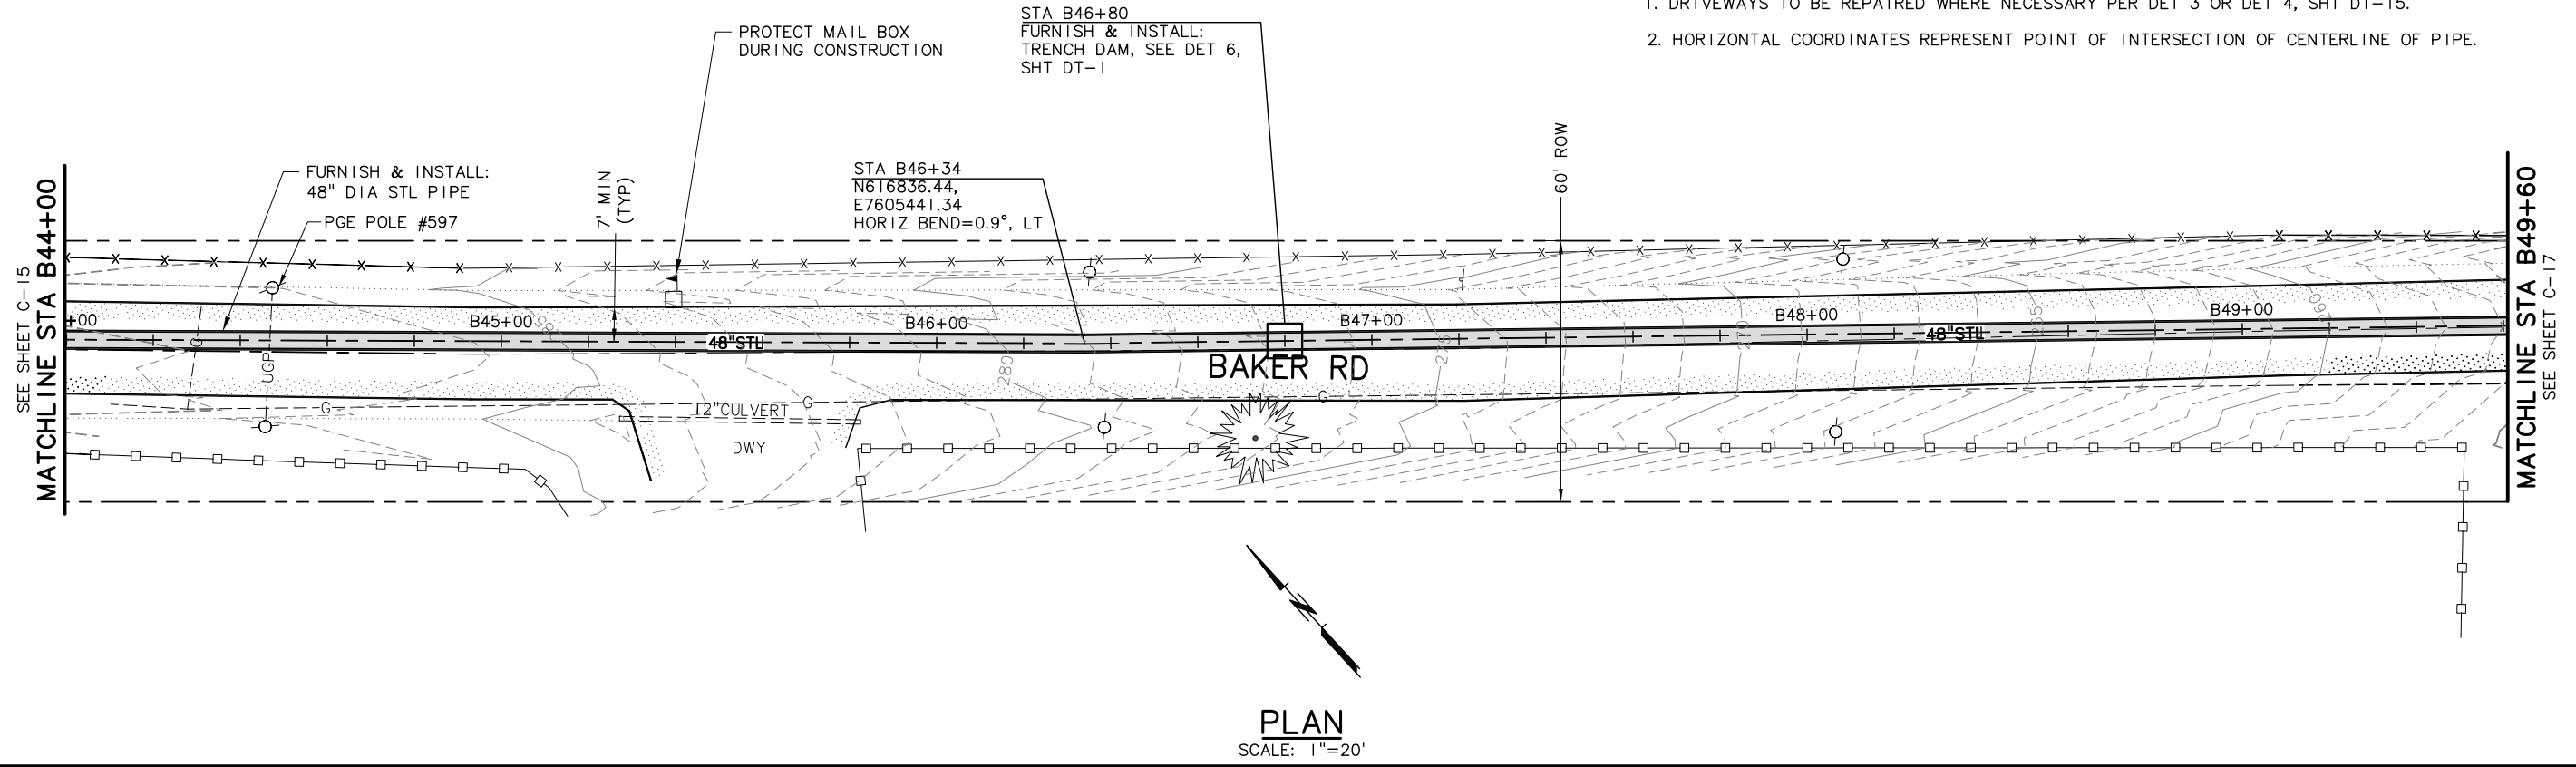

PLAN
SCALE: 1"=20'

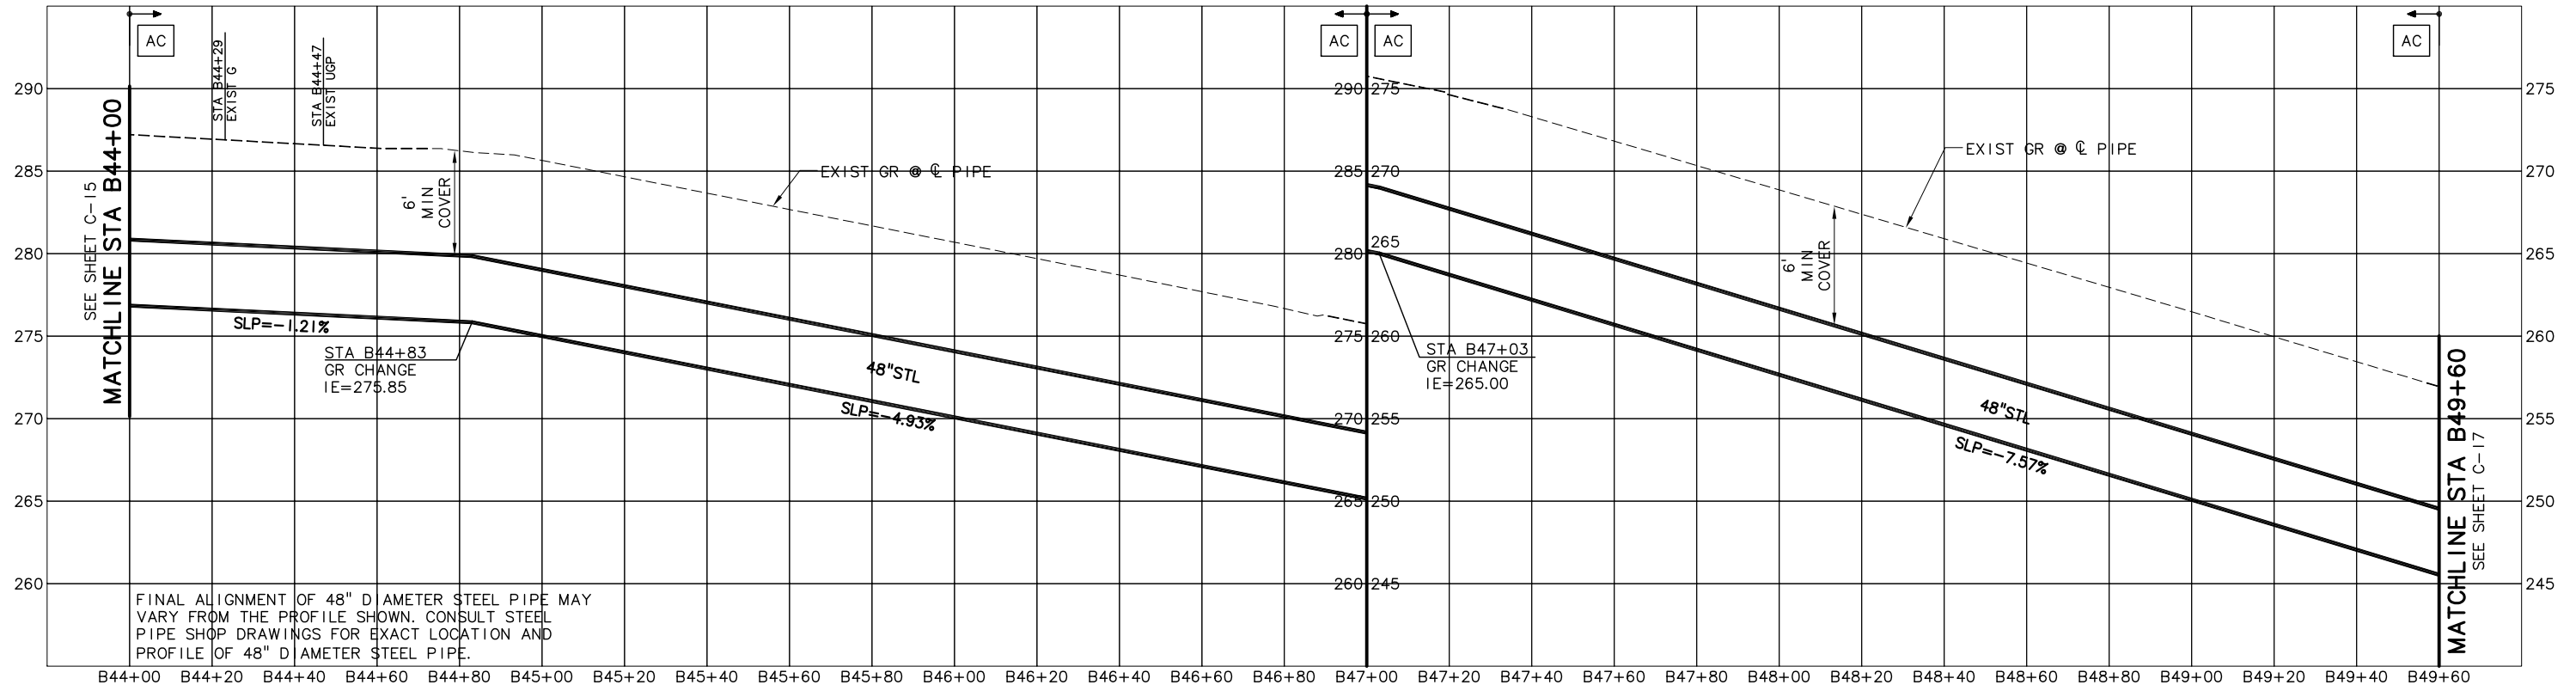

PROFILE
SCALE: 1"=20' HORIZ 1"=5' VERT

FINAL ALIGNMENT OF 48" DIAMETER STEEL PIPE MAY VARY FROM THE PROFILE SHOWN. CONSULT STEEL PIPE SHOP DRAWINGS FOR EXACT LOCATION AND PROFILE OF 48" DIAMETER STEEL PIPE.

NO.	DATE	BY	REVISION
3	08/22/11	BVO	RECORD DRAWING

NOTICE

0 1/2 1

IF THIS BAR DOES NOT MEASURE 1" THEN DRAWING IS NOT TO SCALE

SMG DESIGNED
DAK DRAWN
MLH CHECKED

RECORD DRAWING

SEE DISCLAIMER, SHEET 1.

VERSION 4.1
12-9-97

MSA Murray Smith & Associates, Inc.
Engineers/Planners

121 S.W. Salmon, Suite 900 PHONE 503-225-9010
Portland, Oregon 97204 FAX 503-225-9022



WATER SUPPLY IMPROVEMENT PROJECT TRANSMISSION PIPELINE

**WATERLINE SCHEDULE B
PLAN AND PROFILE
STA B44+00 TO STA B49+60**

PROJECT NO.: 07-0873.207 SCALE: AS SHOWN DATE: JUNE 2009

SHEET
C-16
39 of 79

C:\Users\dak\AppData\Local\Temp\AcPublish_1580\07-0873-207-OR-CIVIL B-R.dwg C-17 9/8/2011 10:22 AM DAK 18.1s (LMS Tech)


STA B50+74
FURNISH & INSTALL:
1-48"x6" TFO, FLG, BOTTOM LT
1-6" BO ASSY
SEE DET 5, SHT DT-3
13 LF OF 1/2" PVC CONDUIT
1-TYPE C POST MOUNTED TEST STATION
SEE DET 3, SHT DT-14
1-CARSONITE MARKER
SEE DET 5, SHT DT-1
FIELD VERIFY POST MOUNTED TEST
STATION & CARSONITE MARKER
LOCATIONS W/ ENGINEER

STA B50+79
FURNISH & INSTALL:
6" PERFORATED PIPE, L=32'
MIN 2.5' COVER


STA B52+40
FURNISH & INSTALL:
TRENCH DAM, SEE DET 6,
SHT DT-1

NOTES:

1. DRIVEWAYS TO BE REPAIRED WHERE NECESSARY PER DET 3 OR DET 4, SHT DT-15.
2. HORIZONTAL COORDINATES REPRESENT POINT OF INTERSECTION OF CENTERLINE OF PIPE.
3. FURNISH & INSTALL TWO NO. 2 AWG STRAND BOND WIRES FROM THE PIPE FLANGE TO THE VALVE/JOINT FLANGE (BOTH SIDES), USING THE THERMITE WELD METHOD.
4. WRAP WITH TWO LAYERS OF 8 MIL POLYETHYLENE.

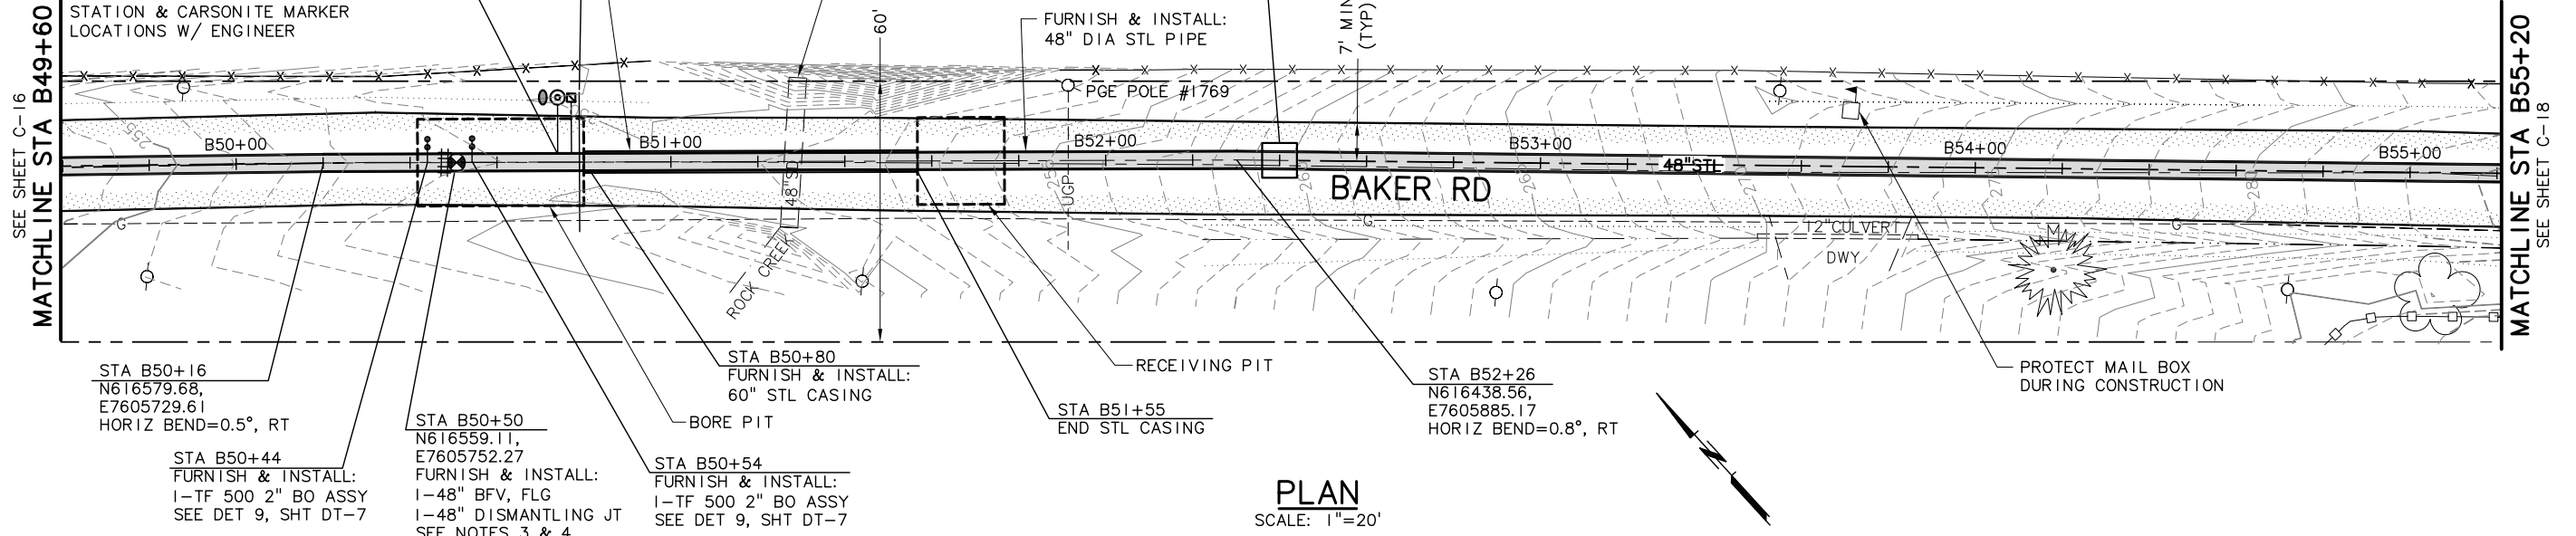

PLAN
SCALE: 1"=20'

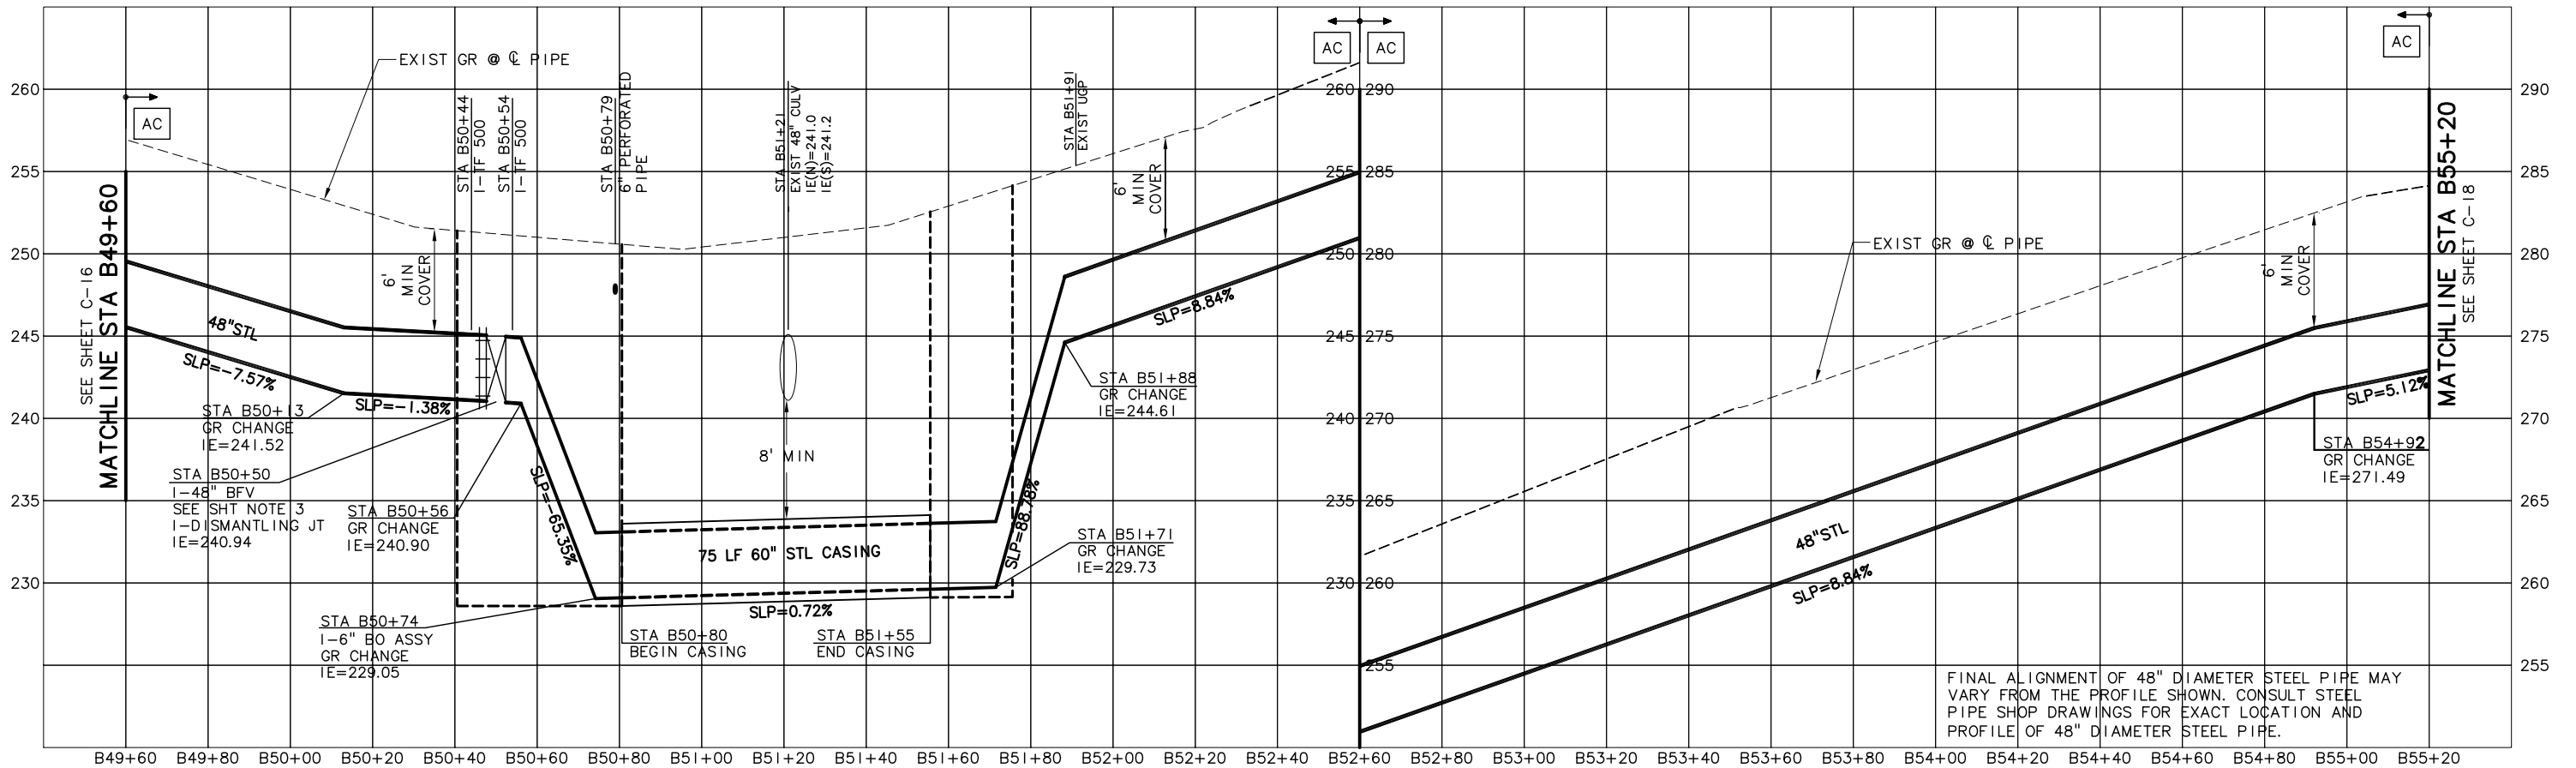

PROFILE
SCALE: 1"=20' HORIZ 1"=5' VERT

FINAL ALIGNMENT OF 48" DIAMETER STEEL PIPE MAY VARY FROM THE PROFILE SHOWN. CONSULT STEEL PIPE SHOP DRAWINGS FOR EXACT LOCATION AND PROFILE OF 48" DIAMETER STEEL PIPE.

NO.	DATE	BY	REVISION
1	08/22/11	BVO	RECORD DRAWING

NOTICE
0 1/2 1
IF THIS BAR DOES NOT MEASURE 1" THEN DRAWING IS NOT TO SCALE

SMG DESIGNED
DAK DRAWN
MLH CHECKED

RECORD DRAWING
SEE DISCLAIMER, SHEET 1.
VERSION 4.1
12-9-97

MSA Murray Smith & Associates, Inc.
Engineers/Planners
121 S.W. Salmon, Suite 900 PHONE 503-225-9010
Portland, Oregon 97204 FAX 503-225-9022


City of Sherwood Oregon

WATER SUPPLY IMPROVEMENT PROJECT TRANSMISSION PIPELINE

WATERLINE SCHEDULE B PLAN AND PROFILE STA B49+60 TO STA B55+20


PROJECT NO.: 07-0873.207 SCALE: AS SHOWN DATE: JUNE 2009

C:\Users\dak\AppData\Local\temp\AcPublish_1580\07-0873-207-OR-CIVIL B-R.dwg C-18 9/8/2011 10:22 AM DAK 18.1s (LMS Tech)

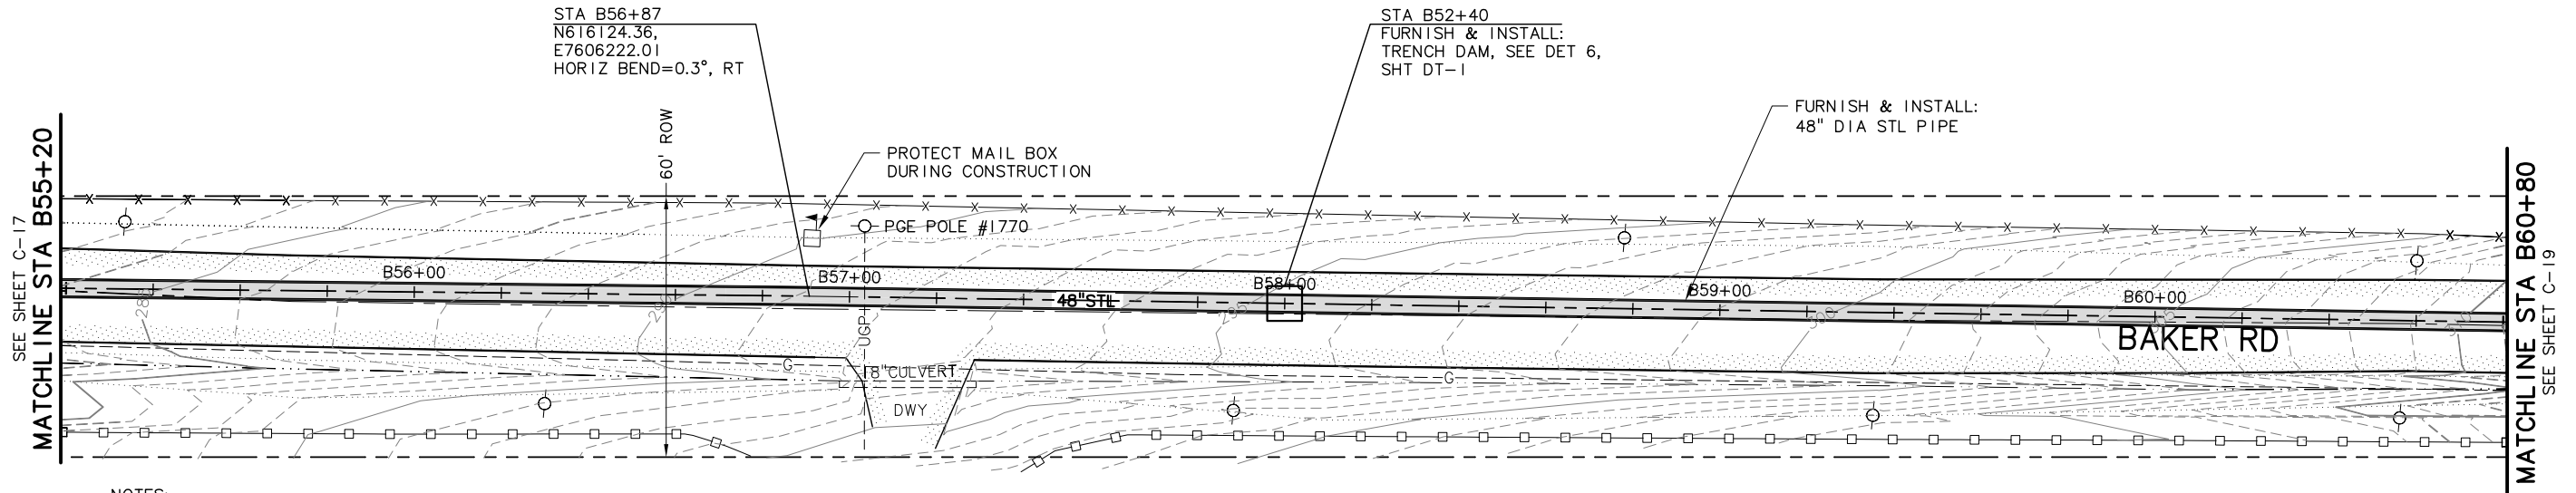

- NOTES:**
1. DRIVEWAYS TO BE REPAIRED WHERE NECESSARY PER DET 3 OR DET 4, SHT DT-15.
 2. HORIZONTAL COORDINATES REPRESENT POINT OF INTERSECTION OF CENTERLINE OF PIPE.

PLAN
SCALE: 1"=20'

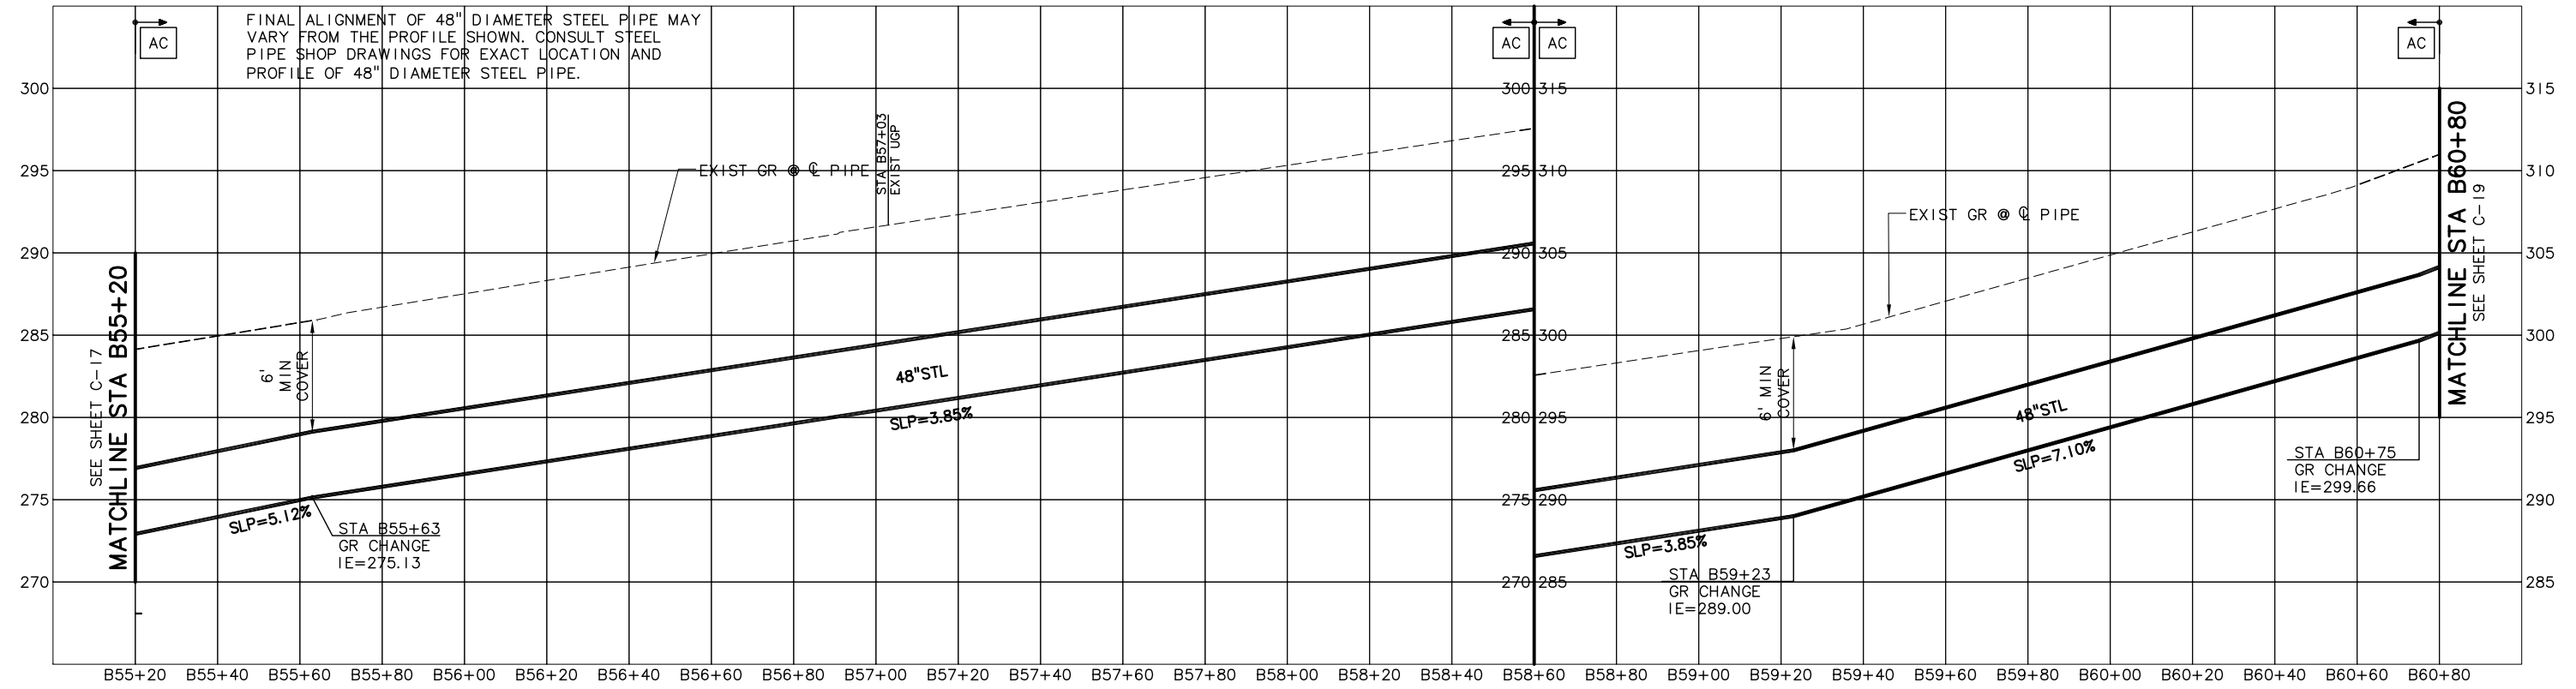

PROFILE
SCALE: 1"=20' HORIZ 1"=5' VERT

NO.	DATE	BY	REVISION
3	08/22/11	BVO	RECORD DRAWING

NOTICE

0 1/2 1

IF THIS BAR DOES NOT MEASURE 1" THEN DRAWING IS NOT TO SCALE

SMG DESIGNED
DAK DRAWN
MLH CHECKED

RECORD DRAWING

SEE DISCLAIMER, SHEET 1.

VERSION 4.1
12-9-97

MSA Murray Smith & Associates, Inc.
Engineers/Planners

121 S.W. Salmon, Suite 900 PHONE 503-225-9010
Portland, Oregon 97204 FAX 503-225-9022



WATER SUPPLY IMPROVEMENT PROJECT TRANSMISSION PIPELINE

WATERLINE SCHEDULE B PLAN AND PROFILE

STA B55+20 TO STA B60+80


PROJECT NO.: 07-0873.207 SCALE: AS SHOWN DATE: JUNE 2009

SHEET

C-18


41 of 79

C:\Users\dak\AppData\Local\Temp\AcPublish_1580\07-0873-207-OR-CIVIL B-R.dwg C-19 9/8/2011 10:22 AM DAK 18.1s (LMS Tech)

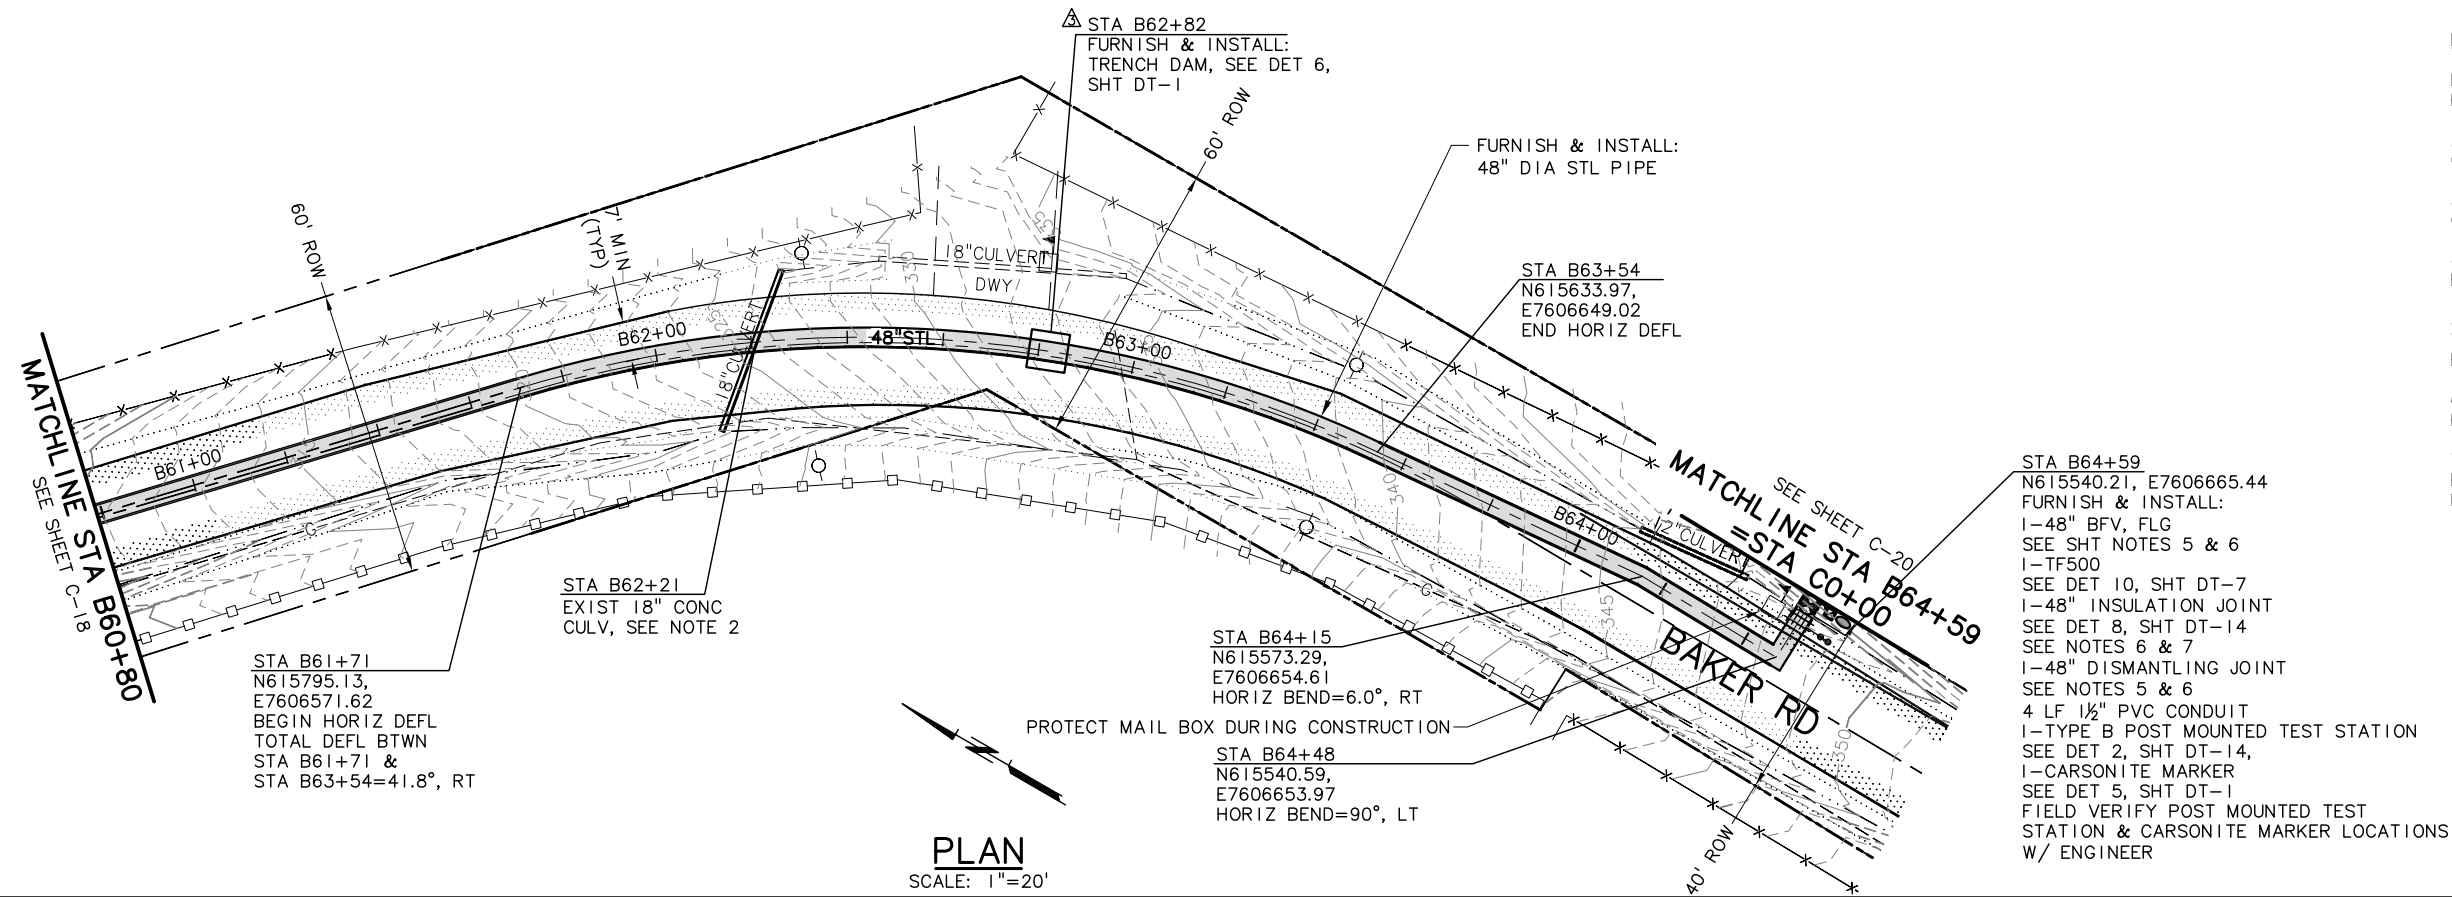

- NOTES:**
- DRIVEWAYS TO BE REPAIRED WHERE NECESSARY PER DET 3 OR DET 4, SHT DT-15.
 - REMOVE AND REPLACE EXISTING 18" DIAMETER CONCRETE CULVERT. MATCH EXISTING SLOPE.
 - HORIZONTAL COORDINATES REPRESENT POINT OF INTERSECTION OF CENTERLINE OF PIPE.
 - BACKING OF TRUCKS OR EQUIPMENT ONTO ROADWAY IS PROHIBITED.
 - FURNISH & INSTALL TWO NO. 2 AWG STRAND WIRES FROM PIPE FLANGE TO VALVE/Joint FLANGE, USING THE THERMITE WELD METHOD.
 - WRAP WITH TWO LAYERS OF 8 MIL POLYETHYLENE.
 - TAPE INSULATION JOINT WITH 40 MIL POLYKEN TAPE OR EQUAL. OVERLAP PER MANUFACTURER'S RECOMMENDATIONS.

PLAN
SCALE: 1"=20'

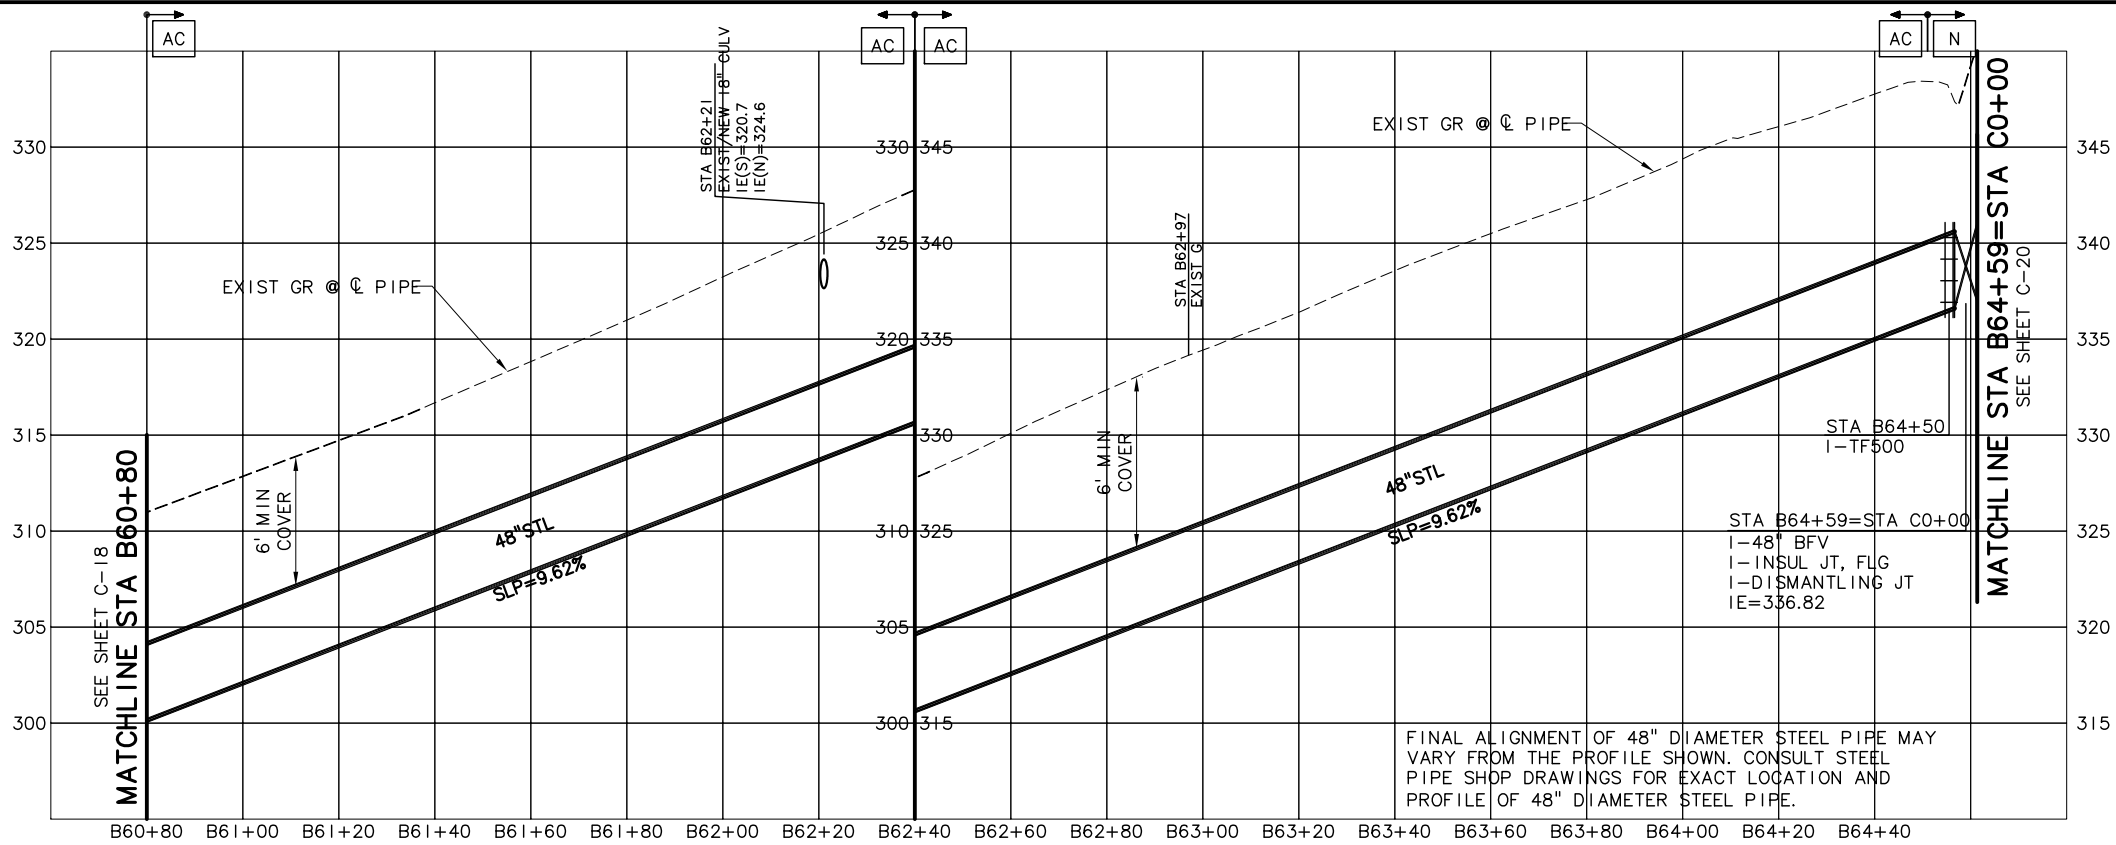

PROFILE
SCALE: 1"=20' HORIZ 1"=5' VERT

NO.	DATE	BY	REVISION
1	08/22/11	BVO	RECORD DRAWING

NOTICE

0 1/2 1

IF THIS BAR DOES NOT MEASURE 1" THEN DRAWING IS NOT TO SCALE

SMG DESIGNED
DAK DRAWN
MLH CHECKED

RECORD DRAWING

SEE DISCLAIMER, SHEET 1.

VERSION 4.1
12-9-97

MSA Murray Smith & Associates, Inc.
Engineers/Planners

121 S.W. Salmon, Suite 900 PHONE 503-225-9010
Portland, Oregon 97204 FAX 503-225-9022

City of Sherwood Oregon

WATER SUPPLY IMPROVEMENT PROJECT TRANSMISSION PIPELINE

**WATERLINE SCHEDULE B
PLAN AND PROFILE
STA B60+80 TO STA B64+59**



PROJECT NO.: 07-0873.207 SCALE: AS SHOWN DATE: JUNE 2009

SHEET
C-19
42 of 79

C:\Users\dak\AppData\Local\Temp\AcPublish_1580\07-0873-207-OR-CIVIL C-R.dwg C-20 9/6/2011 11:27 AM DAK 18.1s (LMS Tech)

NOTES:

1. CONTRACTOR TO STOCKPILE AND REUSE TOPSOIL STA C0+00 TO STA C5+60, SEE TRENCH DET 3, SHT DT-1.
2. SEE SECTION 01100, SPECIAL PROVISIONS, FOR OTHER REQUIREMENTS PERTAINING TO WORK WITHIN PRIVATE PROPERTY.
3. NOT USED.
4. SURFACE TO BE RESTORED TO EXISTING CONDITIONS AND GRADE. PROVIDE 12 INCHES MINIMUM TOPSOIL. SEE SPECIFICATIONS.
5. INSTALL TWO NO. 2 AWG STRAND BOND WIRES FROM PIPE FLANGE TO VALVE FLANGE USING THE THERMITE WELD METHOD.
6. REMOVE EXIST 48" INCH TEST HEAD CONNECT TO EXIST BFV (STA 0+00). STORE AND REINSTALL AT STA C47+17.

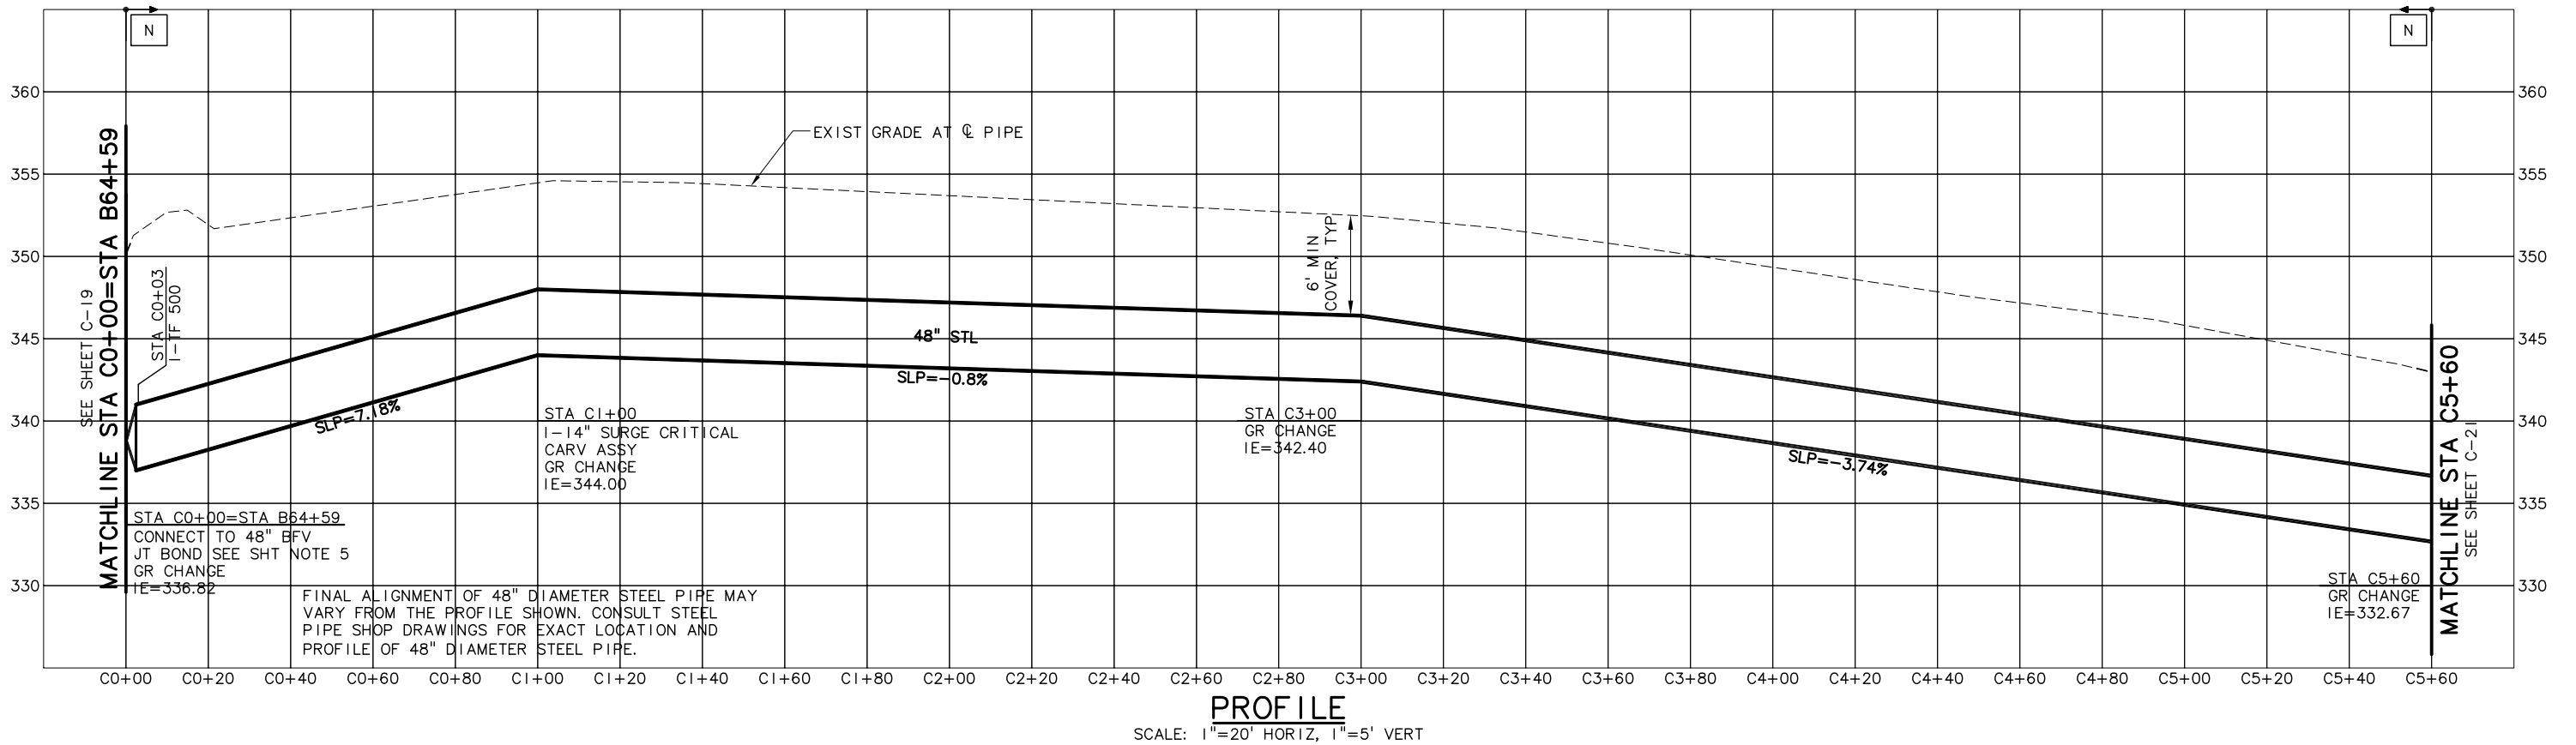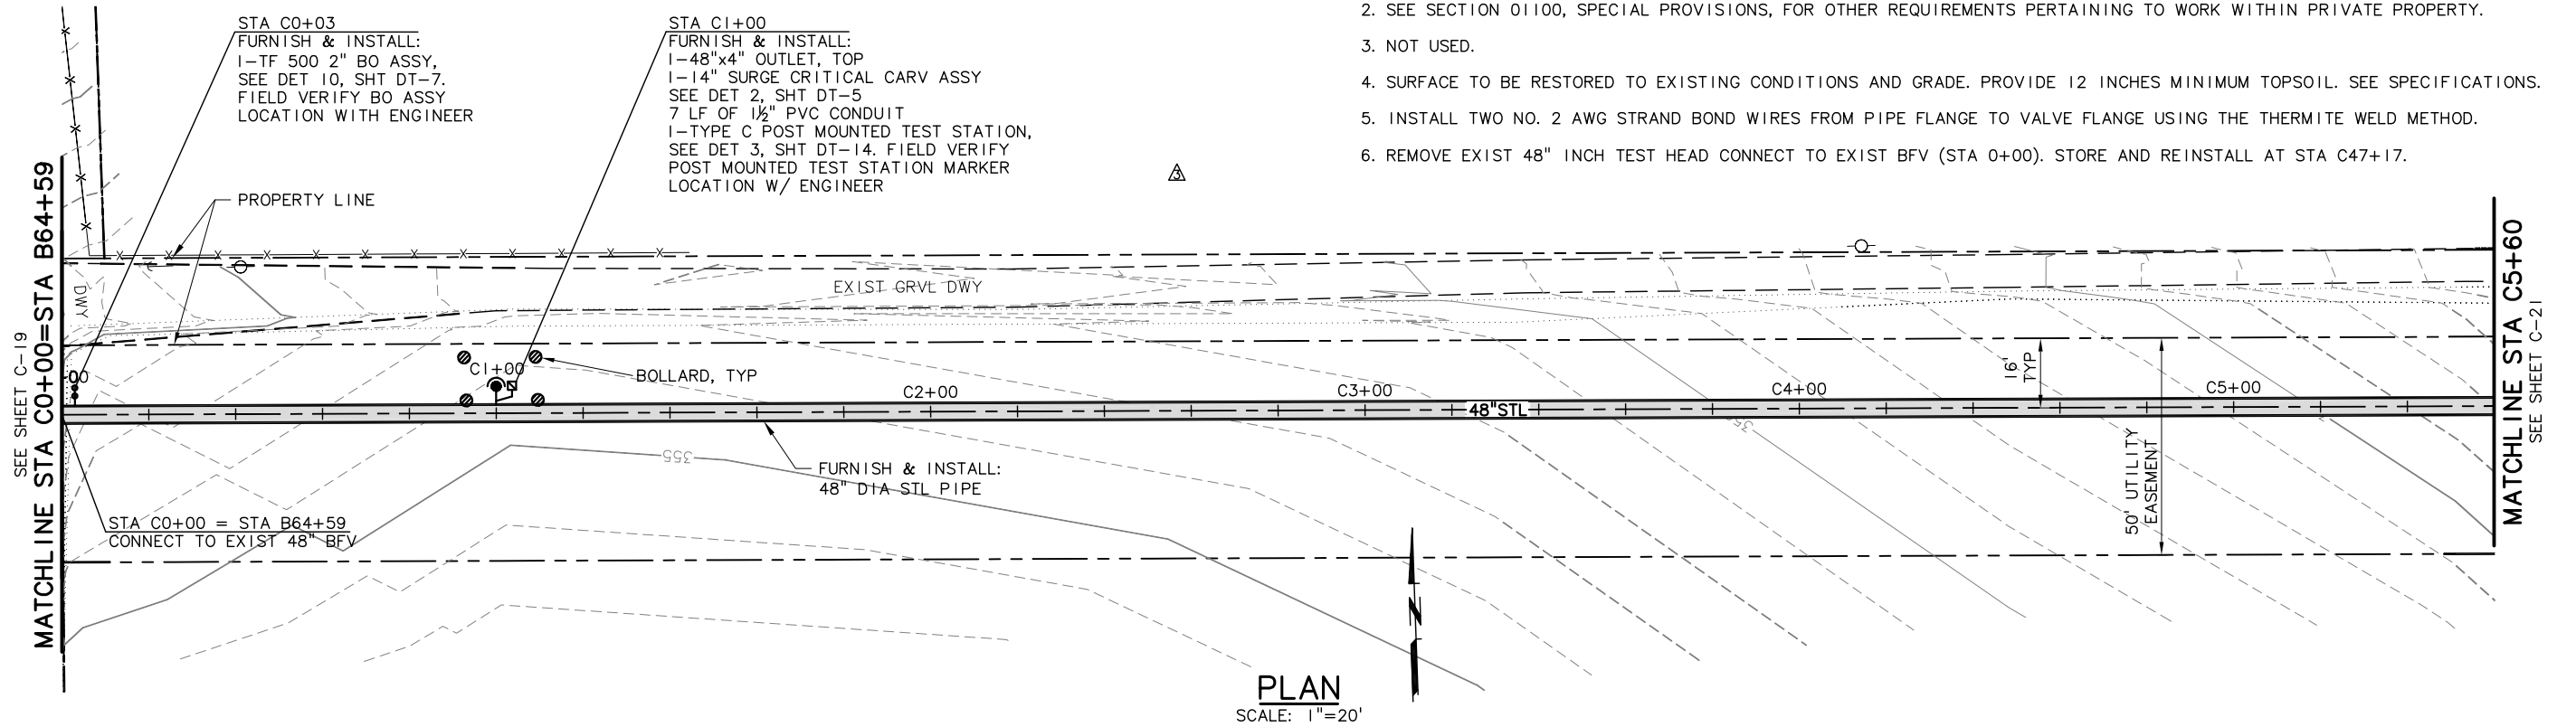

NO.	DATE	BY	REVISION
1	08/22/11	BVO	RECORD DRAWING

NOTICE

0 1/2 1

IF THIS BAR DOES NOT MEASURE 1" THEN DRAWING IS NOT TO SCALE

SMG DESIGNED
DAK DRAWN
MLH CHECKED

RECORD DRAWING

SEE DISCLAIMER, SHEET 1.

VERSION 4.1
12-9-97

MSA Murray Smith & Associates, Inc.
Engineers/Planners

121 S.W. Salmon, Suite 900
Portland, Oregon 97204

PHONE 503-225-9010
FAX 503-225-9022

City of Sherwood Oregon

WATER SUPPLY IMPROVEMENT PROJECT TRANSMISSION PIPELINE

WATERLINE SCHEDULE C PLAN AND PROFILE STA C0+00 TO STA C5+60


PROJECT NO.: 07-0873.207 SCALE: AS SHOWN DATE: JUNE 2009

SHEET C-20


43 of 79

NOTES:

1. CONTRACTOR TO STOCKPILE AND REUSE TOPSOIL STA C5+60 TO STA C11+20, SEE TRENCH DET 3, SHT DT-1.
2. SEE SPECIFICATION REQUIREMENTS PERTAINING TO WORK WITHIN PRIVATE PROPERTY.
3. SURFACE TO BE RESTORED TO EQUIVALENT CONDITION AND GRADE AS PRIOR TO CONSTRUCTION. PROVIDE 12 INCHES MINIMUM TOPSOIL. SEE SPECIFICATIONS.

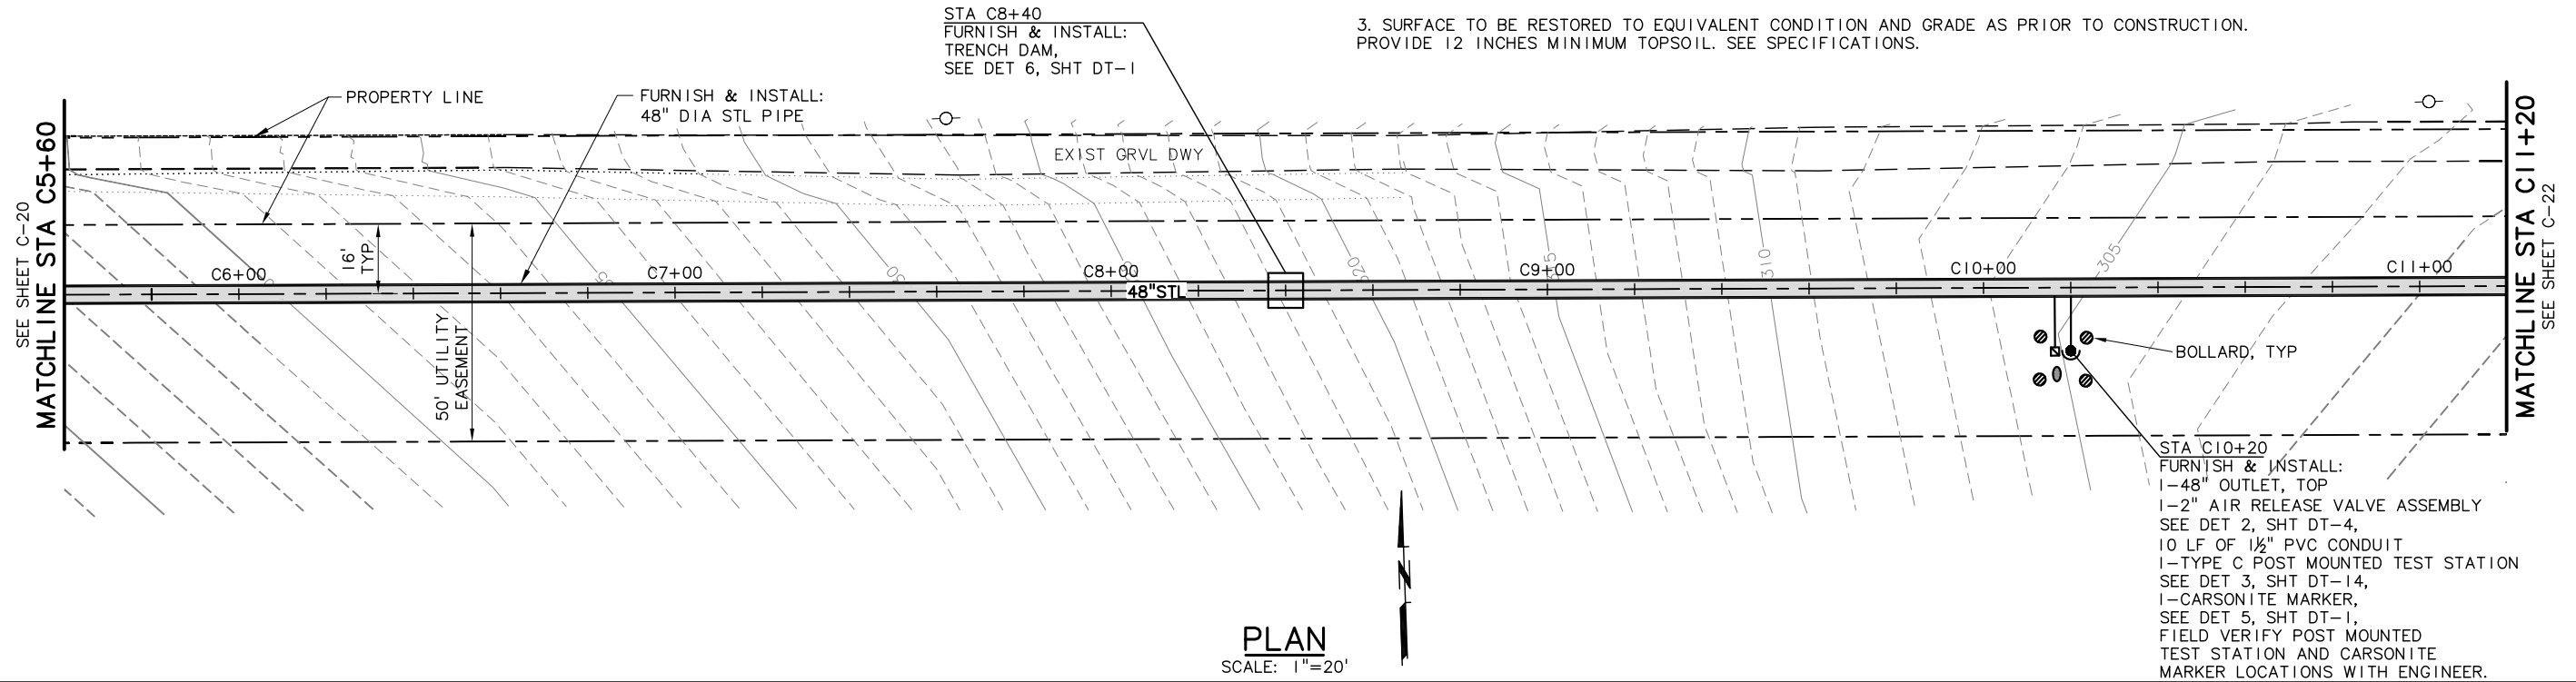

PLAN
SCALE: 1"=20'

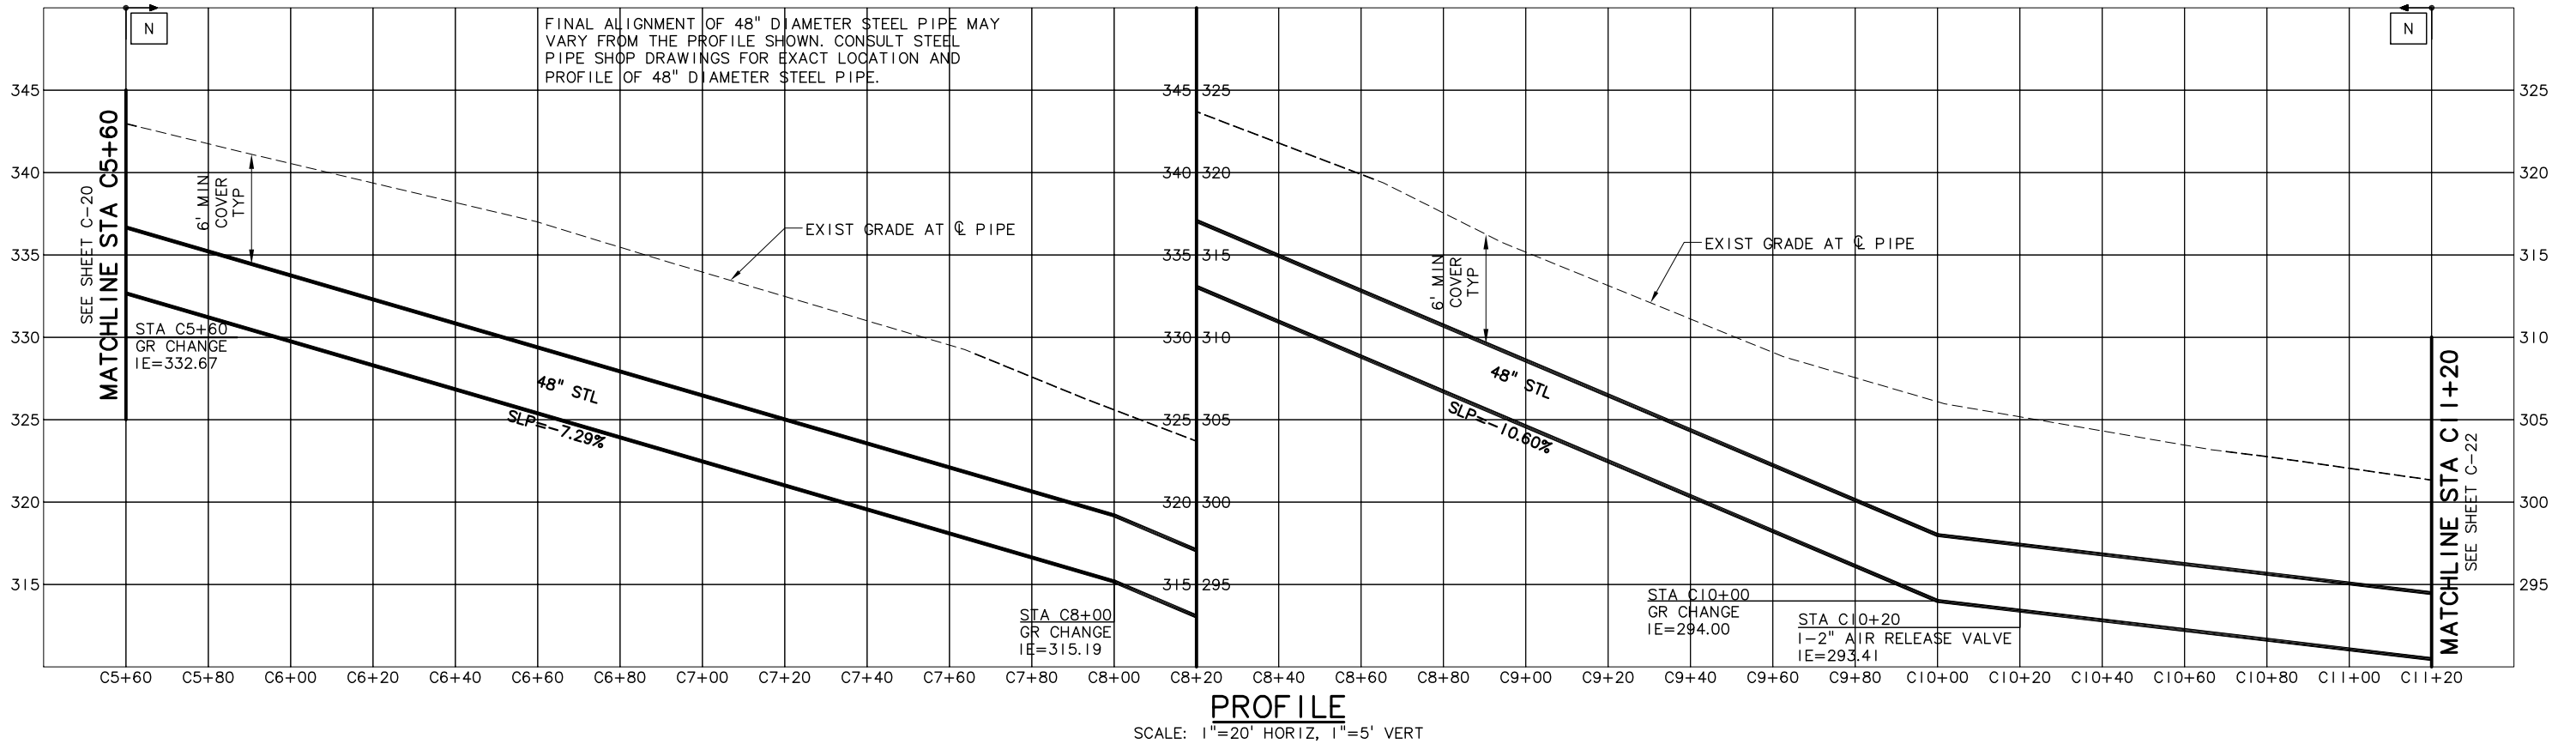

PROFILE
SCALE: 1"=20' HORIZ, 1"=5' VERT

C:\Users\dak\AppData\Local\temp\AcPublish_1580\07-0873-207-OR-CIVIL C-R.dwg C-21 9/6/2011 11:27 AM DAK 18.1s (LMS Tech)

NO.	DATE	BY	REVISION
1	08/22/11	BVO	RECORD DRAWING

NOTICE

0 1/2 1

IF THIS BAR DOES NOT MEASURE 1" THEN DRAWING IS NOT TO SCALE

SMG DESIGNED
DAK DRAWN
MLH CHECKED

RECORD DRAWING

SEE DISCLAIMER, SHEET 1.

VERSION 4.1
12-9-97

MSA Murray Smith & Associates, Inc.
Engineers/Planners

121 S.W. Salmon, Suite 900 PHONE 503-225-9010
Portland, Oregon 97204 FAX 503-225-9022

City of Sherwood Oregon



WATER SUPPLY IMPROVEMENT PROJECT TRANSMISSION PIPELINE

WATERLINE SCHEDULE C PLAN AND PROFILE STA C 5+60 TO STA C11+20

PROJECT NO.: 07-0873.207 SCALE: AS SHOWN DATE: JUNE 2009

SHEET C-21
44 of 79


C:\Users\dak\AppData\Local\temp\AcPublish_1580\07-0873-207-OR-CIVIL C-R.dwg C-22 9/6/2011 11:27 AM DAK 18.1s (LMS Tech)

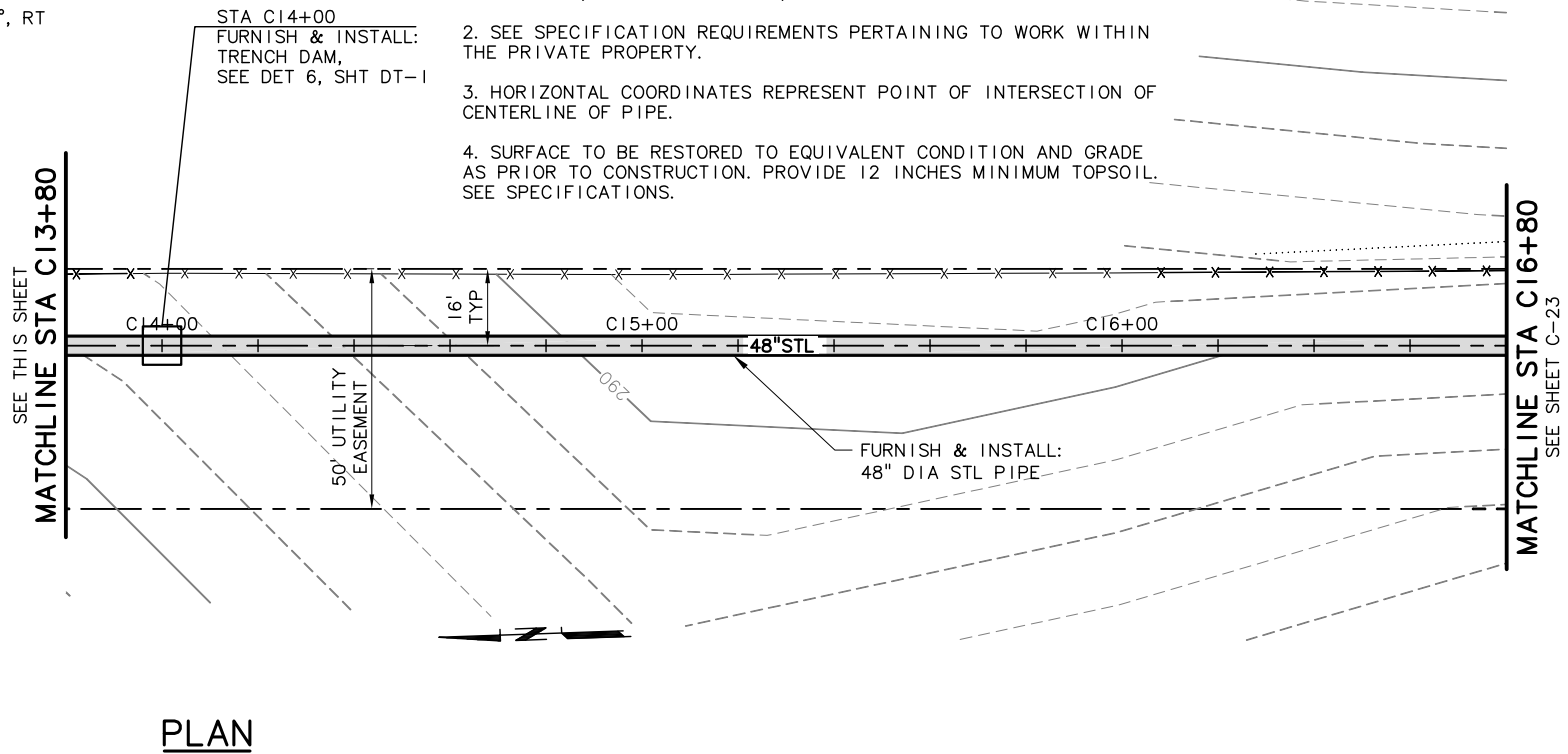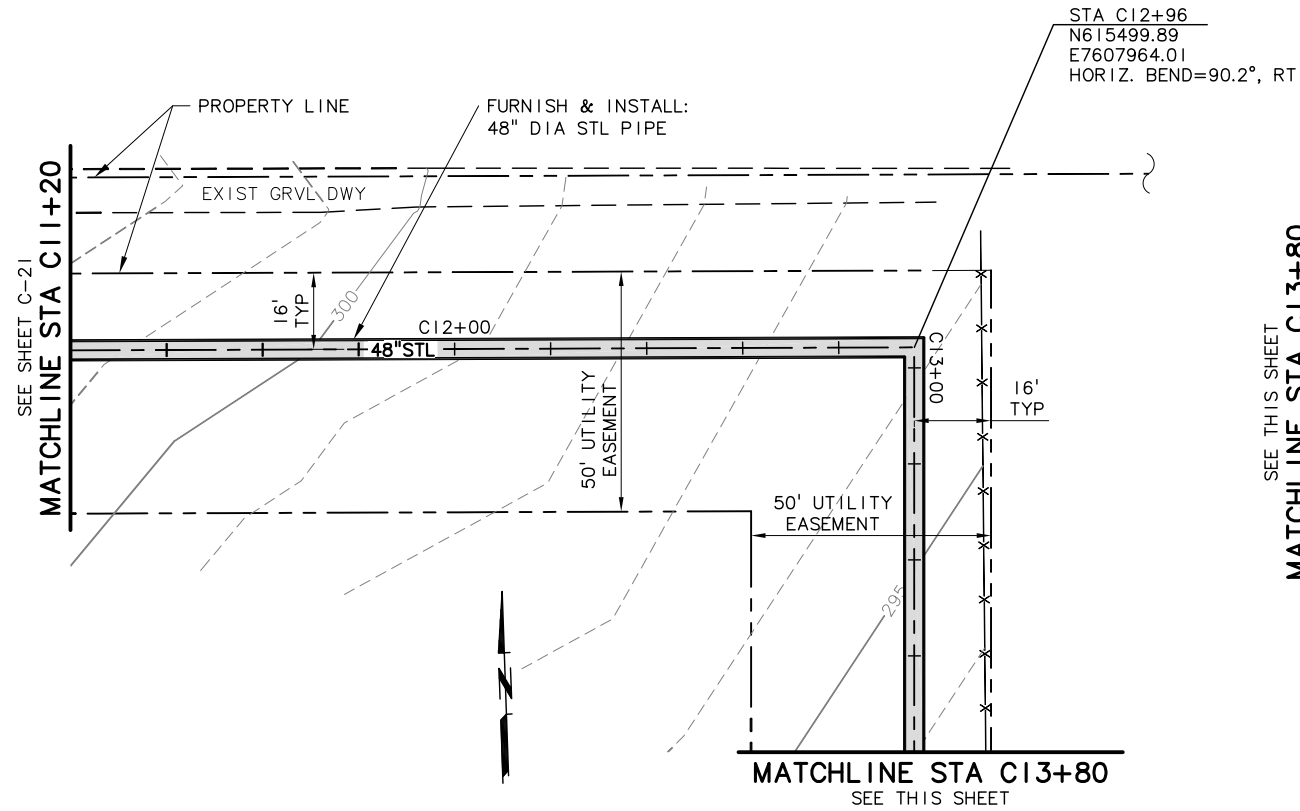

NOTES:

1. CONTRACTOR TO STOCKPILE AND REUSE TOPSOIL STA C11+20 TO STA C16+80, SEE TRENCH DET 3, SHT DT-1.
2. SEE SPECIFICATION REQUIREMENTS PERTAINING TO WORK WITHIN THE PRIVATE PROPERTY.
3. HORIZONTAL COORDINATES REPRESENT POINT OF INTERSECTION OF CENTERLINE OF PIPE.
4. SURFACE TO BE RESTORED TO EQUIVALENT CONDITION AND GRADE AS PRIOR TO CONSTRUCTION. PROVIDE 12 INCHES MINIMUM TOPSOIL. SEE SPECIFICATIONS.

PLAN
SCALE: 1"=20'

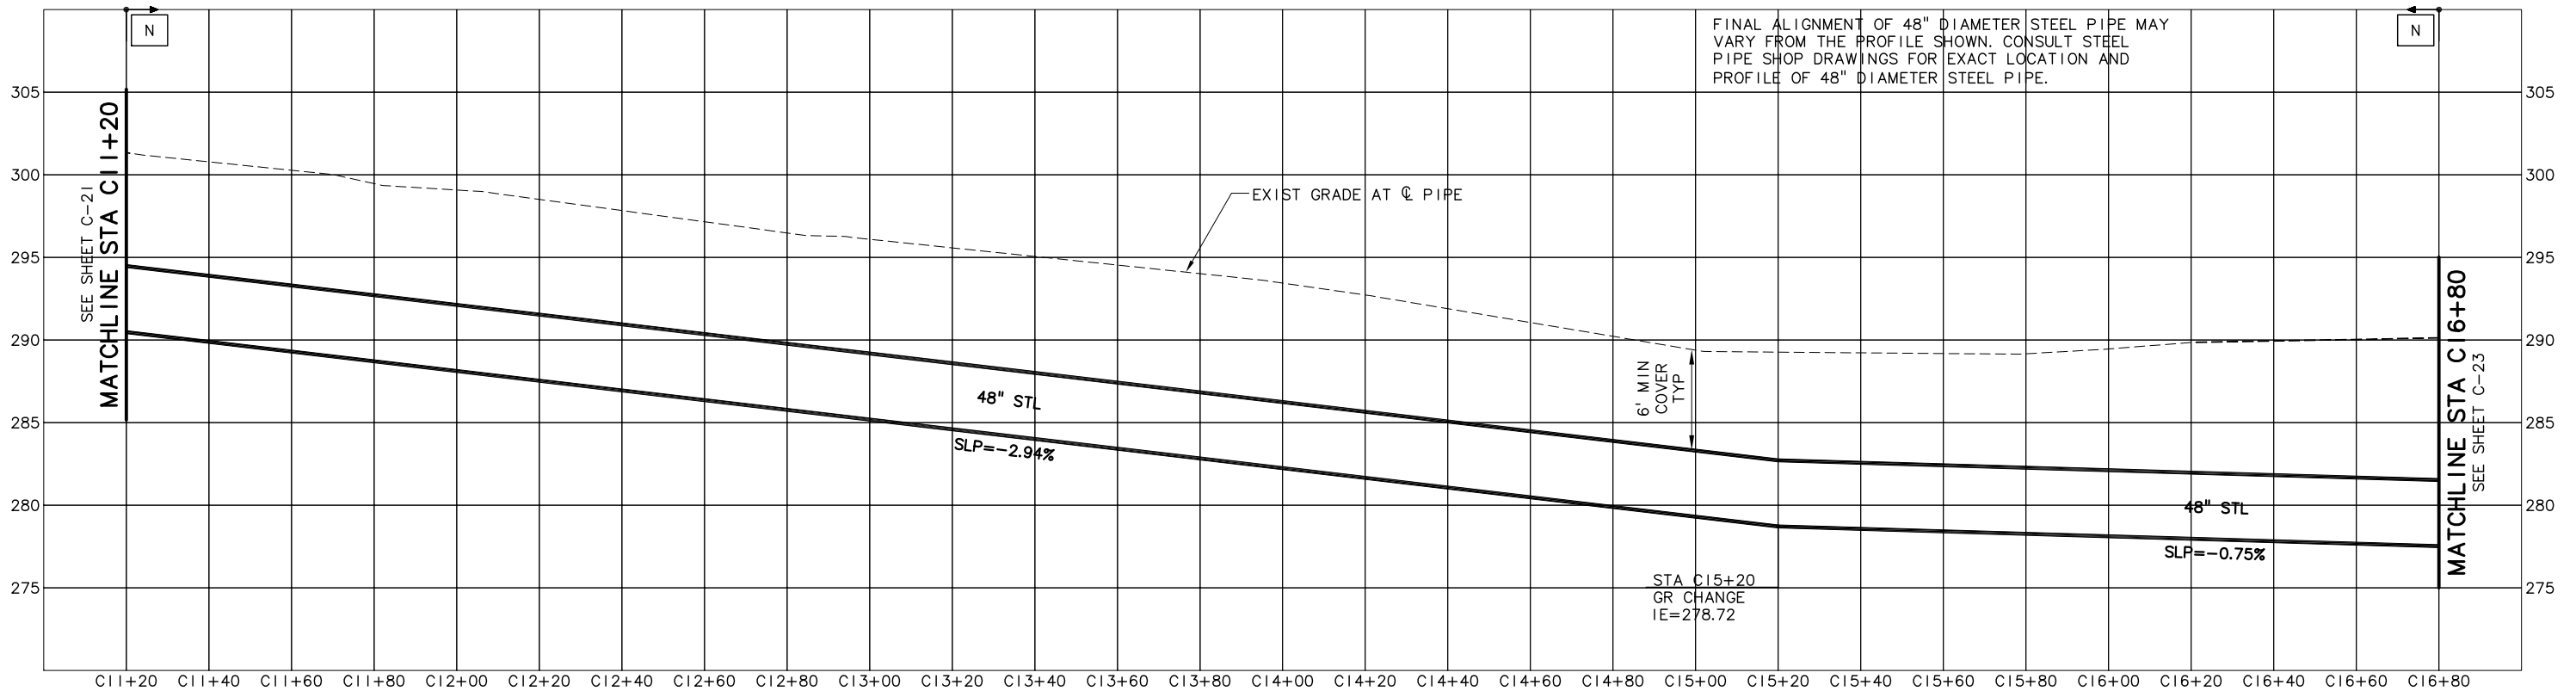

FINAL ALIGNMENT OF 48" DIAMETER STEEL PIPE MAY VARY FROM THE PROFILE SHOWN. CONSULT STEEL PIPE SHOP DRAWINGS FOR EXACT LOCATION AND PROFILE OF 48" DIAMETER STEEL PIPE.

PROFILE
SCALE: 1"=20' HORIZ, 1"=5' VERT

NO.	DATE	BY	REVISION
3	08/22/11	BVO	RECORD DRAWING

NOTICE
0 1/2 1
IF THIS BAR DOES NOT MEASURE 1" THEN DRAWING IS NOT TO SCALE

SMG DESIGNED
DAK DRAWN
MLH CHECKED

RECORD DRAWING
SEE DISCLAIMER, SHEET 1.
VERSION 4.1
12-9-97

MSA Murray Smith & Associates, Inc.
Engineers/Planners
121 S.W. Salmon, Suite 900 PHONE 503-225-9010
Portland, Oregon 97204 FAX 503-225-9022




WATER SUPPLY IMPROVEMENT PROJECT TRANSMISSION PIPELINE

WATERLINE SCHEDULE C PLAN AND PROFILE STA C11+20 TO STA C16+80

PROJECT NO.: 07-0873.207 SCALE: AS SHOWN DATE: JUNE 2009

SHEET
C-22
45 of 79

C:\Users\dak\AppData\Local\temp\AcPublish_1580\07-0873-207-OR-CIVIL C-R.dwg C-23 9/6/2011 11:27 AM DAK 18.1s (LMS Tech)

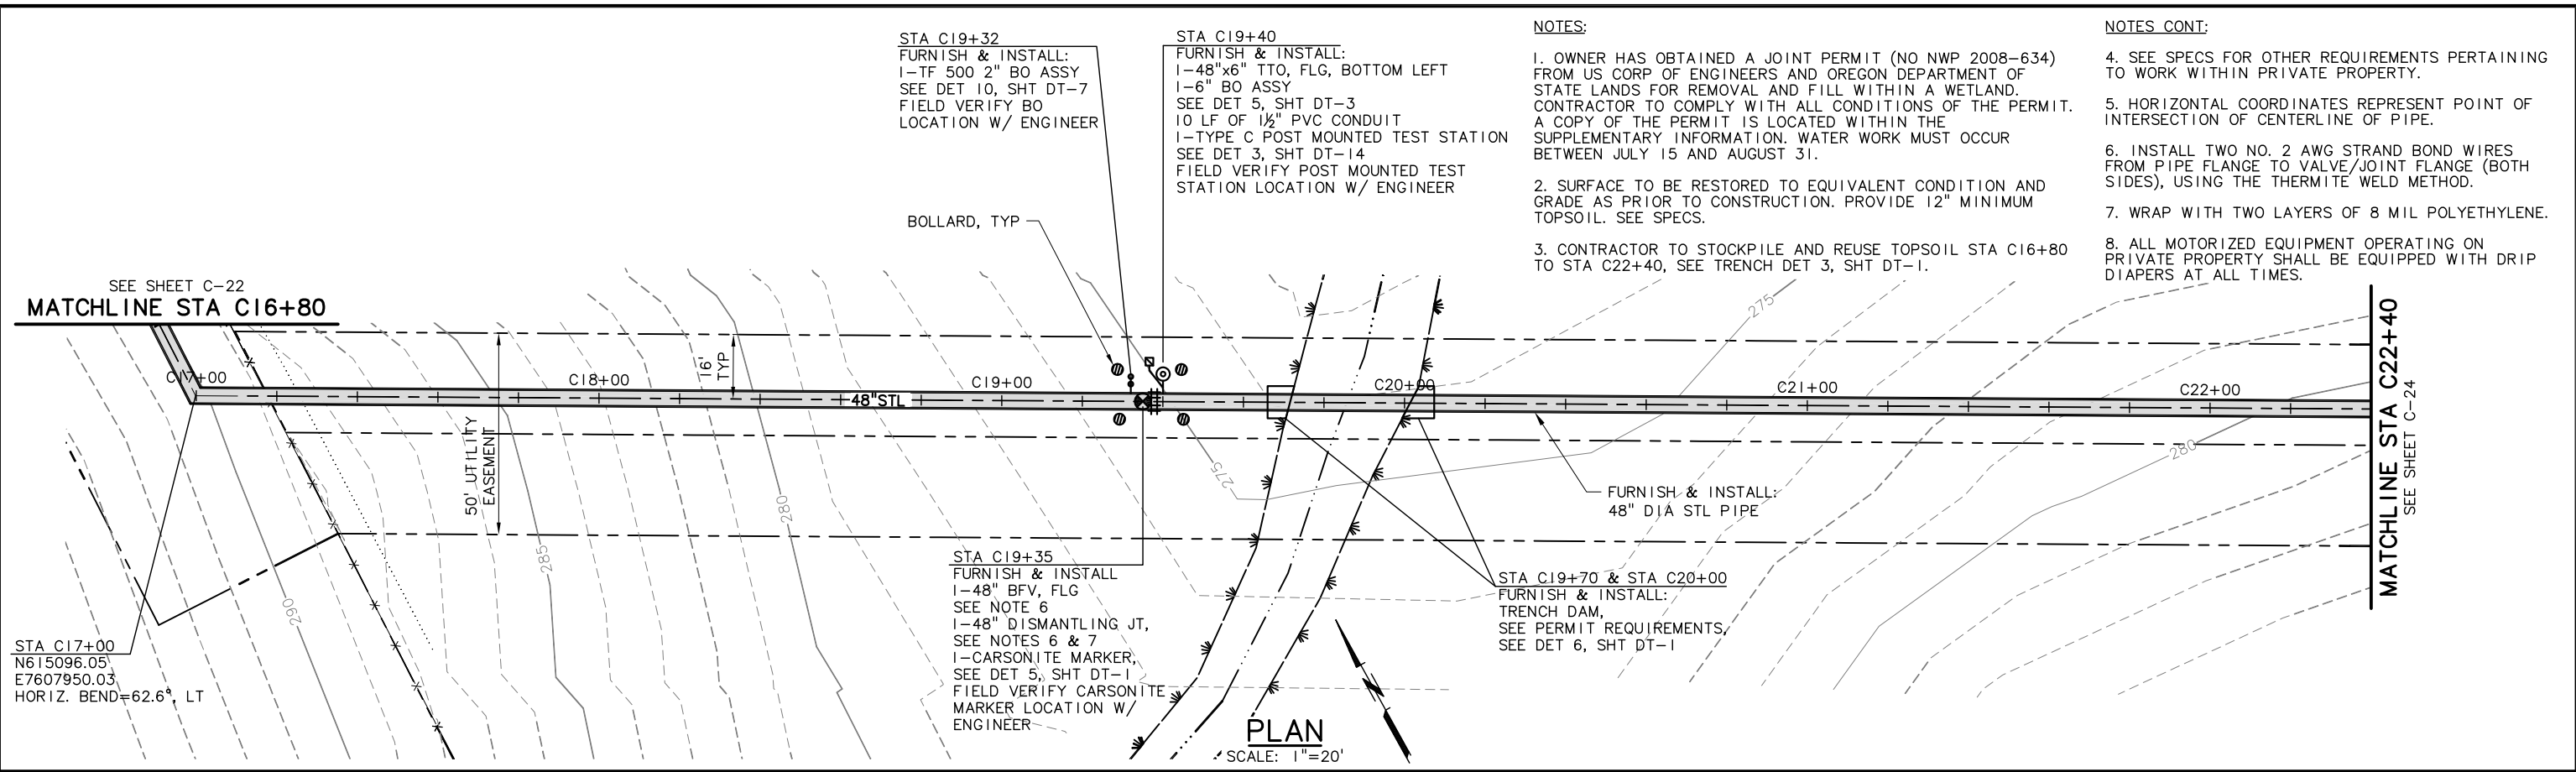

STA C19+32
FURNISH & INSTALL:
1-TF 500 2" BO ASSY
SEE DET 10, SHT DT-7
FIELD VERIFY BO
LOCATION W/ ENGINEER

STA C19+40
FURNISH & INSTALL:
1-48"x6" TFO, FLG, BOTTOM LEFT
1-6" BO ASSY
SEE DET 5, SHT DT-3
10 LF OF 1 1/2" PVC CONDUIT
1-TYPE C POST MOUNTED TEST STATION
SEE DET 3, SHT DT-14
FIELD VERIFY POST MOUNTED TEST
STATION LOCATION W/ ENGINEER

STA C19+35
FURNISH & INSTALL
1-48" BFV, FLG
SEE NOTE 6
1-48" DISMANTLING JT,
SEE NOTES 6 & 7
1-CARSONITE MARKER,
SEE DET 5, SHT DT-1
FIELD VERIFY CARSONITE
MARKER LOCATION W/
ENGINEER

STA C19+70 & STA C20+00
FURNISH & INSTALL:
TRENCH DAM,
SEE PERMIT REQUIREMENTS,
SEE DET 6, SHT DT-1

NOTES:


1. OWNER HAS OBTAINED A JOINT PERMIT (NO NWP 2008-634) FROM US CORP OF ENGINEERS AND OREGON DEPARTMENT OF STATE LANDS FOR REMOVAL AND FILL WITHIN A WETLAND. CONTRACTOR TO COMPLY WITH ALL CONDITIONS OF THE PERMIT. A COPY OF THE PERMIT IS LOCATED WITHIN THE SUPPLEMENTARY INFORMATION. WATER WORK MUST OCCUR BETWEEN JULY 15 AND AUGUST 31.
2. SURFACE TO BE RESTORED TO EQUIVALENT CONDITION AND GRADE AS PRIOR TO CONSTRUCTION. PROVIDE 12" MINIMUM TOPSOIL. SEE SPECS.
3. CONTRACTOR TO STOCKPILE AND REUSE TOPSOIL STA C16+80 TO STA C22+40, SEE TRENCH DET 3, SHT DT-1.

NOTES CONT:

4. SEE SPECS FOR OTHER REQUIREMENTS PERTAINING TO WORK WITHIN PRIVATE PROPERTY.
5. HORIZONTAL COORDINATES REPRESENT POINT OF INTERSECTION OF CENTERLINE OF PIPE.
6. INSTALL TWO NO. 2 AWG STRAND BOND WIRES FROM PIPE FLANGE TO VALVE/Joint FLANGE (BOTH SIDES), USING THE THERMITE WELD METHOD.
7. WRAP WITH TWO LAYERS OF 8 MIL POLYETHYLENE.
8. ALL MOTORIZED EQUIPMENT OPERATING ON PRIVATE PROPERTY SHALL BE EQUIPPED WITH DRIP DIAPERS AT ALL TIMES.

PLAN

SCALE: 1"=20'

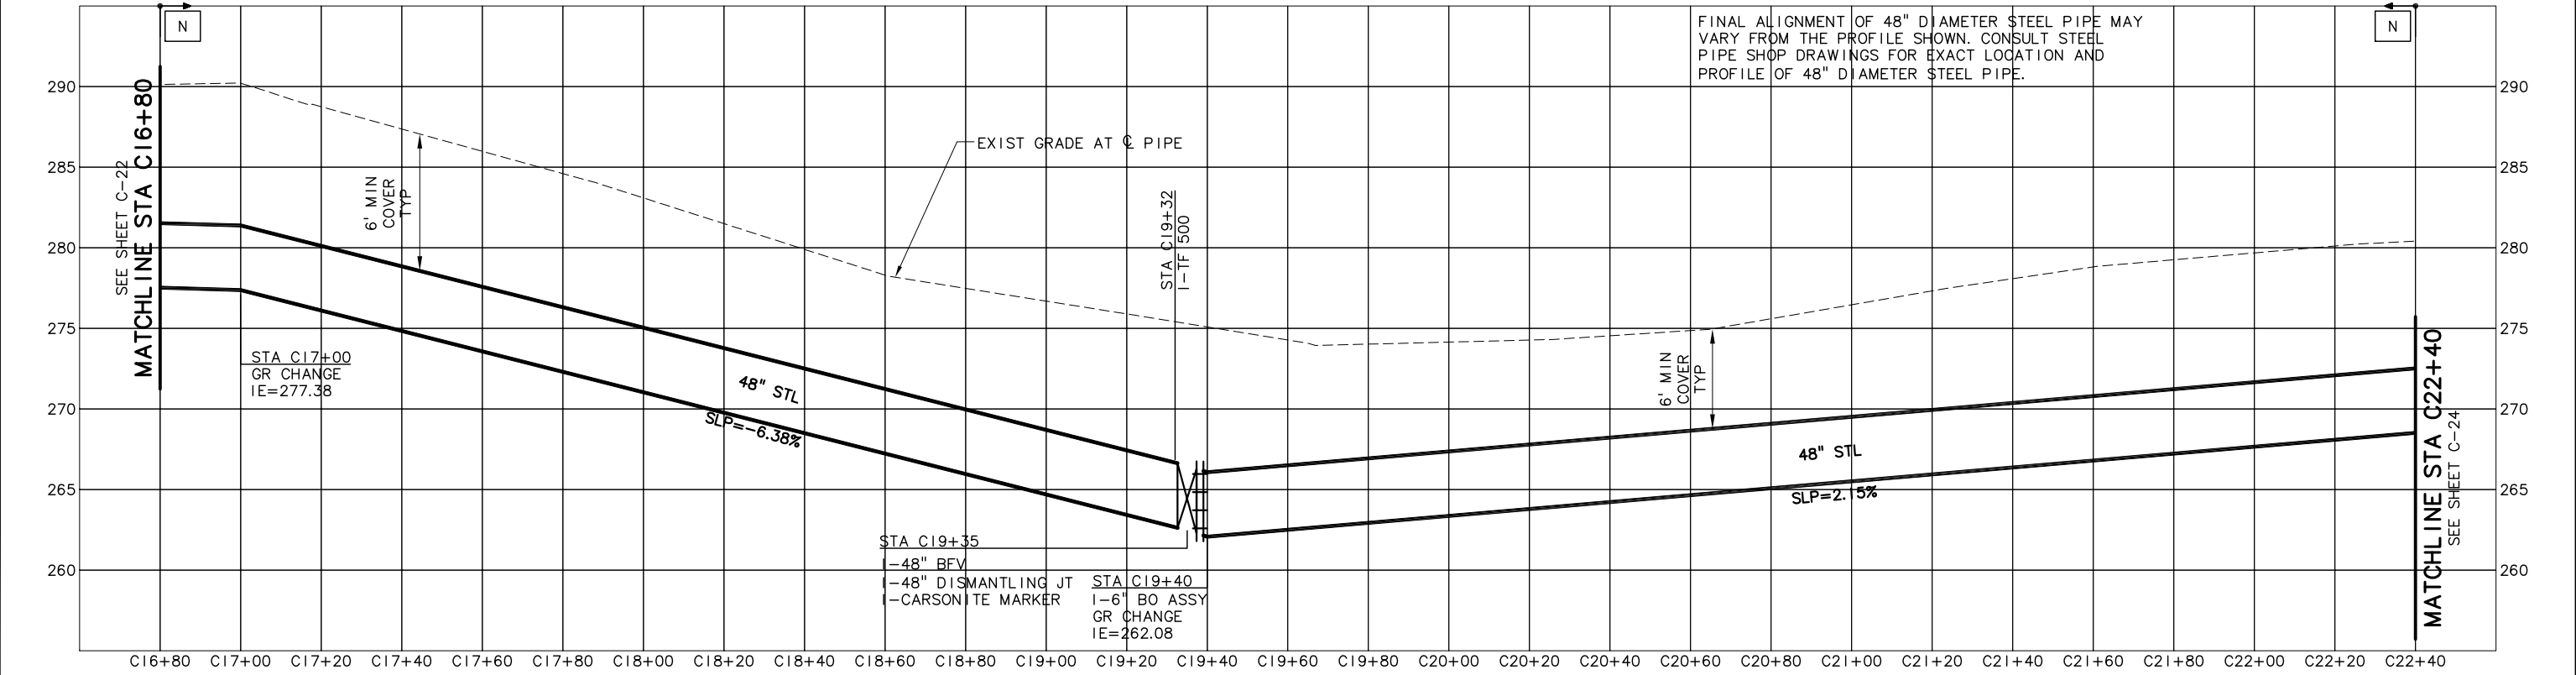

FINAL ALIGNMENT OF 48" DIAMETER STEEL PIPE MAY VARY FROM THE PROFILE SHOWN. CONSULT STEEL PIPE SHOP DRAWINGS FOR EXACT LOCATION AND PROFILE OF 48" DIAMETER STEEL PIPE.

PROFILE

SCALE: 1"=20' HORIZ, 1"=5' VERT

NO.	DATE	BY	REVISION
1	08/22/11	BVO	RECORD DRAWING

NOTICE

0 1/2 1

IF THIS BAR DOES NOT MEASURE 1" THEN DRAWING IS NOT TO SCALE

SMG DESIGNED
DAK DRAWN
MLH CHECKED

RECORD DRAWING

SEE DISCLAIMER, SHEET 1.

VERSION 4.1
12-9-97

MSA Murray Smith & Associates, Inc.
Engineers/Planners

121 S.W. Salmon, Suite 900 PHONE 503-225-9010
Portland, Oregon 97204 FAX 503-225-9022

City of Sherwood Oregon

WATER SUPPLY IMPROVEMENT PROJECT TRANSMISSION PIPELINE

WATERLINE SCHEDULE C PLAN AND PROFILE STA C16+80 TO STA C22+40

PROJECT NO.: 07-0873.207 SCALE: AS SHOWN DATE: JUNE 2009

SHEET C-23
46 of 79


C:\Users\dak\AppData\Local\temp\AcPublish_1580\07-0873-207-OR-CIVIL C-R.dwg C-24 9/6/2011 11:27 AM DAK 18.1s (LMS Tech)

STA C22+80
 FURNISH & INSTALL:
 1-48" x 4" OUTLET, TOP
 1-12" CARV ASSY
 SEE DET 2, SHT DT-5
 7 LF OF 1/2" PVC CONDUIT
 1-TYPE C POST MOUNTED TEST STATION
 SEE DET 3, SHT DT-14,
 FIELD VERIFY POST MOUNTED TEST
 STATION LOCATION W/ ENGINEER


STA C25+20
 FURNISH & INSTALL:
 TRENCH DAM,
 SEE DET 6, SHT DT-1

NOTES:

1. CONTRACTOR TO STOCKPILE AND REUSE TOPSOIL STA C22+40 TO STA C28+00, SEE TRENCH DET 3, SHT DT-1.
2. SEE SPECS FOR OTHER REQUIREMENTS PERTAINING TO WORK WITHIN PRIVATE PROPERTY.
3. SURFACE TO BE RESTORED TO EQUIVALENT CONDITION AND GRADE AS PRIOR TO CONSTRUCTION. PROVIDE 12 INCHES MINIMUM TOPSOIL, SEE SPECS.

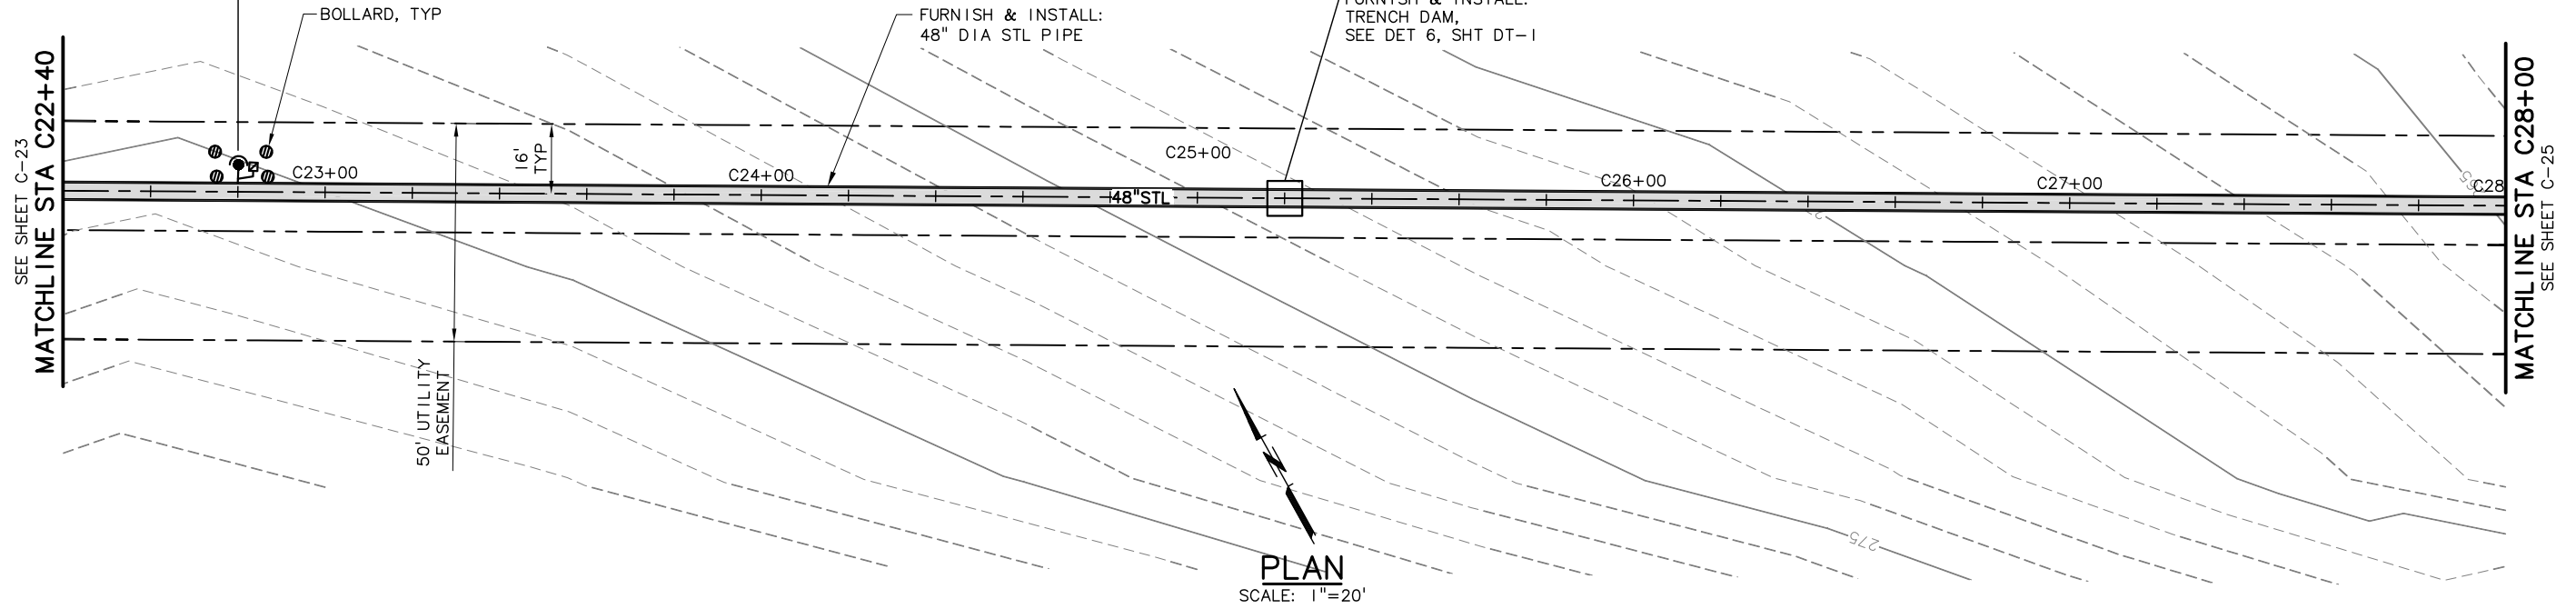

PLAN
 SCALE: 1"=20'

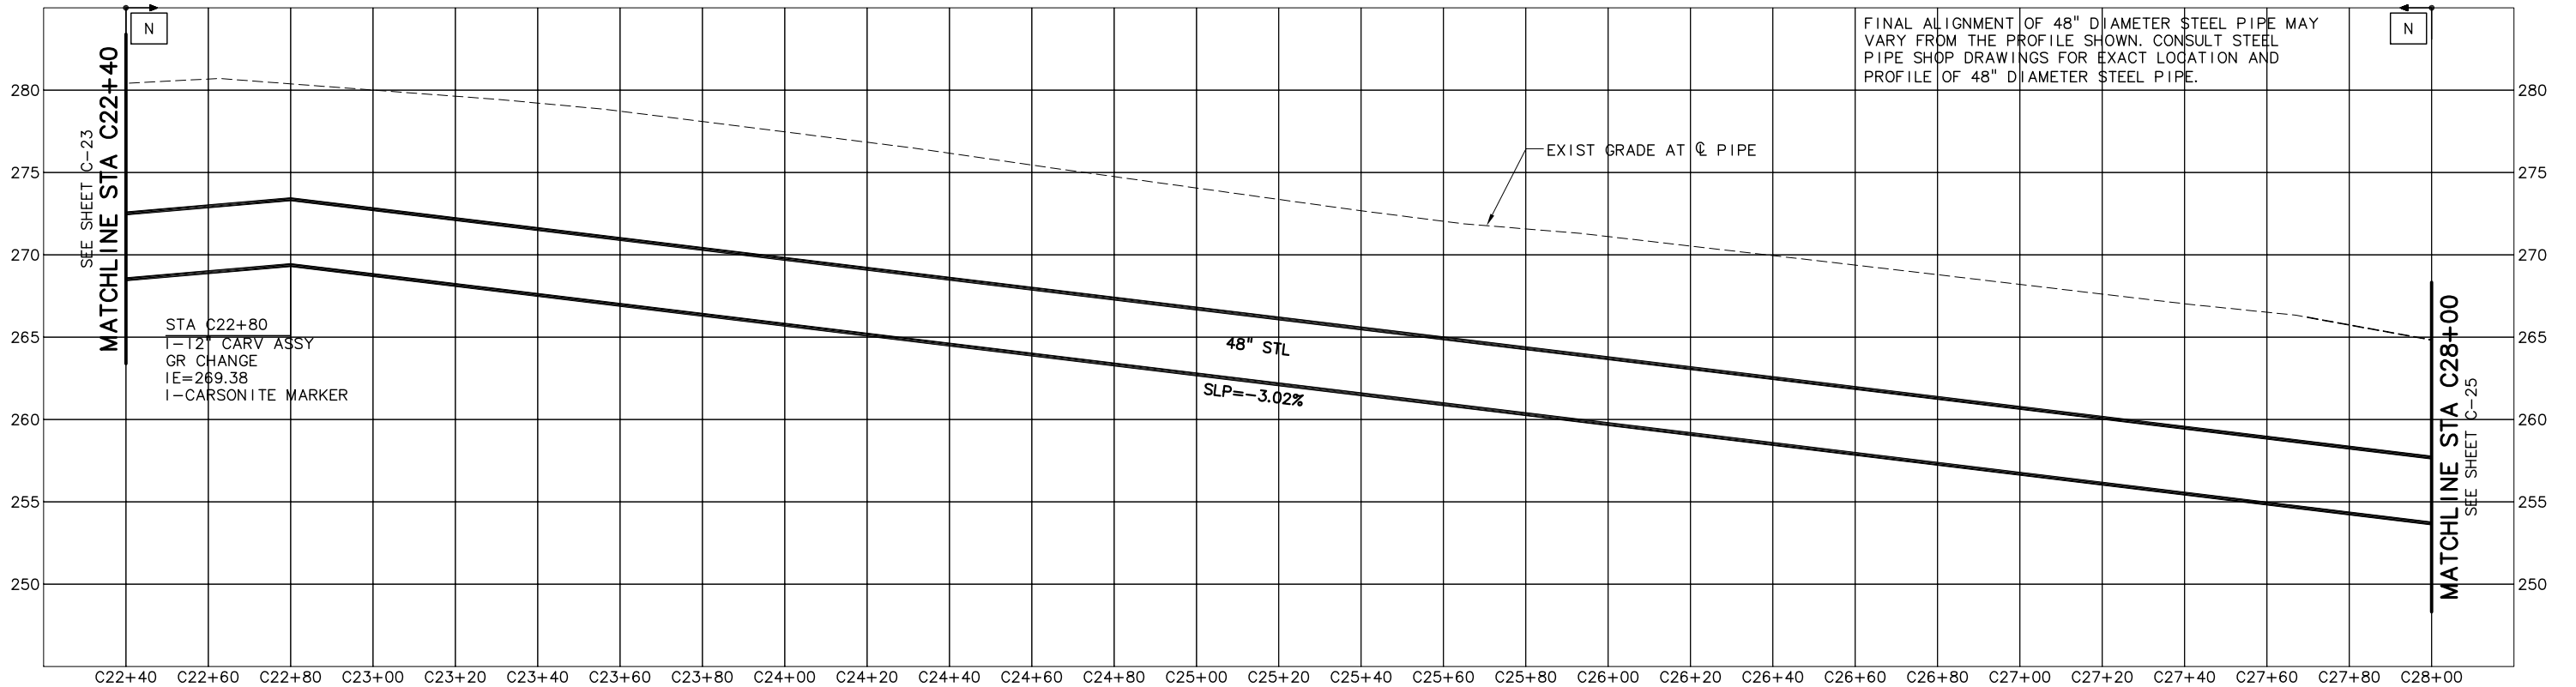

PROFILE

SCALE: 1"=20' HORIZ, 1"=5' VERT

FINAL ALIGNMENT OF 48" DIAMETER STEEL PIPE MAY VARY FROM THE PROFILE SHOWN. CONSULT STEEL PIPE SHOP DRAWINGS FOR EXACT LOCATION AND PROFILE OF 48" DIAMETER STEEL PIPE.

NO.	DATE	BY	REVISION
1	08/22/11	BVO	RECORD DRAWING

NOTICE
 0 1/2 1
 IF THIS BAR DOES NOT MEASURE 1" THEN DRAWING IS NOT TO SCALE

SMG DESIGNED
 DAK DRAWN
 MLH CHECKED

RECORD DRAWING
 SEE DISCLAIMER, SHEET 1.
 VERSION 4.1
 12-9-97

MSA Murray Smith & Associates, Inc.
 Engineers/Planners
 121 S.W. Salmon, Suite 900 PHONE 503-225-9010
 Portland, Oregon 97204 FAX 503-225-9022





WATER SUPPLY IMPROVEMENT PROJECT TRANSMISSION PIPELINE

WATERLINE SCHEDULE C PLAN AND PROFILE STA C22+40 TO STA C28+00

PROJECT NO.: 07-0873.207 SCALE: AS SHOWN DATE: JUNE 2009

SHEET
C-24
 47 of 79

C:\Users\dak\AppData\Local\temp\AcPublish_1580\07-0873-207-OR-CIVIL C-R.dwg C-25 9/6/2011 11:27 AM DAK 18.1s (LMS Tech)

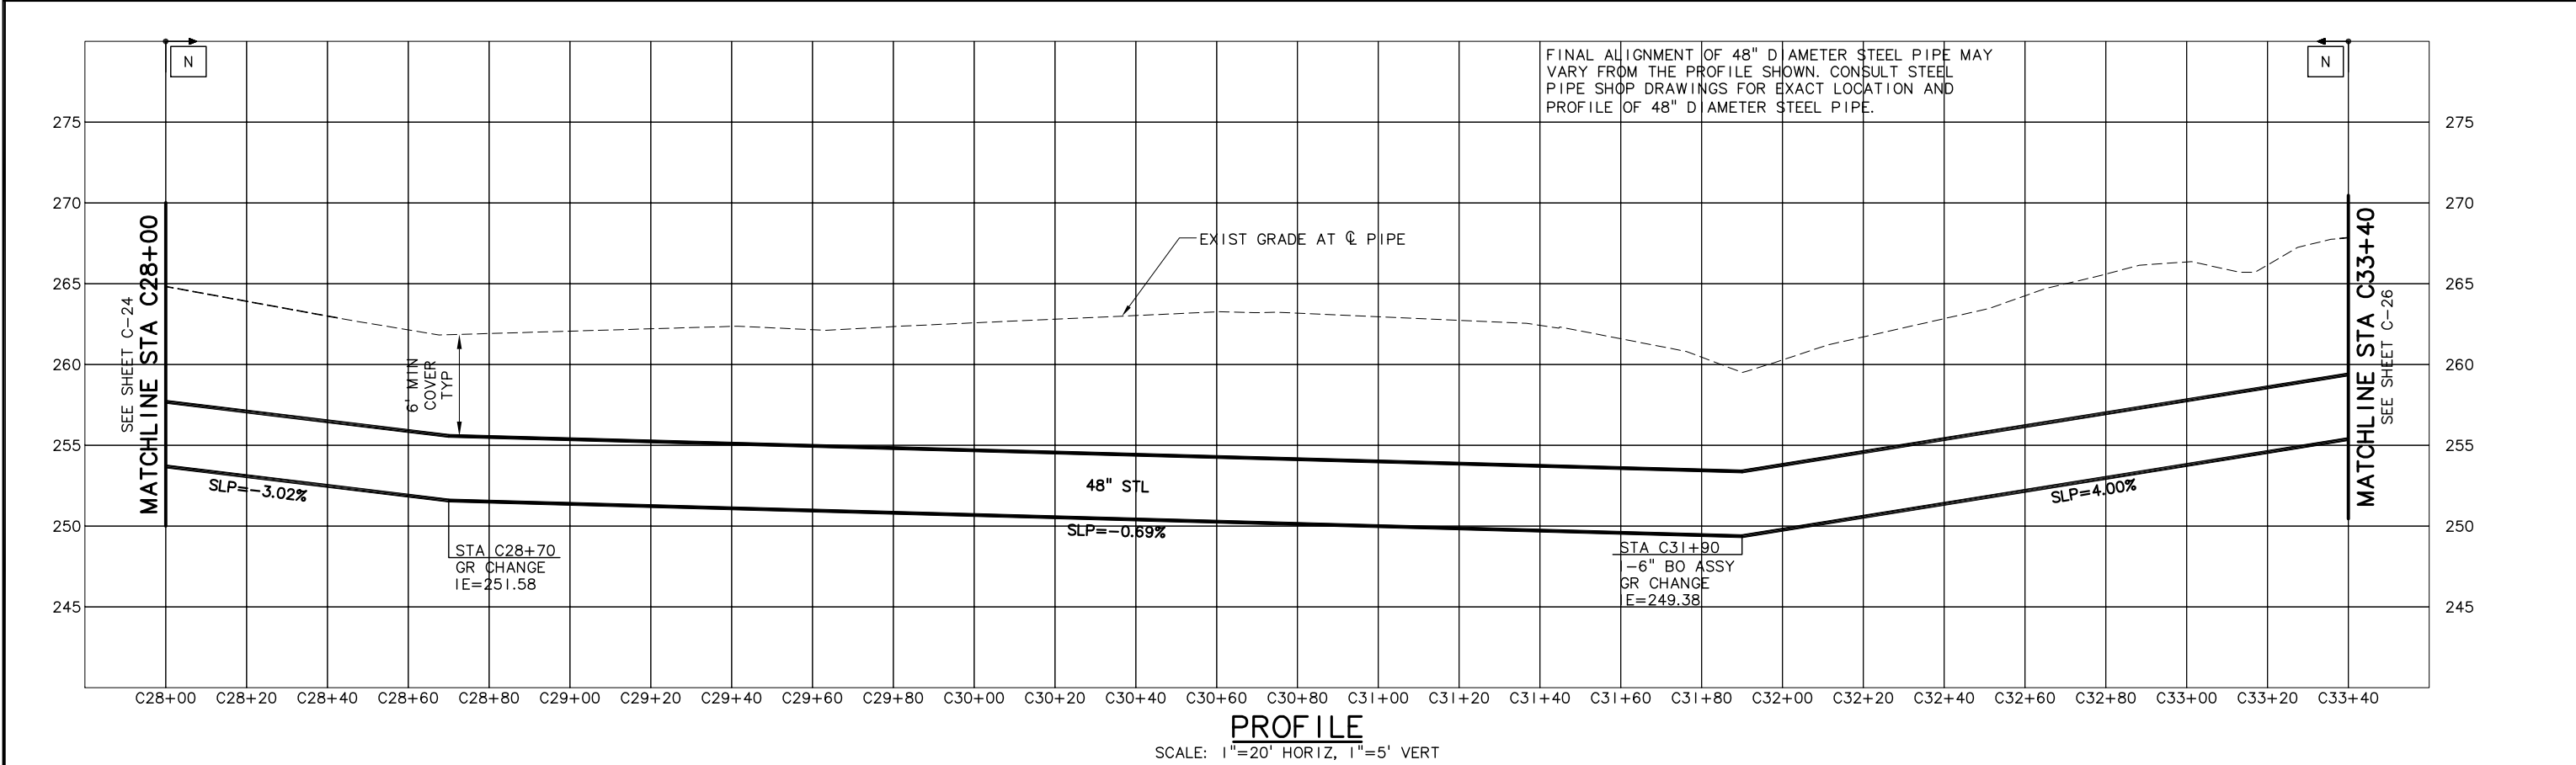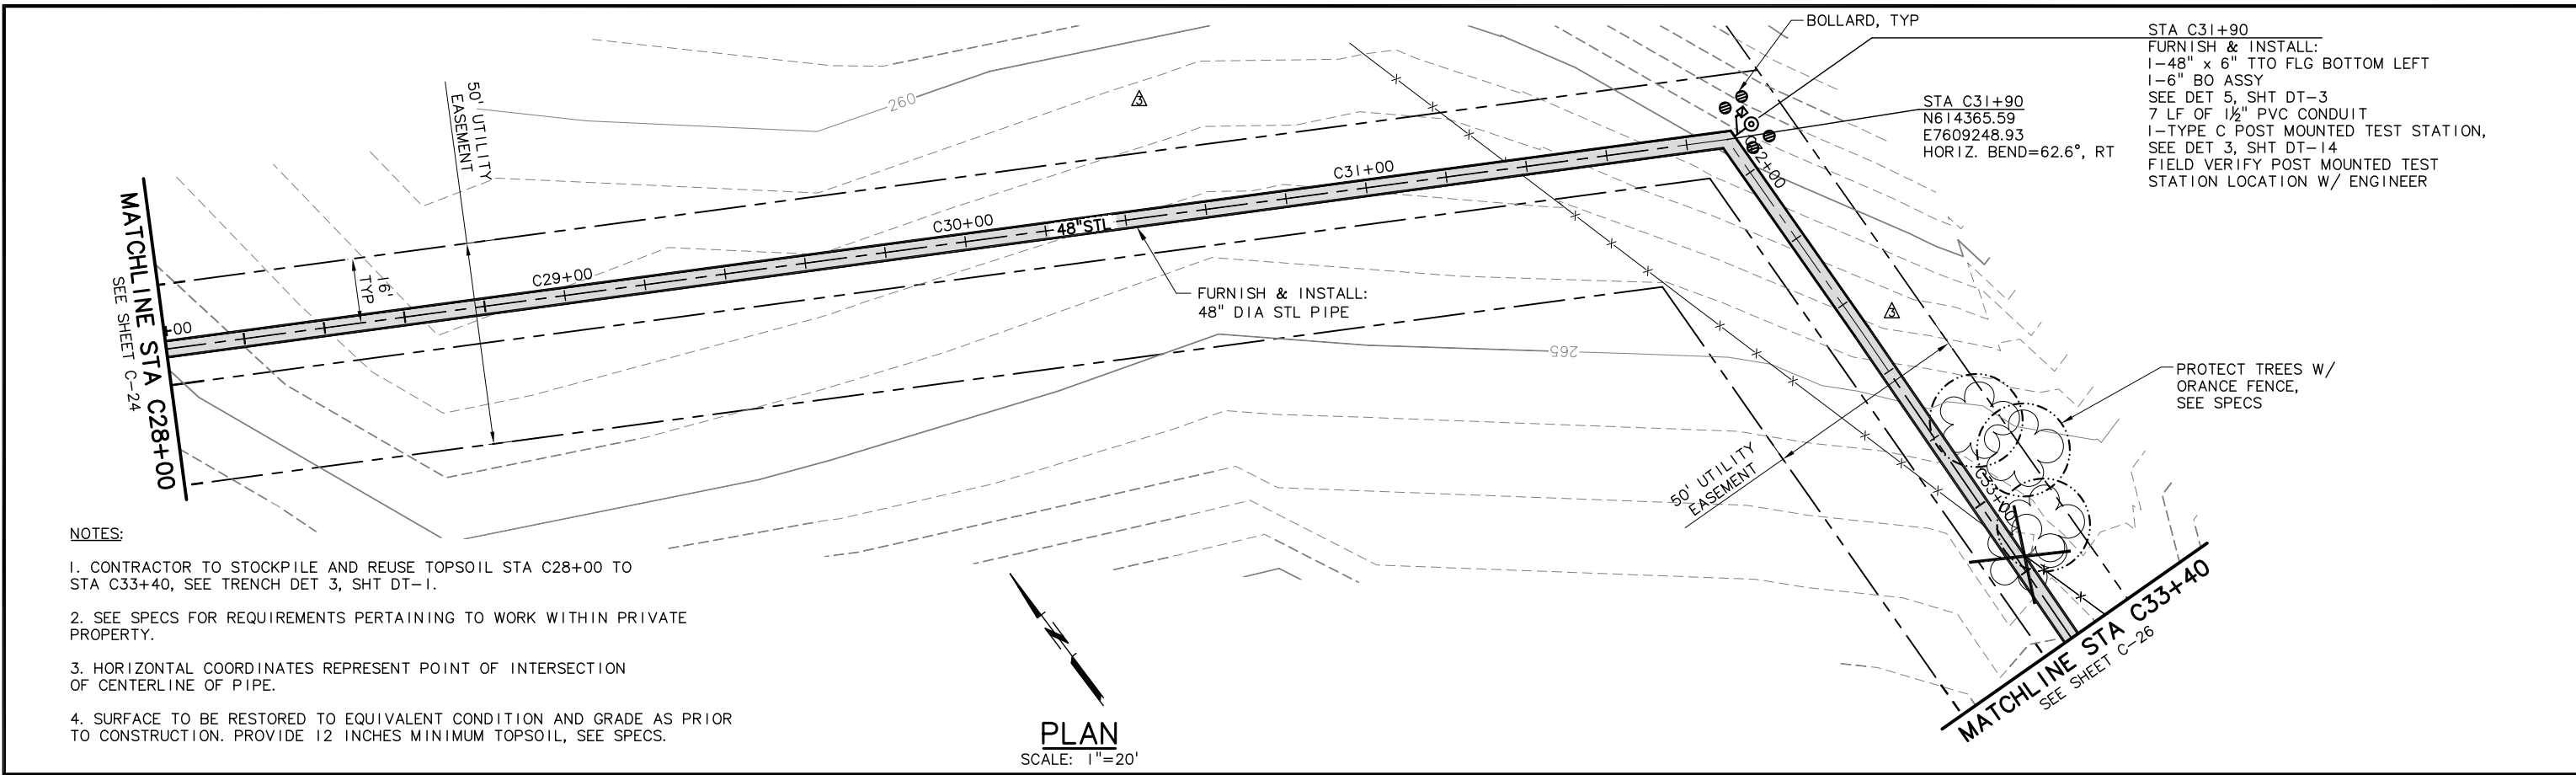

NO.	DATE	BY	REVISION
1	08/22/11	BVO	RECORD DRAWING

NOTICE
0 1/2 1
IF THIS BAR DOES NOT MEASURE 1" THEN DRAWING IS NOT TO SCALE

SMG DESIGNED
DAK DRAWN
MLH CHECKED

RECORD DRAWING
SEE DISCLAIMER, SHEET 1.
VERSION 4.1
12-9-97

MSA Murray Smith & Associates, Inc.
Engineers/Planners
121 S.W. Salmon, Suite 900 PHONE 503-225-9010
Portland, Oregon 97204 FAX 503-225-9022

City of Sherwood Oregon



WATER SUPPLY IMPROVEMENT PROJECT TRANSMISSION PIPELINE

WATERLINE SCHEDULE C PLAN AND PROFILE STA C28+00 TO STA C33+40

PROJECT NO.: 07-0873.207 SCALE: AS SHOWN DATE: JUNE 2009

SHEET
C-25
48 of 79

STA C33+60, 16' LT
 N614195.73,
 E7609243.05
 BEGIN RELOCATION
 OF FENCE, REUSE FENCE
 POSTS WHERE UNDAMAGED,
 REPLACE WIRE W/ LIKE
 KIND, RELOCATE 770% LF
 WIRE FENCE AS SHOWN.

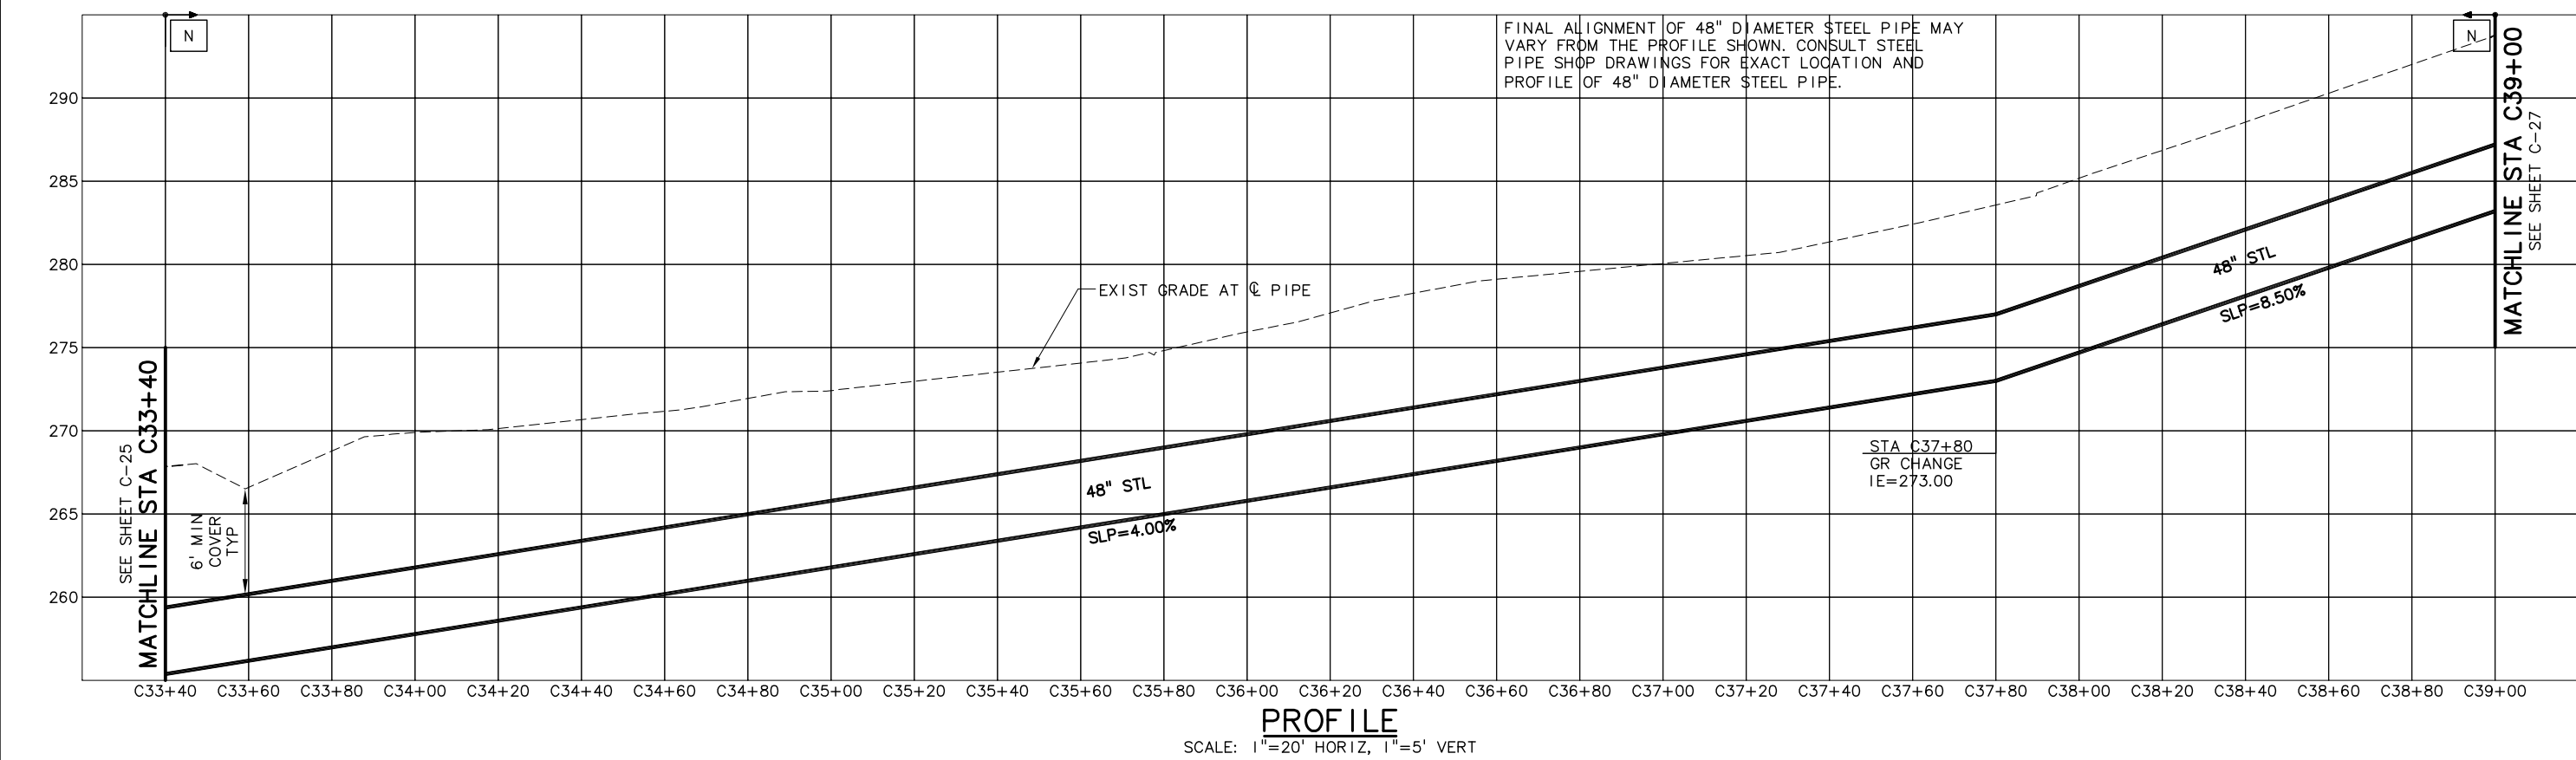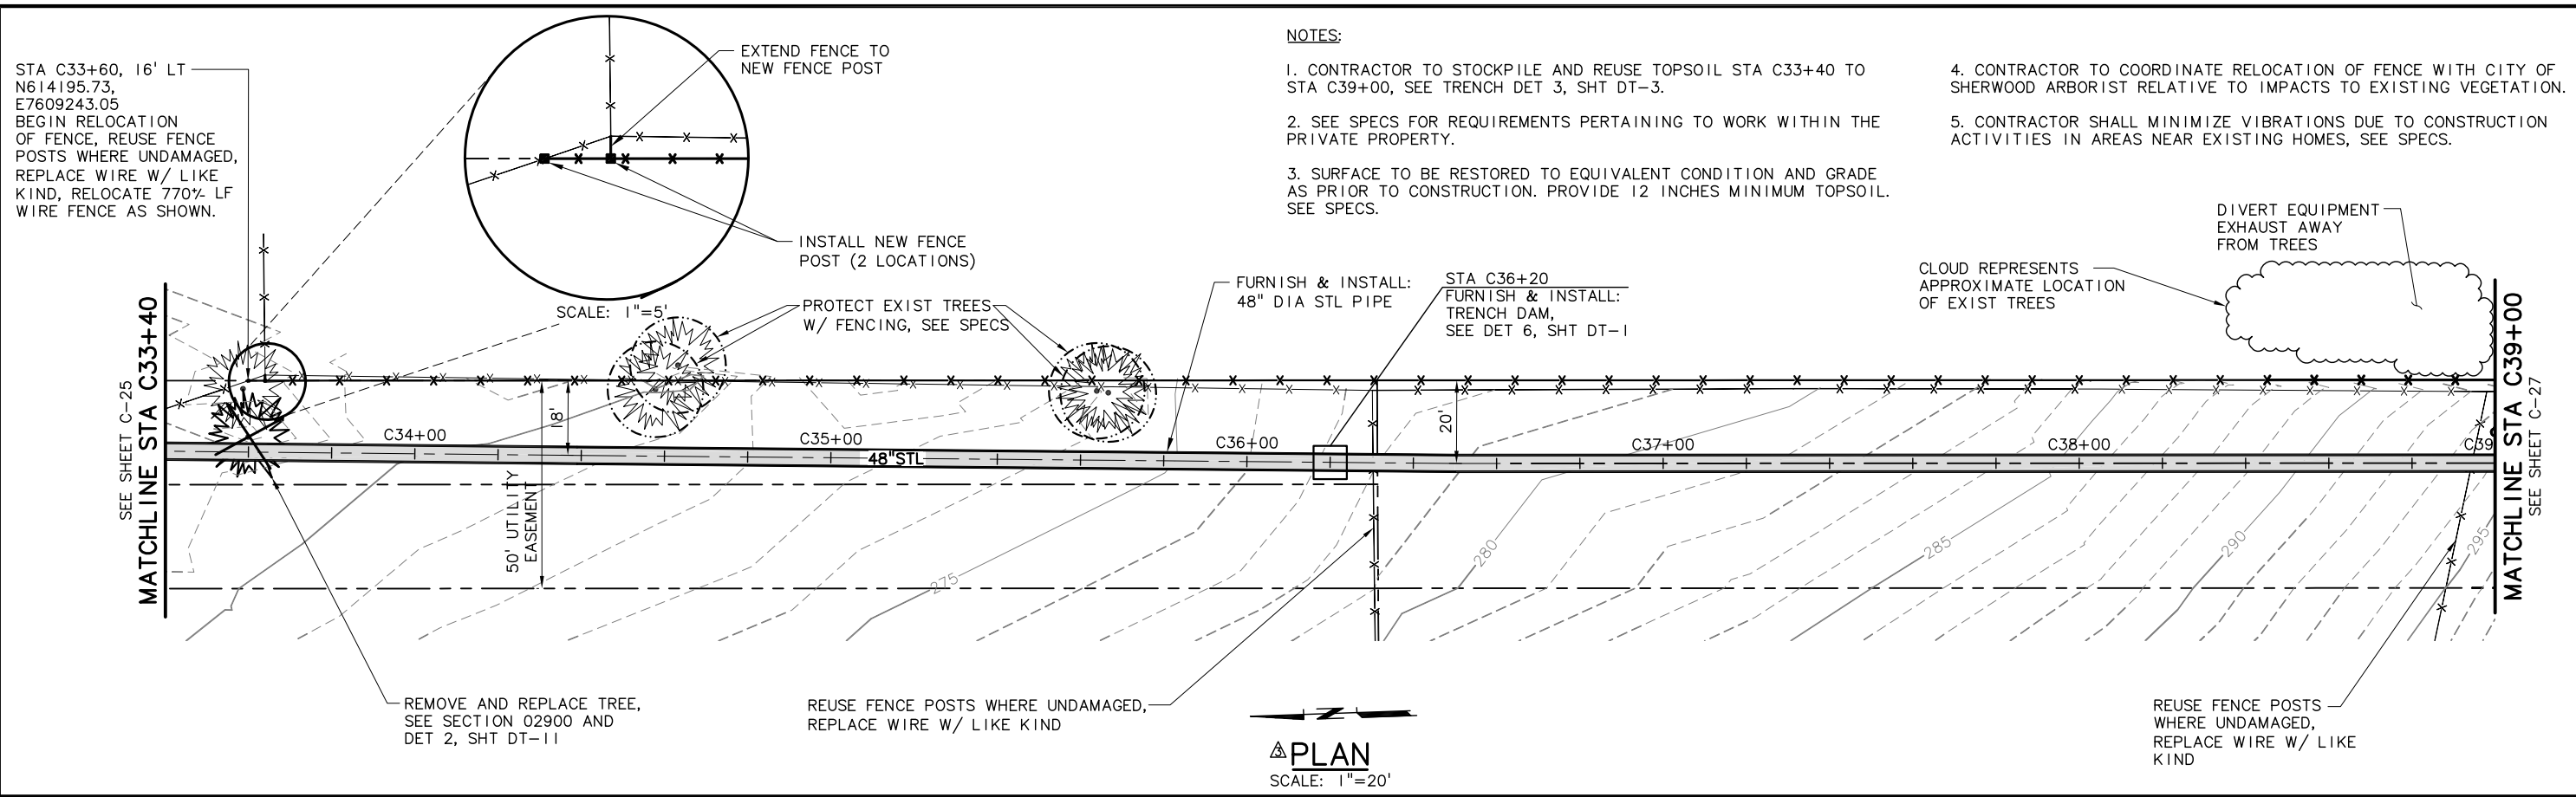

C:\Users\dak\appdata\local\temp\AcPublish_1580\07-0873-207-OR-CIVIL C-R.dwg C-26 9/6/2011 11:27 AM DAK 18.1s (LMS Tech)

NO.	DATE	BY	REVISION
1	08/22/11	BVO	RECORD DRAWING

NOTICE

0 1/2 1

IF THIS BAR DOES NOT MEASURE 1" THEN DRAWING IS NOT TO SCALE

SMG DESIGNED
 DAK DRAWN
 MLH CHECKED

RECORD DRAWING

SEE DISCLAIMER, SHEET 1.

VERSION 4.1
 12-9-97

MSA Murray Smith & Associates, Inc.
 Engineers/Planners

121 S.W. Salmon, Suite 900 PHONE 503-225-9010
 Portland, Oregon 97204 FAX 503-225-9022

City of Sherwood Oregon



WATER SUPPLY IMPROVEMENT PROJECT TRANSMISSION PIPELINE

WATERLINE SCHEDULE C PLAN AND PROFILE STA C33+40 TO STA C39+00

PROJECT NO.: 07-0873.207 SCALE: AS SHOWN DATE: JUNE 2009

SHEET C-26
 49 of 79

C:\Users\dak\AppData\Local\temp\AcPublish_1580\07-0873-207-OR-CIVIL C-R.dwg C-27 9/6/2011 11:27 AM DAK 18.1s (LMS Tech)

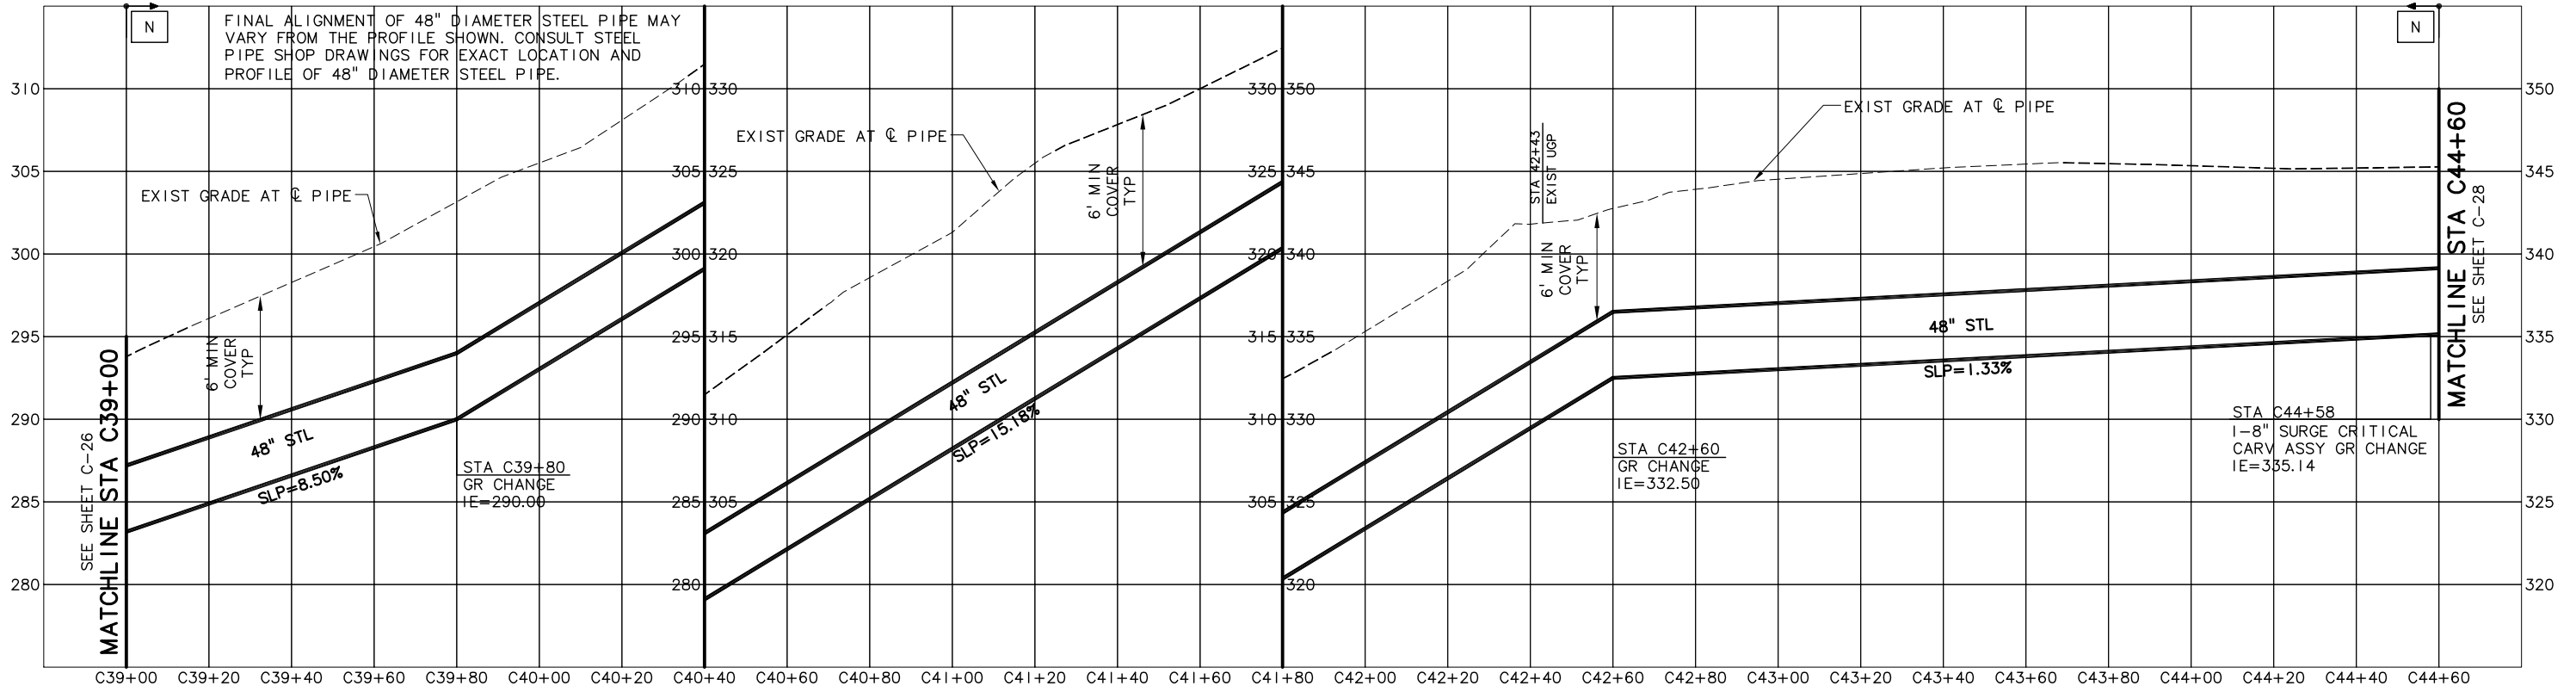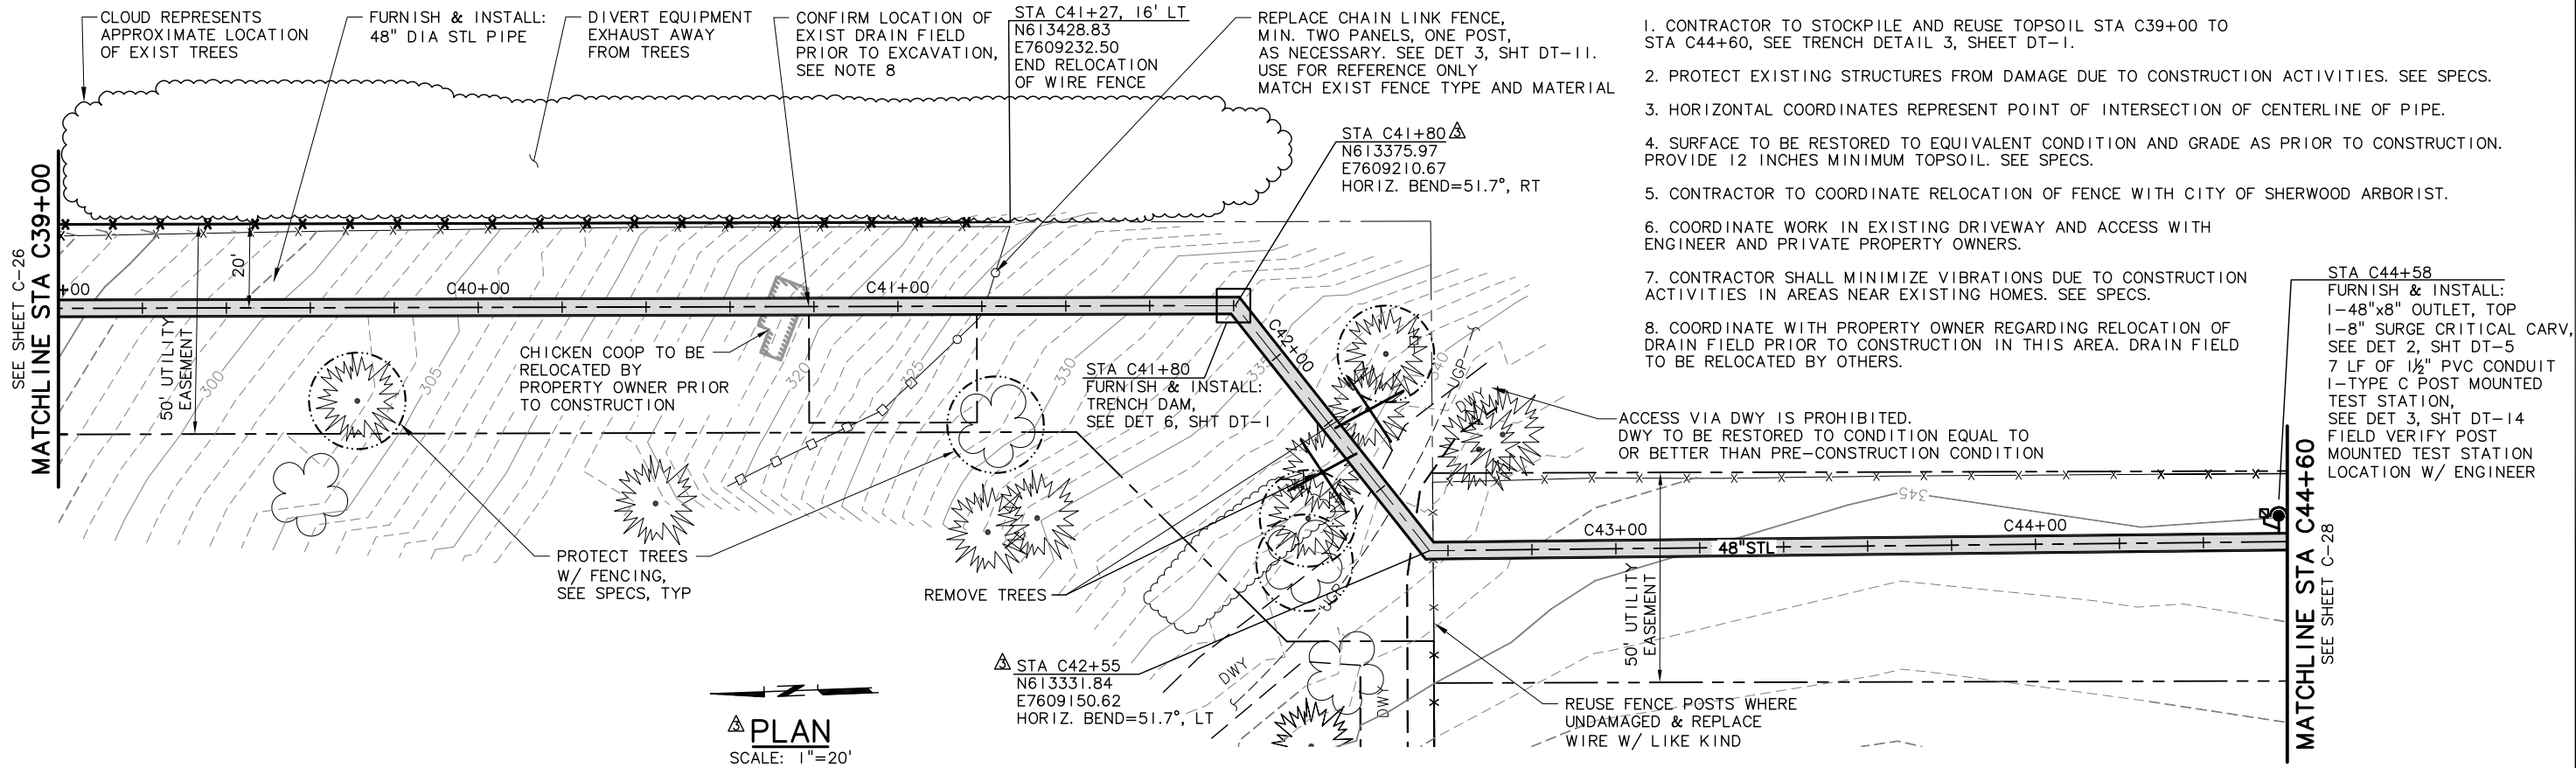

NO.	DATE	BY	REVISION
1	08/22/11	BVO	RECORD DRAWING

NOTICE

0 1/2 1

IF THIS BAR DOES NOT MEASURE 1" THEN DRAWING IS NOT TO SCALE

SMG DESIGNED
DAK DRAWN
MLH CHECKED

RECORD DRAWING

SEE DISCLAIMER, SHEET 1.

VERSION 4.1
12-9-97

MSA Murray Smith & Associates, Inc.
Engineers/Planners

121 S.W. Salmon, Suite 900 PHONE 503-225-9010
Portland, Oregon 97204 FAX 503-225-9022

City of Sherwood Oregon


WATER SUPPLY IMPROVEMENT PROJECT TRANSMISSION PIPELINE

WATERLINE SCHEDULE C PLAN AND PROFILE STA C39+00 TO STA C44+60


PROJECT NO.: 07-0873.207 SCALE: AS SHOWN DATE: JUNE 2009

SHEET
C-27
50 of 79

G:\PDX_Projects\07\0873\207 Design-Final Plans\CAD\07-0873-207-OR-CIVIL D-R.dwg C-29 9/6/2011 11:31 AM DAK 18.1s (LMS Tech)

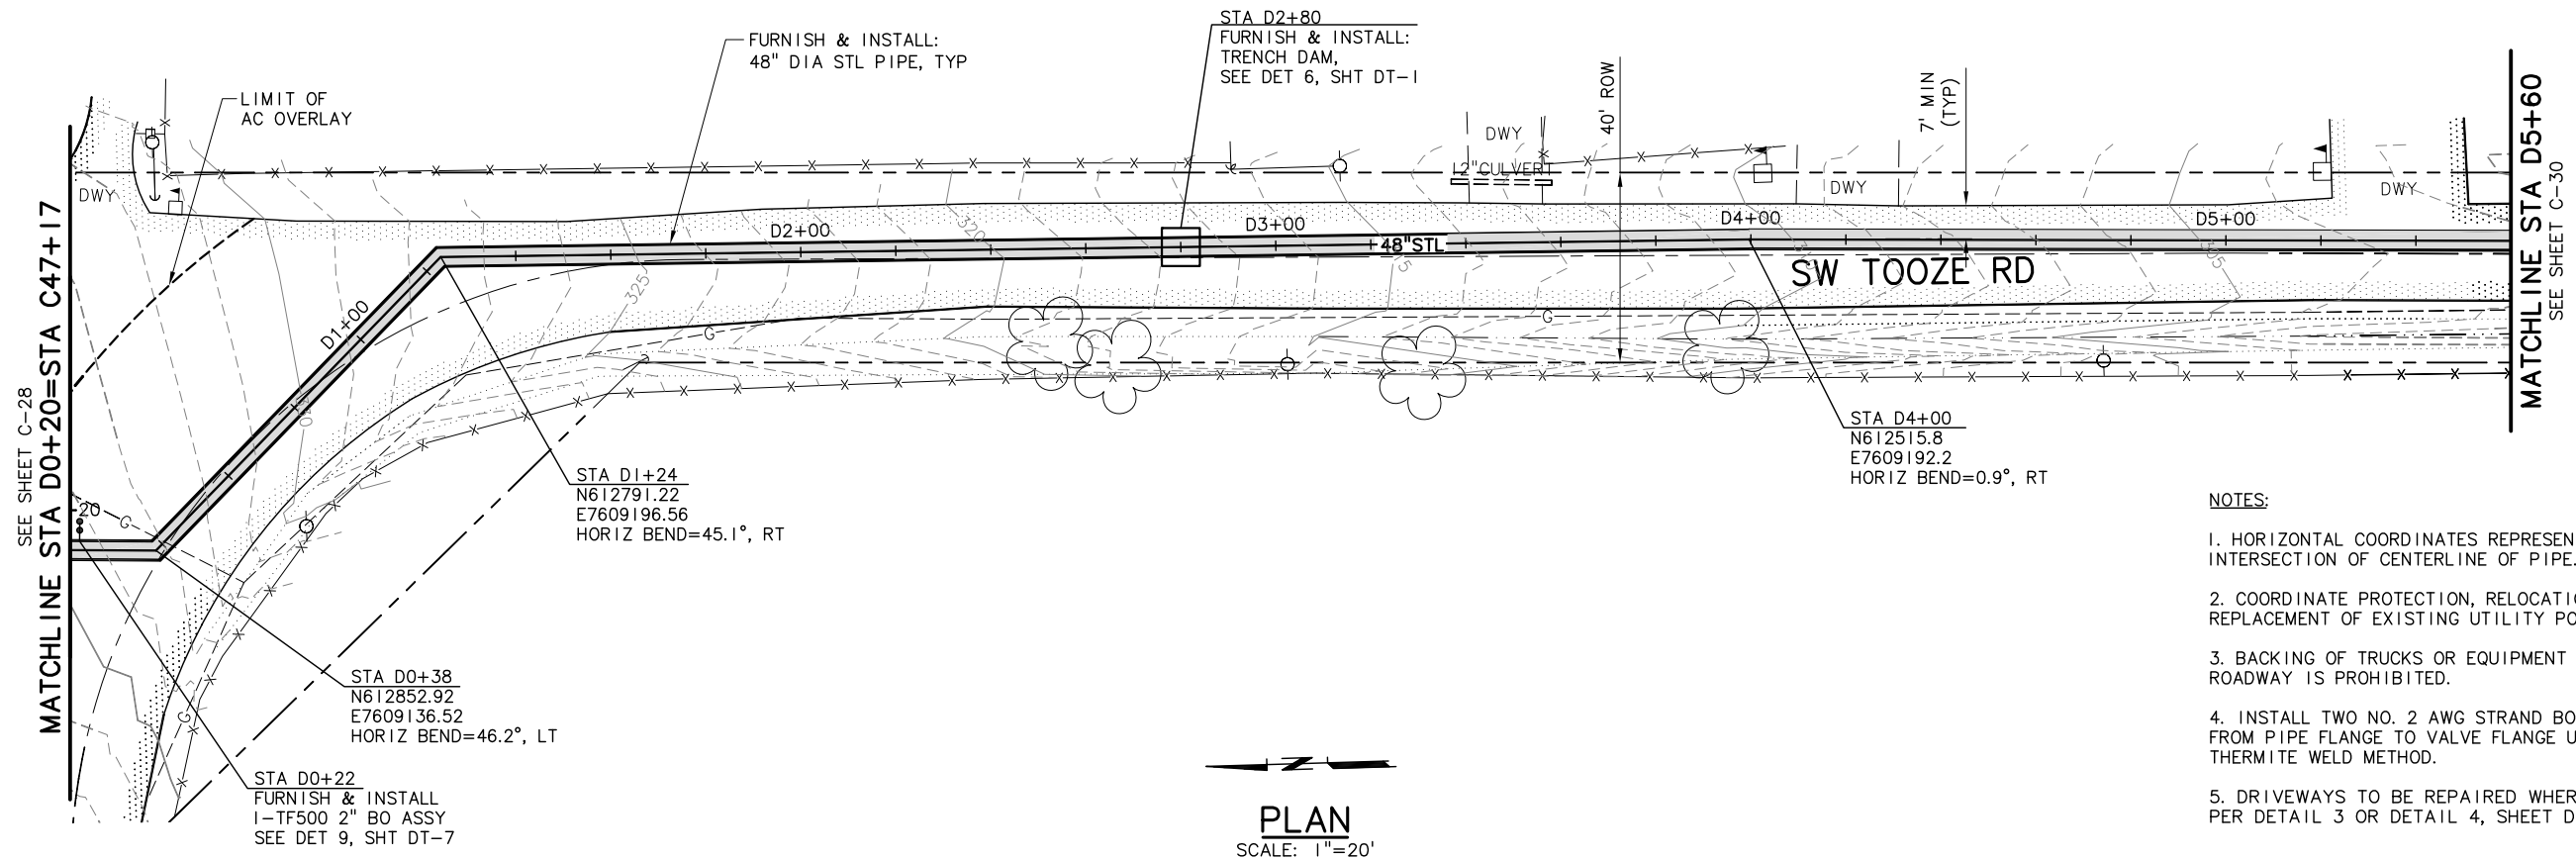

- NOTES:**
- HORIZONTAL COORDINATES REPRESENT POINT OF INTERSECTION OF CENTERLINE OF PIPE.
 - COORDINATE PROTECTION, RELOCATION OR REPLACEMENT OF EXISTING UTILITY POLE WITH PGE.
 - BACKING OF TRUCKS OR EQUIPMENT ONTO ROADWAY IS PROHIBITED.
 - INSTALL TWO NO. 2 AWG STRAND BOND WIRES FROM PIPE FLANGE TO VALVE FLANGE USING THE THERMITE WELD METHOD.
 - DRIVEWAYS TO BE REPAIRED WHERE NECESSARY PER DETAIL 3 OR DETAIL 4, SHEET DT-15.

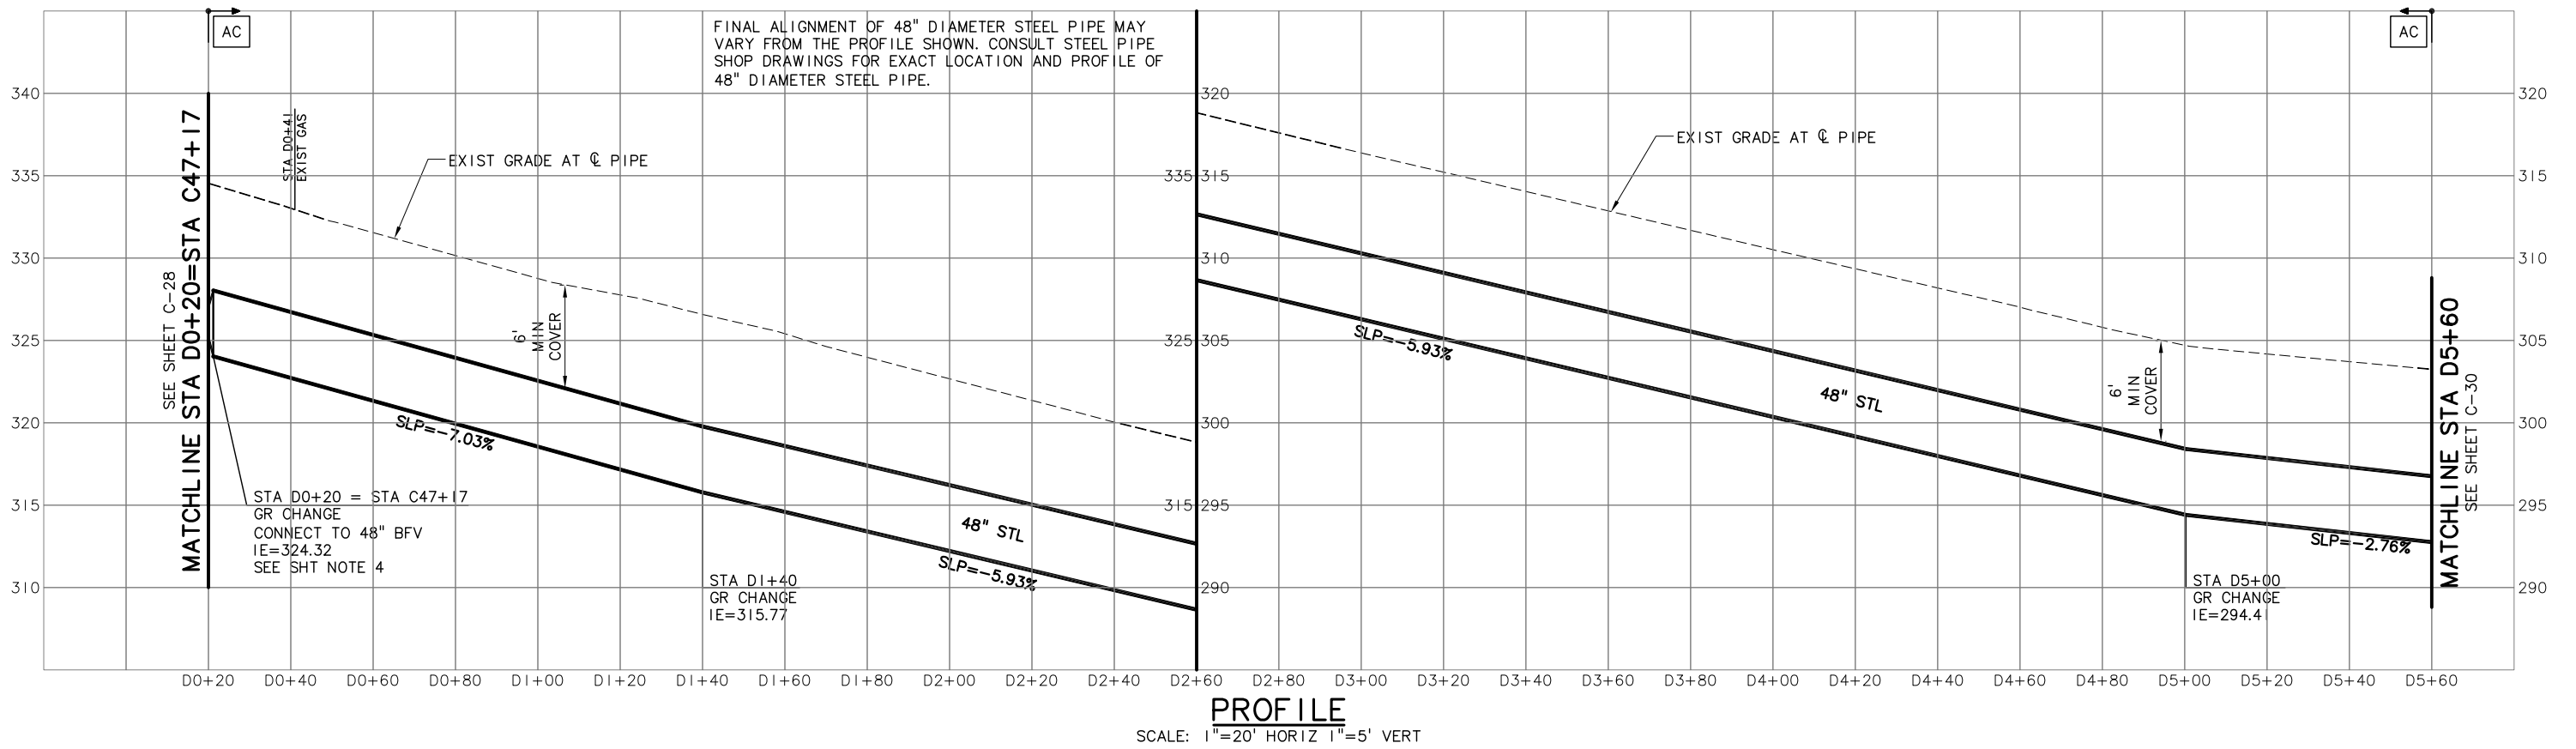

NO.	DATE	BY	REVISION
1	08/22/11	BVO	RECORD DRAWING

NOTICE

0 1/2 1

IF THIS BAR DOES NOT MEASURE 1" THEN DRAWING IS NOT TO SCALE

SMG DESIGNED
DAK DRAWN
MLH CHECKED

RECORD DRAWING

SEE DISCLAIMER, SHEET 1.

VERSION 4.1
12-9-97

MSA Murray Smith & Associates, Inc.
Engineers/Planners

121 S.W. Salmon, Suite 900
Portland, Oregon 97204

PHONE 503-225-9010
FAX 503-225-9022




WATER SUPPLY IMPROVEMENT PROJECT TRANSMISSION PIPELINE

WATERLINE SCHEDULE D PLAN AND PROFILE STA D0+20 TO STA D5+60


PROJECT NO.: 07-0873.207 SCALE: AS SHOWN DATE: JUNE 2009

NOTE:

I. DRIVEWAYS TO BE REPAIRED WHERE NECESSARY PER DETAIL 3 OR DETAIL 4, SHEET DT-15.

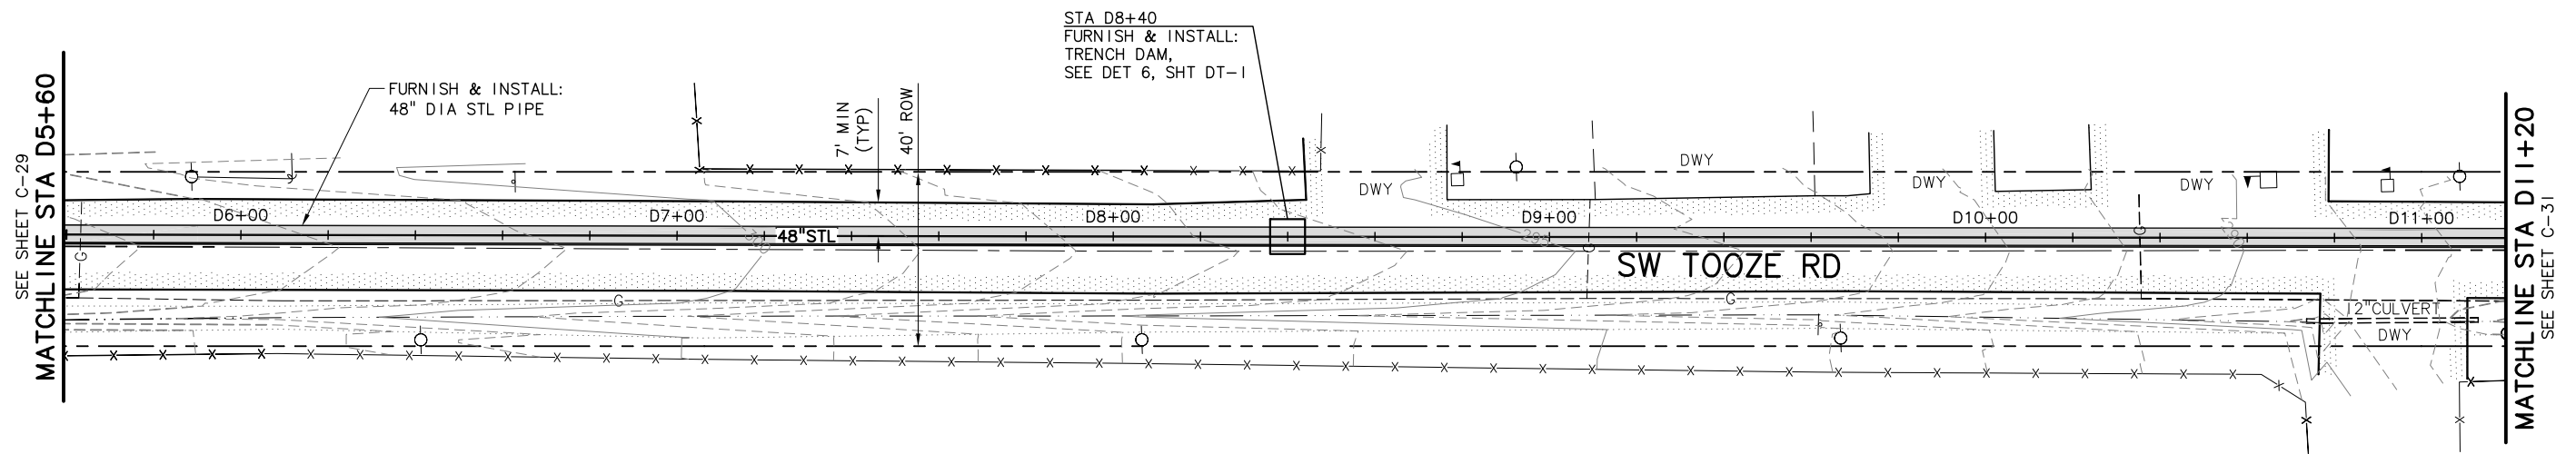

PLAN
SCALE: 1"=20'

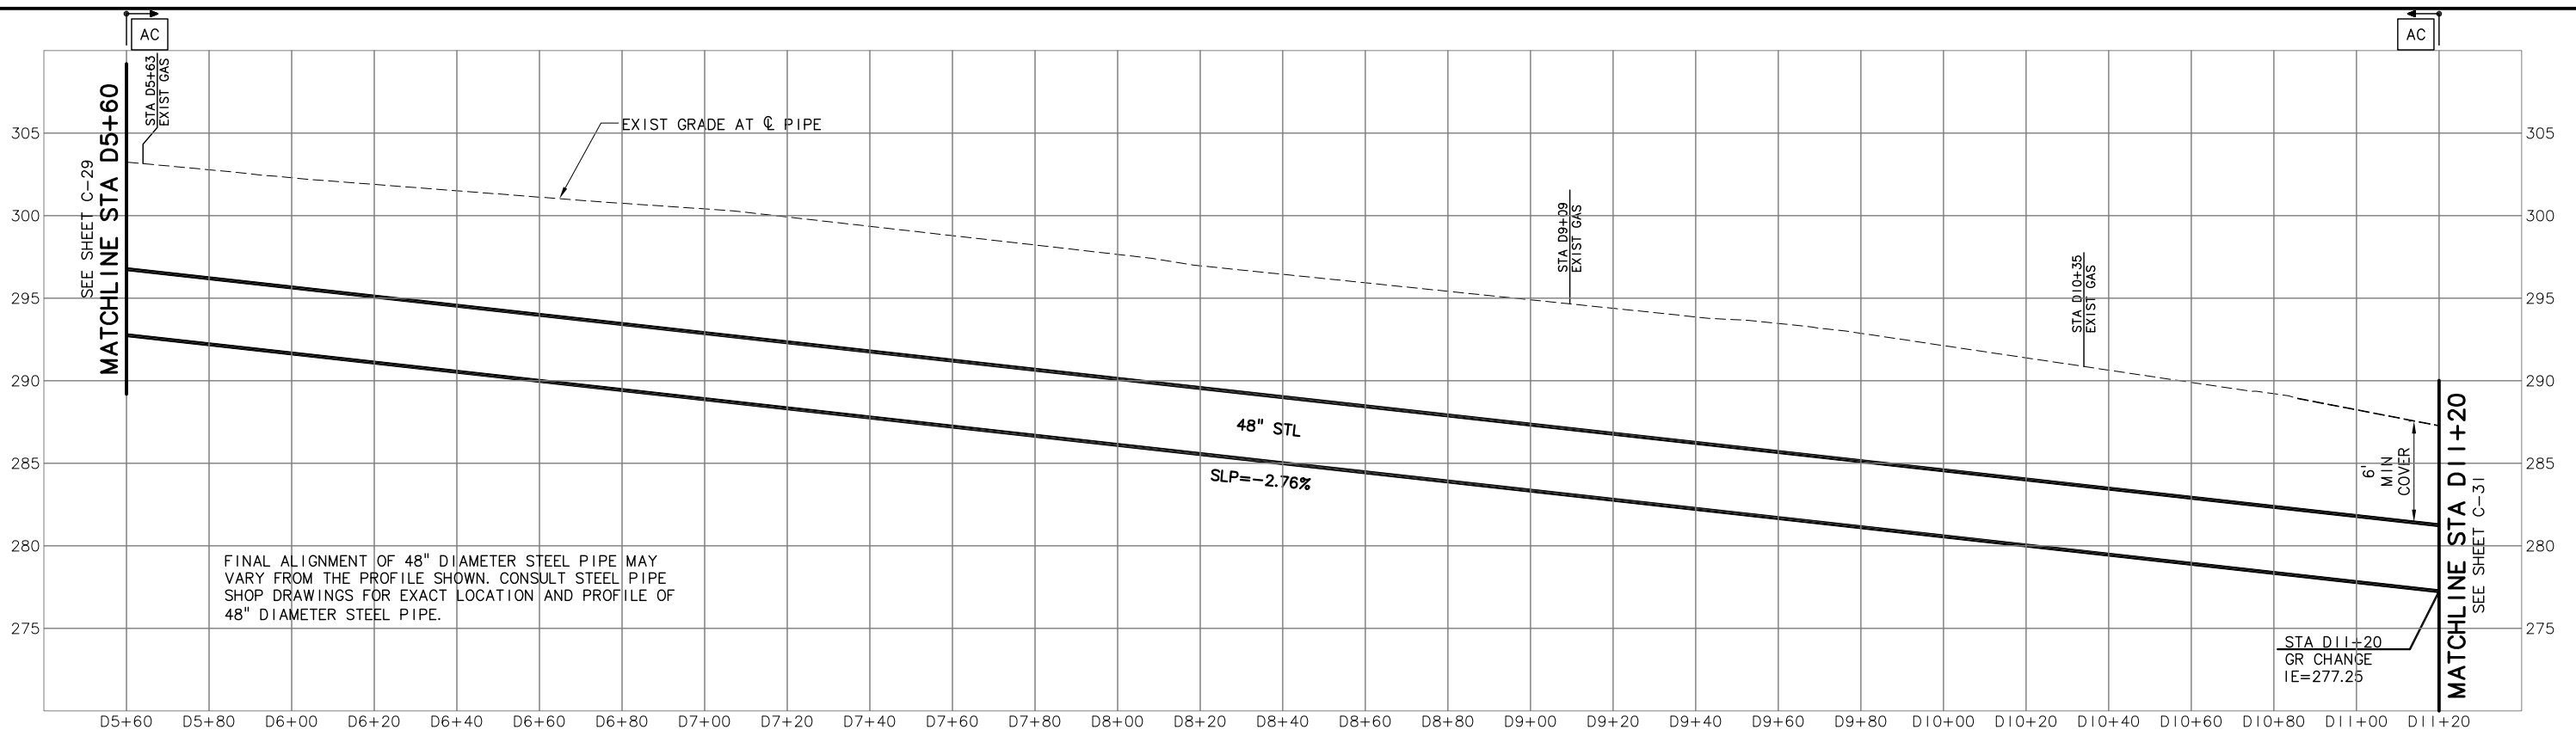

PROFILE
SCALE: 1"=20' HORIZ 1"=5' VERT

C:\PDX_Projects\07\0873\207 Design-Final Plans\CAD\DOR\07-0873-207-OR-CIVIL D-R.dwg C-30 9/6/2011 11:31 AM DAK 18.1s (LMS Tech)

NO.	DATE	BY	REVISION
1	08/22/11	BVO	RECORD DRAWING

NOTICE

0 1/2 1

IF THIS BAR DOES NOT MEASURE 1" THEN DRAWING IS NOT TO SCALE

SMG DESIGNED
DAK DRAWN
MLH CHECKED

RECORD DRAWING

SEE DISCLAIMER, SHEET 1.

VERSION 4.1
12-9-97

MSA Murray Smith & Associates, Inc.
Engineers/Planners

121 S.W. Salmon, Suite 900 PHONE 503-225-9010
Portland, Oregon 97204 FAX 503-225-9022

City of Sherwood Oregon

WATER SUPPLY IMPROVEMENT PROJECT TRANSMISSION PIPELINE

WATERLINE SCHEDULE D PLAN AND PROFILE

STA D5+60 TO STA D11+20


PROJECT NO.: 07-0873.207 SCALE: AS SHOWN DATE: JUNE 2009

SHEET

C-30


53 of 79

C:\PDX_Projects\07\0873\207 Design-Final Plans\CAD\07-0873-207-OR-CIVIL D-R.dwg C-31 9/6/2011 11:31 AM DAK 18.1s (LMS Tech)

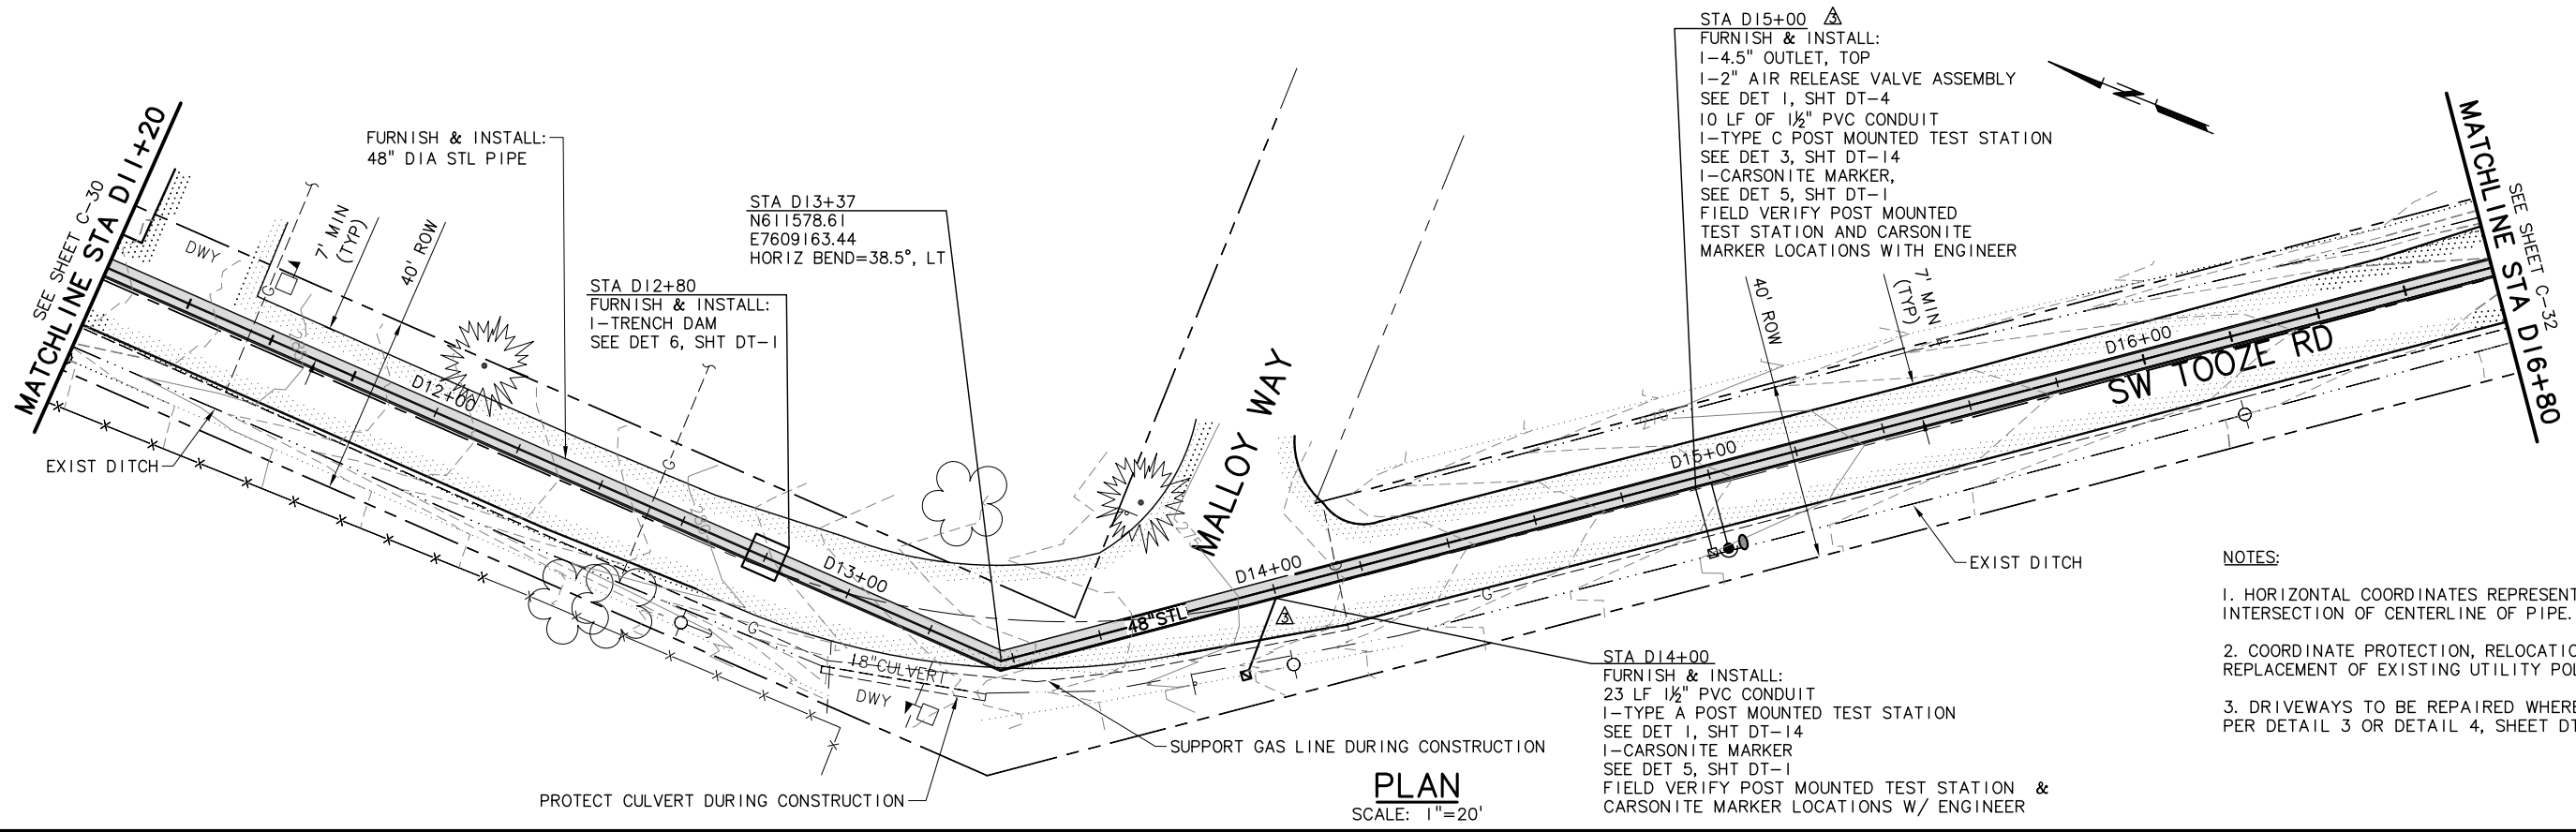

PLAN
SCALE: 1"=20'

- NOTES:**
1. HORIZONTAL COORDINATES REPRESENT POINT OF INTERSECTION OF CENTERLINE OF PIPE.
 2. COORDINATE PROTECTION, RELOCATION OR REPLACEMENT OF EXISTING UTILITY POLE WITH PGE.
 3. DRIVEWAYS TO BE REPAIRED WHERE NECESSARY PER DETAIL 3 OR DETAIL 4, SHEET DT-15.

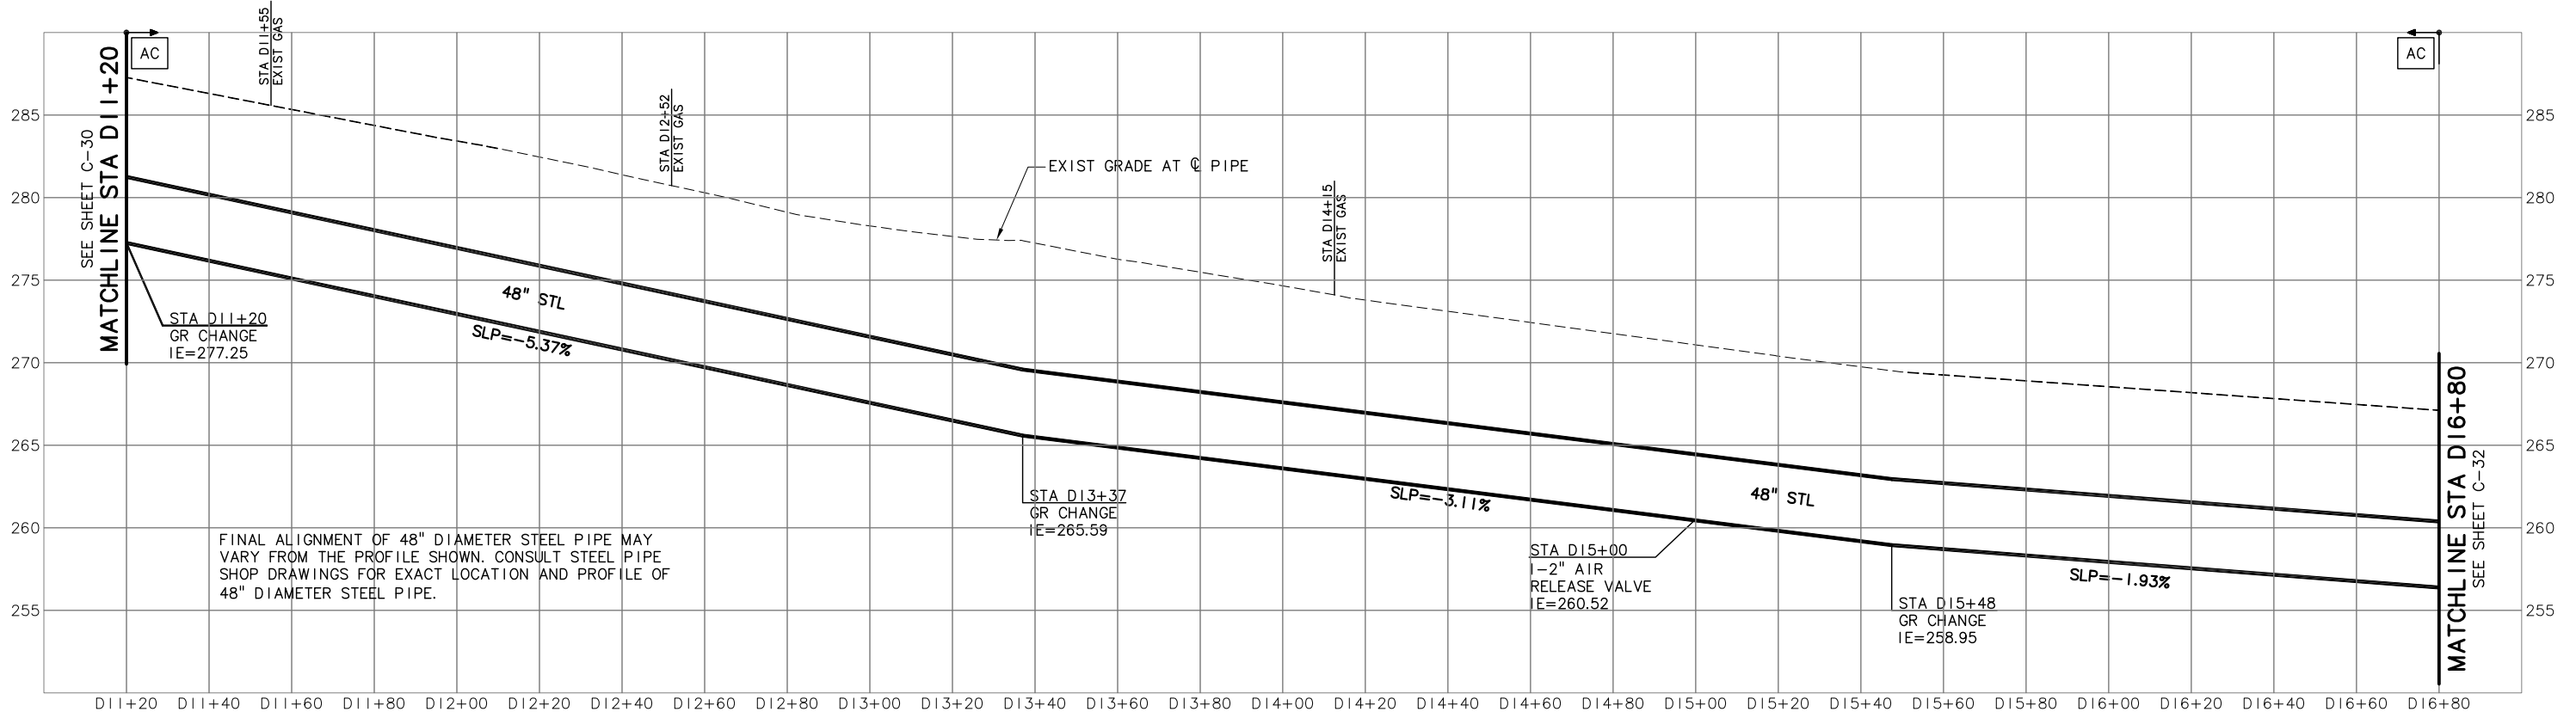

PROFILE
SCALE: 1"=20' HORIZ 1"=5' VERT

NO.	DATE	BY	REVISION
1	08/22/11	BVO	RECORD DRAWING

NOTICE

0 1/2 1

IF THIS BAR DOES NOT MEASURE 1" THEN DRAWING IS NOT TO SCALE

SMG DESIGNED
DAK DRAWN
MLH CHECKED

RECORD DRAWING

SEE DISCLAIMER, SHEET 1.

VERSION 4.1
12-9-97

MSA Murray Smith & Associates, Inc.
Engineers/Planners

121 S.W. Salmon, Suite 900 PHONE 503-225-9010
Portland, Oregon 97204 FAX 503-225-9022




WATER SUPPLY IMPROVEMENT PROJECT TRANSMISSION PIPELINE

**WATERLINE SCHEDULE D
PLAN AND PROFILE
STA D11+20 TO STA D16+80**


PROJECT NO.: 07-0873.207 SCALE: AS SHOWN DATE: JUNE 2009

NOTES:

1. HORIZONTAL COORDINATES REPRESENT POINT OF INTERSECTION OF CENTERLINE OF PIPE.
2. COORDINATE PROTECTION, RELOCATION OR REPLACEMENT OF EXISTING UTILITY POLE WITH PGE.
3. DRIVEWAYS TO BE REPAIRED WHERE NECESSARY PER DETAIL 3 OR DETAIL 4, SHEET DT-15.

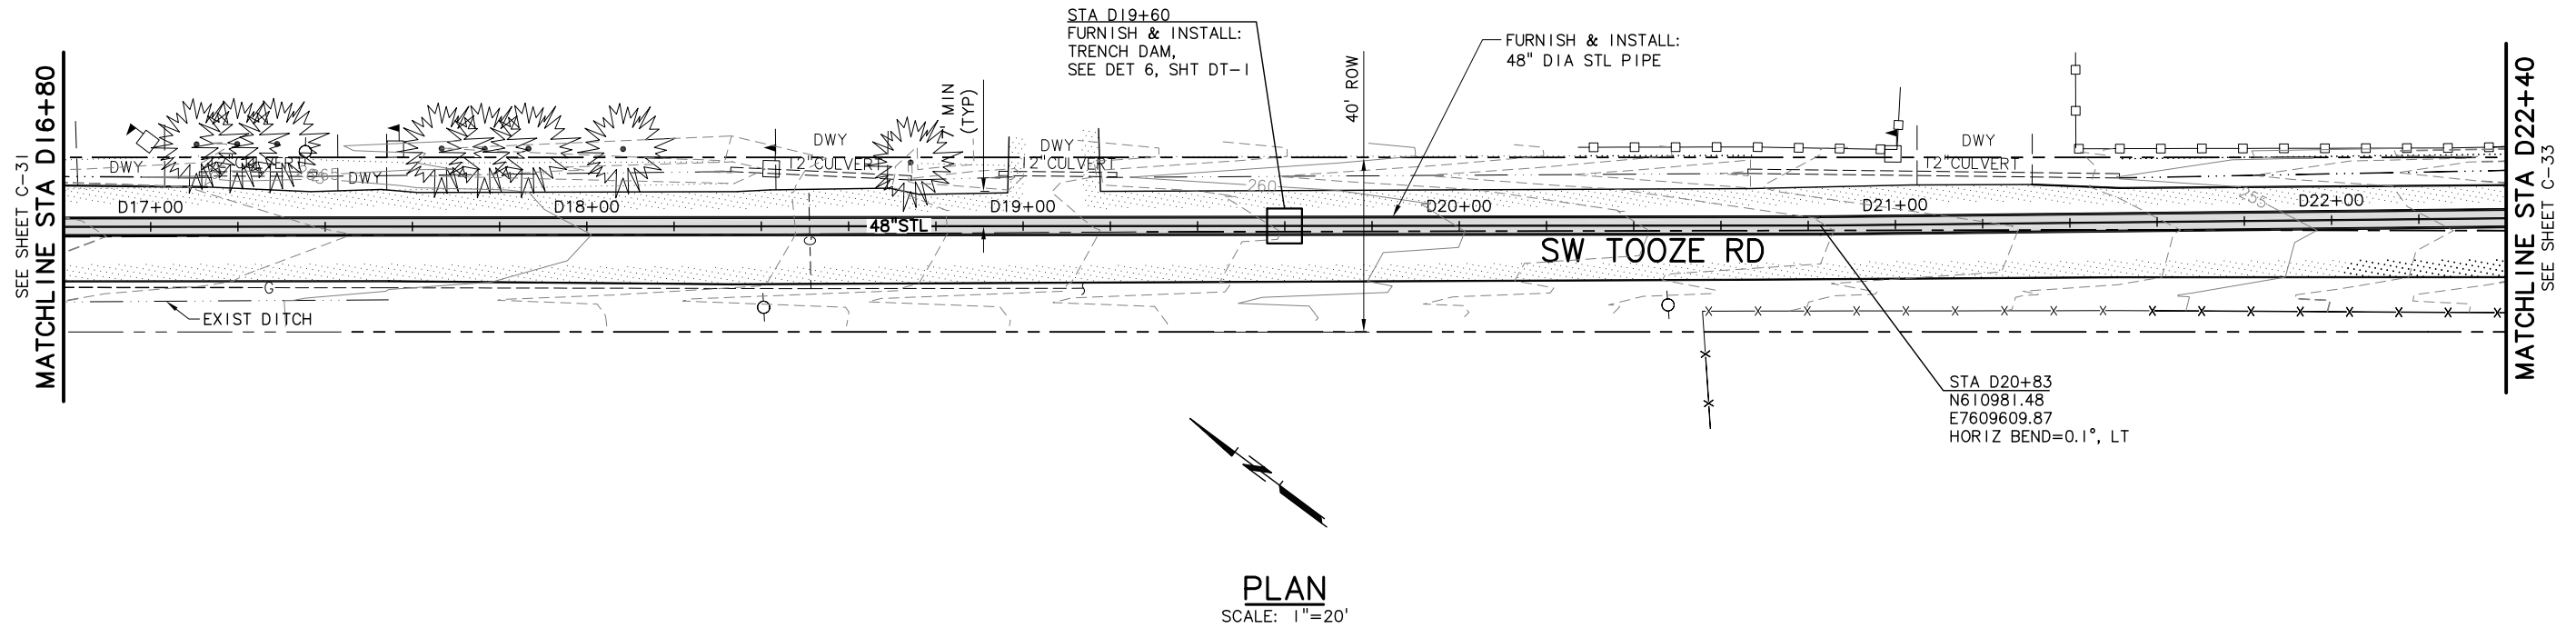

PLAN
SCALE: 1"=20'

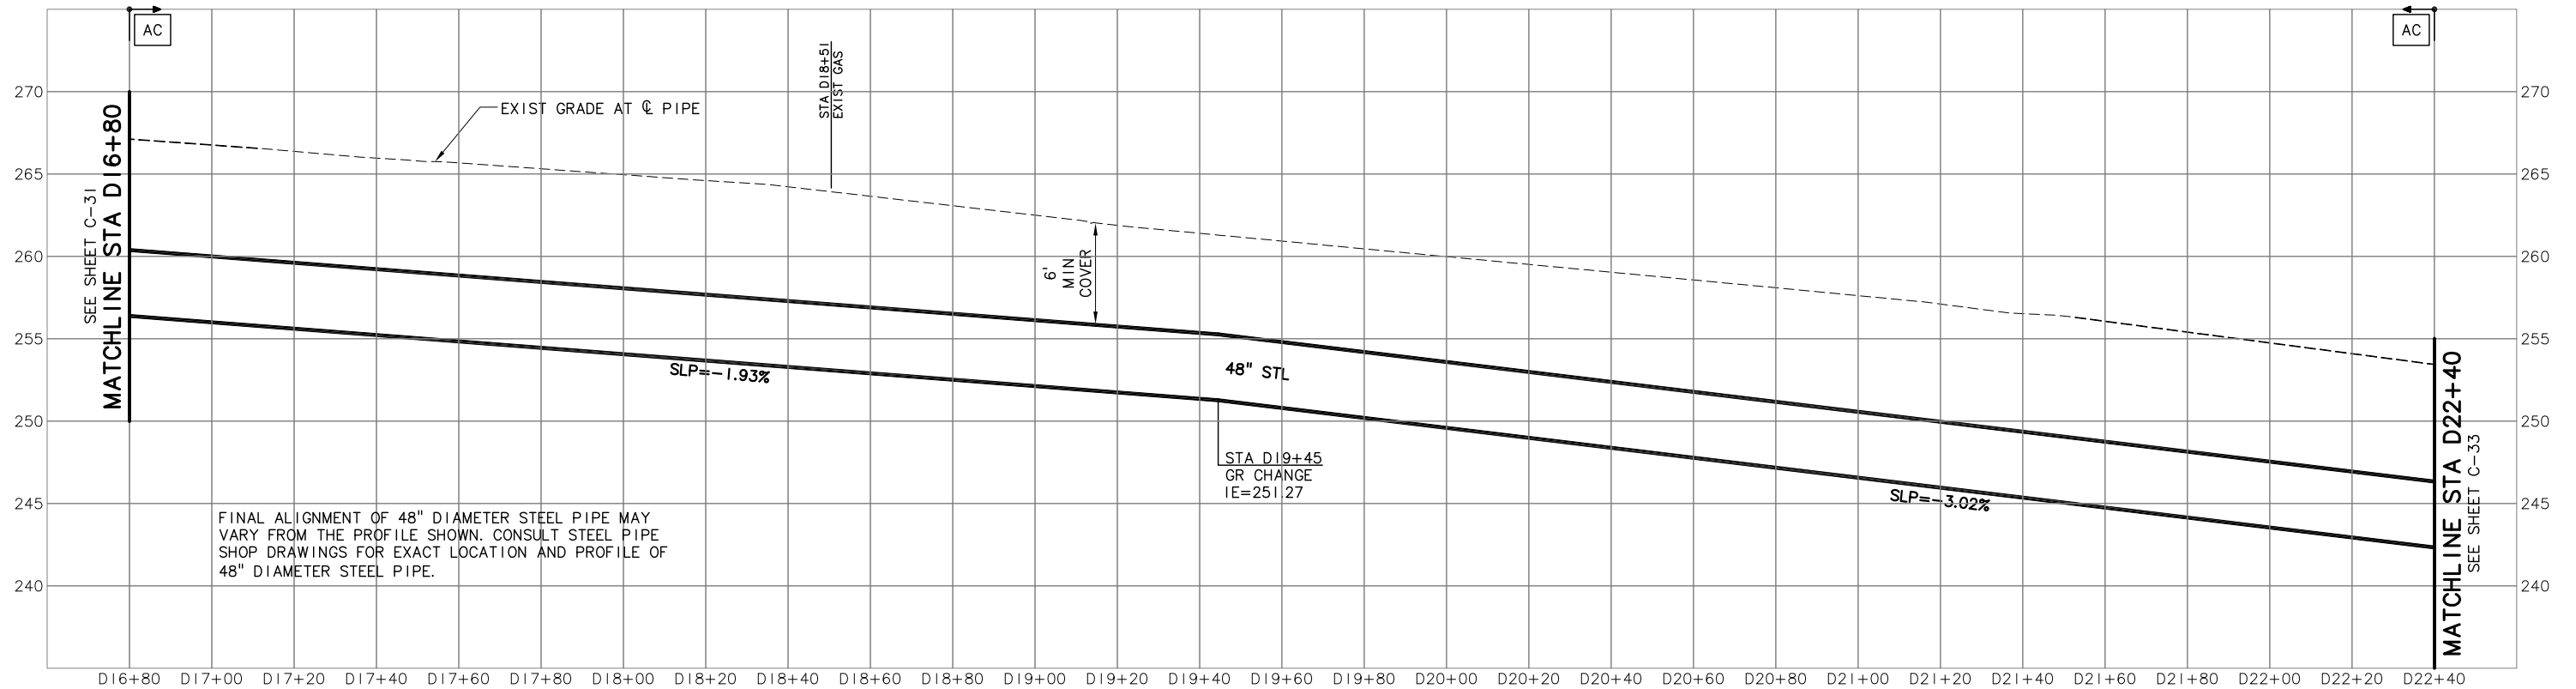

PROFILE
SCALE: 1"=20' HORIZ 1"=5' VERT

C:\PDX_Projects\07\0873\207 Design-Final Plans\CAD\DOR\07-0873-207-OR-CIVIL D-R.dwg C-32 9/6/2011 11:31 AM DAK 18.1s (LMS Tech)

NO.	DATE	BY	REVISION
1	08/22/11	BVO	RECORD DRAWING

NOTICE

0 1/2 1

IF THIS BAR DOES NOT MEASURE 1" THEN DRAWING IS NOT TO SCALE

SMG DESIGNED
DAK DRAWN
MLH CHECKED

RECORD DRAWING

SEE DISCLAIMER, SHEET 1.

VERSION 4.1
12-9-97

MSA Murray Smith & Associates, Inc.
Engineers/Planners

121 S.W. Salmon, Suite 900 PHONE 503-225-9010
Portland, Oregon 97204 FAX 503-225-9022



WATER SUPPLY IMPROVEMENT PROJECT TRANSMISSION PIPELINE



WATERLINE SCHEDULE D PLAN AND PROFILE STA D16+80 TO STA D22+40

PROJECT NO.: 07-0873.207 SCALE: AS SHOWN DATE: JUNE 2009

SHEET
C-32
55 of 79

NOTES:

1. HORIZONTAL COORDINATES REPRESENT POINT OF INTERSECTION OF CENTERLINE OF PIPE.
2. COORDINATE PROTECTION, RELOCATION OR REPLACEMENT OF EXISTING UTILITY POLE WITH PGE.
3. DRIVEWAYS TO BE REPAIRED WHERE NECESSARY PER DETAIL 3 OR DETAIL 4, SHEET DT-15.

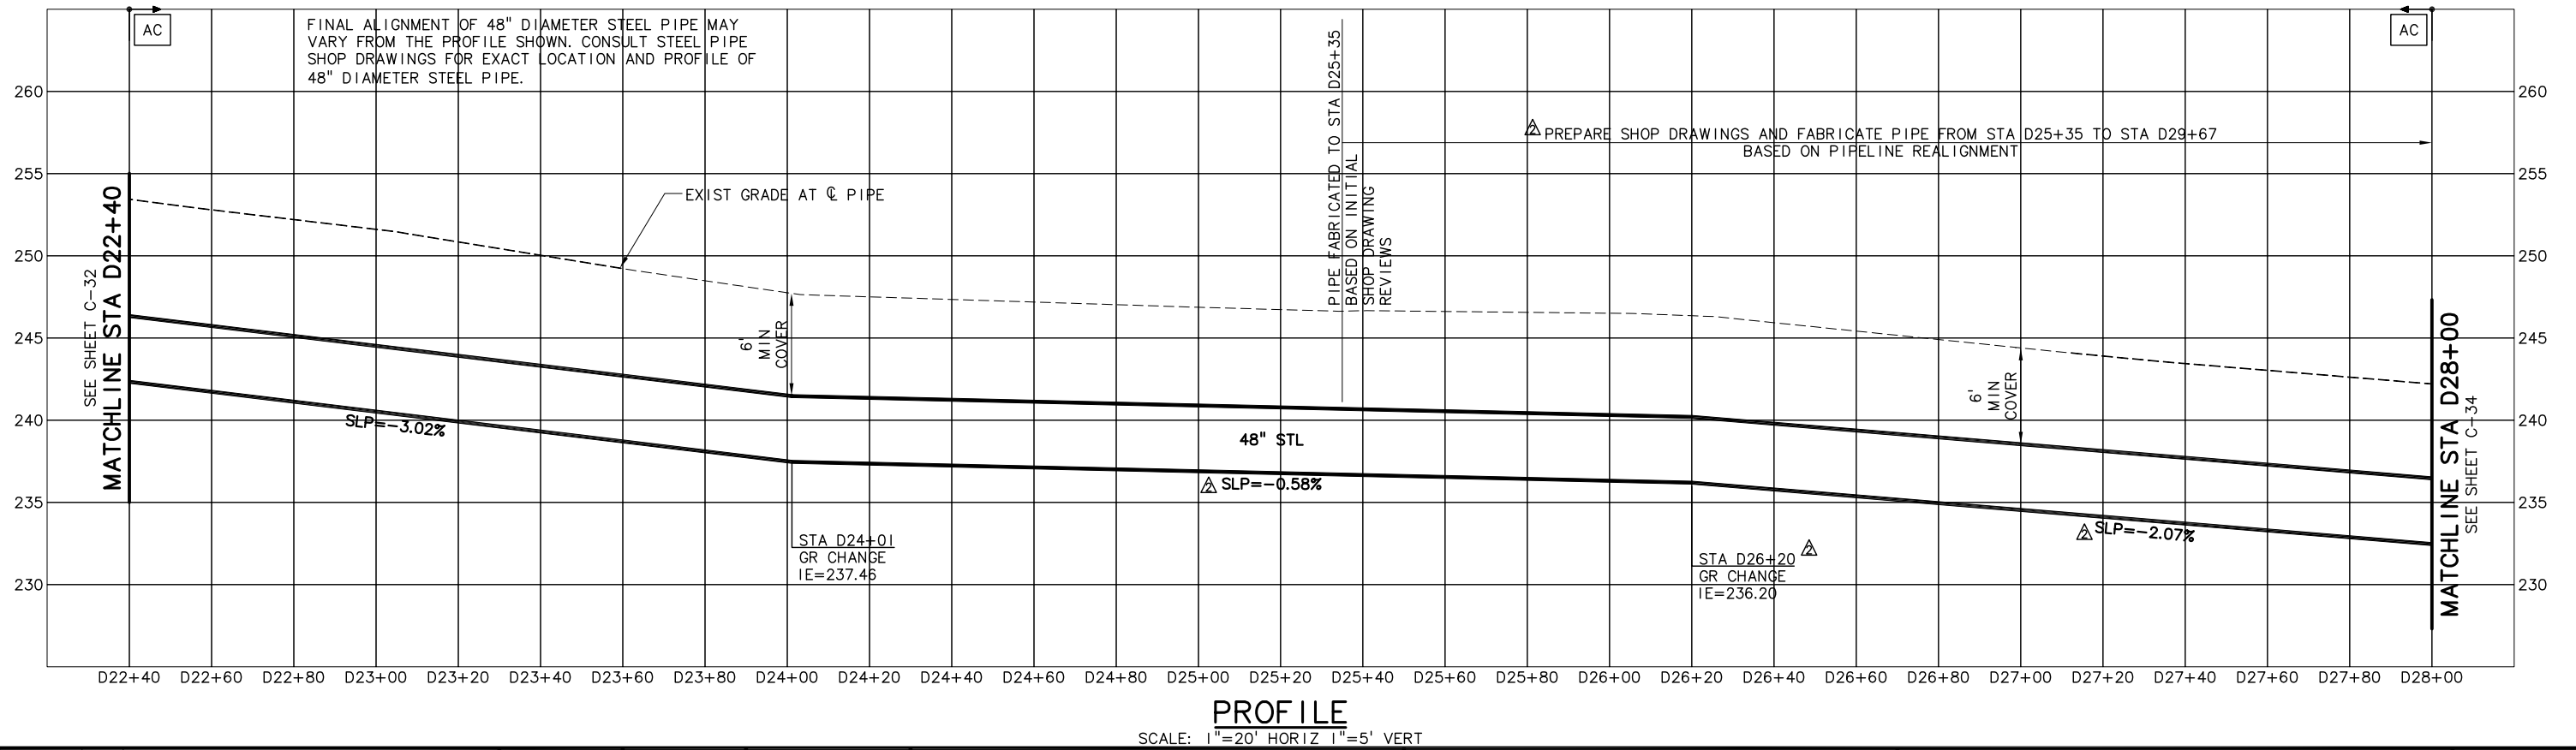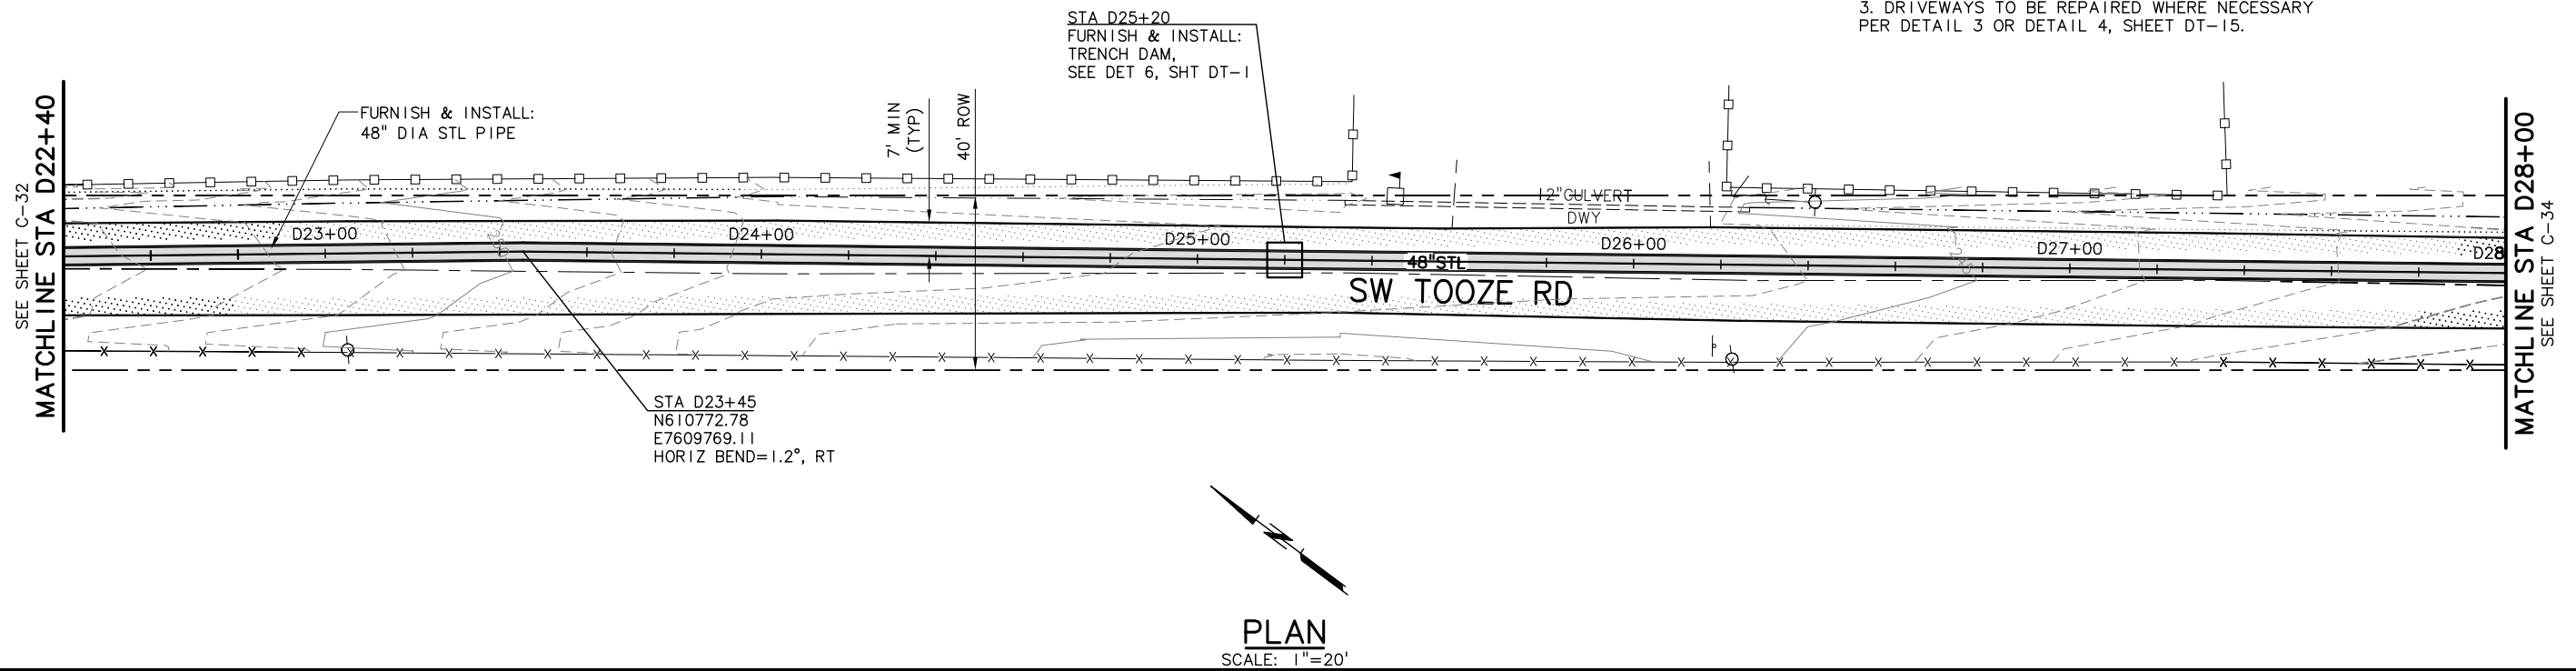

C:\Users\dak\AppData\local\temp\AcPublish_6152\07-0873-207-OR-C33-C34-R.dwg C-33 9/2/2011 12:00 PM DAK 18.1s (LMS Tech)

NO.	DATE	BY	REVISION
1	08/22/11	BVO	RECORD DRAWING
2	07/23/10	SMG	REVISED 48" PIPE ALIGNMENT

NOTICE

0 1/2 1

IF THIS BAR DOES NOT MEASURE 1" THEN DRAWING IS NOT TO SCALE

SMG DESIGNED
DAK DRAWN
MLH CHECKED

RECORD DRAWING

SEE DISCLAIMER, SHEET 1.

VERSION 4.1
12-9-97

MSA Murray Smith & Associates, Inc.
Engineers/Planners

121 S.W. Salmon, Suite 900 PHONE 503-225-9010
Portland, Oregon 97204 FAX 503-225-9022




WATER SUPPLY IMPROVEMENT PROJECT TRANSMISSION PIPELINE

WATERLINE SCHEDULE D PLAN AND PROFILE STA D22+40 TO STA D28+00

PROJECT NO.: 07-0873.207 SCALE: AS SHOWN DATE: JUNE 2009


SHEET
C-33
56 of 79

C:\PDX-Projects\07\0873\207-Design-Final_Plans\CAD\DOR\07-0873-207-OR-C33-C34-R.dwg C-34 9/8/2011 10:55 AM DAK 18.1s (LMS Tech)

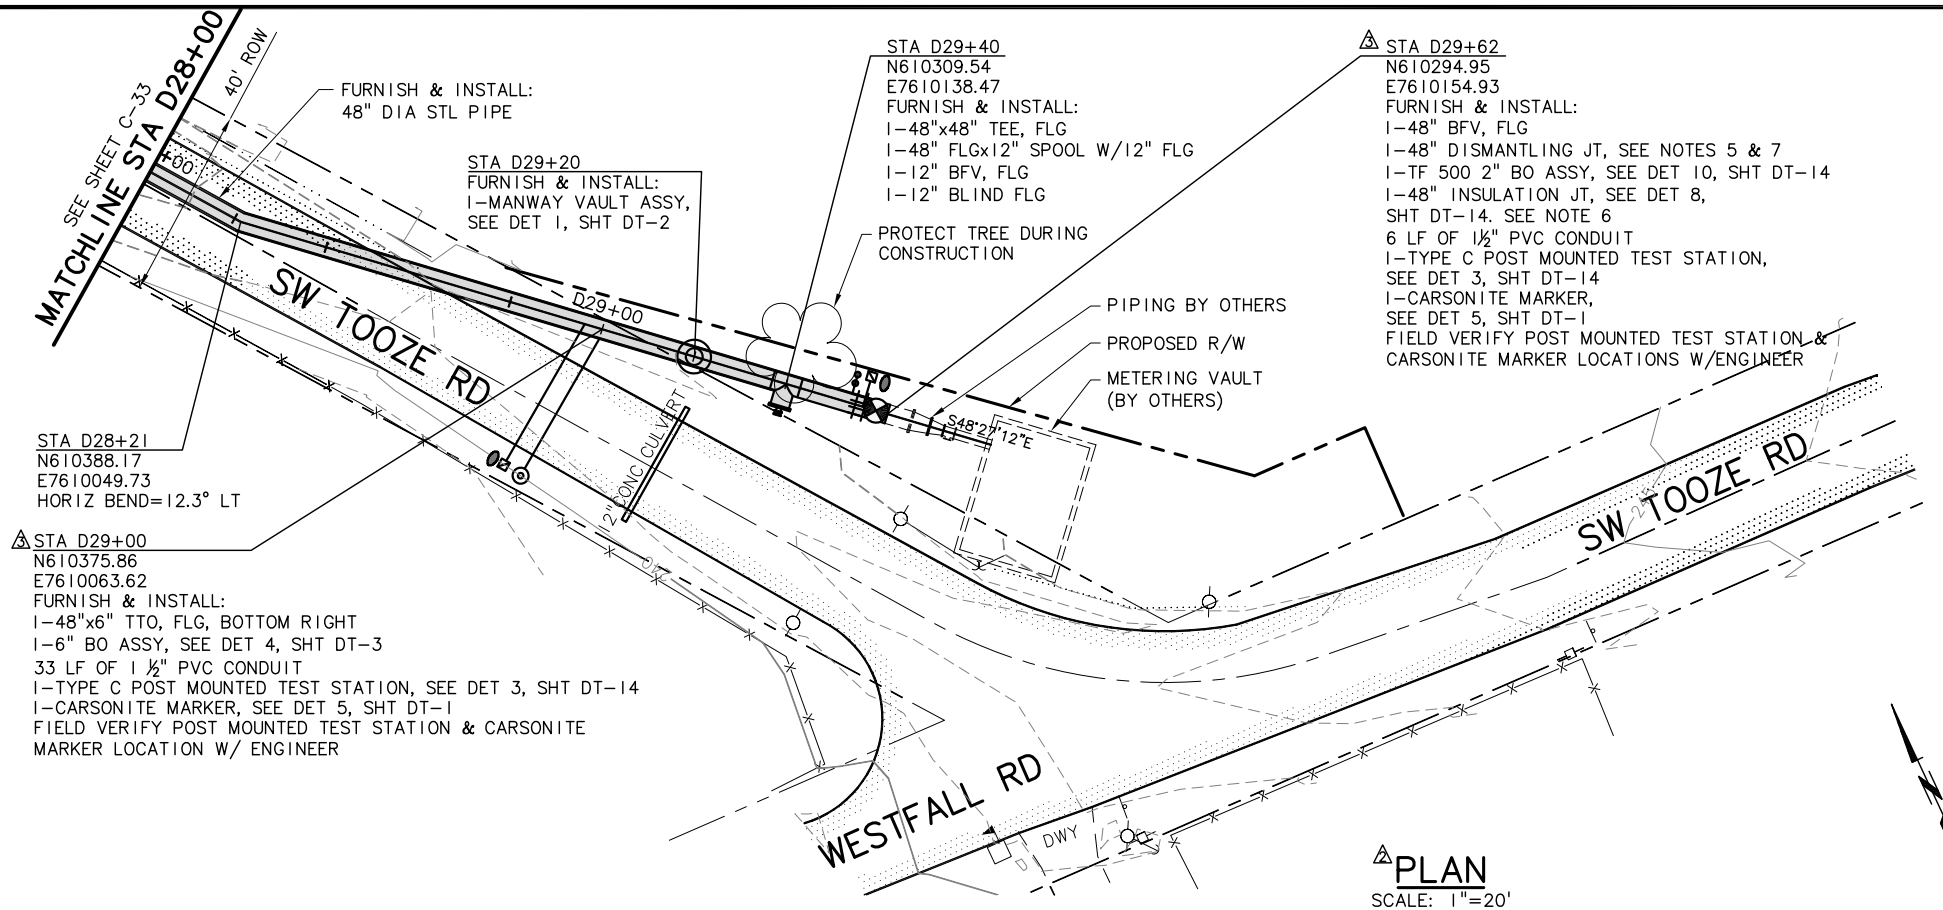

- NOTES:**
1. CONTRACTOR TO POTHOLE AND VERIFY DEPTH AND LOCATION PRIOR TO CONSTRUCTION.
 2. ALL DUCTILE IRON FITTINGS TO BE RESTRAINED UNLESS OTHERWISE SHOWN.
 3. HORIZONTAL COORDINATES REPRESENT POINT OF INTERSECTION OF CENTERLINE OF PIPE.
 4. NOT USED.
 5. FURNISH & INSTALL TWO NO. 2 AWG STRAND BOND WIRES FROM PIPE FLANGE TO VALVE/JOINT FLANGE USING THE THERMITE WELD METHOD.
 6. TAPE ISOLATION JOINT WITH 40 MIL POLYKEN TAPE, OR EQUAL. OVERLAP PER MANUFACTURER'S RECOMMENDATION.
 7. WRAP WITH 2 LAYERS OF 8 MIL POLYETHELENE.
 8. COORDINATE PIPE CONNECTION PLANS WITH FINAL 48-INCH PIPE INSTALLATION SOUTHEAST OF STATION D29+67, BY OTHERS.

PLAN
SCALE: 1"=20'

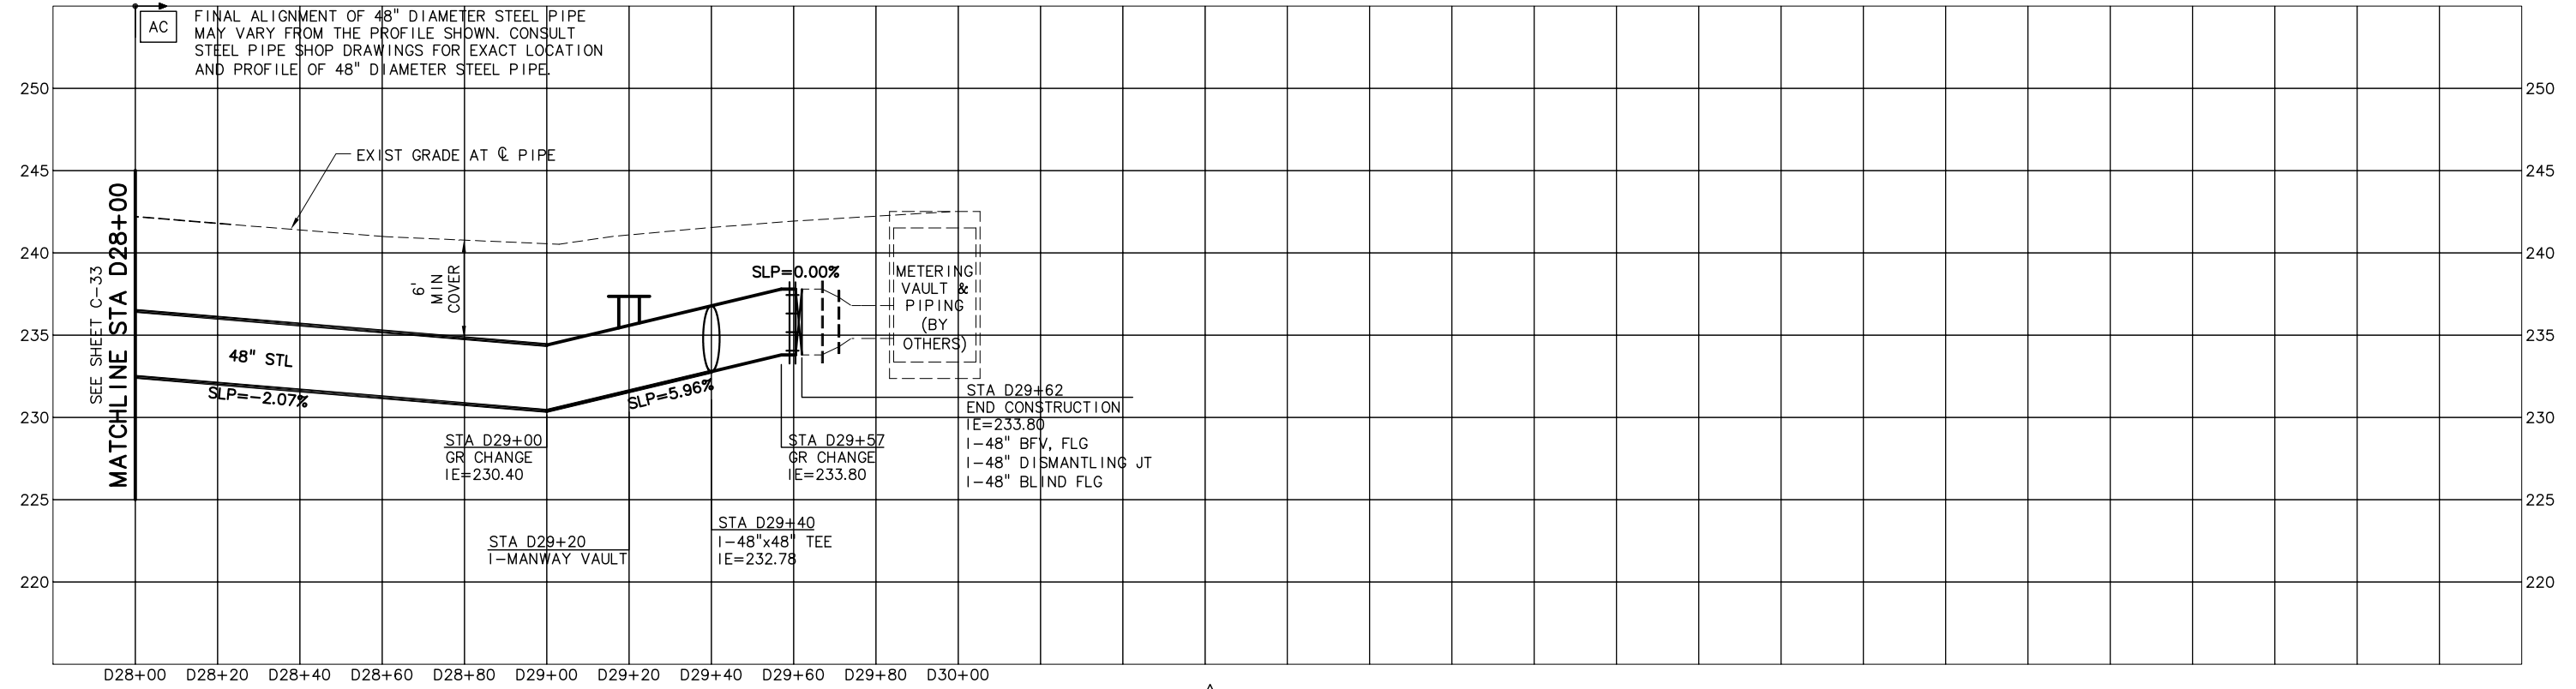

PROFILE
SCALE: 1"=20' HORIZ 1"=5' VERT

NO.	DATE	BY	REVISION
1	08/22/11	BVO	RECORD DRAWING
2	07/23/10	SMG	REVISED 48" PIPE ALIGNMENT

NOTICE

0 1/2 1

IF THIS BAR DOES NOT MEASURE 1" THEN DRAWING IS NOT TO SCALE

SMG DESIGNED
DAK DRAWN
MLH CHECKED

RECORD DRAWING

SEE DISCLAIMER, SHEET 1.

VERSION 4.1
12-9-97

MSA Murray Smith & Associates, Inc.
Engineers/Planners

121 S.W. Salmon, Suite 900
Portland, Oregon 97204


PHONE 503-225-9010
FAX 503-225-9022

City of Sherwood Oregon

WATER SUPPLY IMPROVEMENT PROJECT TRANSMISSION PIPELINE

**WATERLINE SCHEDULE D
PLAN AND PROFILE
STA D28+00 TO STA D29+62**


PROJECT NO.: 07-0873.207 SCALE: AS SHOWN DATE: JUNE 2009

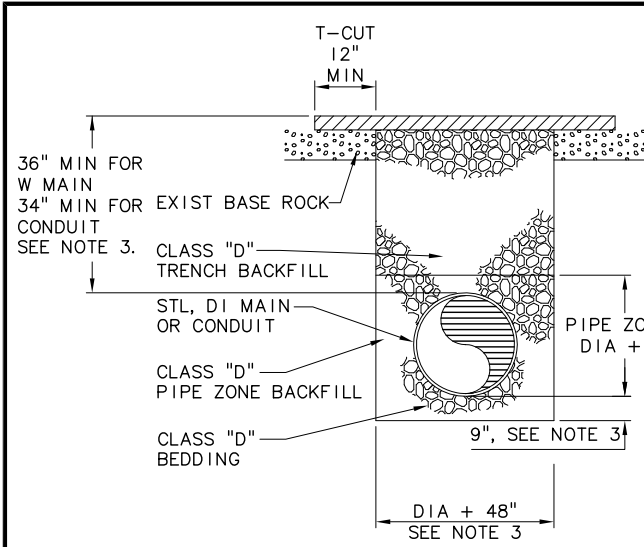

NOTES:

1. REPLACE REMOVED ASPHALT W/ A MIN OF 4" LEVEL 2 AC OR EXIST PAVEMENT DEPTH WHICHEVER IS GREATER.
2. FURNISH & INSTALL CLASS "D" BEDDING, PIPE ZONE & TRENCH BACKFILL, TO PAVEMENT BASE. COMPACT MATERIAL IN LIFTS TO ACHIEVE 95% OF MAX DENSITY IN ACCORDANCE W/ AASHTO T-180.
3. FOR ALL PIPES AND CONDUITS OTHER THAN 48 INCH DIAMETER STEEL PIPE, TRENCH WIDTH IS DIA + 24 INCHES AND BEDDING IS 6 INCHES.
4. MIN AC REPLACEMENT WIDTH IS 3'-0".
5. WHERE CONSTRUCTION IMPACTS ROAD SHOULDER, REGRADE TO MATCH EXIST.


PIPE TRENCH DETAIL - IN ROADWAY (1)
SCALE: NTS

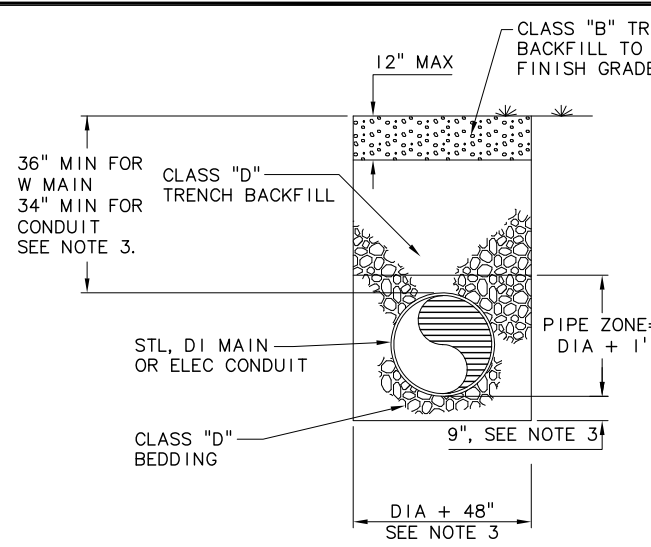

NOTES:

1. NON AC SURFACES SHALL BE RESURFACED TO MATCH EXIST FOR GRAVEL RESURFACING, SEE SPECS. REPLACE TOPSOIL AND BACKFILL W/ CLASS "B" NATIVE MATERIAL. FINISH TRENCH SURFACE TO MATCH ORIGINAL CONTOURS. REPLACE EXIST LANDSCAPING.
2. FURNISH AND INSTALL CLASS "D" BEDDING AND PIPE ZONE BACKFILL COMPACTED TO 95% OF MAX. DENSITY PER AASHTO T-180. FURNISH AND INSTALL CLASS "B" NATIVE TRENCH BACKFILL TO FINISH GRADE COMPACTED TO 95% MAX DENSITY PER AASHTO T-180.
3. FOR ALL PIPES AND CONDUITS OTHER THAN 48 INCH DIAMETER STEEL PIPE, TRENCH WIDTH IS DIAMETER + 24 INCHES AND BEDDING DEPTH IS 6- INCHES.
4. MIN AC REPLACEMENT WIDTH IS 3'-0".


PIPE TRENCH DETAIL - OUTSIDE OF ROADWAY (2)
SCALE: NTS

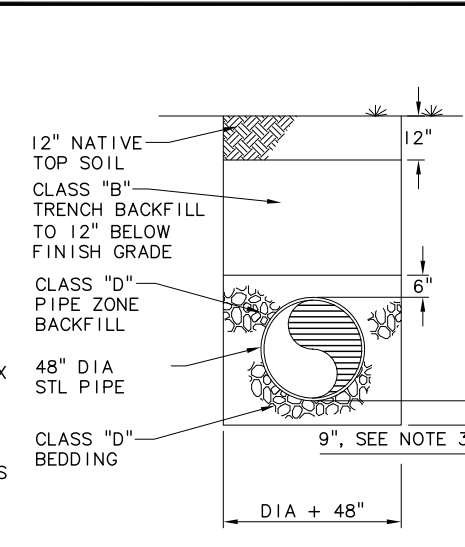

NOTES:

1. STOCKPILE AND REUSE TOPSOIL. SEE 02900, PLANTING, AND 01100, SPECIAL PROVISIONS, FOR ADDITIONAL REQMTS WITHIN THE AGRICULTURAL AREAS.
2. FURNISH AND INSTALL CLASS "D" BEDDING AND PIPE ZONE BACKFILL COMPACTED TO 95% OF MAX DENSITY PER AASHTO T-180. FURNISH AND INSTALL CLASS "B" NATIVE TRENCH BACKFILL TO 12" BELOW FINISH GRADE COMPACTED TO 95% MAX DENSITY PER AASHTO T-180. REPLACE 12" OF ORIGINAL TOPSOIL TO FINISH GRADE COMPACTED TO 95% MAX DENSITY PER AASHTO T-180.
3. FINISH TRENCH SURFACE TO MATCH ORIGINAL CONTOURS. REPLACE EXISTING LANDSCAPING.

PIPE TRENCH DETAIL - IN AGRICULTURAL AREAS (3)
SCALE: NTS

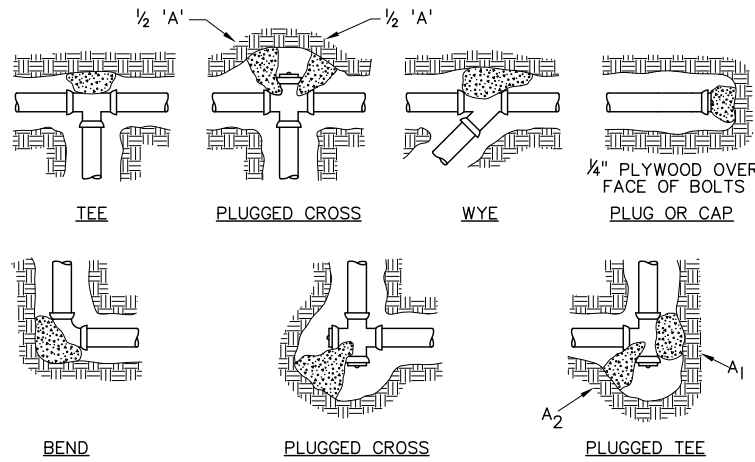


FITTING SIZE	BEARING AREA, 'A', OF THRUST BLOCKS IN SQUARE FEET *						
	TEE, WYE, PLUG OR CAP	90° BEND, PLUGGED CROSS	TEE PLUGGED ON RUN		45° BEND	22½° BEND	11¼° BEND
	A	A	A ₁	A ₂	A	A	A
4	1.4	1.9	2.7	1.9	1.0	-	-
6	2.8	4.0	5.6	4.0	2.1	1.1	-
8	4.8	6.8	9.6	6.8	3.7	1.9	0.9
10	7.3	10.3	14.5	10.3	5.6	2.8	1.4
12	10.3	14.5	20.4	14.5	7.9	4.0	2.0
14	13.8	19.5	27.5	19.5	10.6	5.4	2.7
16	17.8	25.2	35.5	25.2	13.6	7.0	3.5
18	22.4	31.7	44.7	31.7	17.1	8.7	4.4
20	27.5	38.9	54.8	38.9	21.0	10.7	5.4
24	39.2	55.5	78.3	55.5	30.0	15.3	7.7

*ABOVE BEARING AREAS BASED UPON TEST PRESSURE OF 150 P.S.I. AND AN ALLOWABLE SOIL BEARING STRESS OF 2000 POUNDS PER SQUARE FOOT. TO COMPUTE BEARING AREAS FOR DIFFERENT TEST PRESSURES AND SOIL BEARING STRESSES, USE THE FOLLOWING EQUATION: BEARING AREA=(TEST PRESSURE/150) X (2000/SOIL BEARING STRESS) X (TABLE VALUE).


STANDARD THRUST BLOCK DETAILS (4)
SCALE: NTS

NOTES:

1. CONCRETE THRUST BLOCKING SHALL BE POURED AGAINST UNDISTURBED EARTH.
2. KEEP CONCRETE CLEAR OF JOINT AND ACCESSORIES. INSTALL ISOLATION MATERIAL BETWEEN PIPE AND/OR FITTINGS BEFORE POURING BLOCKING.
3. THE REQUIRED THRUST BEARING AREAS FOR SPECIAL CONNECTIONS ARE SHOWN ENCIRCLED ON THE PLANS; e.g. (5) INDICATES 15 SQUARE FEET BEARING AREA REQUIRED
4. IF NOT SHOWN ON PLANS, REQUIRED BEARING AREAS AT FITTING SHALL BE AS INDICATED IN TABLE, ADJUSTED IF NECESSARY, TO CONFORM TO THE TEST PRESSURE(S) AND ALLOWABLE SOIL BEARING STRESS(ES) STATED IN THE SPECIFICATIONS.
5. BEARING AREAS AND SPECIAL BLOCKING DETAILS SHOWN ON PLANS TAKE PRECEDENCE OVER BEARING AREAS AND BLOCKING DETAILS SHOWN ON THIS DETAIL.
6. CONCRETE SHALL BE 3000 PSI MIN 28 DAY COMPRESSIVE STRENGTH.
7. BEARING AREAS WHERE EXISTING PIPE WILL BE ABANDONED IN PLACE, AS SHOWN ON PLAN, SHALL INCLUDE 1/2" STL PLATE AT THE BASE OF THE THRUST BLOCK. THE MIN BEARING AREA OF THE STL PLATE SHALL BE BASED ON DATA FROM THE TABLE.

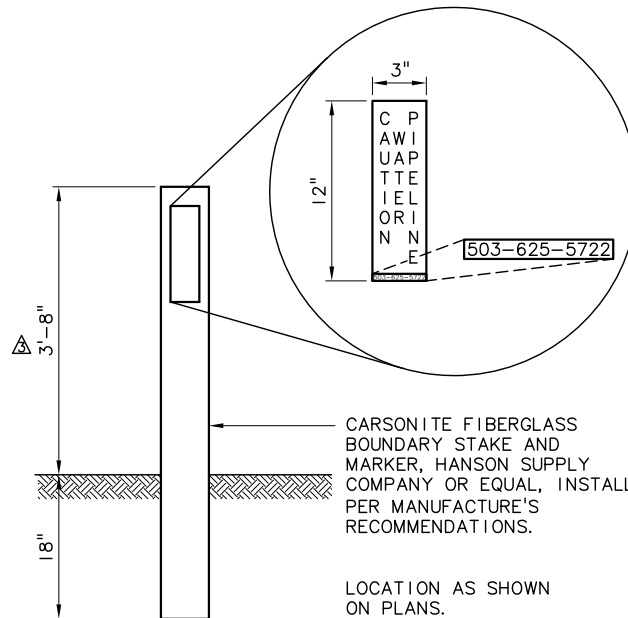

CARSONITE MARKER DETAIL (5)
SCALE: NTS

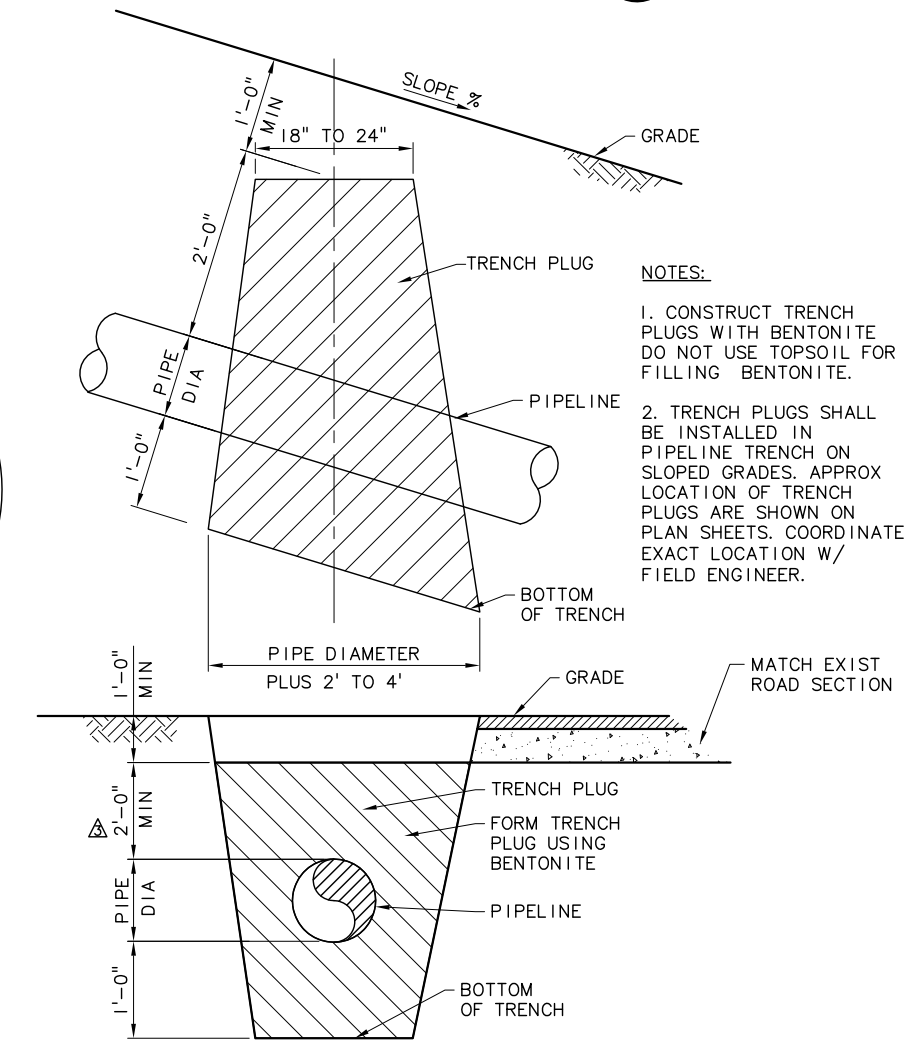

TYPICAL TRENCH DAM (6)
SCALE: 1/2"=1'-0"

C:\Users\dak\AppData\Local\temp\AcPublish_6152\07-0873-207-OR-DETS-R.dwg DT-1 9/2/2011 12:06 PM DAK 18.1s (LMS Tech)

NO.	DATE	BY	REVISION
1	08/22/11	BVO	RECORD DRAWING

NOTICE

0 1/2 1

IF THIS BAR DOES NOT MEASURE 1" THEN DRAWING IS NOT TO SCALE

SMG DESIGNED
DAK DRAWN
MLH CHECKED

RECORD DRAWING

SEE DISCLAIMER, SHEET 1.

VERSION 4.1
12-9-97

MSA Murray Smith & Associates, Inc.
Engineers/Planners

121 S.W. Salmon, Suite 900
Portland, Oregon 97204

PHONE 503-225-9010
FAX 503-225-9022

WATER SUPPLY IMPROVEMENT PROJECT TRANSMISSION PIPELINE

City of Sherwood Oregon


PIPELINE DETAILS-1

PROJECT NO.: 07-0873.207 SCALE: AS SHOWN DATE: JUNE 2009

SHEET

DT-1

58 of 79

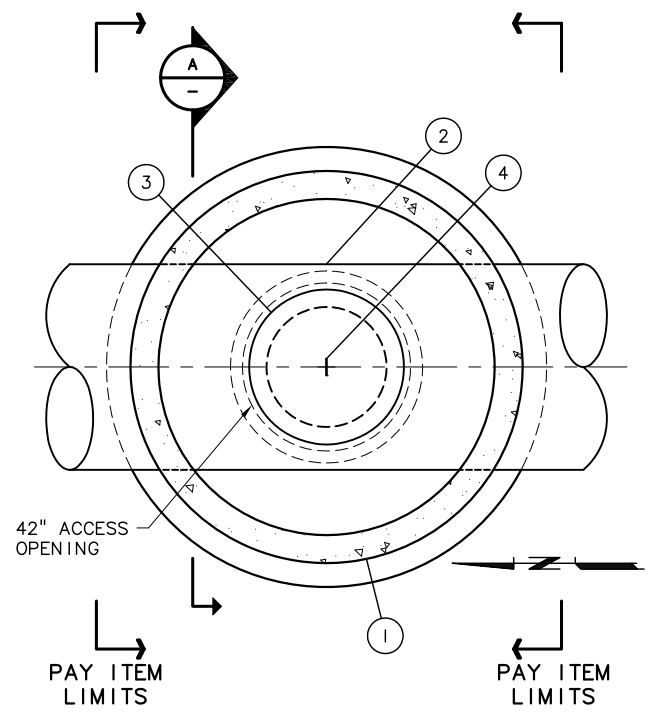


ACCESS MANHOLE
SCALE: 1/2"=1'-0"

- ACCESS MANHOLE MATERIAL LIST**
- ① 84" DIA PRECAST MANHOLE
 - ② 48" DIA STL PIPE W/ 30" DIA MANWAY ACCESS
 - ③ 30" DIA BLIND FLG
 - ④ LIFTING EYE, 750 LB RATED
 - ⑤ TRAFFIC RATED TAMPER PROOF 42" MH COVER & FRAME


NOTES:

1. 53" DIA BLOCKOUT FOR STEEL PIPE SHALL BE PERFORMED BY MANUFACTURER. CONTRACTOR TO INSTALL 4" DIA POLYETHYLENE CLOSED CELL FOAM CYLINDERS TO FILL ANNULAR SPACE ON TOP OF PIPE AND GROUT OVER FOAM.

2. PIPE BEDDING AND BACKFILL WITHIN VAULT SHALL BE 3/4"-0" CRUSHED ROCK.

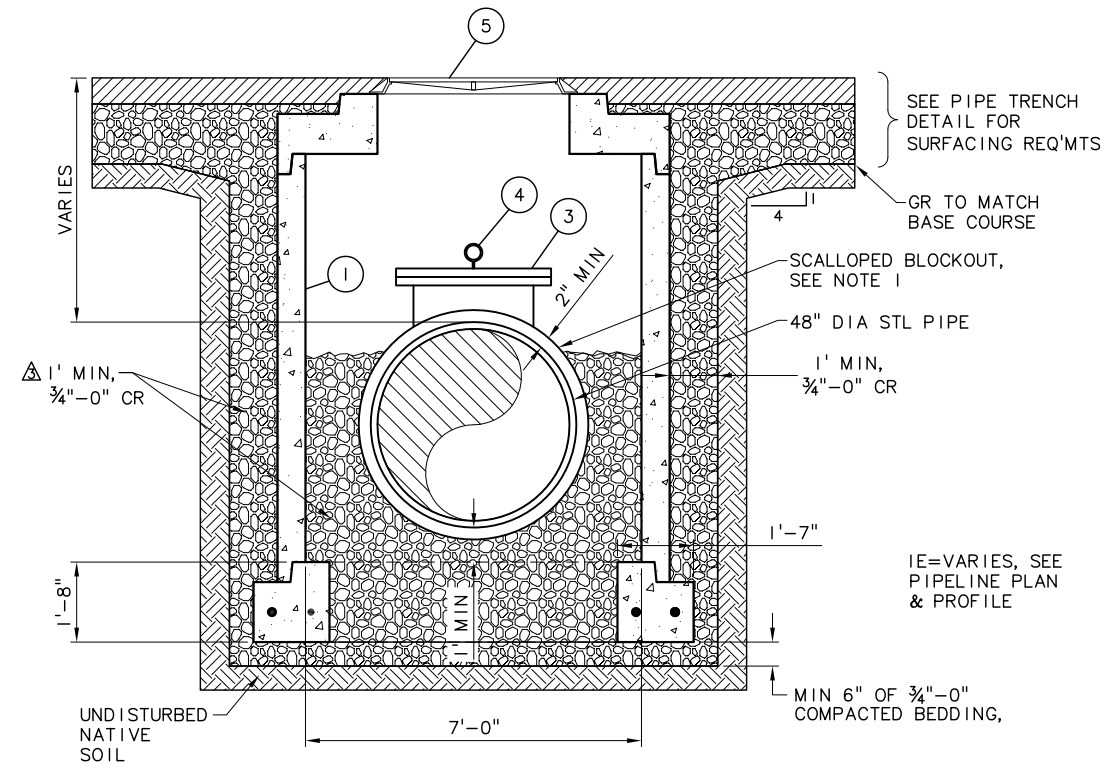

SECTION
SCALE: 1/2"=1'-0"

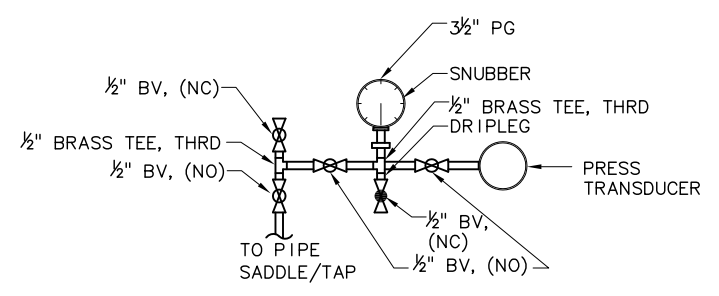


NOTES:

1. INSTALL PRESSURE GAUGE ASSEMBLY AS SHOWN.

2. ALL 1/2" PIPE SHALL BE COPPER.

PRESSURE GAUGE ASSEMBLY
SCALE: 1/2"=1'-0"

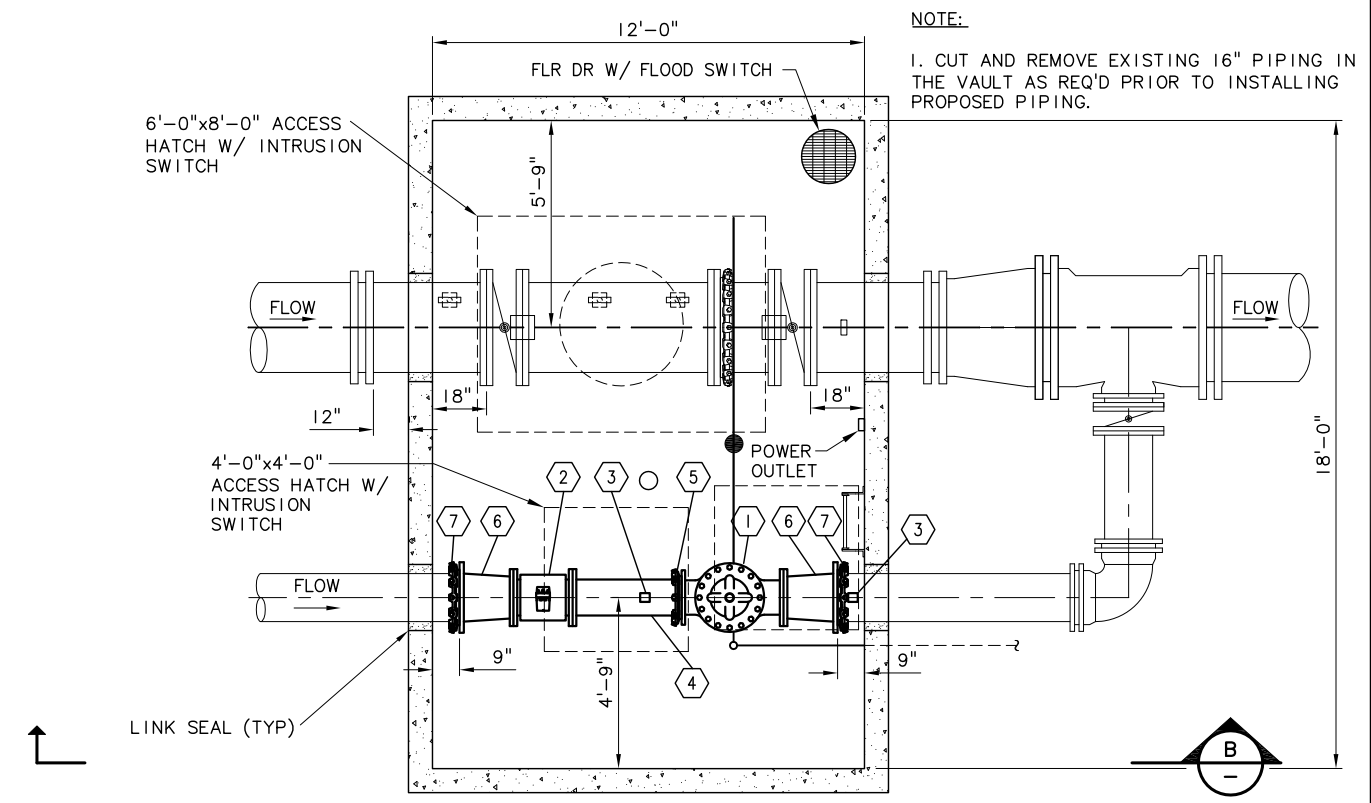


CONTROL VALVE VAULT PLAN
SCALE: 3/8"=1'-0"

NOTE:

1. CUT AND REMOVE EXISTING 16" PIPING IN THE VAULT AS REQ'D PRIOR TO INSTALLING PROPOSED PIPING.

CONTROL VALVE VAULT MATERIAL LIST

- ① 12" ELECTRICALLY CONTROLLED VALVE, FLG, SEE SPECS
- ② 12" MAG METER, FLG
- ③ PRESSURE GAUGE ASSY, SEE DET 3, THIS SHEET
- ④ 12" SPL, FLGXPE, LENGTH AS REQUIRED
- ⑤ 12" MEGA FLG
- ⑥ 16"x12" RDCR, FLG
- ⑦ 16" MEGA FLG ADPTR
- ⑧ ADJUSTABLE PIPE SUPPORT, BOLT TO FLOOR (STANDON MODEL S96 OR APPVD EQ)

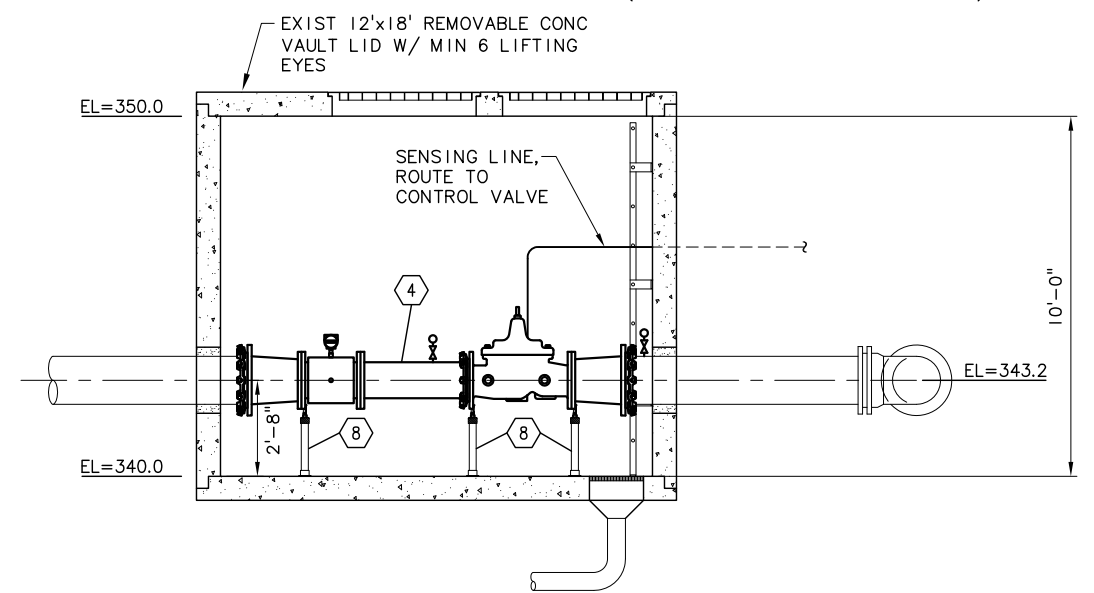

SECTION
SCALE: 3/8"=1'-0"

C:\Users\dak\appdata\local\temp\AcPublish_6152\07-0873-207-OR-DETS-R.dwg DT-2 9/2/2011 12:06 PM DAK 18.1s (LMS Tech)

NO.	DATE	BY	REVISION
1	08/22/11	BVO	RECORD DRAWING

NOTICE

0 1/2 1

IF THIS BAR DOES NOT MEASURE 1" THEN DRAWING IS NOT TO SCALE

SMG DESIGNED
DAK DRAWN
MLH CHECKED

RECORD DRAWING

SEE DISCLAIMER, SHEET 1.

VERSION 4.1
12-9-97

MSA Murray Smith & Associates, Inc.
Engineers/Planners

121 S.W. Salmon, Suite 900
Portland, Oregon 97204

PHONE 503-225-9010
FAX 503-225-9022




WATER SUPPLY IMPROVEMENT PROJECT TRANSMISSION PIPELINE

PIPELINE DETAILS-2

PROJECT NO.: 07-0873.207 SCALE: AS SHOWN DATE: JUNE 2009

SHEET
DT-2
59 of 79

C:\Users\dak\AppData\Local\Temp\AcPublish_6152\07-0873-207-OR-DETS-R.dwg DT-4 9/2/2011 12:06 PM DAK 18.1s (LMS Tech)

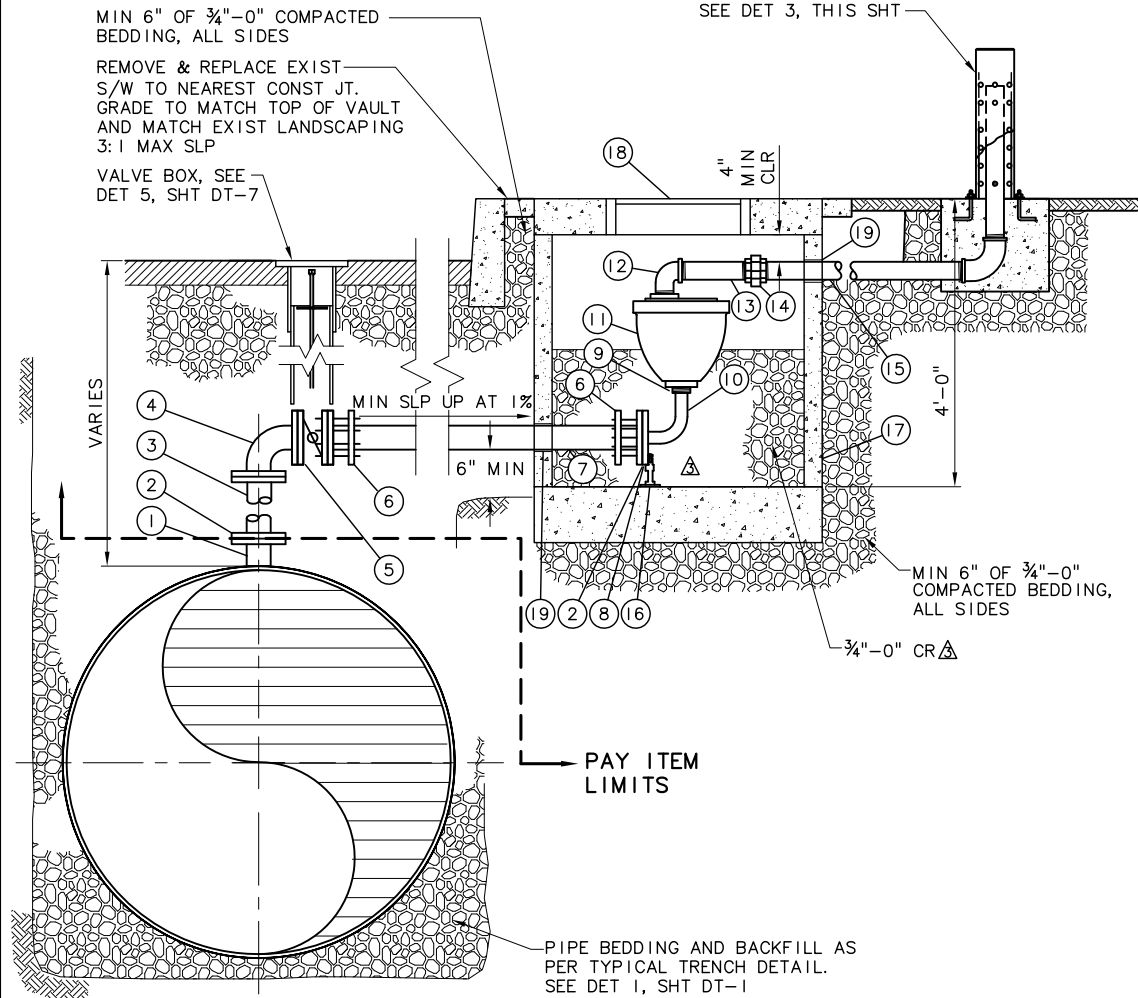


PAY ITEM LIMITS


PIPE BEDDING AND BACKFILL AS PER TYPICAL TRENCH DETAIL. SEE DET 1, SHT DT-1

STANDPIPE LOCATION TO BE FIELD VERIFIED BY ENGINEER


DRILL 1/2" DIA HOLE 6" ABOVE GROUND LEVEL
3" GALV STL ELBOW THRD

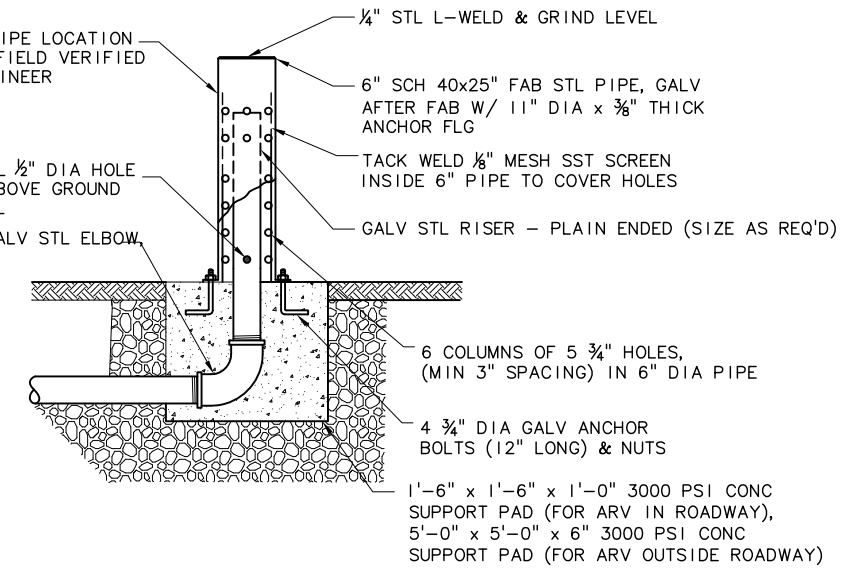


DETAIL 3
SCALE: NTS

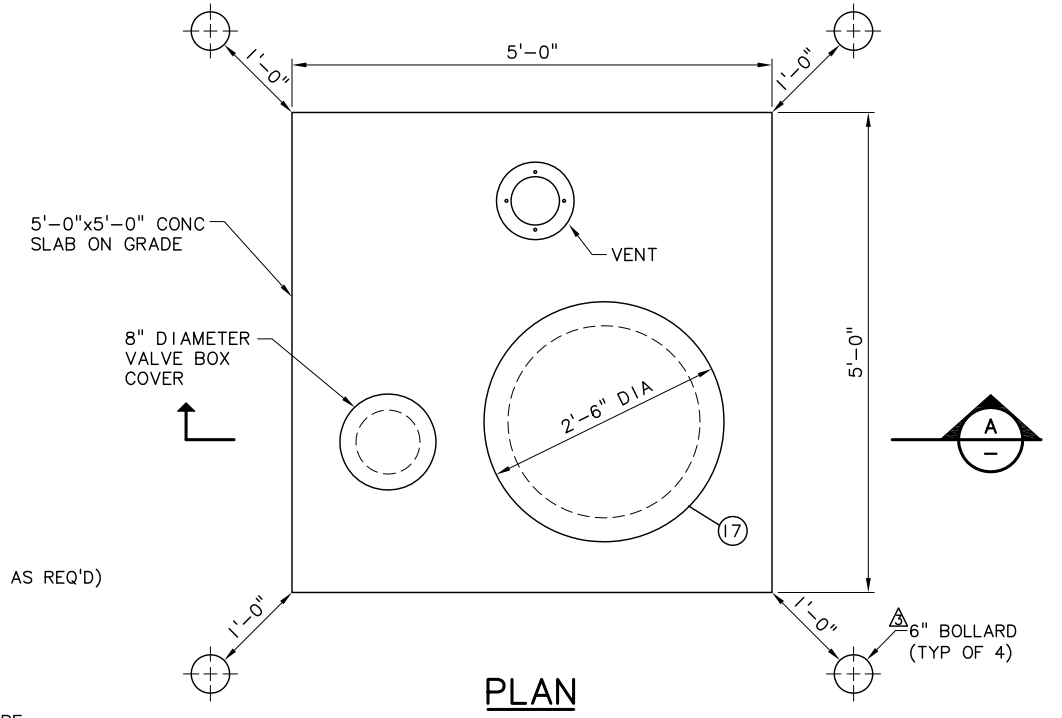

PLAN

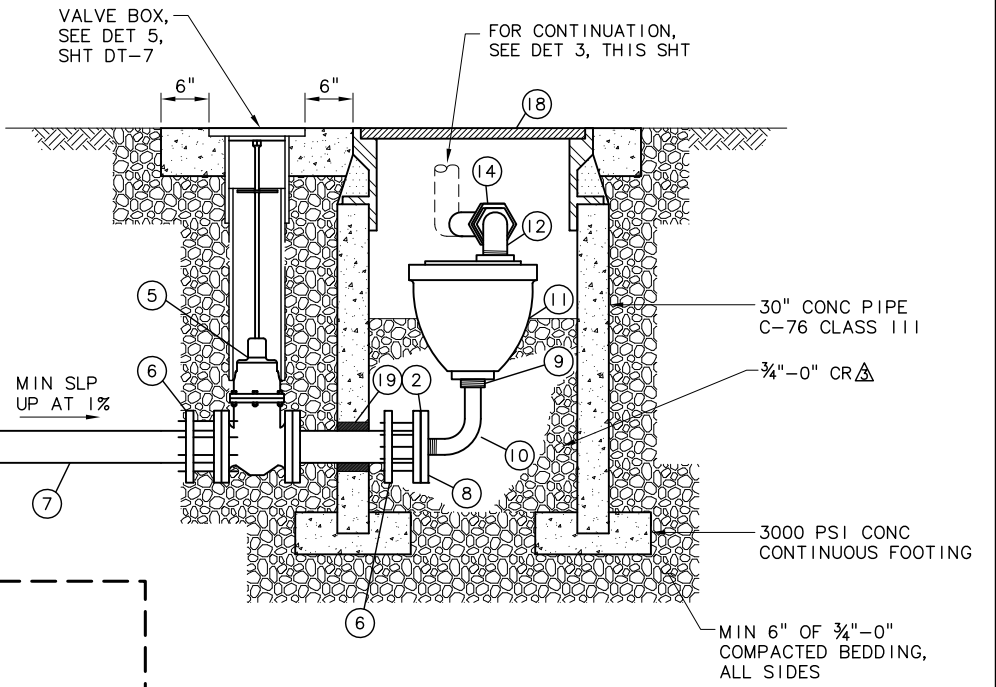

SECTION A
SCALE: 1"=1'-0"

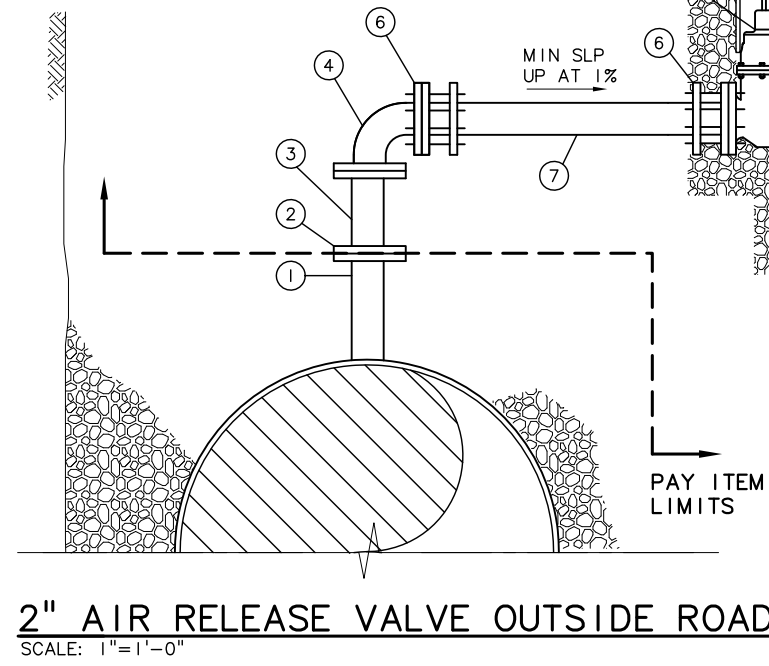

2" AIR RELEASE VALVE IN ROADWAY
SCALE: NTS

2" AIR RELEASE VALVE OUTSIDE ROADWAY
SCALE: 1"=1'-0"

MATERIAL LIST:

- | | |
|--|---|
| ① 48"x4" TEE, PEXFLG | ⑩ 2" BRONZE 90° BEND, THRD |
| ② INSULATED FLG JT, SEE DET 8, SHT DT-14 | ⑪ 2" AIR RELEASE VALVE, APCO 200A, OR EQUAL |
| ③ 4" DI SPL, FLG, LENGTH AS REQ'D | ⑫ 3" GALV STL ELBOW, THRD |
| ④ 4" DI 90° BEND, FLG | ⑬ 3" GALV STL NIPPLE, THRD |
| ⑤ 4" GV, FLG | ⑭ 3" GALV STL UNION, THRD |
| ⑥ 4" RFCA | ⑮ 3" GALV STL PIPING, THRD |
| ⑦ 4" DI SPL, PE, LENGTH AS REQ'D | ⑯ FLG PIPE SUPPORT (STANDON S-89) |
| ⑧ 4"x2" BRONZE COMPANION FLG | ⑰ UTILITY VAULT NO. 444-LA |
| ⑨ 2" BRONZE NIPPLE, THRD | ⑱ 30" H-20 TRAFFIC RATED TAMPER-PROOF MH COVER AND FRAME |
| | ⑲ ALL VAULT PENETRATIONS SHALL BE SEALED WITH WALL SLEEVE SEALS. USE LINK SEAL IN HOLES AROUND PIPE |

- NOTES:**
- ALL PIPE AND FITTINGS SHALL BE RESTRAINED.
 - VERIFY LOCATION ON OF VAULT AND STAND PIPE WITH ENGINEER.
 - INSTALL TWO BENDS AS REQUIRED BETWEEN GATE VALVE AND CARV TO FACILITATE CONNECTION.

AIR RELEASE VALVE SCHEDULE		
STA	SIZE (INCHES)	APCO MODEL NO.
B17+60	2	200A
C10+20	2	200A
D15+00	2	200A

2" AIR RELEASE VALVE IN ROADWAY
SCALE: NTS

2" AIR RELEASE VALVE OUTSIDE ROADWAY
SCALE: 1"=1'-0"

NOTICE

0 1/2 1

IF THIS BAR DOES NOT MEASURE 1" THEN DRAWING IS NOT TO SCALE

SMG DESIGNED
DAK DRAWN
MLH CHECKED

RECORD DRAWING

SEE DISCLAIMER, SHEET 1.

VERSION 4.1
12-9-97

MSA Murray Smith & Associates, Inc.
Engineers/Planners

121 S.W. Salmon, Suite 900
Portland, Oregon 97204

PHONE 503-225-9010
FAX 503-225-9022

City of Sherwood Oregon

WATER SUPPLY IMPROVEMENT PROJECT TRANSMISSION PIPELINE

PIPELINE DETAILS - 4

PROJECT NO.: 07-0873.207 SCALE: AS SHOWN DATE: JUNE 2009

SHEET

DT-4

61 of 79

C:\Users\dak\appdata\local\temp\AcPublish_6152\07-0873-207-OR-DETS-R.dwg DT-5 9/2/2011 12:06 PM DAK 18.1s (LMS Tech)

NOTE:


1. ALL VAULT PENETRATIONS SHALL BE SEALED WITH WALL SEALS. USE LINK SEAL IN HOLES AROUND PIPE.

PIPING SCHEDULE:


- ① 48"x₋" TEE, PEXFLG*
- ② INSULATED FLG JT, SEE DET., SHT.
- ③ ₋" DI 90° BEND, FLG*
- ④ ₋" RFCA*
- ⑤ ₋" BFV, FLG*
- ⑥ VALVE BOX, SEE DET., SHT.
- ⑦ ₋" DI SPL, FLG, LENGTH AS REQ'D*
- ⑧ ₋" DI TEE, FLG*
- ⑨ 84" STD MH
- ⑩ STD APWA 30" MH COVER & FRAME
- ⑪ ₋" FCA*
- ⑫ EXPANDED METAL SCREEN, WELD IN PLACE
- ⑬ CAST IN SLAB ₋" SCHED 40 STL PIPE W/ RETURN BEND, GALV AFTER FAB (TYP OF 2)*
- ⑭ 1" COPPER TUBING
- ⚠ ⑮ 12" ADS PIPE FILLED W/ 3000 PSI CONC, WRAP FITTING IN POLYETHYLENE PLASTIC TO PROTECT FROM CONC, PROVIDE 18" EMBEDMENT
- ⑯ 1" WELD-O-LET

*SEE AIR/VACUUM VALVE SCHEDULE FOR SIZE


STA	SIZE (INCHES)	TYPE	APCO MODEL NO.
⚠ A20+20	12	COMBINATION	1812
A30+80	12	COMBINATION	1812
A47+67	12	COMBINATION	1812
B9+40	10	SURGE CRITICAL	1710
B32+59	12	COMBINATION	1812
B43+43	10	COMBINATION	1810
C1+00	14	SURGE CRITICAL	1714
C22+80	12	COMBINATION	1812
C44+58	8	SURGE CRITICAL	1708

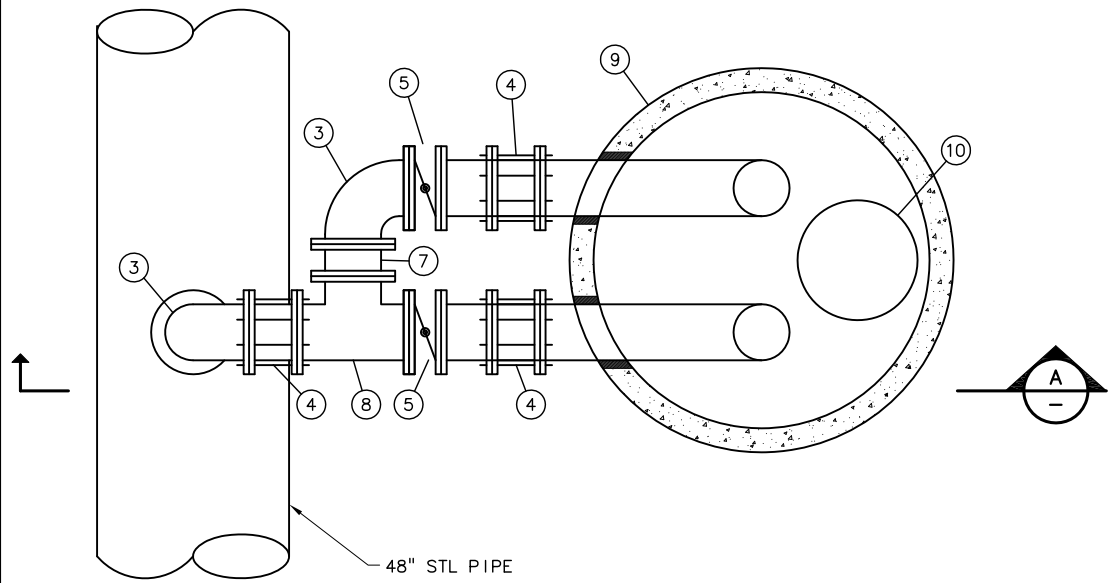

PLAN

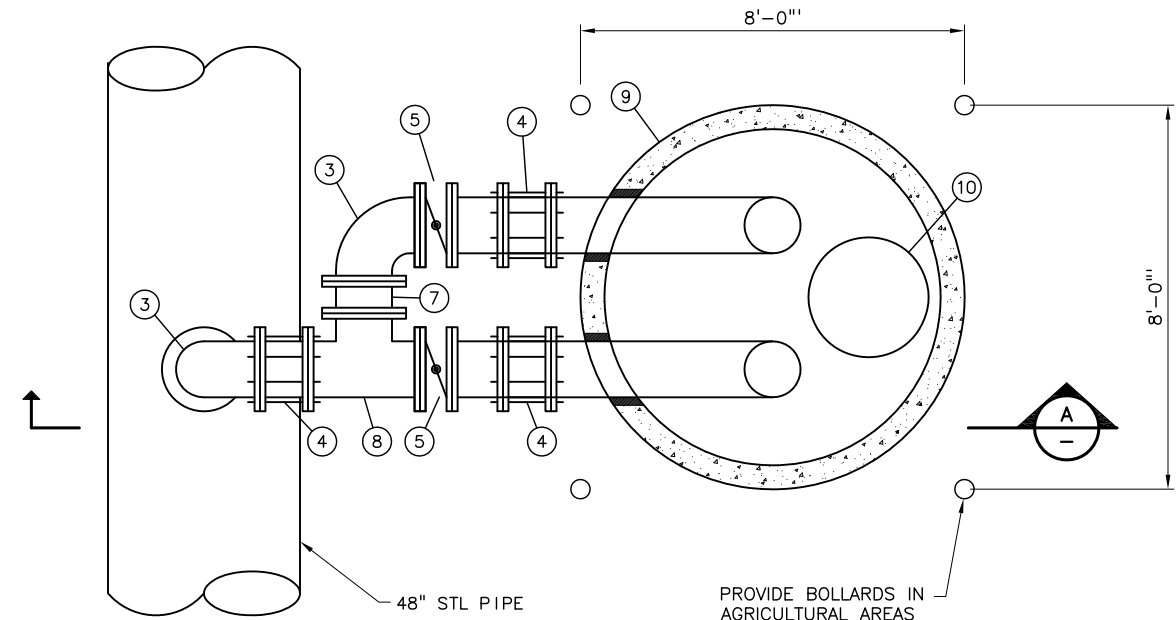


PLAN

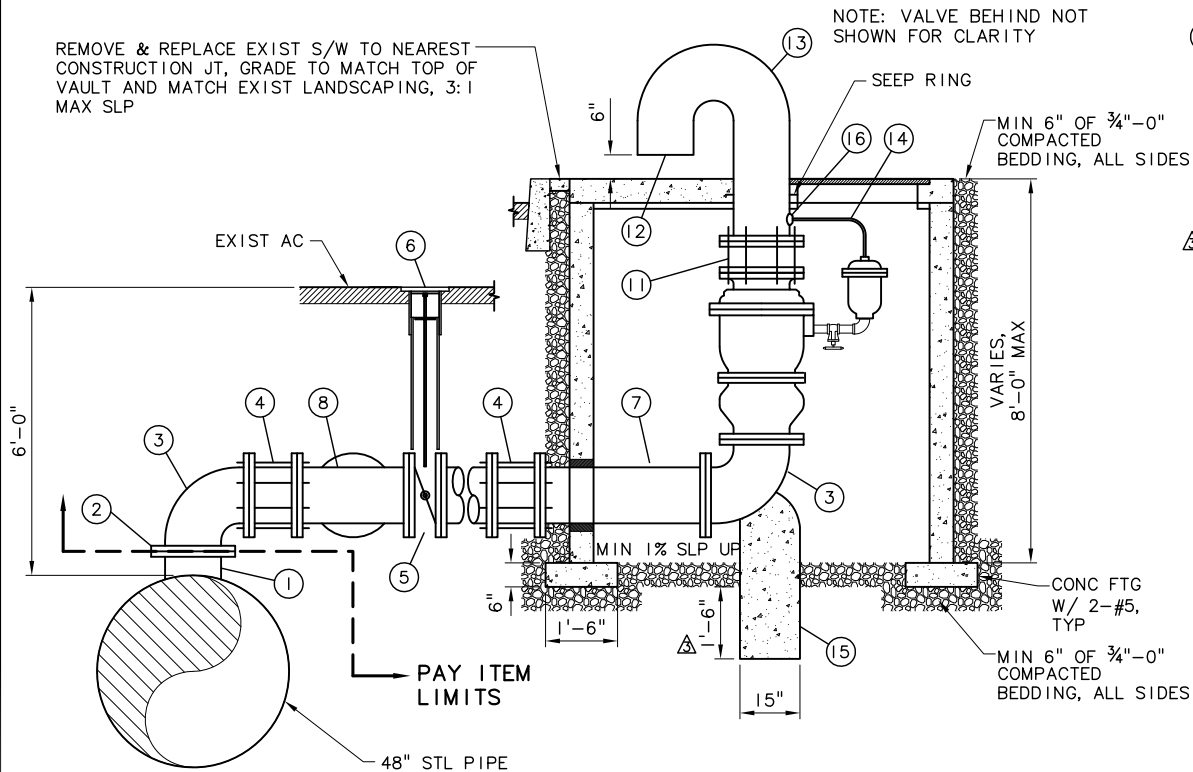

SECTION

AIR/VACUUM VALVE IN ROADWAY (1)
SCALE: 1/2" = 1'-0"

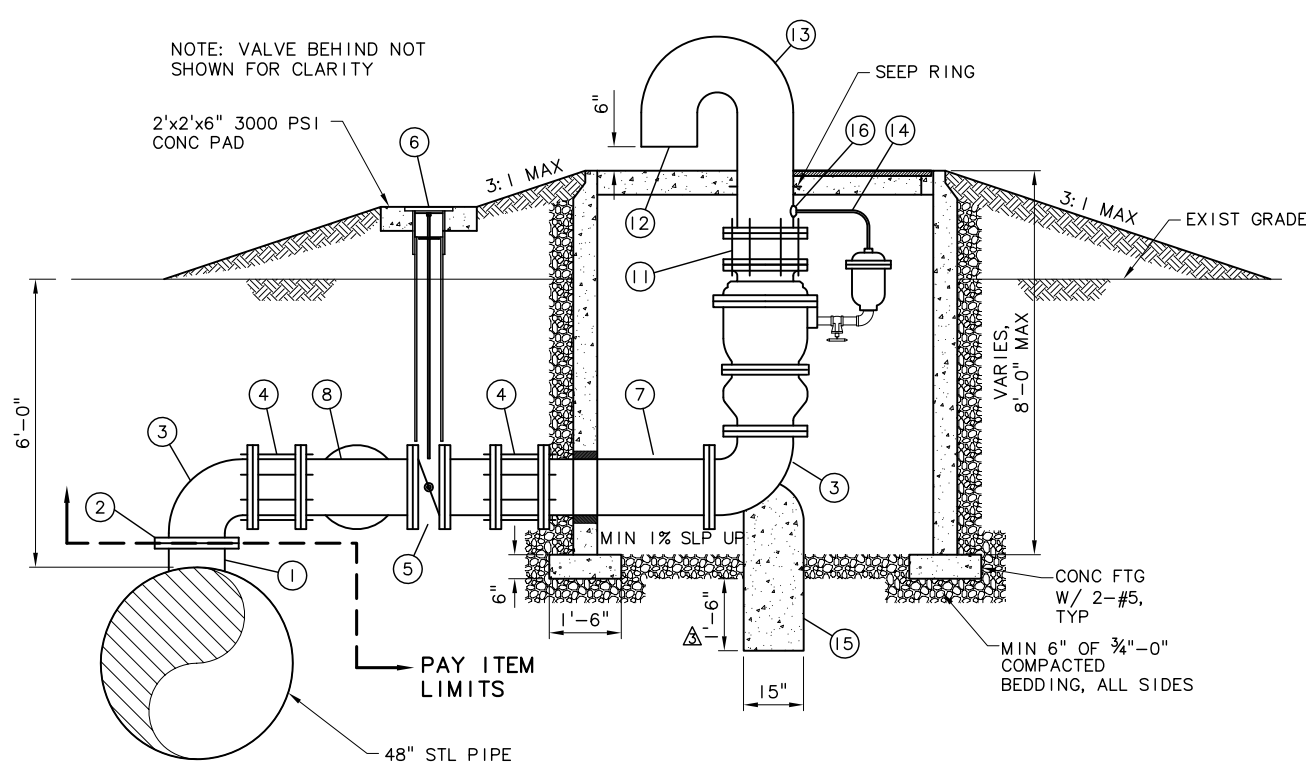

SECTION

AIR/VACUUM VALVE OUTSIDE ROADWAY (2)
SCALE: 1/2" = 1'-0"

NOTICE

0 1/2 1

IF THIS BAR DOES NOT MEASURE 1" THEN DRAWING IS NOT TO SCALE

SMG DESIGNED
DAK DRAWN
MLH CHECKED

RECORD DRAWING

SEE DISCLAIMER, SHEET 1.

VERSION 4.1
12-9-97

MSA Murray Smith & Associates, Inc.
Engineers/Planners

121 S.W. Salmon, Suite 900 PHONE 503-225-9010
Portland, Oregon 97204 FAX 503-225-9022

City of Sherwood Oregon

WATER SUPPLY IMPROVEMENT PROJECT TRANSMISSION PIPELINE


PIPELINE DETAILS-5

PROJECT NO.: 07-0873.207 SCALE: AS SHOWN DATE: JUNE 2009


SHEET

DT-5


62 of 79

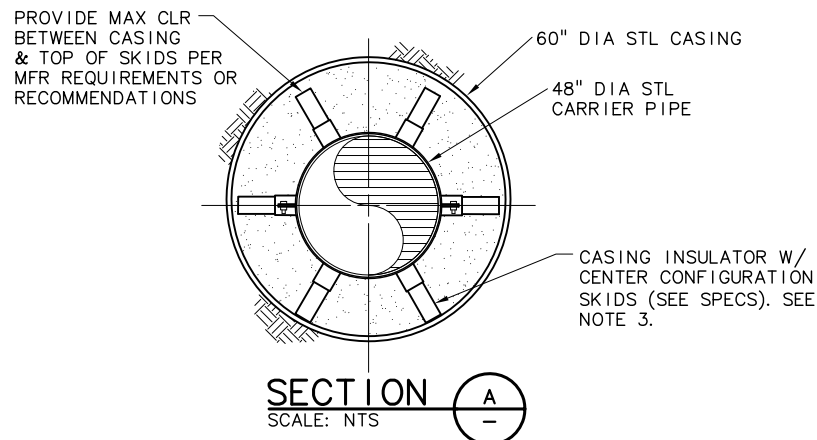


SECTION A
SCALE: NTS

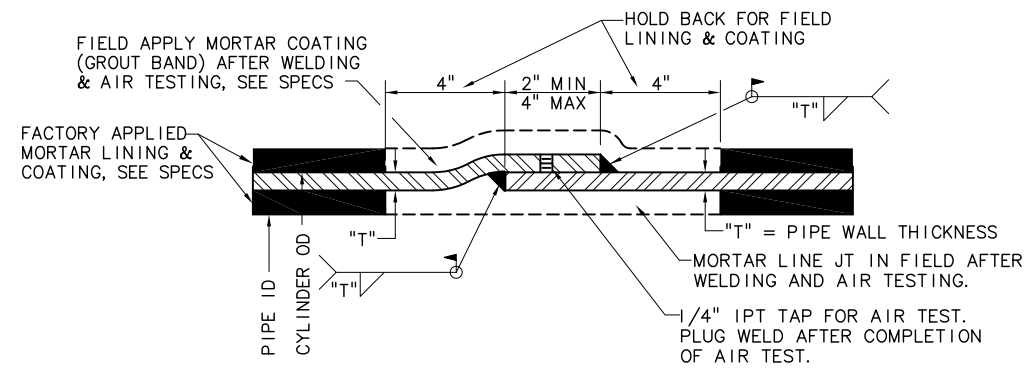


DOUBLE FILLET WELDED LAP JOINT 2
SCALE: NTS

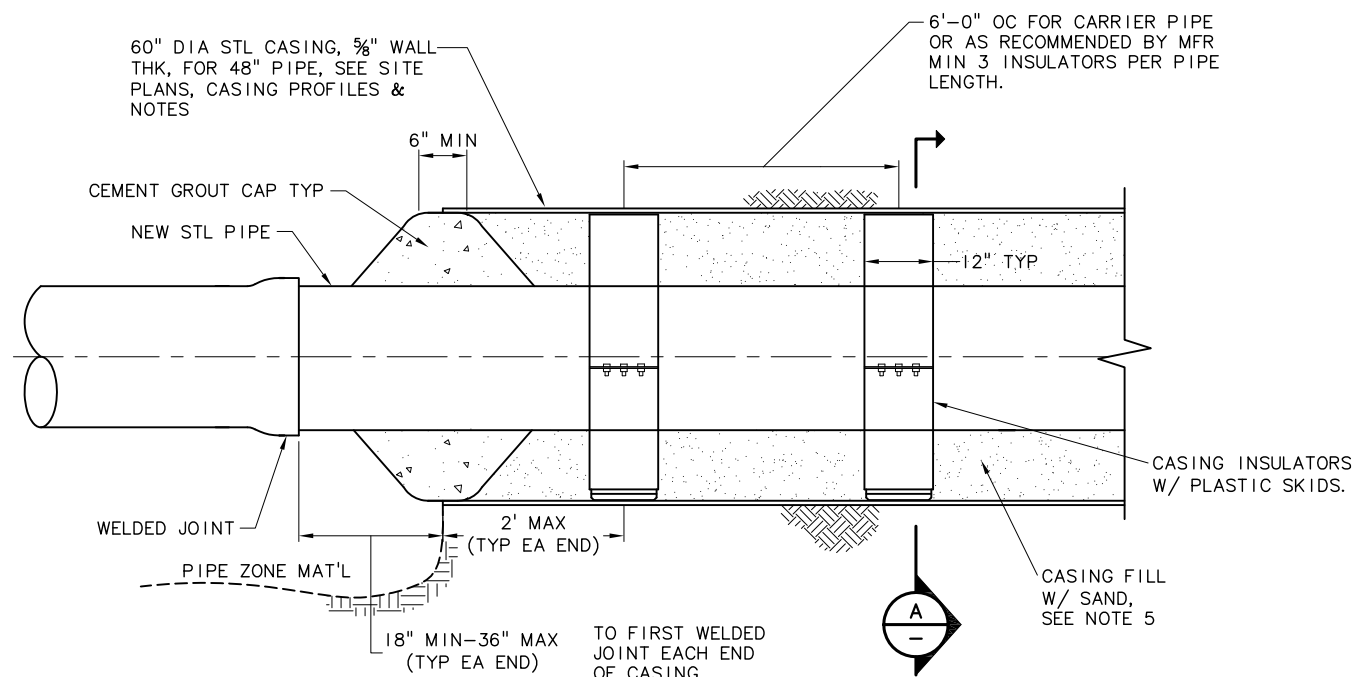

CASING DETAIL 1
SCALE: NTS

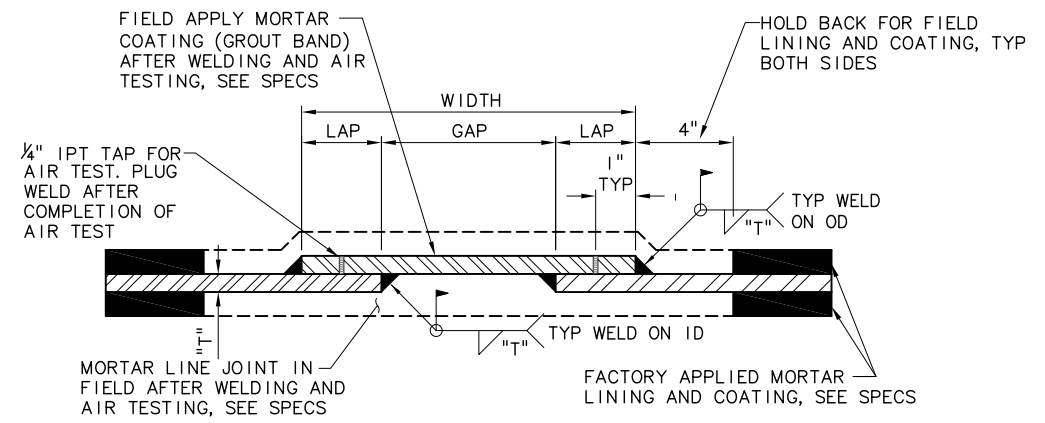

BUTT STRAP JOINT 3
SCALE: NTS

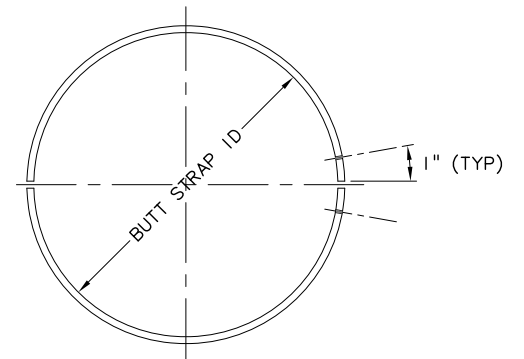

BUTT STRAP DETAIL 4
SCALE: NTS

CASING NOTES:

1. 60" ANSI/AWWA C200 STEEL CASING, AS REQUIRED.
2. PROVIDE 2" MINIMUM CLEARANCE BETWEEN CASING AND CARRIER PIPE BELLS AND APPURTENANCES.
3. CONTRACTOR TO VERIFY CASING SIZES PRIOR TO SIZING AND ORDERING CASING INSULATORS.
4. CASING SHALL BE FILLED WITH FINE CLEAN DRY SAND CAREFULLY AIR BLOWN IN SUCH A WAY AS TO ELIMINATE ANY VOIDS.
5. CARRIER PIPE INSTALLED WITHIN BORE PITS SHALL BE INSTALLED WITH THE SAME BEDDING AND BACKFILL REQUIREMENTS AS PIPELINES SEE TYPICAL TRENCH SECTION.

C:\Users\dak\appdata\local\temp\AcPublish_6152\07-0873-207-OR-DETS-R.dwg DT-6 9/2/2011 12:06 PM DAK 18.1s (LMS Tech)

NO.	DATE	BY	REVISION
1	08/22/11	BVO	RECORD DRAWING

NOTICE

IF THIS BAR DOES NOT MEASURE 1" THEN DRAWING IS NOT TO SCALE

SMG DESIGNED
DAK DRAWN
MLH CHECKED

RECORD DRAWING
SEE DISCLAIMER, SHEET 1.
VERSION 4.1
12-9-97

MSA Murray Smith & Associates, Inc.
Engineers/Planners
121 S.W. Salmon, Suite 900 PHONE 503-225-9010
Portland, Oregon 97204 FAX 503-225-9022


City of Sherwood Oregon

WATER SUPPLY IMPROVEMENT PROJECT TRANSMISSION PIPELINE

PIPING DETAILS-6

PROJECT NO.: 07-0873.207 SCALE: AS SHOWN DATE: JUNE 2009


C:\Users\dak\appdata\local\temp\AcPublish_6152\07-0873-207-OR-DETS-R.dwg DT-7 9/2/2011 12:06 PM DAK 18.1s (LMS Tech)

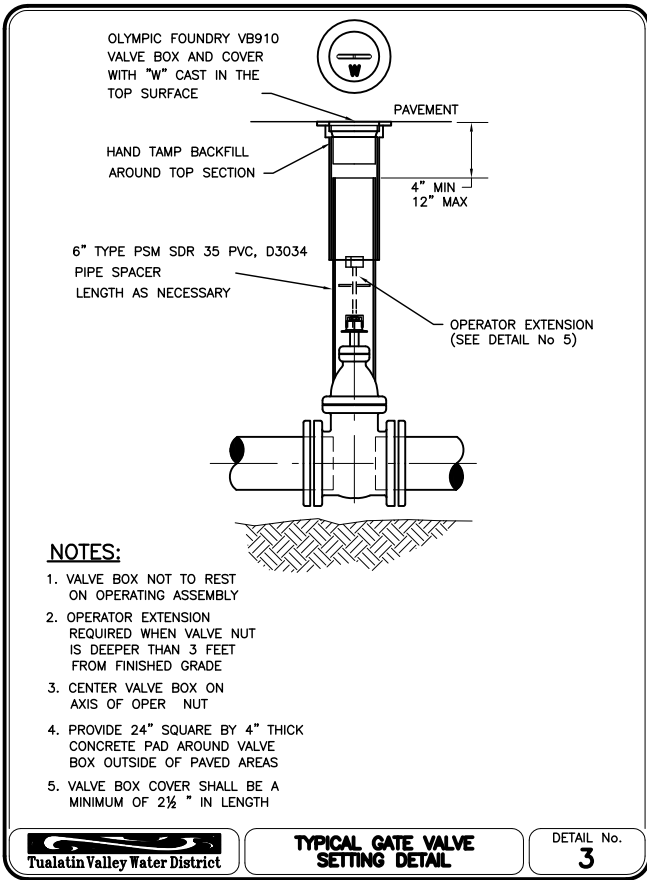

NOTES:

1. VALVE BOX NOT TO REST ON OPERATING ASSEMBLY
2. OPERATOR EXTENSION REQUIRED WHEN VALVE NUT IS DEEPER THAN 3 FEET FROM FINISHED GRADE
3. CENTER VALVE BOX ON AXIS OF OPER NUT
4. PROVIDE 24" SQUARE BY 4" THICK CONCRETE PAD AROUND VALVE BOX OUTSIDE OF PAVED AREAS
5. VALVE BOX COVER SHALL BE A MINIMUM OF 2 1/2" IN LENGTH


Tualatin Valley Water District **TYPICAL GATE VALVE SETTING DETAIL** DETAIL No. **3**

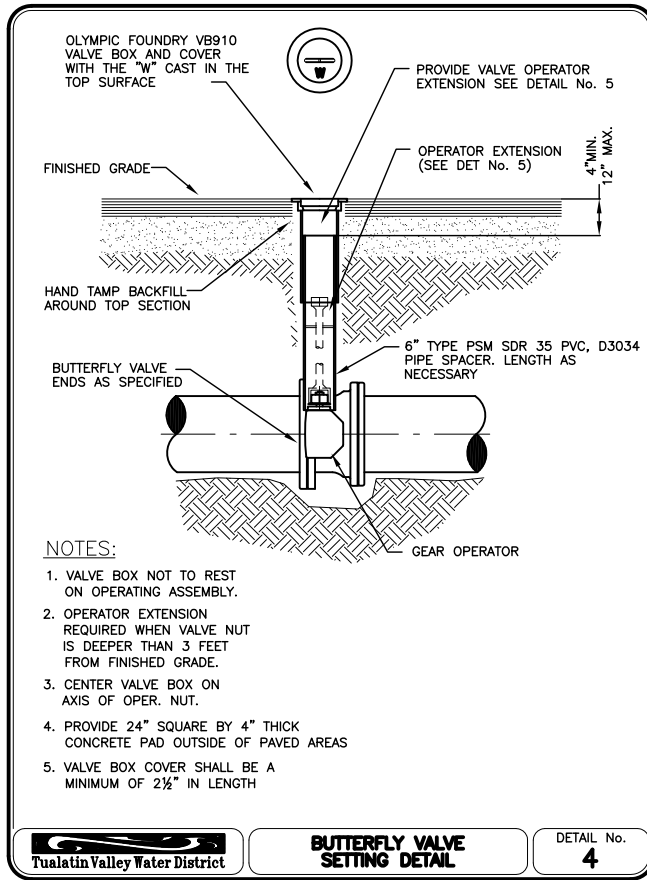

NOTES:

1. VALVE BOX NOT TO REST ON OPERATING ASSEMBLY.
2. OPERATOR EXTENSION REQUIRED WHEN VALVE NUT IS DEEPER THAN 3 FEET FROM FINISHED GRADE.
3. CENTER VALVE BOX ON AXIS OF OPER. NUT.
4. PROVIDE 24" SQUARE BY 4" THICK CONCRETE PAD OUTSIDE OF PAVED AREAS
5. VALVE BOX COVER SHALL BE A MINIMUM OF 2 1/2" IN LENGTH


Tualatin Valley Water District **BUTTERFLY VALVE SETTING DETAIL** DETAIL No. **4**

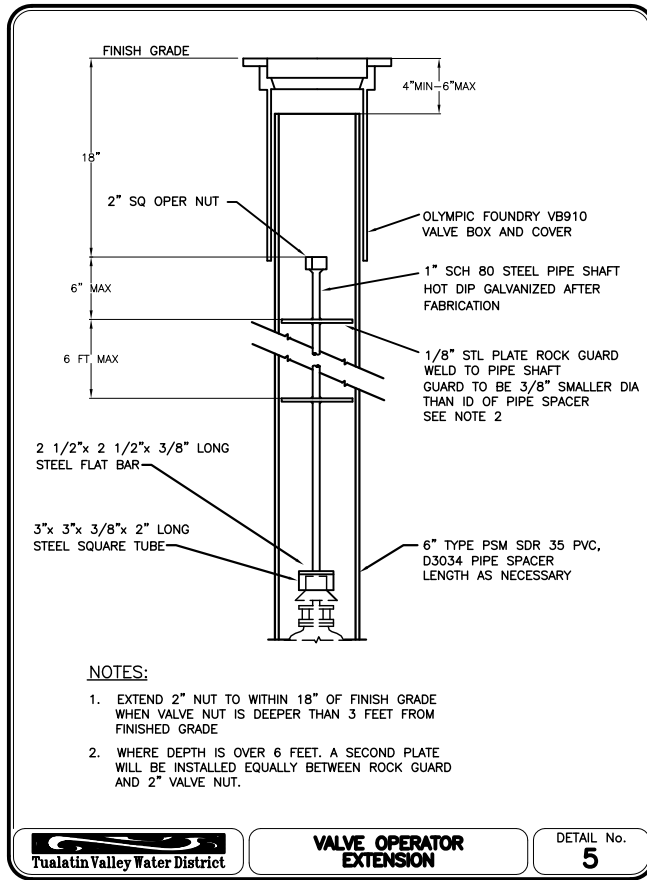

NOTES:

1. EXTEND 2" NUT TO WITHIN 18" OF FINISH GRADE WHEN VALVE NUT IS DEEPER THAN 3 FEET FROM FINISHED GRADE
2. WHERE DEPTH IS OVER 6 FEET. A SECOND PLATE WILL BE INSTALLED EQUALLY BETWEEN ROCK GUARD AND 2" VALVE NUT.


Tualatin Valley Water District **VALVE OPERATOR EXTENSION** DETAIL No. **5**

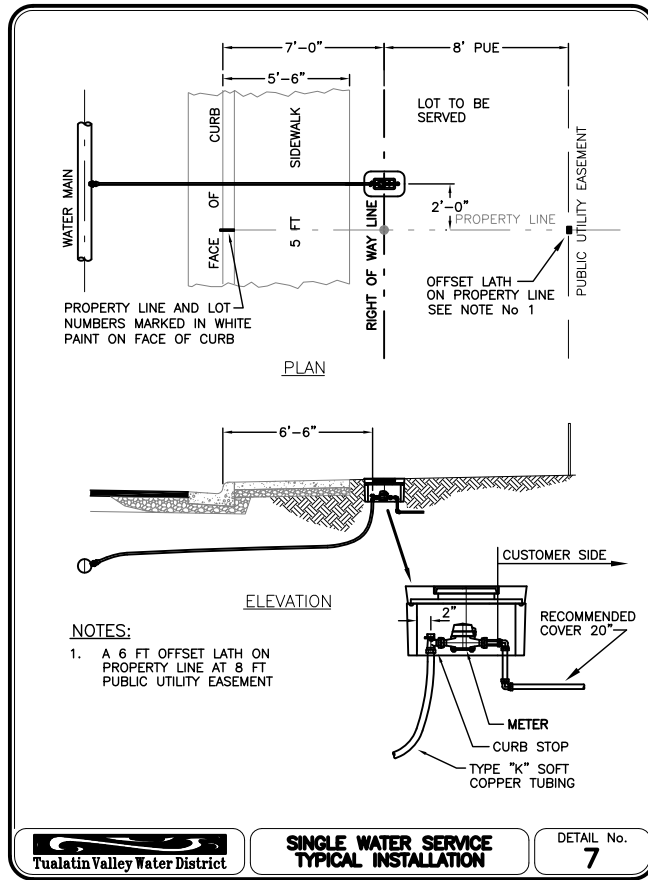

NOTES:

1. A 6 FT OFFSET LATH ON PROPERTY LINE AT 8 FT PUBLIC UTILITY EASEMENT


Tualatin Valley Water District **SINGLE WATER SERVICE TYPICAL INSTALLATION** DETAIL No. **7**

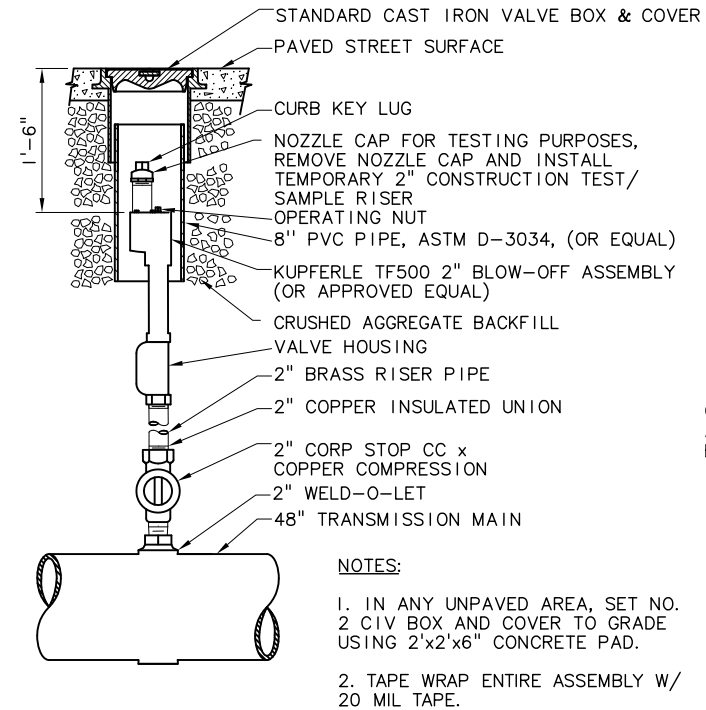

NOTES:

1. IN ANY UNPAVED AREA, SET NO. 2 CIV BOX AND COVER TO GRADE USING 2'x2'x6" CONCRETE PAD.
2. TAPE WRAP ENTIRE ASSEMBLY W/ 20 MIL TAPE.

TF500 AIR RELEASE AND BLOW-OFF ASSEMBLY (9) SCALE: NTS

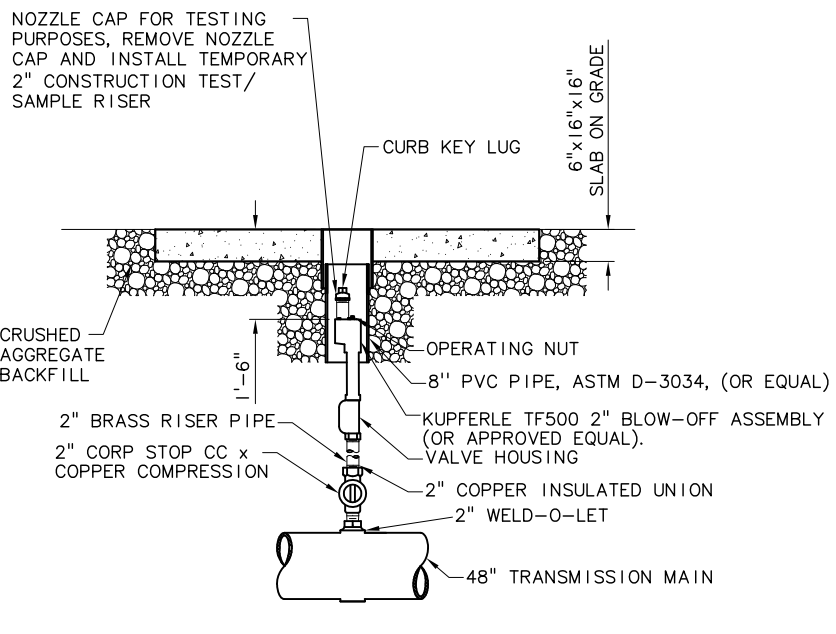

TF500 AIR RELEASE AND BLOW-OFF ASSEMBLY - AGRICULTURAL AREA (10) SCALE: NTS

NO.	DATE	BY	REVISION
3	08/22/11	BVO	RECORD DRAWING

NOTICE
0 1/2 1
IF THIS BAR DOES NOT MEASURE 1" THEN DRAWING IS NOT TO SCALE

SMG DESIGNED
DAK DRAWN
MLH CHECKED

RECORD DRAWING
SEE DISCLAIMER, SHEET 1.
VERSION 4.1
12-9-97









MSA Murray Smith & Associates, Inc.
Engineers/Planners
121 S.W. Salmon, Suite 900 PHONE 503-225-9010
Portland, Oregon 97204 FAX 503-225-9022

City of Sherwood Oregon
WATER SUPPLY IMPROVEMENT PROJECT TRANSMISSION PIPELINE


MISC DETAILS
PROJECT NO.: 07-0873.207 SCALE: AS SHOWN DATE: JUNE 2009

SHEET **DT-7**
64 of 79

C:\Users\dak\appdata\local\temp\AcPublish_6152\07-0873-207-OR-DETS-R.dwg DT-8 9/2/2011 12:06 PM DAK 18.1s (LMS Tech)

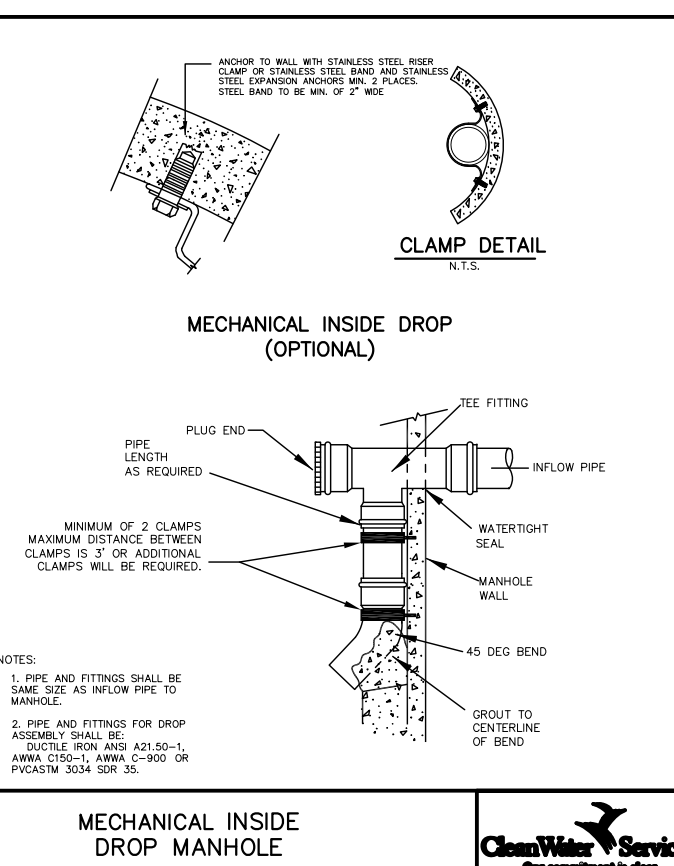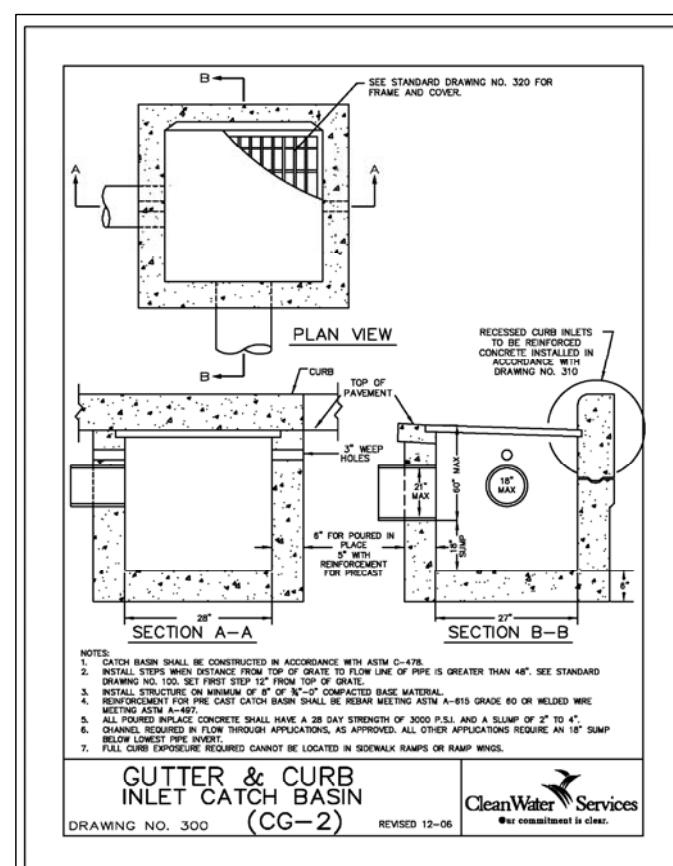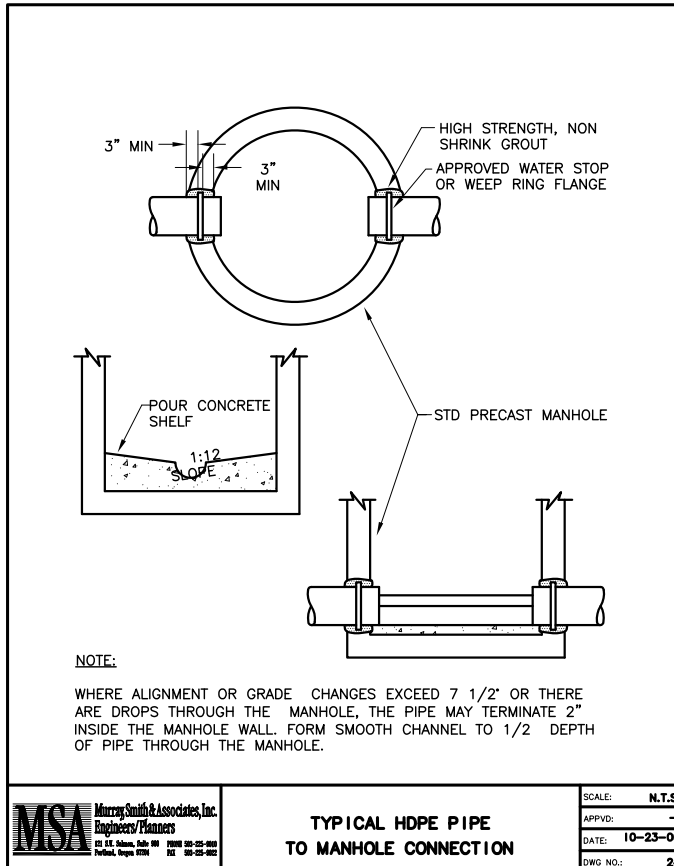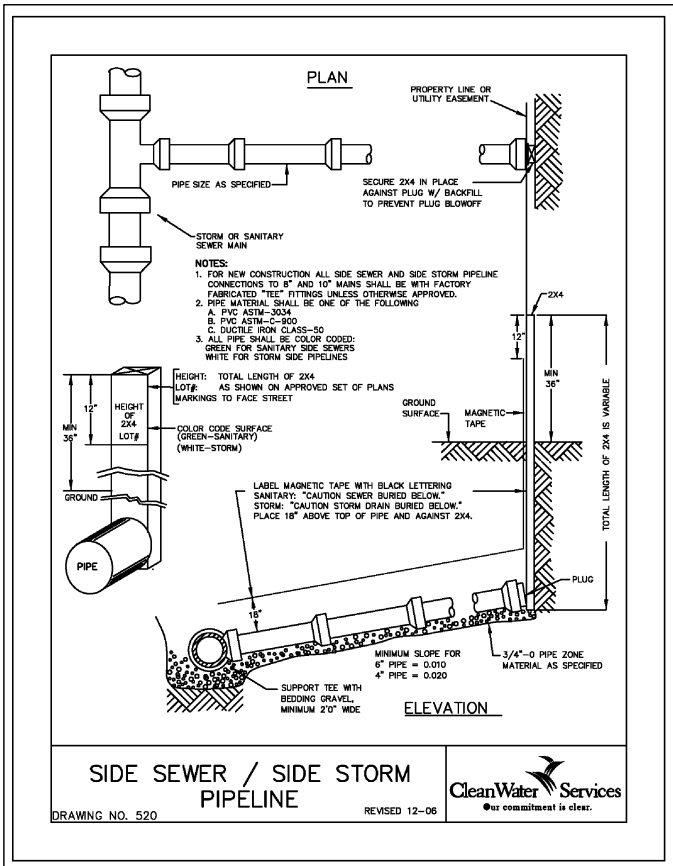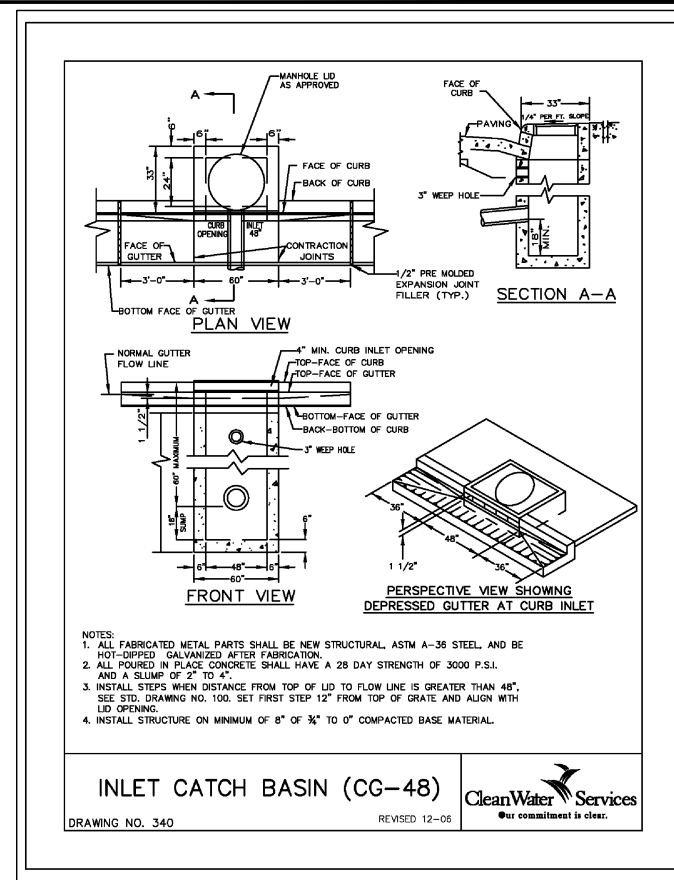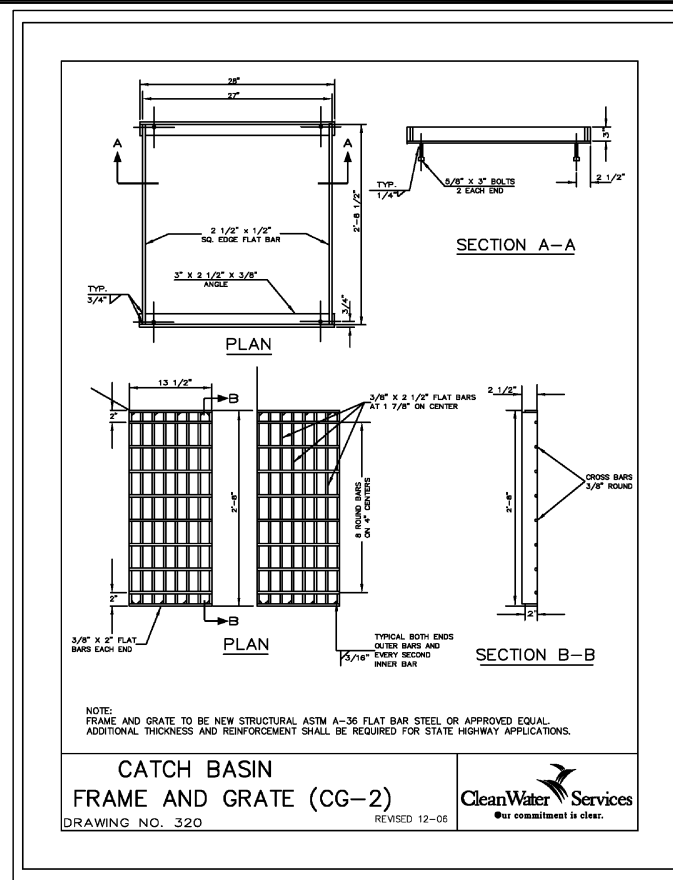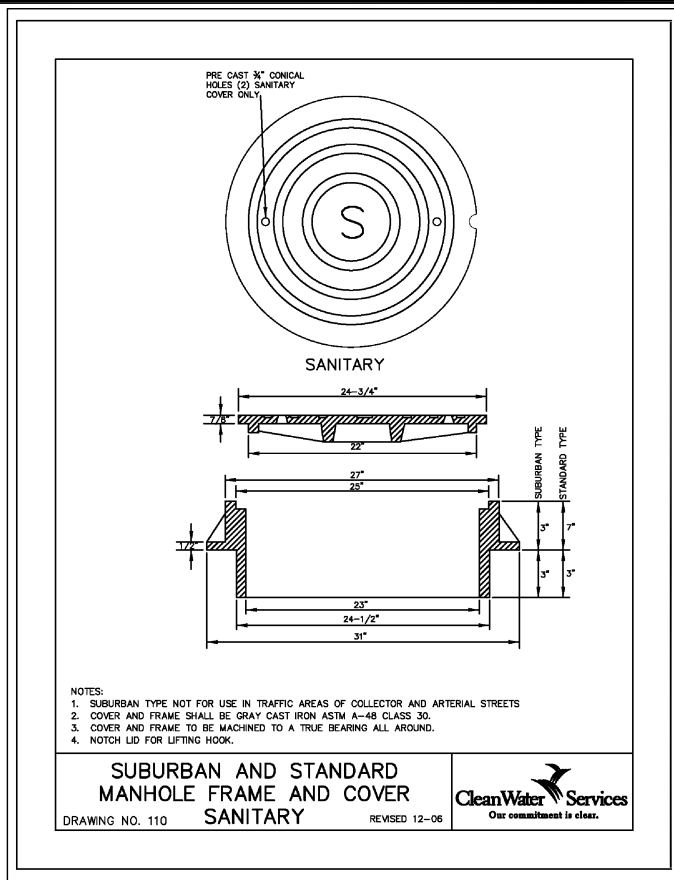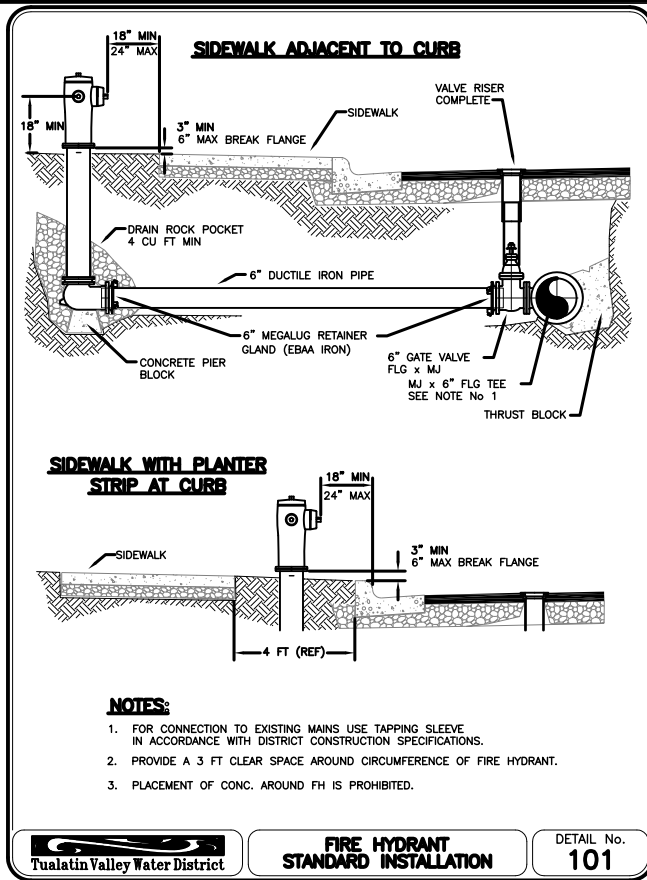

NO.	DATE	BY	REVISION
3	08/22/11	BVO	RECORD DRAWING

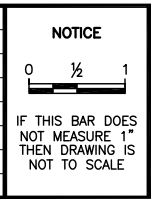

SMG DESIGNED
DAK DRAWN
MLH CHECKED

RECORD DRAWING

SEE DISCLAIMER, SHEET 1.

VERSION 4.1
12-9-97

MSA **Murray Smith & Associates, Inc.** **Engineers/Planners**

121 S.W. Salmon, Suite 900 PHONE 503-225-9010
Portland, Oregon 97204 FAX 503-225-9022

City of Sherwood Oregon

WATER SUPPLY IMPROVEMENT PROJECT TRANSMISSION PIPELINE


MISC DETAILS

DT-8


PROJECT NO.: 07-0873.207 SCALE: AS SHOWN DATE: JUNE 2009

SHEET 65 of 79


C:\Users\dak\appdata\local\temp\AcPublish_6152\07-0873-207-OR-DETS-R.dwg DT-9 9/2/2011 12:06 PM DAK 18.1s (LMS Tech)

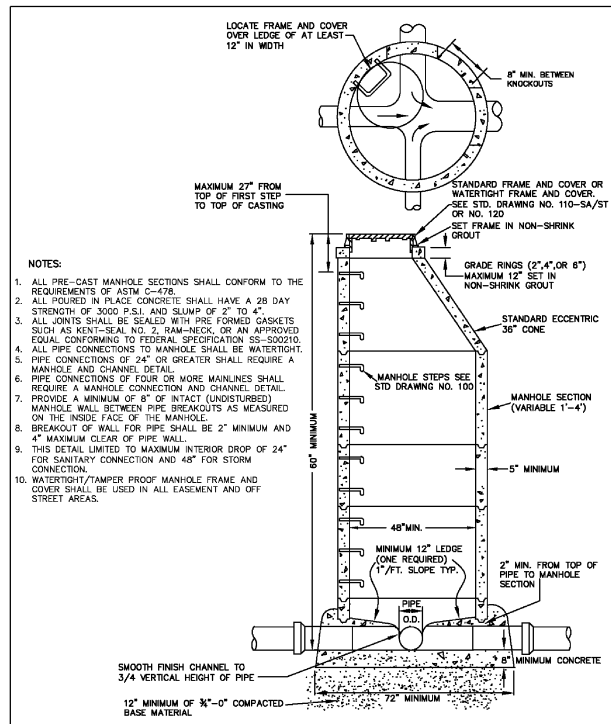


STANDARD MANHOLE
DRAWING NO. 010
REVISED 02-03
CleanWater Services
Our commitment is clear.

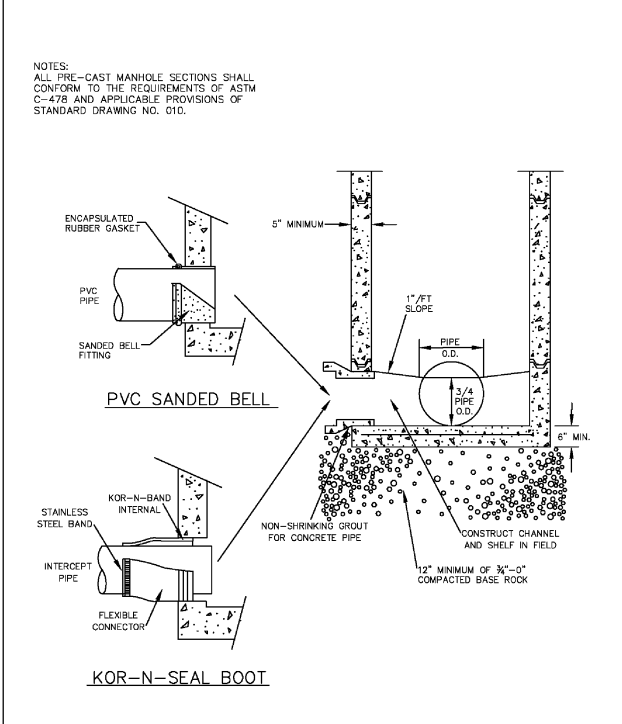


PRECAST CONCRETE MANHOLE BASE
DRAWING NO. 020
REVISED 05-07
CleanWater Services
Our commitment is clear.

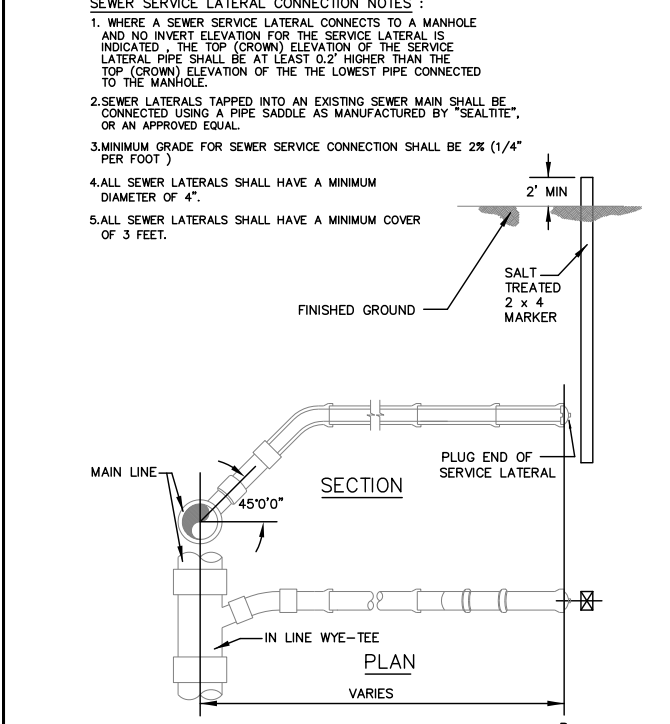


SEWER SERVICE LATERAL CONNECTION
SCALE: N.T.S.
APPVD: --
DATE: 10-23-00
DWG NO.: S-2

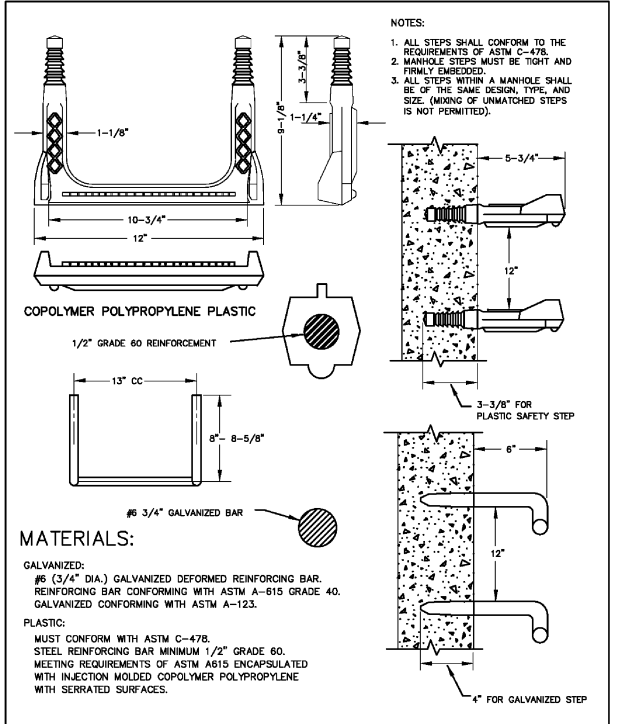


MANHOLE STEP
DRAWING NO. 100
REVISED 02-03
CleanWater Services
Our commitment is clear.

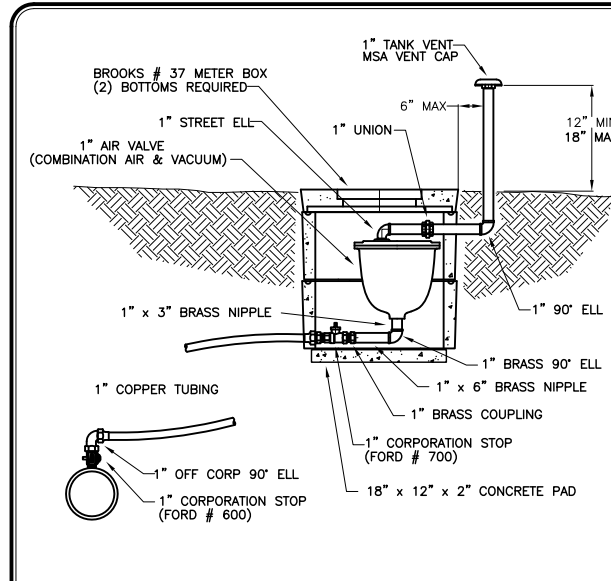


1" COMBINATION AIR & VACUUM VALVE
DETAIL NO. 601
Tualatin Valley Water District

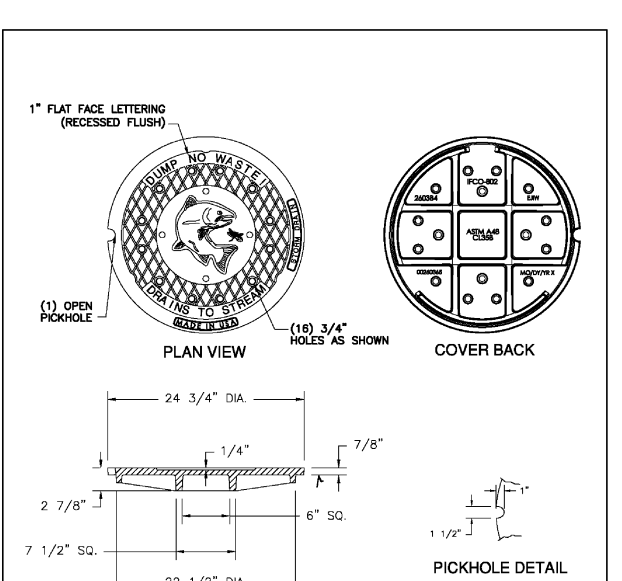

STORM WATER MANHOLE LID
DRAWING NO. 120
REVISED 12-06
CleanWater Services
Our commitment is clear.

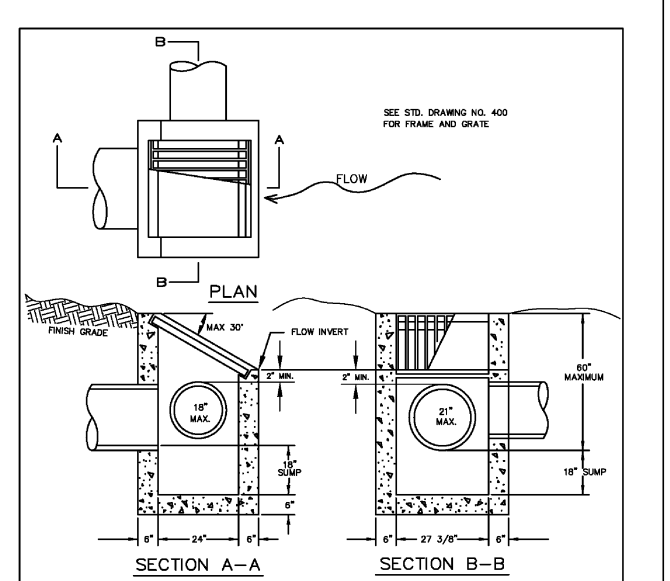

DITCH INLET
DRAWING NO. 390
REVISED 12-06
CleanWater Services
Our commitment is clear.

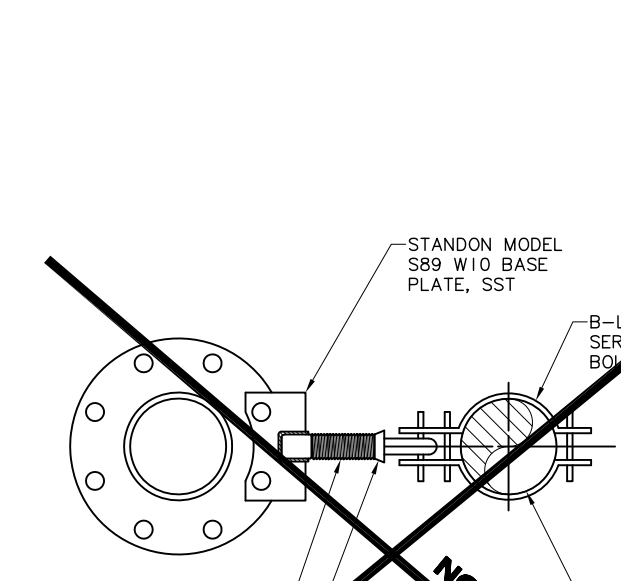

AIR VALVE PIPE SUPPORT
SCALE: NTS

NOTICE
0 1/2 1
IF THIS BAR DOES NOT MEASURE 1" THEN DRAWING IS NOT TO SCALE

SMG DESIGNED
DAK DRAWN
MLH CHECKED

RECORD DRAWING
SEE DISCLAIMER, SHEET 1.
VERSION 4.1
12-9-97

MSA Murray Smith & Associates, Inc.
Engineers/Planners
121 S.W. Salmon, Suite 900 PHONE 503-225-9010
Portland, Oregon 97204 FAX 503-225-9022




WATER SUPPLY IMPROVEMENT PROJECT TRANSMISSION PIPELINE



MISC DETAILS
PROJECT NO.: 07-0873.207 SCALE: AS SHOWN DATE: JUNE 2009

SHEET DT-9
66 of 79


C:\Users\dak\appdata\local\AcPublish_6152\07-0873-207-OR-DETS-R.dwg DT-10 9/2/2011 12:06 PM DAK 18.s (LMS Tech)

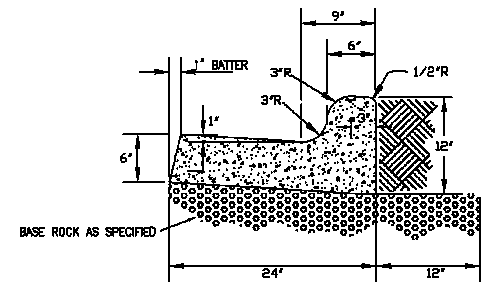

REVISIONS	DATE	STANDARD DRAWING TITLE	DRAWING NUMBER
R-0	11-09-08	CURB AND GUTTER	ST-1
R-1, Revised Title Block	08-01-06		
R-2, Revised Title	12-12-06		
APPROVED BY		DATE	

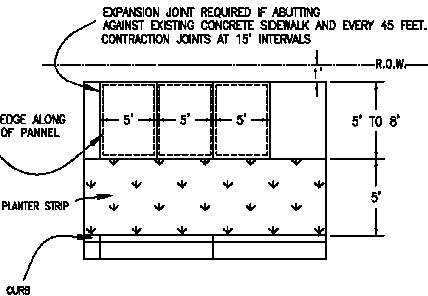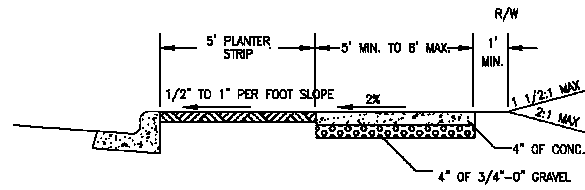

REVISIONS	DATE	STANDARD DRAWING TITLE	DRAWING NUMBER
R-0	11-09-08	TYPICAL SIDEWALK	ST-2
R-1, Revised Title/Notes	08-01-06		
R-2, Revised Title	12-12-06		
APPROVED BY		DATE	

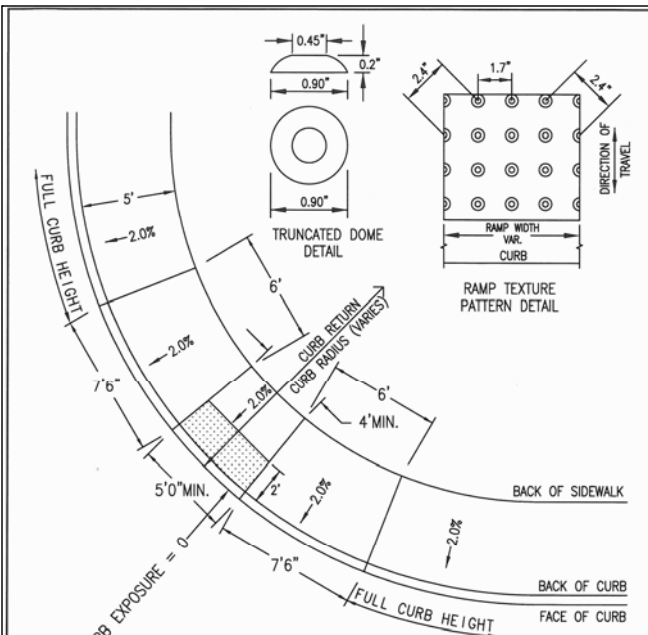

- NOTES:
1. PLANTER STRIP DETAIL - REFER TO ODOT STANDARD DRAWING RD 755 (SIDEWALK RAMP DETAIL)
 2. PLACE TRUNCATED DOME DETECTABLE WARNING TEXTURE IN THE LOWER 24" OF THE THROAT OF THE RAMP ONLY. ARRANGE DOMES USING IN-LINE PATTERN ONLY AS SHOWN IN DETAIL RIGHT. COLOR OF TEXTURE TO BE SAFETY YELLOW. FOR CONSTRUCTION OF SIDEWALK RAMP OUTSIDE OF PUBLIC RIGHT-OF-WAY, CHECK WITH STATE BUILDING CODES.



REVISIONS	DATE	STANDARD DRAWING TITLE	DRAWING NUMBER	
R-0	12-12-06	WHEELCHAIR / BIKE RAMP Attached Sidewalk	ST-7	
APPROVED BY				DATE

- NOTES:
1. CONCRETE SHALL HAVE A COMPRESSIVE STRENGTH OF 3300 PSI @ 28 DAYS.
 2. EXPANSION JOINTS SHALL BE PROVIDED AT:
 - A. AT EACH POINT OF TANGENCY OF THE CURB.
 - B. AT EACH COLD JOINT.
 - C. AT EACH SIDE OF STRUCTURES.
 - D. AT EACH SIDE OF DRIVEWAYS.
 - E. AT LOCATIONS NECESSARY TO LIMIT SPACING TO 45 FEET.
 3. EXPANSION JOINT MATERIAL SHALL BE PREFORMED FILLER TYPE, NON-EXTRUDING MATERIAL OR EQUAL, EXTENDING FROM SUBGRADE TO NOT LESS THAN 1/8" WITHIN FINISH GRADE. EXPANSION JOINT SHALL BE NOT LESS THAN 1/2" WIDE.
 4. CONTRACTION JOINTS:
 - A. SPACING TO BE NOT MORE THAN 15 FEET.
 - B. JOINT DEPTH SHALL BE ONE-THIRD OF THE THICKNESS OF THE CONCRETE AND A MINIMUM OF 1/2".
 - C. JOINT SHALL BE NOT LESS THAN 1/8" INCH NOR MORE THAN 1/4" INCH WIDE.
 5. BASE ROCK TO MATCH STREET SECTION. BASE ROCK UNDER CURB SHALL BE TO SUBGRADE OF STREET STRUCTURE OR 10 INCHES IN DEPTH, WHICHEVER IS GREATER.
 6. CONTRACTION JOINTS IN CURB AND SIDEWALK SHALL ALIGN.
 7. CURING COMPOUND MUST BE VISIBLE AND BE SPREAD EVENLY.
 8. CONCRETE TESTS SHALL BE PERFORMED DURING CURB PLACEMENT. ONE SET OF 3 CYLINDERS SHALL BE CAST FOR EACH 300 LF. OF CURB OR 20 CY. OF CONCRETE. MAXIMUM 1 SET PER DAY. FOR EACH SET OF 3 CYLINDERS TEST FOR SLUMP, AIR CONTENT AND CONCRETE TEMPERATURE.
 9. CONCRETE TO HAVE ENTRAINED AIR, 5% TO 7%, MAXIMUM.
 10. BEFORE CURBS ARE INSTALLED A WHEEL ROLL TEST CONSISTING OF A FULLY LOADED TANDEM AXLE TRUCK OF APPROXIMATELY 50,000 LBS WILL BE WITNESSED BY THE CITY INSPECTOR AND A REPRESENTATIVE OF THE ENGINEERING GROUP THAT DESIGNED THE PROJECT.
 11. ALL PUBLIC AND PRIVATE UTILITIES (CONDUITS) SHALL BE IN PLACE BEFORE CURBS ARE INSTALLED.
 12. DRAINAGE BLOCKOUT -
 - A. BLOCKOUTS ALLOWED BY VARIANCE ONLY, FOR EXISTING STRUCTURES WHERE LATERAL CONNECTION TO EXISTING STORM DRAINAGE SYSTEM IS NOT FEASIBLE.
 - B. 3" I.D. ABS PLASTIC PIPE WITH COUPLING
 - C. DRAINAGE ACCESS THROUGH EXISTING CURB SHALL BE CORE DRILLED

REVISIONS	DATE	STANDARD DRAWING TITLE	DRAWING NUMBER
R-0	11-09-08	CURB NOTES	ST-1-1
R-1, Revised Notes	09-01-06		
R-2, Revised Title	12-12-06		
APPROVED BY		DATE	

- NOTES:
1. CONCRETE SHALL BE A MINIMUM 3300 PSI AT 28 DAYS.
 2. EXPANSION JOINT MATERIAL SHALL BE PREFORMED FILLER TYPE, NON-EXTRUDING MATERIAL OR EQUAL, EXTENDING FROM SUBGRADE TO NOT LESS THAN 1/8" WITHIN FINISH GRADE. EXPANSION JOINT MATERIAL SHALL BE NOT LESS THAN 1/2" WIDE. MATCH ALL SIDEWALK JOINTS WITH CURB JOINTS.
 3. CONTRACTION JOINTS:
 - A. SPACING TO BE NOT MORE THAN 15 FEET.
 - B. THE DEPTH OF THE JOINT SHALL BE ONE-THIRD THE THICKNESS OF THE CONCRETE.
 - C. JOINT SHALL BE NOT LESS THAN 1/8" INCH NOR MORE THAN 1/4" INCH WIDE.
 4. SIDEWALK SHALL HAVE A MINIMUM THICKNESS OF 6" WHEN PART OF A RESIDENTIAL DRIVEWAY AND A MINIMUM THICKNESS OF 8" WHEN PART OF A COMMERCIAL DRIVEWAY, OTHERWISE SIDEWALK SHALL HAVE MINIMUM THICKNESS OF 4".
 5. ALL SIDEWALKS SHALL HAVE A BROOMED SURFACE UNLESS OTHERWISE SPECIFIED. FINISHED SURFACES SHALL BE FREE OF HUMPS, SAGS, OTHER IRREGULARITIES. ALL SURFACES SHALL BE BROOMED TRANSVERSE TO THE DIRECTION OF TRAFFIC. THE EDGES SHALL BE FINISHED WITH A 3" SHINE ON ALL EDGES.
 6. TOOLED "DUMMY" JOINTS AT 5' NOMINAL INTERVALS.
 7. IF DRAIN BLOCKOUTS IN CURBS ARE APPROVED, THEY SHALL BE EXTENDED PERPENDICULAR TO CURBS TO 1' PAST BACK OF SIDEWALK WITH A 3" DIAMETER ABS PIPE. CONTRACTION JOINT SHALL BE PLACED OVER PIPE.

REVISIONS	DATE	STANDARD DRAWING TITLE	DRAWING NUMBER
R-0	09-01-08	SIDEWALK NOTES	ST-2-1
R-1, Note 4 Rev Title	12-12-06		
APPROVED BY			

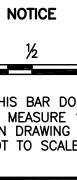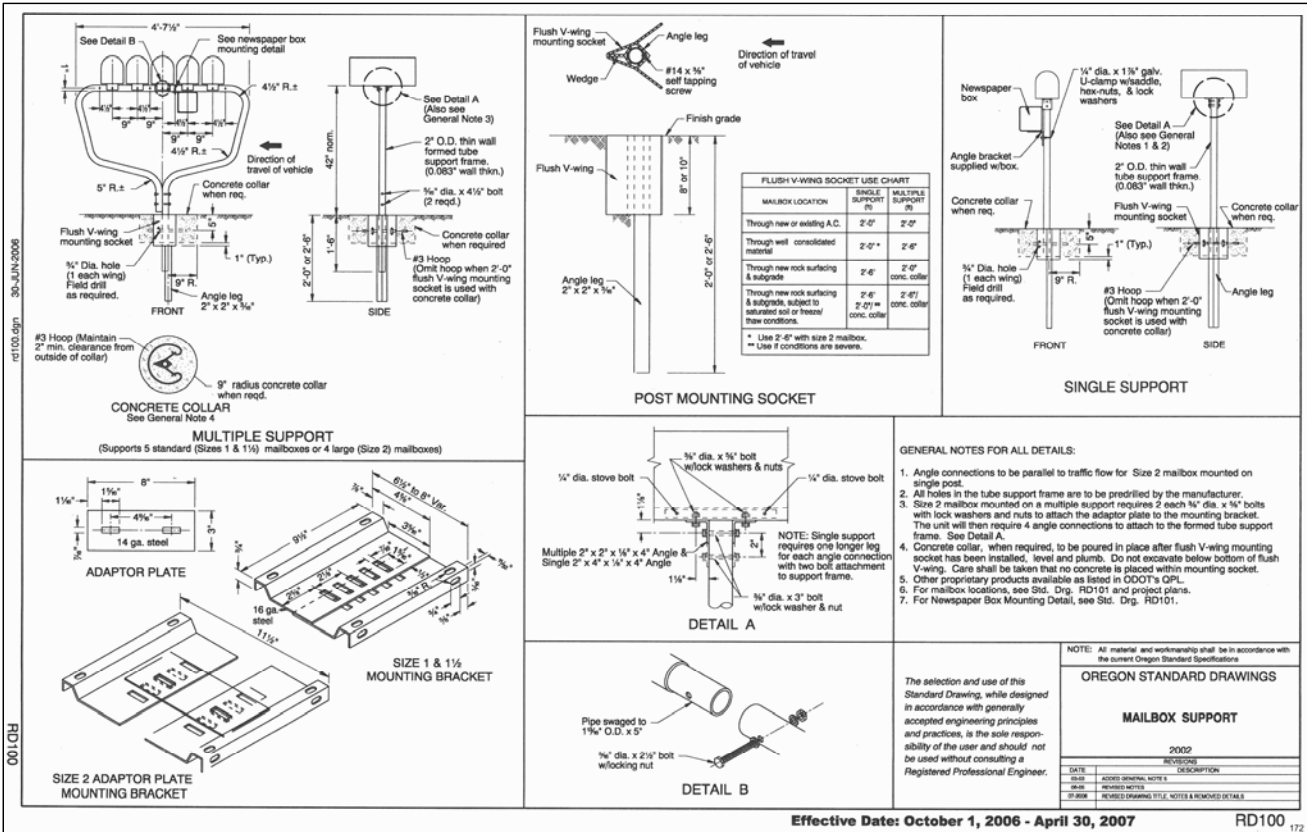

SMG
DESIGNED
DAK
DRAWN
MLH
CHECKED

RECORD DRAWING
SEE DISCLAIMER, SHEET 1.
VERSION 4.1
12-9-97

MSA Murray Smith & Associates, Inc.
Engineers/Planners
121 S.W. Salmon, Suite 900 PHONE 503-225-9010
Portland, Oregon 97204 FAX 503-225-9022




WATER SUPPLY IMPROVEMENT PROJECT TRANSMISSION PIPELINE


MISC DETAILS

SHEET
DT-10
67 of 79


PROJECT NO.: 07-0873.207 SCALE: AS SHOWN DATE: JUNE 2009

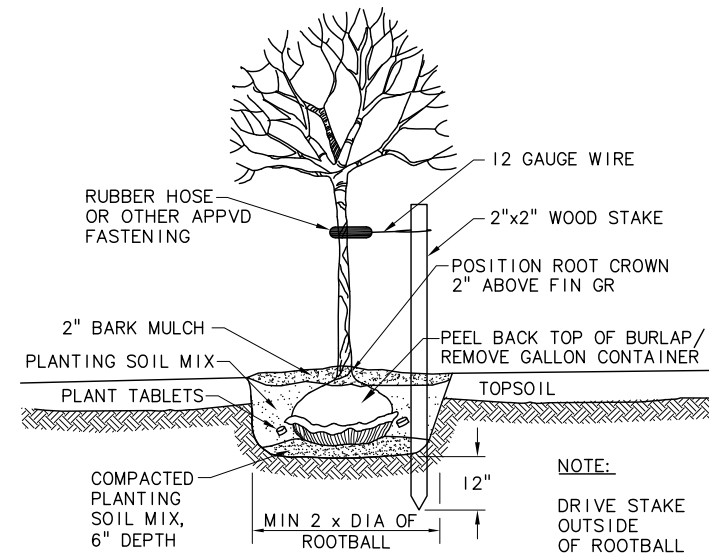

DECIDUOUS TREE PLANTING (1)
SCALE: NTS

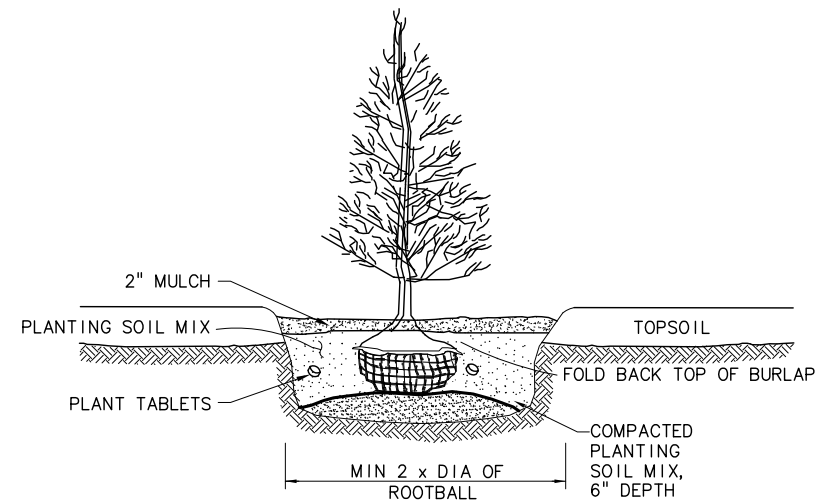

EVERGREEN TREE PLANTING (2)
SCALE: NTS

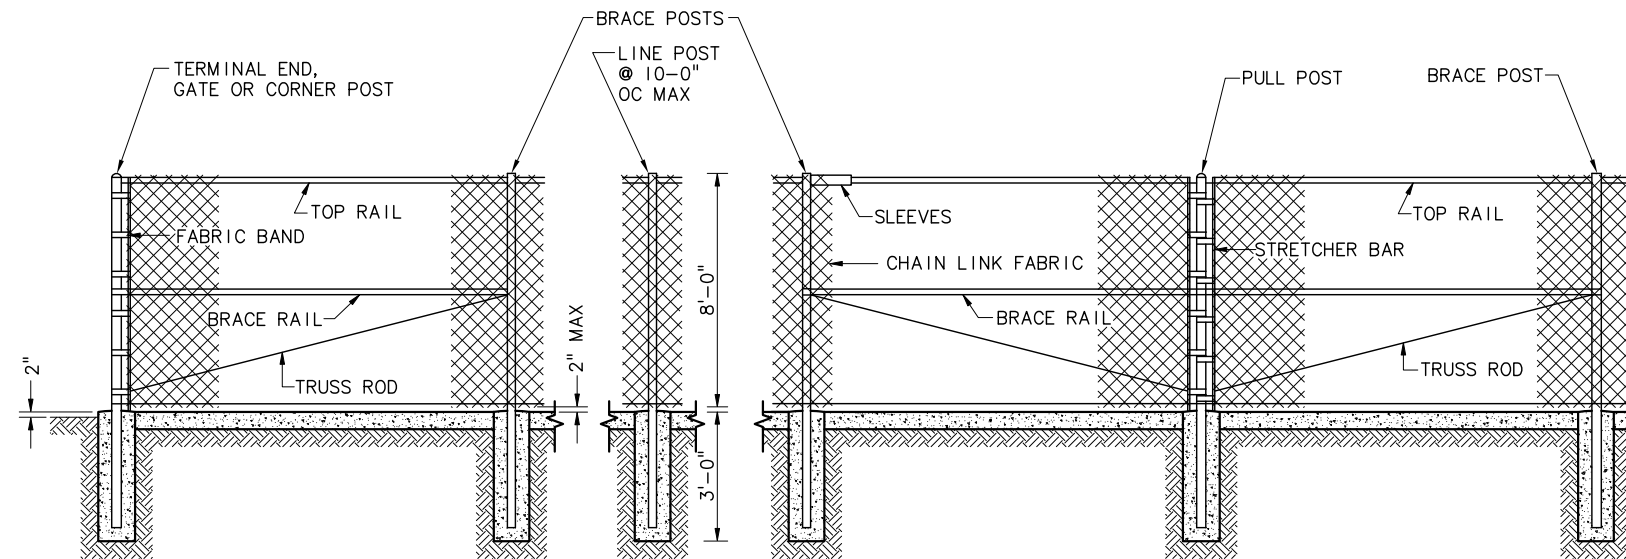

CHAIN LINK FENCE (3)
SCALE: NTS

C:\Users\dak\appdata\local\temp\AcPublish_6152\07-0873-207-OR-DETS-R.dwg DT-11 9/2/2011 12:06 PM DAK 18.1s (LMS Tech)

NO.	DATE	BY	REVISION
3	08/22/11	BVO	RECORD DRAWING

NOTICE
0 1/2 1
IF THIS BAR DOES NOT MEASURE 1" THEN DRAWING IS NOT TO SCALE

SMG
DESIGNED
DAK
DRAWN
MLH
CHECKED

RECORD DRAWING
SEE DISCLAIMER, SHEET 1.
VERSION 4.1
12-9-97

MSA Murray Smith & Associates, Inc.
Engineers/Planners
121 S.W. Salmon, Suite 900 PHONE 503-225-9010
Portland, Oregon 97204 FAX 503-225-9022




WATER SUPPLY IMPROVEMENT PROJECT TRANSMISSION PIPELINE

MISC DETAILS
PROJECT NO.: 07-0873.207 SCALE: AS SHOWN DATE: JUNE 2009

SHEET
DT-11
68 of 79


C:\Users\dak\appdata\local\temp\AcPublish_6152\07-0873-207-OR-DETS-R.dwg DT-12 9/2/2011 12:06 PM DAK 18.1s (LMS Tech)

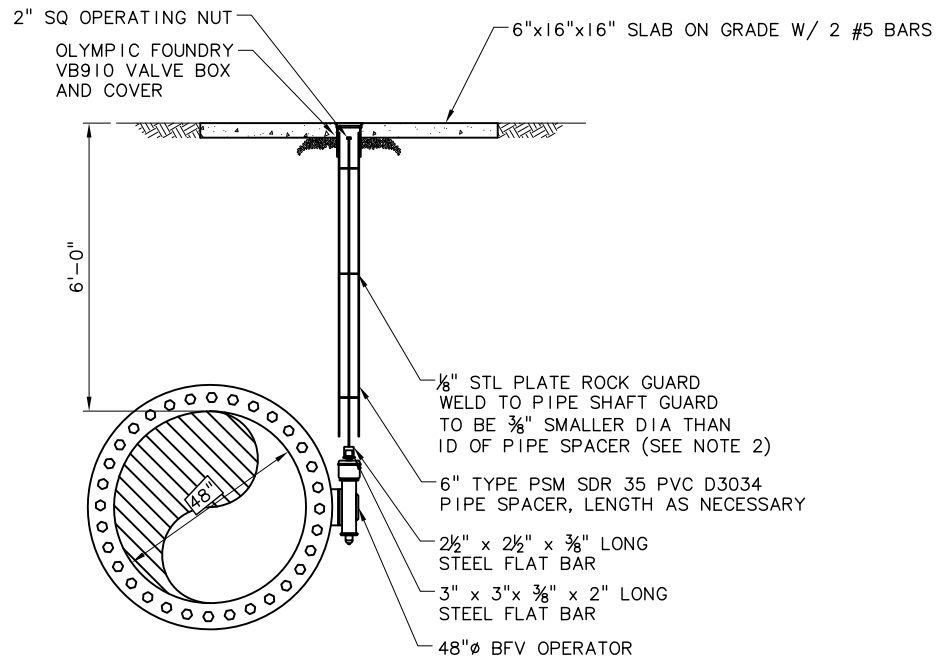

NOTES:

1. EXTEND 2" NUT TO WITHIN 18" OF FINISH GRADE WHEN VALVE NUT IS DEEPER THAN 3 FEET FROM FINISHED GRADE.
2. WHERE DEPTH IS OVER 6 FEET, A SECOND PLATE WILL BE INSTALLED EQUALLY BETWEEN ROCK GUARD AND 2" VALVE NUT.

48" BFV BOX IN AGRICULTURAL AREA (1)
SCALE: NTS

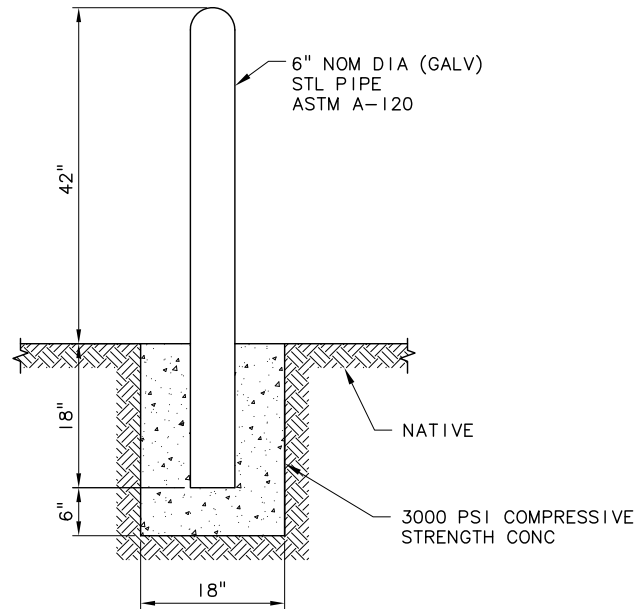

BOLLARD DETAIL (2)
SCALE: NTS

NO.	DATE	BY	REVISION
1	08/22/11	BVO	RECORD DRAWING

NOTICE
0 1/2 1
IF THIS BAR DOES NOT MEASURE 1" THEN DRAWING IS NOT TO SCALE

SMG DESIGNED
DAK DRAWN
MLH CHECKED

RECORD DRAWING
SEE DISCLAIMER, SHEET 1.
VERSION 4.1
12-9-97


MSA Murray Smith & Associates, Inc.
Engineers/Planners
121 S.W. Salmon, Suite 900 PHONE 503-225-9010
Portland, Oregon 97204 FAX 503-225-9022




WATER SUPPLY IMPROVEMENT PROJECT TRANSMISSION PIPELINE

MISC DETAILS			
PROJECT NO.: 07-0873.207	SCALE: AS SHOWN	DATE: JUNE 2009	


C:\Users\dak\appdata\local\temp\AcPublish_6152\07-0873-207-OR-DETS-R.dwg DT-13 9/2/2011 12:06 PM DAK 18.1s (LMS Tech)

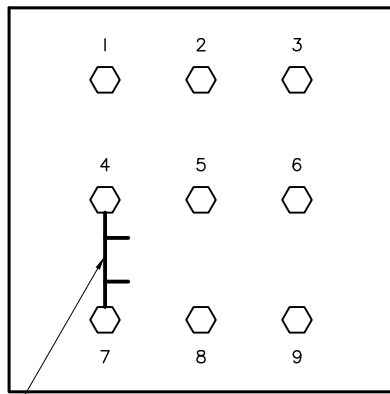


TYPE A
(STANDARD)

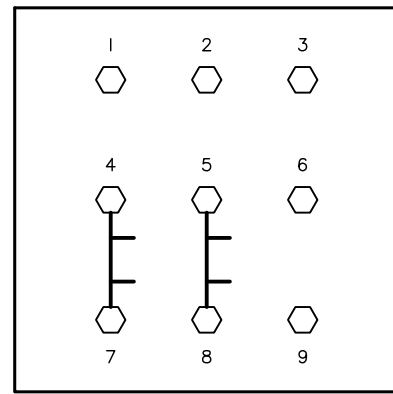

TYPE B
(INLINE INSULATION JOINT)

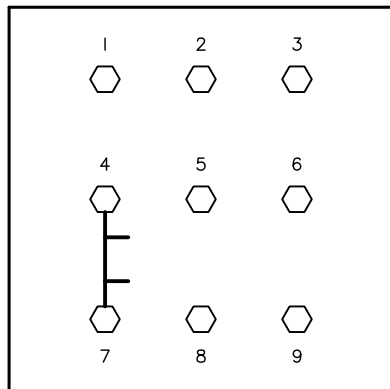



TYPE C
(INSULATION JOINT)

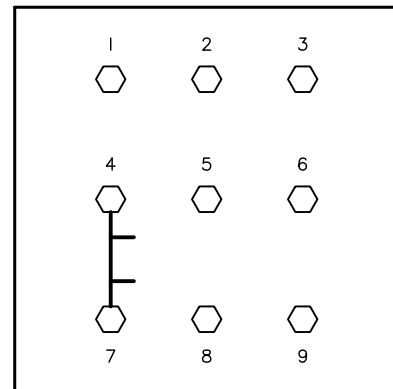

TYPE D
(FOREIGN LINE CROSSING)

TEST STATION WIRING

SCALE: NTS

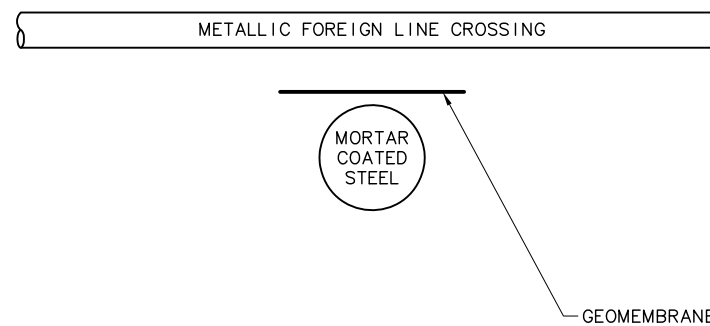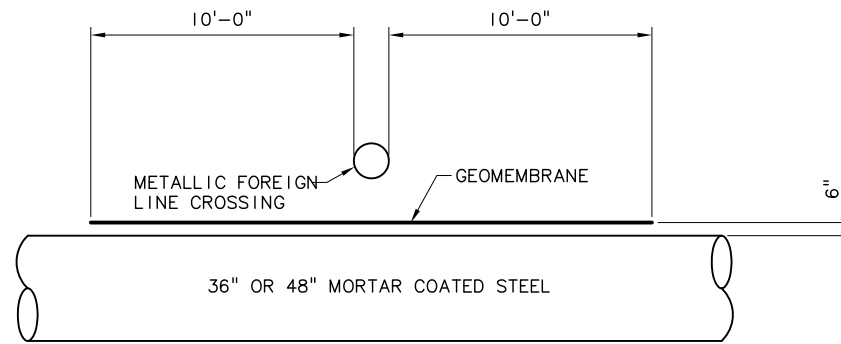

NOTE: GEOMEMBRANE TO BE 6 FEET WIDE.

GEOMEMBRANE INSTALLATION

SCALE: NTS



TS TYPE	#1 IDENTIFICATION	#1 WIRE SIZE	#1 COLOR CODE	#2 IDENTIFICATION	#2 WIRE SIZE	#2 COLOR CODE	#3 IDENTIFICATION	#3 WIRE SIZE	#3 COLOR CODE	#4 IDENTIFICATION	#4 WIRE SIZE	#4 COLOR CODE	#5 IDENTIFICATION	#5 WIRE SIZE	#5 COLOR CODE	#6 IDENTIFICATION	#6 WIRE SIZE	#6 COLOR CODE	#7 IDENTIFICATION	#7 WIRE SIZE	#7 COLOR CODE	#8 IDENTIFICATION	#8 WIRE SIZE	#8 COLOR CODE	#9 IDENTIFICATION	#9 WIRE SIZE	#9 COLOR CODE
A	N	#12	BL							N	#8	BL							A	#12	BK				R	#12	Y
B	N	#12	BL	N	#12	WS	N	#6	BL	N	#8	BL	N	#8	WS	N	#6	W	A	#12	BK	A	#12	BK	R	#12	Y
C	N	#12	BL	NP	#12	G				N	#8	BL	NP	#8	G				A	#12	BK				R	#12	Y
D	N	#12	BL	G/W	#12	O				N	#8	BL	G/W	#8	O				A	#12	BK				R	#12	Y

IDENTIFICATION

N = NEW PIPE
 N/US = NEW PIPE (UP STATION)
 N/DS = NEW PIPE (DOWN STATION)
 E = EXISTING PIPE
 NP = NON-PROTECTED
 F = FOREIGN PIPE (G=GAS, W=WATER)
 A = ANODE
 R = REFERENCE ELECTRODE

WIRE SIZE

#8 & 12
 #6, 8, & 12
 #6, 8, & 12
 #8 & 12
 #8 & 12
 #8 & 12
 #12 & 12

COLOR CODE

BL = BLUE
 BL = BLUE
 W = WHITE
 G = GREEN
 G = GREEN
 O = ORANGE
 BK = BLACK
 Y = YELLOW

TEST STATION IDENTIFICATION & COLOR CODE

SCALE: NTS



NO.	DATE	BY	REVISION
1	08/22/11	BVO	RECORD DRAWING

NOTICE
 0 1/2 1
 IF THIS BAR DOES NOT MEASURE 1" THEN DRAWING IS NOT TO SCALE

SMG DESIGNED
 DAK DRAWN
 MLH CHECKED

RECORD DRAWING
 SEE DISCLAIMER, SHEET 1.
 VERSION 4.1
 12-9-97


MSA Murray Smith & Associates, Inc.
 Engineers/Planners
 121 S.W. Salmon, Suite 900 PHONE 503-225-9010
 Portland, Oregon 97204 FAX 503-225-9022



WATER SUPPLY IMPROVEMENT PROJECT TRANSMISSION PIPELINE


CORROSION CONTROL DETAILS-1

PROJECT NO.: 07-0873.207 SCALE: AS SHOWN DATE: JUNE 2009

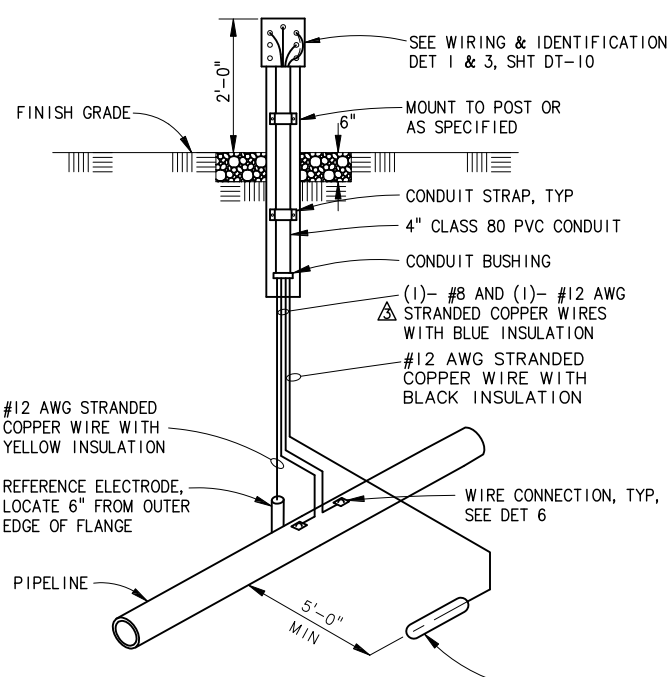


- NOTES:**
1. INSTALL GALVANIC ANODE 1'-0" BELOW PIPE INVERT ELEVATION.
 2. INSTALL 2 1/2" SQUARE 3/4"-0" ROCK BLANKET AROUND ALL TEST STATION POSTS.


**POST MOUNTED TEST STATION (TS)
TYPE A - STANDARD** (1)
SCALE: NTS

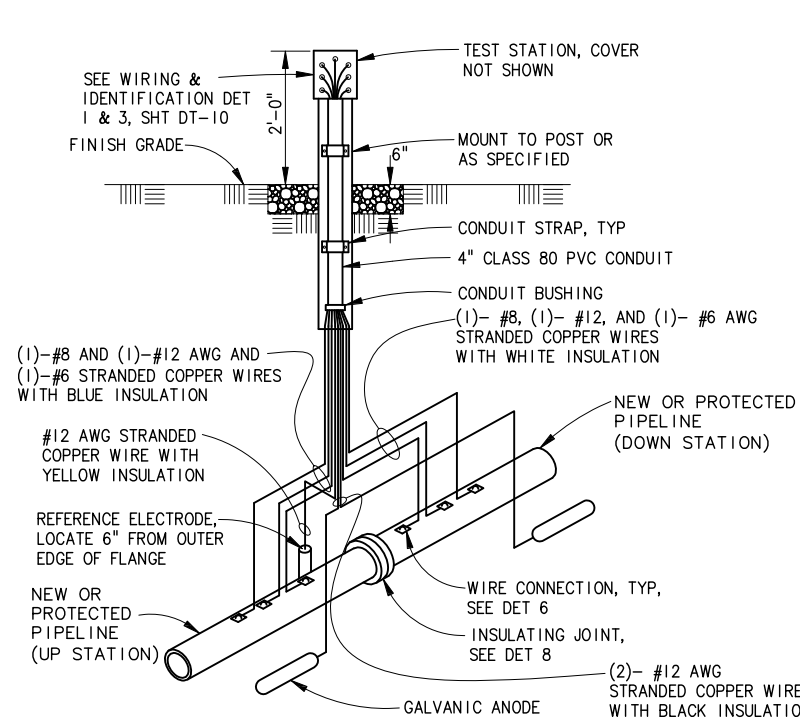

**POST MOUNTED TEST STATION (TS)
TYPE B - INLINE INSULATION JOINT** (2)
SCALE: NTS


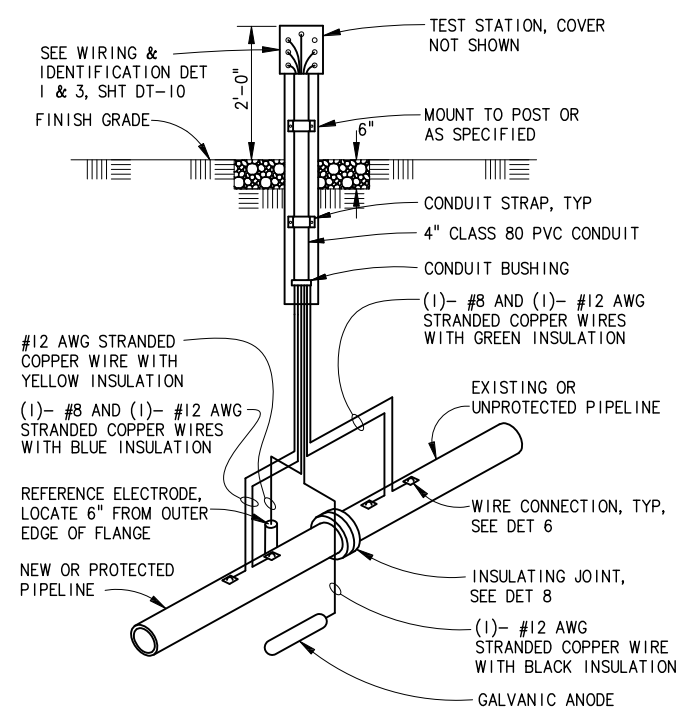


**POST MOUNTED TEST STATION (TS)
TYPE C - INSULATION JOINT** (3)
SCALE: NTS

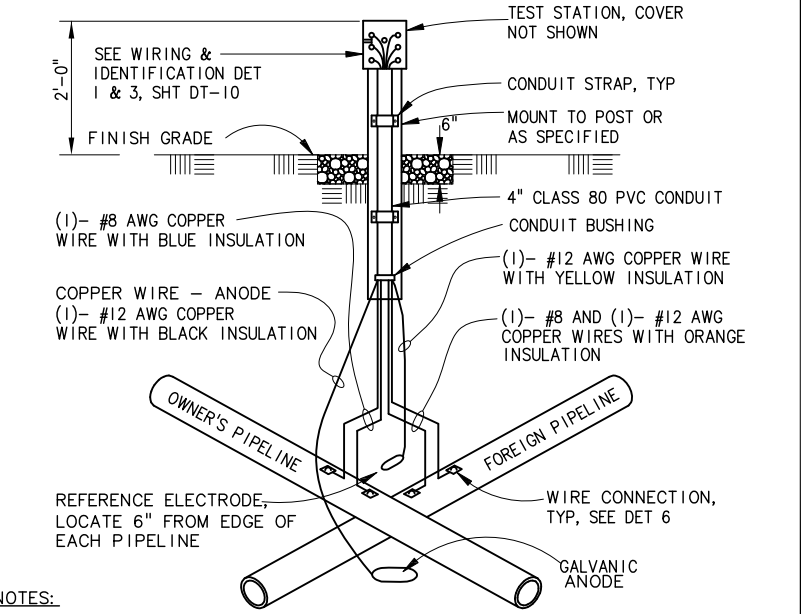


- NOTES:**
1. OBTAIN APPROVAL OF FOREIGN PIPELINE OWNER PRIOR TO EXCAVATION.
 2. WIRE CONNECTIONS TO FOREIGN PIPELINE SHALL BE MADE BY FOREIGN PIPELINE REPRESENTATIVE.
 3. INSTALL REFERENCE ELECTRODE OR COUPONS (2 EA) ONLY AT TEST STATIONS INDICATED ON TEST STATION LOCATION SCHEDULE OR DRAWINGS.
 4. COLOR CODE WIRES ACCORDING TO WIRE COLOR CODE, SEE DETAIL 3, SHT D-10.

**POST MOUNTED TEST STATION (TS)
TYPE D - FOREIGN LINE CROSSING** (4)
SCALE: NTS

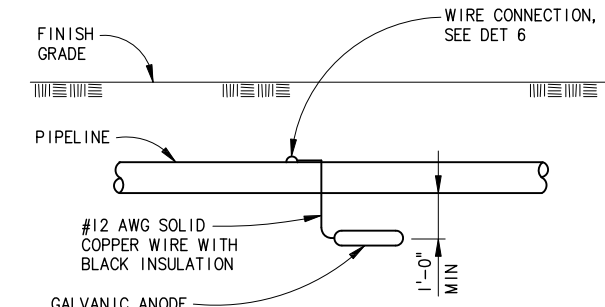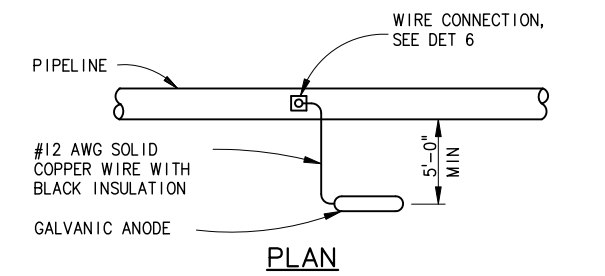


- NOTES:**
1. GALVANIC ANODE TO BE INSTALLED IN NATIVE SOIL.
 2. ANODE TO BE SUBMERGED IN WATER FOR 1 HOUR PRIOR TO INSTALLATION.
 3. SEE SPECIFICATION 13989 FOR REQUIRED NUMBER AND LOCATION OF ANODES.

**GALVANIC ANODE
INSTALLATION** (5)
SCALE: NTS

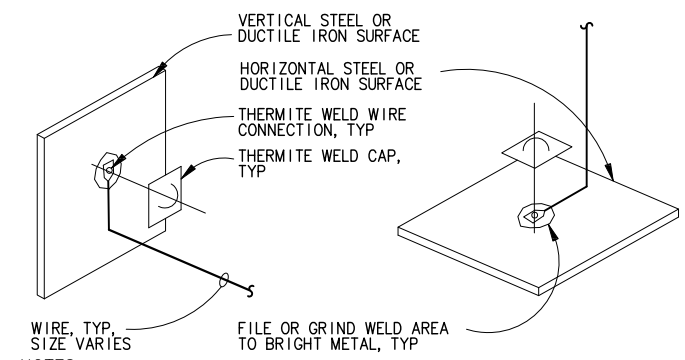


- NOTES:**
1. COPPER SLEEVE REQUIRED FOR THERMITE WELDING OF #10 AWG AND SMALLER WIRE.
 2. USE COPPER SLEEVE FOR THERMITE WELDING OF #2 AWG WIRES.
 3. WELDER AND CARTRIDGE SIZE VARIES ACCORDING TO SURFACE SHAPE, MATERIAL, AND HORIZONTAL OR VERTICAL SURFACE. CONSULT WELDER MANUFACTURER FOR RECOMMENDED WELDER AND CARTRIDGE.
 4. FOR MULTIPLE WIRE CONNECTIONS TO PIPE SEPARATE THERMITE WELD WIRE CONNECTIONS BY ONE PIPE DIAMETER MINIMUM, 2'-0" MAXIMUM.
 5. THERMITE WELD CAP NOT REQUIRED FOR CEMENT COATED SURFACES OR ABOVE GRADE WIRE CONNECTIONS. COAT COMPLETED THERMITE WELD CONNECTIONS AS SPECIFIED.
 6. EXOTHERMIC WELD TO BE PERFORMED AT JOINTS. CONNECTION TO BE COATED WITH MORTAR WHEN COMPLETED.

**EXOTHERMIC WELD CONNECTION
PIPE CABLE CONNECTION** (6)
SCALE: NTS

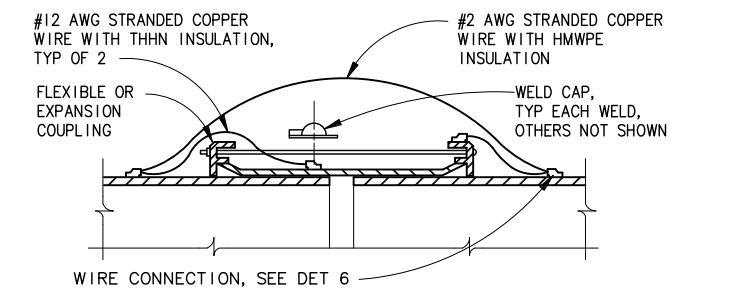

JOINT BOND (7)
SCALE: NTS

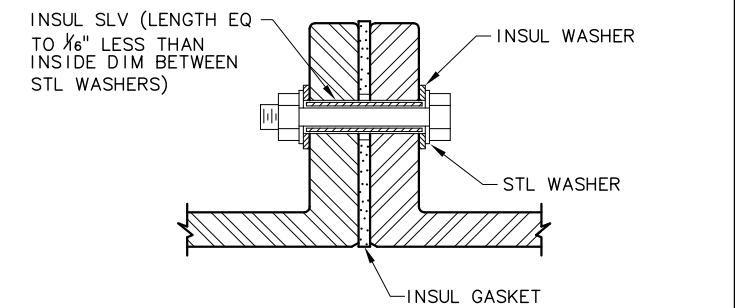

- NOTES:**
1. FOR BURIED OR SUBMERGED INSULATING FLANGE INSTALLATION, DO NOT INSTALL INSULATING WASHER ON PROTECTED SIDE OF INSULATING FLANGE.
 2. COAT BURIED OR SUBMERGED INSULATING FLANGES WITH COLD APPLIED COAL TAR MASTIC AFTER ASSEMBLING JOINT AND WRAP WITH A BUTYL RUBBER ADHESIVE, POLYETHYLENE BACKED TAPE.

INSULATION JOINT (8)
SCALE: NTS

C:\Users\dak\appdata\local\temp\AcPublish_6152\07-0873-207-OR-DETS-R.dwg DT-14 9/2/2011 12:06 PM DAK 18.1s (LMS Tech)

NO.	DATE	BY	REVISION
1	08/22/11	BVO	RECORD DRAWING

NOTICE

0 1/2 1

IF THIS BAR DOES NOT MEASURE 1" THEN DRAWING IS NOT TO SCALE

SMG DESIGNED
DAK DRAWN
MLH CHECKED

RECORD DRAWING

SEE DISCLAIMER, SHEET 1.

VERSION 4.1
12-9-97

MSA Murray Smith & Associates, Inc.
Engineers/Planners

121 S.W. Salmon, Suite 900
Portland, Oregon 97204

PHONE 503-225-9010
FAX 503-225-9022

WATER SUPPLY IMPROVEMENT PROJECT TRANSMISSION PIPELINE



City of Sherwood Oregon

CORROSION CONTROL DETAILS-2

PROJECT NO.: 07-0873.207 SCALE: AS SHOWN DATE: JUNE 2009

SHEET DT-14 71 of 79

C:\Users\dak\appdata\local\temp\AcPublish_6152\07-0873-207-OR-DETS-R.dwg DT-15 9/2/2011 12:06 PM DAK 18.is (LMS Tech)

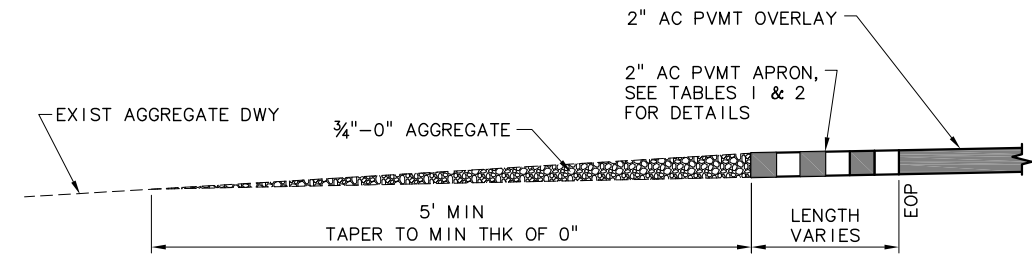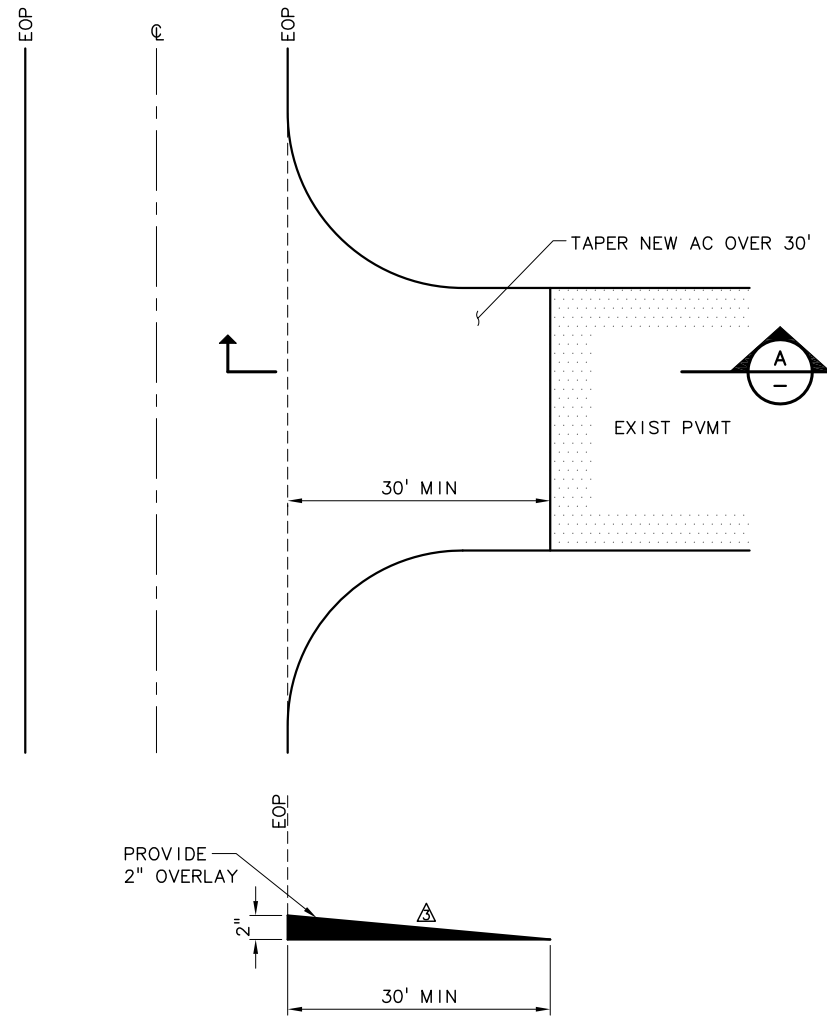

**TABLE 1: BAKER ROAD
PRIMARY & SECONDARY DRIVEWAY APRONS**

STA	SHT	LT/RT	APPROX WIDTH	LENGTH
B1+05	C-8	LT	21'	1'
B1+40	C-8	RT	22'	3'
B1+64	C-8	LT	19'	1'
B2+02	C-8	RT	25'	3'
B3+92	C-8	LT	16'	3'
B4+28	C-8	LT	23'	3'
B6+67	C-9	RT	35'	3'
B9+32	C-9	LT	30'	3'
B9+38	C-9	RT	22'	3'
B11+20	C-10	RT	10'	1'
B13+30	C-10	RT	10'	1'
B16+92	C-11	RT	40'	3'
B19+00	C-11	RT	12'	1'
B27+85	C-12	RT	7'	1'
B32+06	C-13	LT	10'	3'
B32+40	C-13	RT	15'	1'
B36+30	C-14	RT	43'	3'
B50+00	C-17	LT	10'	1'
B57+80	C-18	LT	15'	1'
B62+70	C-19	LT	24'	3'
B64+23	C-19	LT	20'	3'

**TABLE 2: TOOZE ROAD
PRIMARY & SECONDARY DRIVEWAY APRONS**

STA	SHT	LT/RT	APPROX WIDTH	LENGTH
D1+60	C-29	LT	16'	1'
D3+49	C-29	LT	12'	1'
D4+21	C-29	LT	22'	3'
D7+64	C-30	LT	20'	1'
D9+35	C-30	LT	50'	1'
D13+13	C-31	RT	23'	3'
D16+94	C-32	LT	20'	3'
D17+49	C-32	LT	12'	3'
D18+56	C-32	LT	25'	3'
D21+19	C-32	LT	26'	3'
D25+88	C-33	LT	59'	3'
D27+17	C-33	LT	32'	1'

NOTE:


1. PER CLACKAMAS COUNTY, PRIMARY AND SECONDARY DRIVEWAYS SHALL BE 3' AND 1' IN LENGTH, RESPECTIVELY.

STREET CONNECTION TABLE

STA	LT	RT	EXIST APPROACH TYPE	WIDTH AT GRIND LIMITS	COMMENTS
"A" 20+40		X	ASPHALT	25'	SE ALDERGROVE AVE
"A" 27+20		X	ASPHALT	34'	SE BRITTANY LN
"A" 36+70	X		ASPHALT	30'	BAKER RD
"A" 41+60		X	ASPHALT	30'	CORNERSTONE LN
"A" 46+20		X	ASPHALT	30'	LAVON LN
"B" 26+50		X	ASPHALT	25'	McCONNELL RD
"B" 30+60	X		ASPHALT	25'	MORGAN RD
"D" 0+70	X		ASPHALT	60'	KAME TERRACE
"D" 13+70	X		ASPHALT	22'	MALLOY WAY
"D" 30+25		X	ASPHALT	26'	WESTFALL RD

DRIVEWAY APPROACH - AGGREGATE (3)

SCALE: NTS

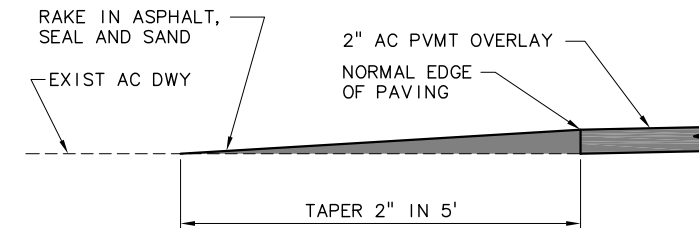

DRIVEWAY APPROACH - ASPHALT (4)

SCALE: NTS

STREET CONNECTION (1)

SCALE: NTS

NO.	DATE	BY	REVISION
1	08/22/11	BVO	RECORD DRAWING

NOTICE

0 1/2 1

IF THIS BAR DOES NOT MEASURE 1" THEN DRAWING IS NOT TO SCALE

SMG DESIGNED
DAK DRAWN
WSE CHECKED

RECORD DRAWING

SEE DISCLAIMER, SHEET 1.

VERSION 4.1
12-9-97

MSA Murray Smith & Associates, Inc.
Engineers/Planners

121 S.W. Salmon, Suite 900 PHONE 503-225-9010
Portland, Oregon 97204 FAX 503-225-9022

City of Sherwood Oregon


WATER SUPPLY IMPROVEMENT PROJECT TRANSMISSION PIPELINE

ROADWAY SECTIONS & DETAILS-1

PROJECT NO.: 07-0873.207 SCALE: AS SHOWN DATE: JUNE 2009

SHEET DT-15

72 of 79

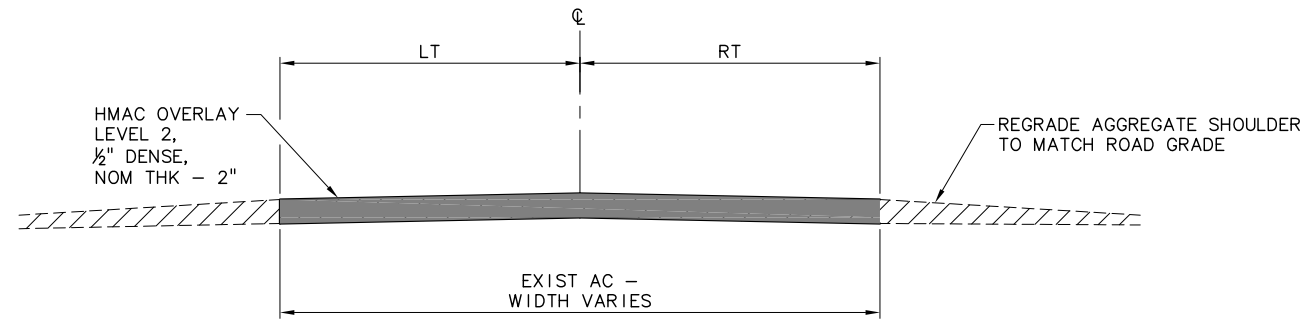


TYPICAL SECTION TABLE			
BEGIN STA	END STA	NORTHBOUND	SOUTHBOUND
"B" 0+00	"B" 64+59	10'-11"	10'-11"
"D" 0+00	"D" 32+40	10'-11"	10'-11"

NOTE:

1. SEE TYPICAL TRENCH SECTION FOR SURFACING REQUIREMENT.


2" OVERLAY TYPICAL SECTION (1)

SCALE: NTS

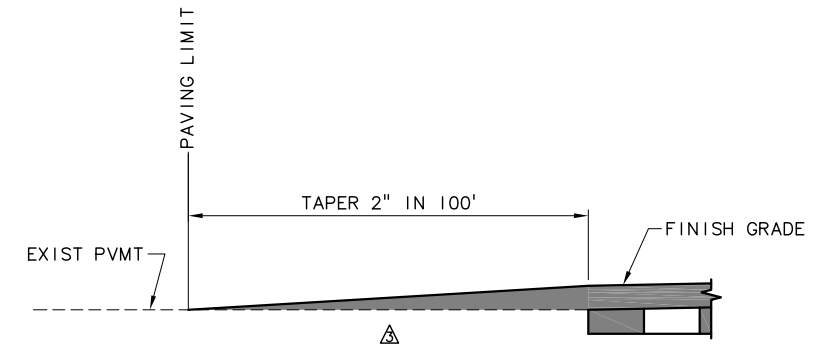

MATCHING PAVEMENT AT PROJECT ENDS (2)

SCALE: NTS

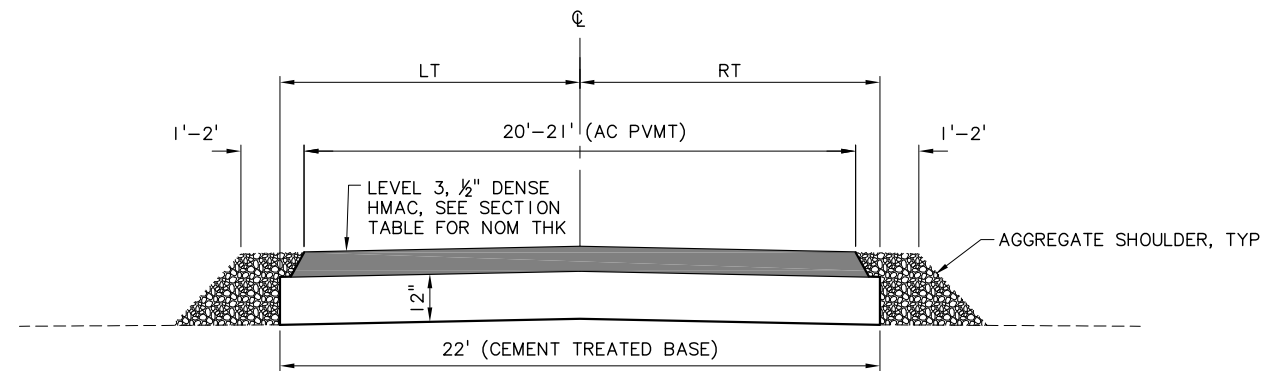

STA B0+00 TO STA B64+59 (BAKER ROAD)
 STA D0+00 TO STA D29+29 (TOOZE ROAD)

SECTION TABLE		
HMAC COURSE	BAKER ROAD	TOOZE ROAD
WEARING	1 1/2"	2"
BASE	2"	2 1/2"

NOTE:

1. ON LEFT SIDE OF ROADWAY, 5% CEMENT BY WEIGHT WAS MIXED WITH 12" OF 3/4"-0" FROM PIPE TRENCH. ON RIGHT SIDE OF ROADWAY, 5% CEMENT BY WEIGHT WAS MIXED WITH 12" OF BASE MATERIAL CONSISTING OF PULVERIZED ASPHALT CONCRETE AND NATIVE SOIL FOUND BENEATH EXISTING ASPHALT CONCRETE.

CLACKAMAS COUNTY ROADWAY SECTION (3)

SCALE: NTS

C:\Users\dak\appdata\local\temp\AcPublish_6152\07-0873-207-OR-DETS-R.dwg DT-16 9/2/2011 12:06 PM DAK 18.1s (LMS Tech)

NO.	DATE	BY	REVISION
1	08/22/11	BVO	RECORD DRAWING

NOTICE

IF THIS BAR DOES NOT MEASURE 1" THEN DRAWING IS NOT TO SCALE

SMG DESIGNED
 DAK DRAWN
 WSE CHECKED

RECORD DRAWING
 SEE DISCLAIMER, SHEET 1.
 VERSION 4.1
 12-9-97

MSA Murray Smith & Associates, Inc.
 Engineers/Planners
 121 S.W. Salmon, Suite 900 PHONE 503-225-9010
 Portland, Oregon 97204 FAX 503-225-9022

City of Sherwood Oregon


WATER SUPPLY IMPROVEMENT PROJECT TRANSMISSION PIPELINE

ROADWAY SECTIONS & DETAILS-2

PROJECT NO.: 07-0873.207 SCALE: AS SHOWN DATE: JUNE 2009


SHEET
 DT-16
 73 of 79

C:\PDX_Projects\07_0873\207_Design-Final_Plans\CAD\07-0873-207-OR-DETS-R.dwg DT-17 9/8/2011 1:15 PM DAK 18.is (LMS Tech)

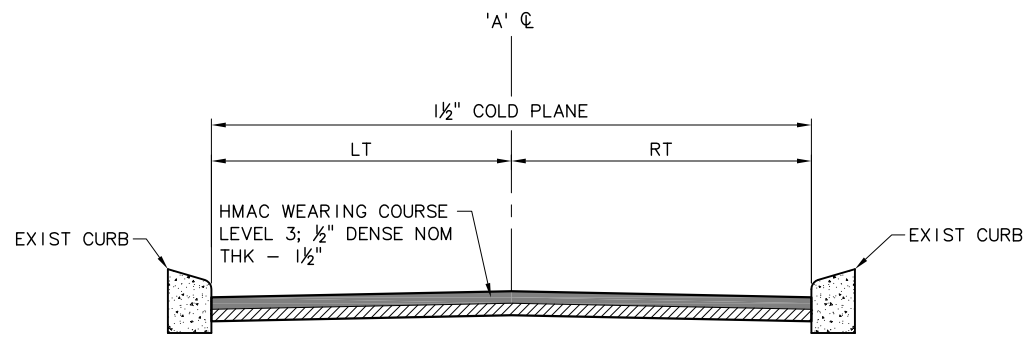


STA A16+00 TO STA A36+45 (SUNSET BLVD)
STA A43+70 TO STA A47+60 (BAKER ROAD)

1 1/2" COLD PLANE AND 1 1/2" INLAY (1)
SCALE: NTS

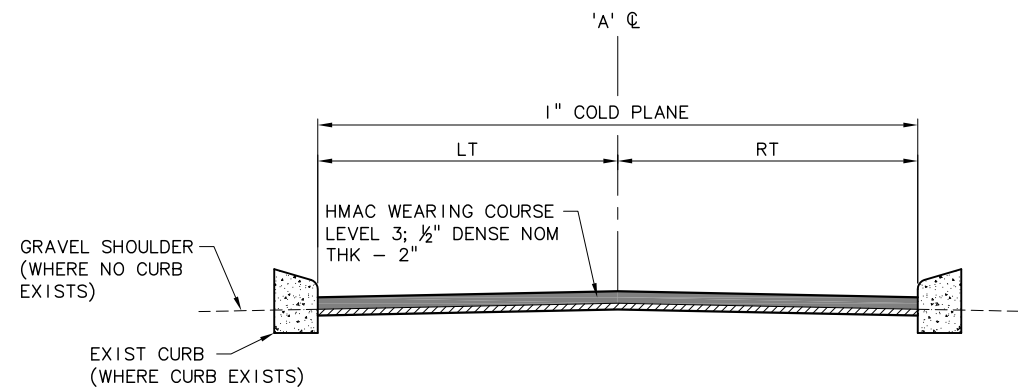

1" COLD PLANE AND 2" INLAY (BAKER RD) (2)
SCALE: NTS

BEG STA	END STA	WESTBOUND	EASTBOUND
A16+00	A16+50	0'	21'
A16+50	A17+10	0'	22'
A17+10	A17+90	0'	24'
A17+90	A18+50	0'	25'
A18+50	A19+90	0'	26'
A19+90	A20+90	0'	18'
A20+90	A21+20	0'	27'
A21+20	A21+40	0'	28'
A21+40	A21+70	0'	29'
A21+70	A25+70	0'	28'
A25+70	A26+50	0'	27'
A26+50	A26+80	0'	26'
A26+80	A27+00	0'	25'
A27+00	A27+20	0'	24'
A27+20	A27+40	0'	23'
A27+40	A28+80	0'	20'
A28+80	A29+00	0'	17'
A29+00	A29+40	0'	16'
A29+40	A30+90	0'	15'
A30+90	A31+60	0'	14'
A31+60	A32+20	13'	13'
A32+20	A32+40	13'	0'
A32+40	A33+30	14'	0'
A33+30	A33+70	15'	0'
A33+70	A34+40	16'	0'
A34+40	A35+00	17'	0'
A35+00	A35+20	19'	0'
A35+20	A35+40	20'	0'
A35+40	A35+80	21'	0'
A35+80	A36+20	19'	0'
A36+20	A36+40	18'	0'
A36+40	A36+45	20'	0'
A43+70	A43+80	13'	15'
A43+80	A44+00	12'	15'
A44+00	A44+90	12'	14'
A44+90	A47+60	13'	13'

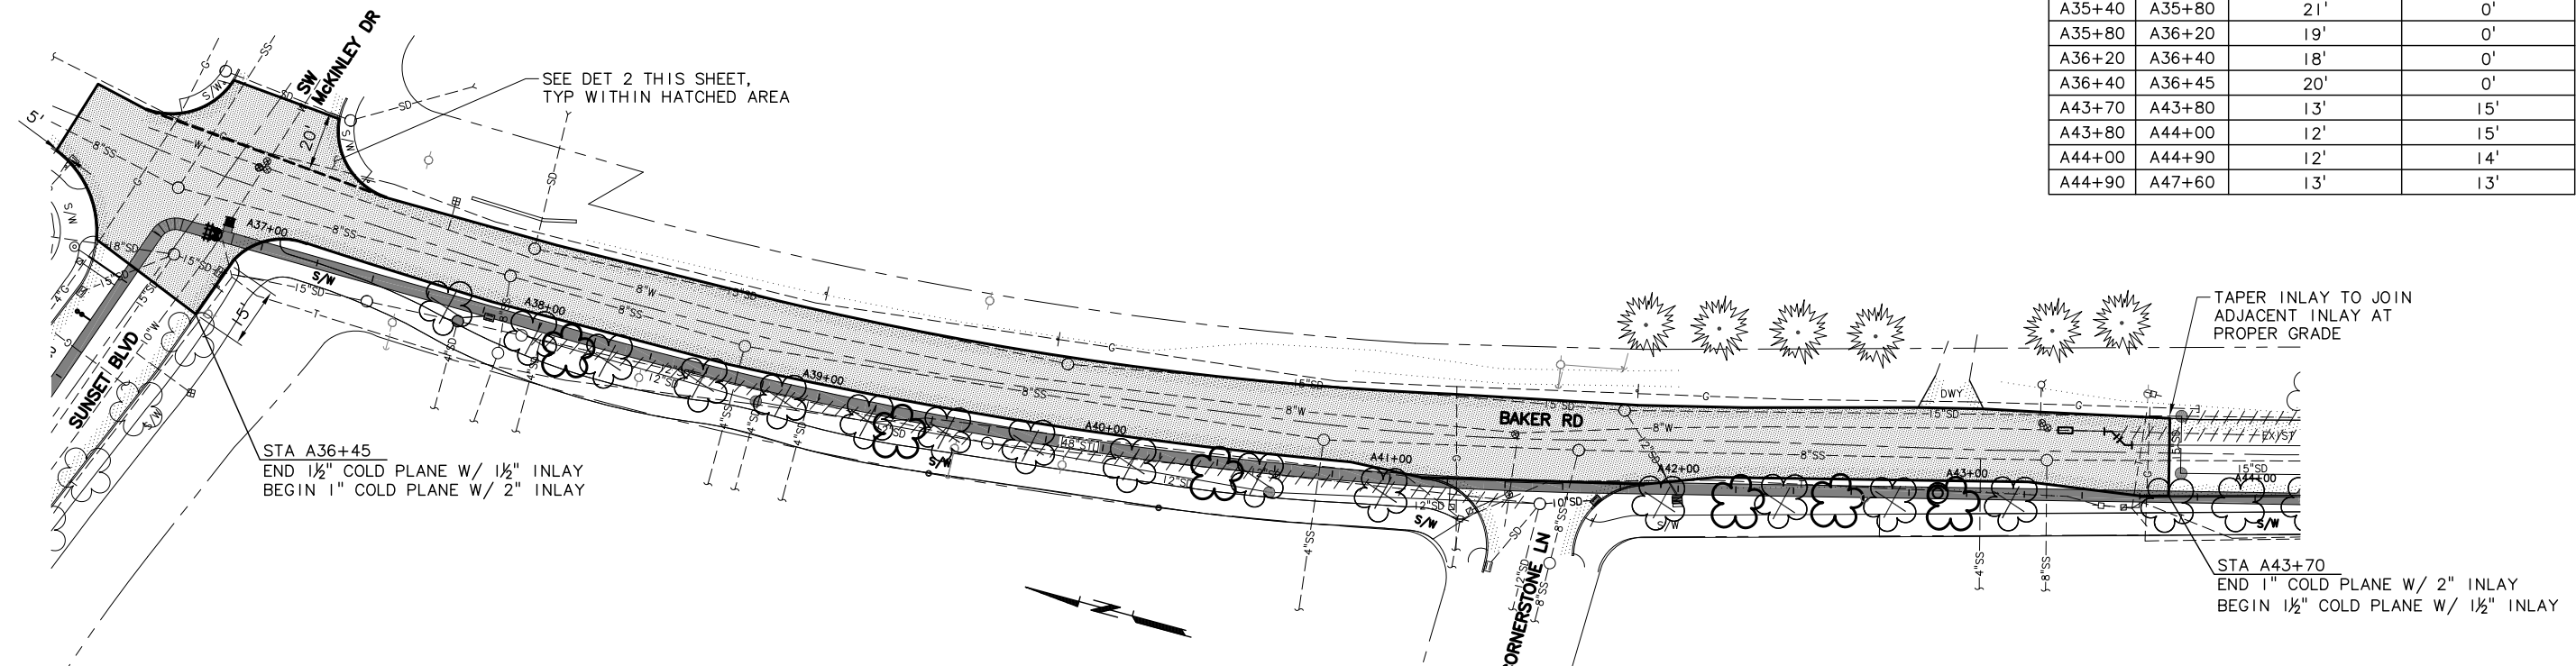

PLAN
SCALE: 1" = 30'

NO.	DATE	BY	REVISION
1	08/22/11	BVO	RECORD DRAWING

NOTICE

IF THIS BAR DOES NOT MEASURE 1" THEN DRAWING IS NOT TO SCALE

SMG DESIGNED
DAK DRAWN
WSE CHECKED

RECORD DRAWING
SEE DISCLAIMER, SHEET 1.
VERSION 4.1
12-9-97

MSA Murray Smith & Associates, Inc.
Engineers/Planners
121 S.W. Salmon, Suite 900 PHONE 503-225-9010
Portland, Oregon 97204 FAX 503-225-9022

City of Sherwood Oregon


WATER SUPPLY IMPROVEMENT PROJECT TRANSMISSION PIPELINE

ROADWAY SECTIONS & DETAILS-3

PROJECT NO.: 07-0873.207 SCALE: AS SHOWN DATE: JUNE 2009

NOTES:

1. INSTALL 2" PVC SCH 40 CONDUIT BETWEEN JUNCTION BOXES. PROVIDE MINIMUM 36" COVER. SWEEPS TO BE 36" RADIUS, MINIMUM. NUMBER OF BENDS PER RUN CANNOT EXCEED THREE.
2. POTHOLE TO LOCATE EXISTING 2" CONDUIT FROM WEST. SPLICE NEW 2" CONDUIT TO EXISTING 2" CONDUIT AND EXTEND TO NEW JUNCTION BOX. STUB ALL 3 CONDUITS INTO NEW JUNCTION BOX.
3. CONDUIT LOCATION SHOWN SCHEMATICALLY FOR CLARITY. ACTUAL CONDUIT LOCATIONS MAY VARY.
4. ALL JUNCTION BOXES SHALL BE INSTALLED PERPENDICULAR/PARALLEL TO THE EXISTING/PROPOSED SIDEWALK.
5. DISPOSE OF STREET LIGHTS INCLUDING POLES, FIXTURES AND APPURTENANCES PER SPECIFICATIONS.

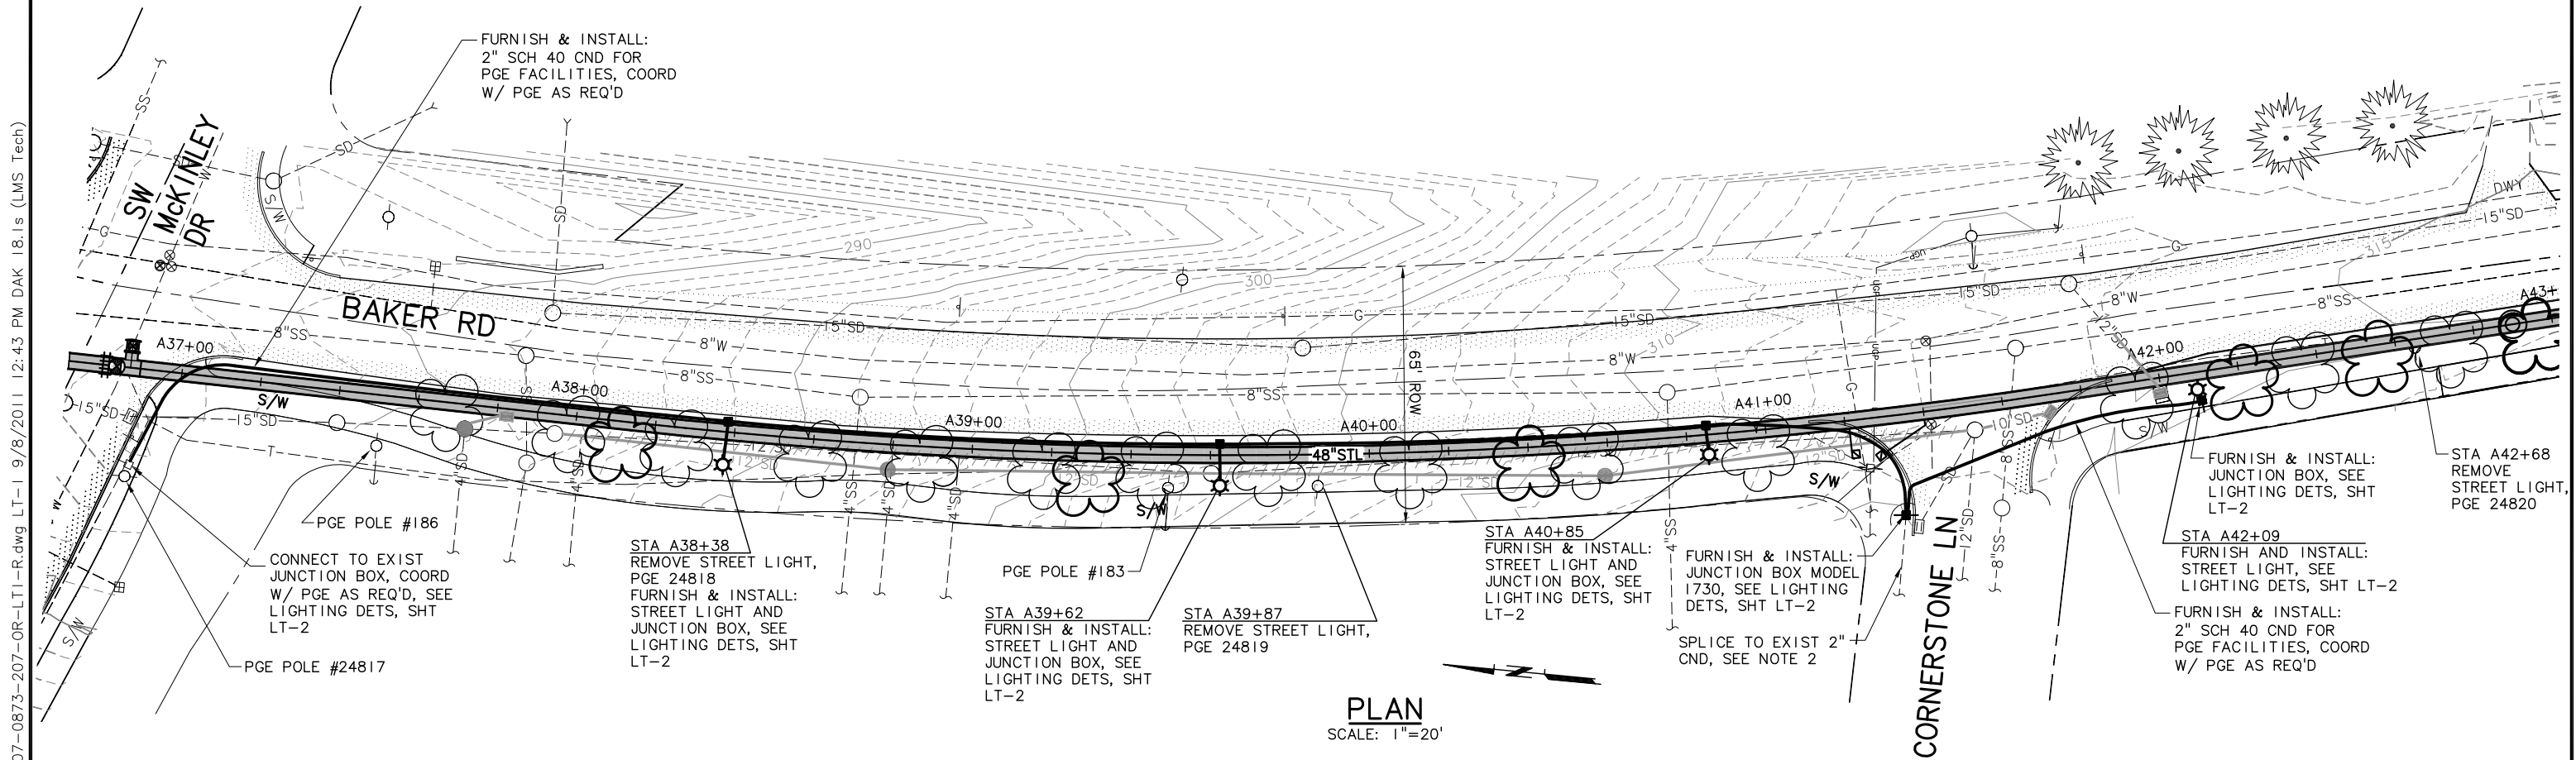

PLAN
SCALE: 1"=20'

C:\PDX_Projects\07\0873\207 Design-Final Plans\CAD\DOR\07-0873-207-OR-LT1-R.dwg LT-1 9/8/2011 12:43 PM DAK 18.1s (LMS Tech)

NO.	DATE	BY	REVISION
1	08/22/11	BVO	RECORD DRAWING

NOTICE
0 1/2 1
IF THIS BAR DOES NOT MEASURE 1" THEN DRAWING IS NOT TO SCALE

SMG
DESIGNED
DAK
DRAWN
MLH
CHECKED

RECORD DRAWING
SEE DISCLAIMER, SHEET 1.
VERSION 4.1
12-9-97

MSA Murray Smith & Associates, Inc.
Engineers/Planners
121 S.W. Salmon, Suite 900 PHONE 503-225-9010
Portland, Oregon 97204 FAX 503-225-9022




WATER SUPPLY IMPROVEMENT PROJECT TRANSMISSION PIPELINE


BAKER ROAD STREET LIGHTING PLAN
PROJECT NO.: 07-0873.207 SCALE: AS SHOWN DATE: JUNE 2009

SHEET
LT-1
75 of 79


C:\Users\dak\appdata\local\temp\AcPublish_6152\07-0873-207-OR-DETS-R.dwg LT-2 9/2/2011 12:06 PM DAK 18.1s (LMS Tech)

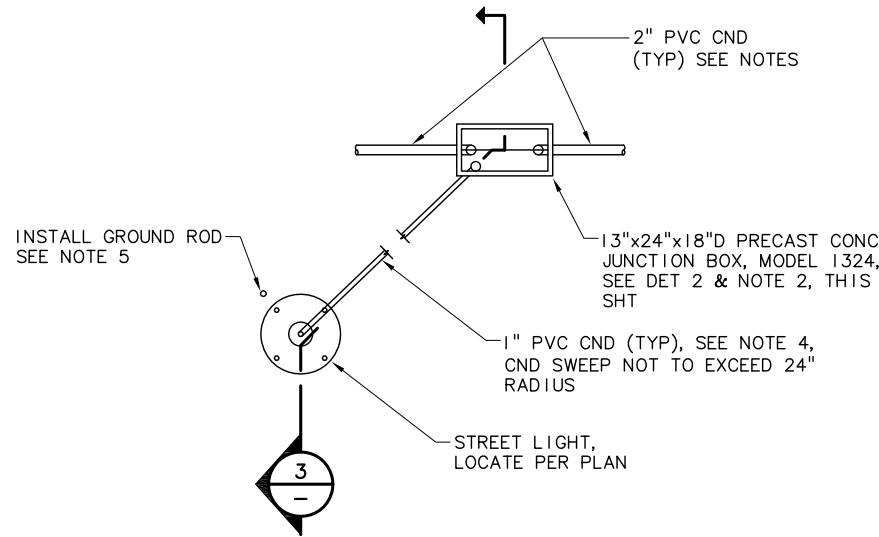

STREET LIGHT FOUNDATION AND JUNCTION BOX LOCATION (TYP)
SCALE: NTS

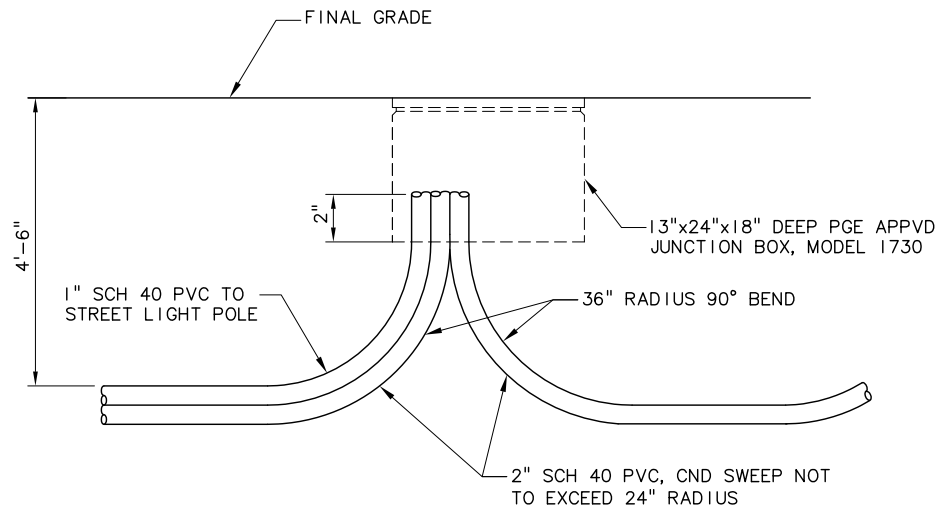


STREET LIGHT CONDUIT/JUNCTION BOX SYSTEM
SCALE: NTS

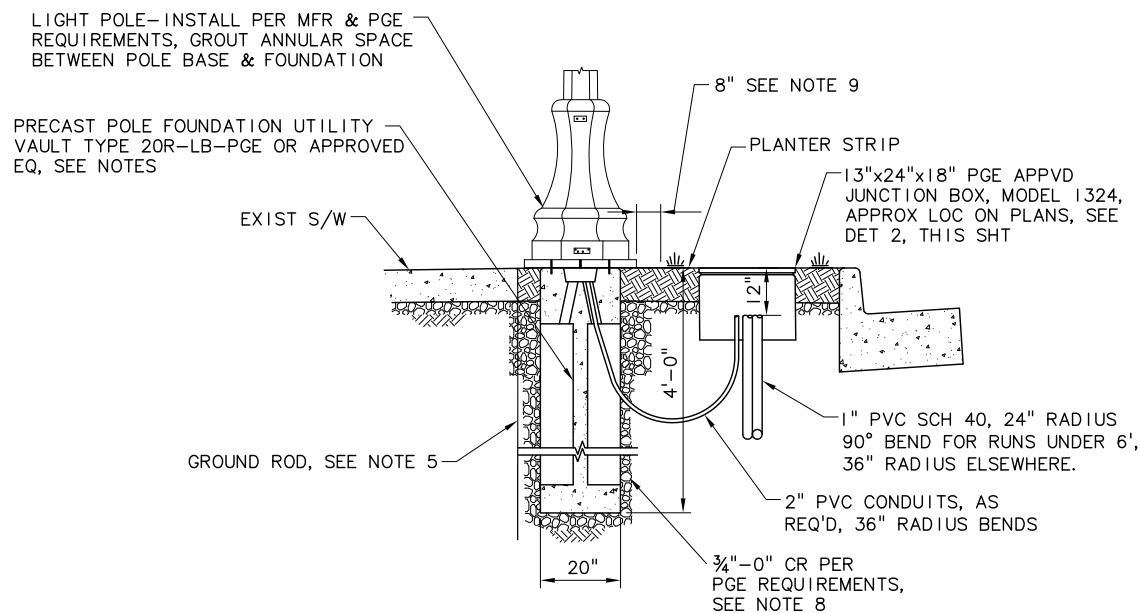

POLE BASE AND FOOTING DETAIL (TYP)
SCALE: NTS

NOTES:

1. LOCATION OF POLES, JUNCTION BOXES, AND CONDUIT SHALL BE INSTALLED AS SHOWN ON DRAWINGS OR AS OTHERWISE SPECIFIED BY THE ENGINEER. ALL LIGHTING EQUIPMENT MUST BE PLACED WITHIN THE RIGHT-OF-WAY. PLACE LIGHTING CONDUIT IN COMMON UTILITY TRENCH WHENEVER POSSIBLE.
2. FURNISH AND INSTALL FLUTED ALUMINUM POLE WITH WIDE REFRACTIVE GLOBE AND 150W LAMP.
3. FURNISH AND INSTALL PGE APPROVED JUNCTION BOXES. FIELD LOCATE TO ACCOMMODATE 24" OR 36" RADIUS 90° BEND AS REQUIRED BY PGE.
4. ALL BENDS SHALL BE FACTORY MADE. TRENCH AND ELBOW CONFIGURATIONS MUST BE INSPECTED BY PGE PRIOR TO BACKFILLING. CONTRACTOR TO CALL PGE TWO DAYS PRIOR TO INSPECTION. CONTACT JEFF STEIGLEDER AT 503-570-4404.
5. FURNISH AND INSTALL 5/8" DIAMETER x 8 FOOT LONG GALVANIZED GROUND ROD, AND 5/8" DIAMETER GROUND ROD CLAMP PER PGE REQUIREMENTS. ATTACH GROUND ROD TO POLE WITH #6 SOLID COPPER WIRE.
6. ALL CONDUIT SHALL BE GRAY SCHEDULE 40, ELECTRICAL GRADE PVC CONDUIT WITH NYLON PULL LINE (500 LBS TEST). INSTALL CONDUIT PER TYPICAL TRENCH DETAIL.
7. INSTALL PRECAST POLE FOUNDATIONS SUCH THAT TOP OF FOUNDATION IS FLUSH WITH TOP OF PROPOSED SIDEWALK.
8. BACKFILL PRECAST POLE FOUNDATIONS WITH 3/4"-MINUS CRUSHED ROCK. COMPACT TO 95% MAXIMUM DENSITY. EXTEND CRUSHED ROCK BACKFILL TO EXCAVATION SIDE SLOPES. MINIMUM 1 FOOT THICK ALL AROUND FOUNDATION.
9. STREETLIGHT WIRE SHALL BE #10 AWG, 600 VOLT, 3 CONDUCTOR, CLASS B STRANDING, TYPE TC WITH SUNLIGHT RESISTANT 45-MIL PVC JACKET PER PGE SPECIFICATIONS.

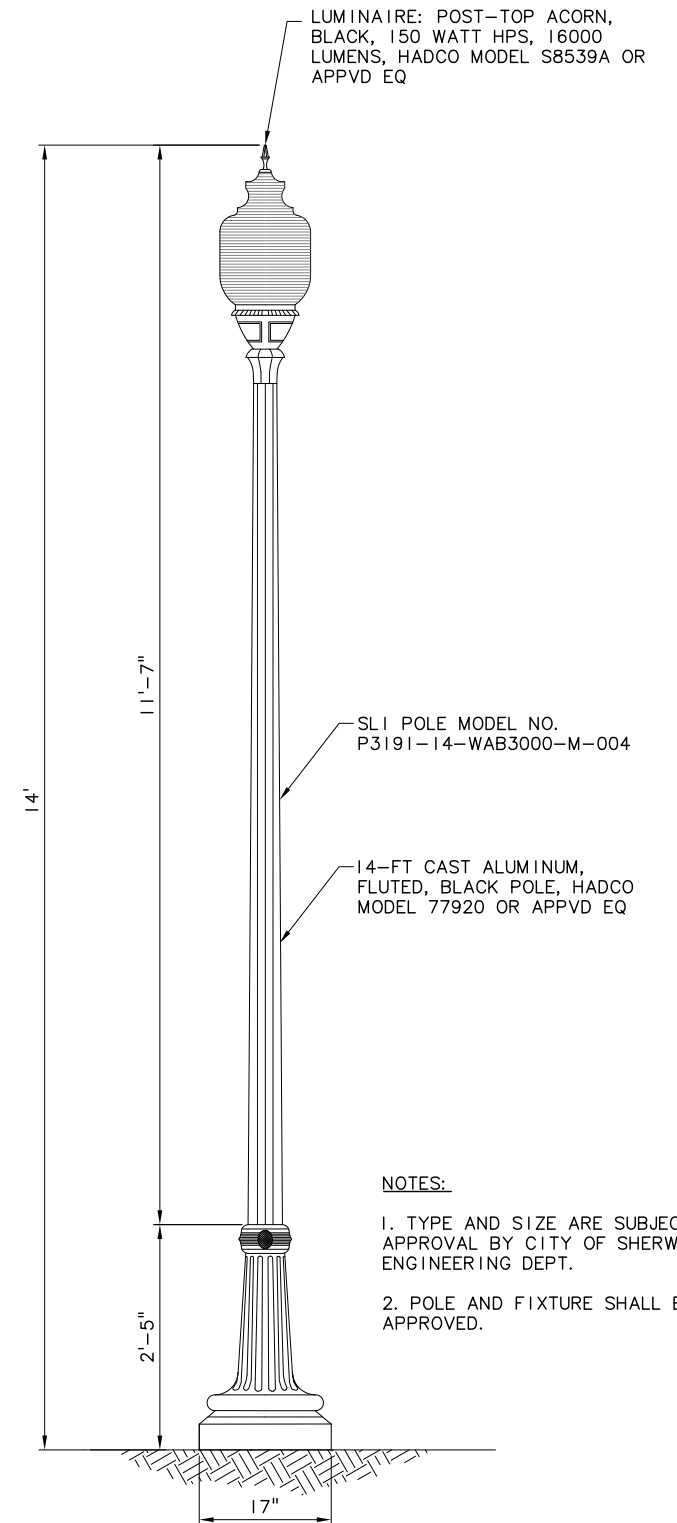

STREET LIGHT POLE
SCALE: NTS

NOTES:

1. TYPE AND SIZE ARE SUBJECT TO APPROVAL BY CITY OF SHERWOOD ENGINEERING DEPT.
2. POLE AND FIXTURE SHALL BE PGE APPROVED.

NO.	DATE	BY	REVISION
1	08/22/11	BVO	RECORD DRAWING

NOTICE

IF THIS BAR DOES NOT MEASURE 1" THEN DRAWING IS NOT TO SCALE

SMG DESIGNED
DAK DRAWN
MLH CHECKED

RECORD DRAWING

SEE DISCLAIMER, SHEET 1.

VERSION 4.1
12-9-97

MSA Murray Smith & Associates, Inc.
Engineers/Planners

121 S.W. Salmon, Suite 900 PHONE 503-225-9010
Portland, Oregon 97204 FAX 503-225-9022

City of Sherwood Oregon

WATER SUPPLY IMPROVEMENT PROJECT TRANSMISSION PIPELINE

LIGHTING DETAILS

PROJECT NO.: 07-0873.207 SCALE: AS SHOWN DATE: JUNE 2009






SHEET
LT-2
76 of 79

S Y M B O L S

P L A N

S I N G L E L I N E D I A G R A M

S C H E M A T I C D I A G R A M

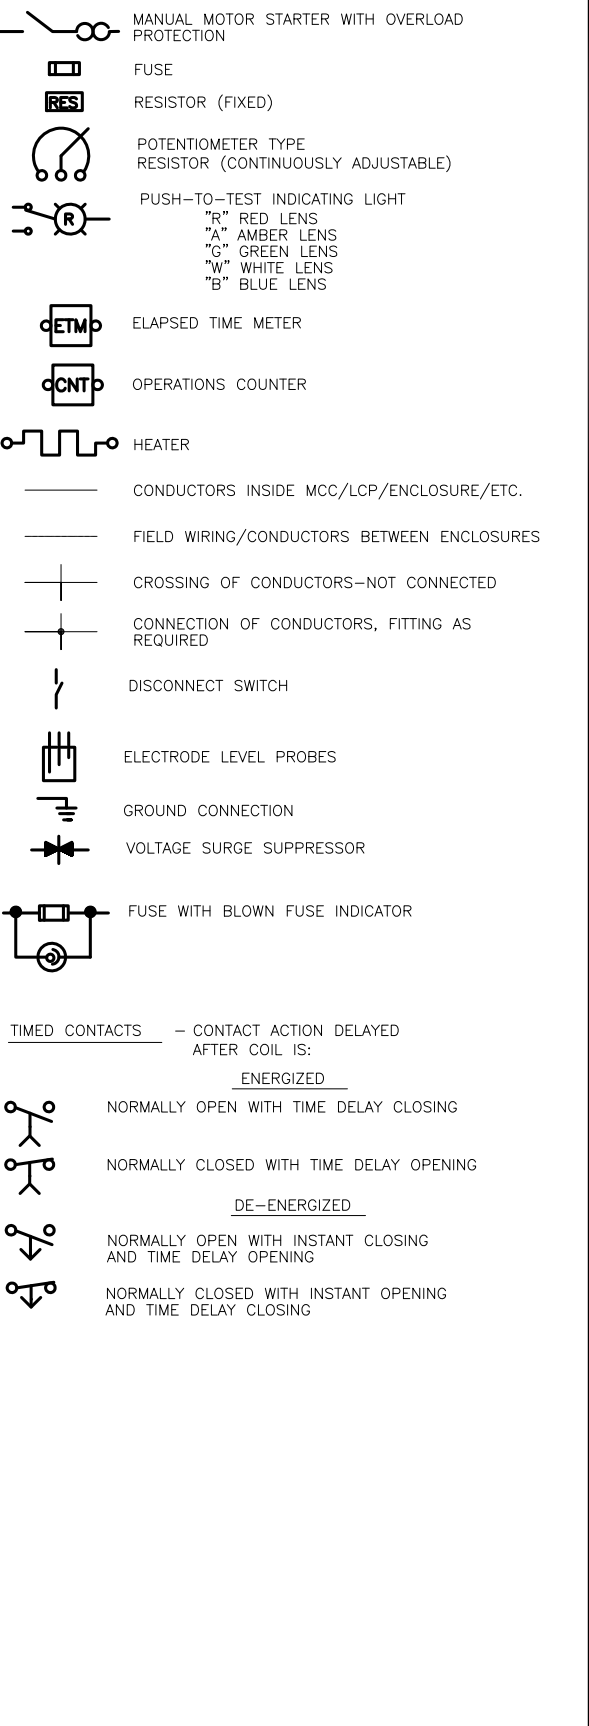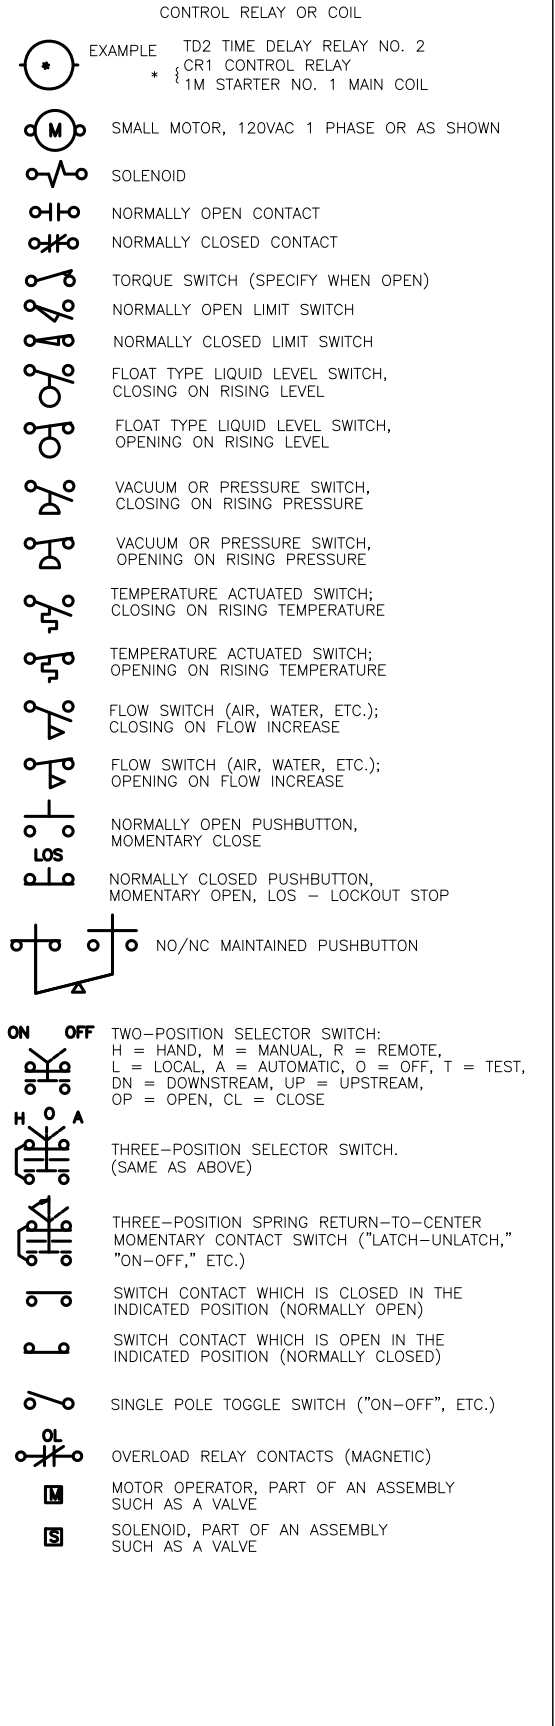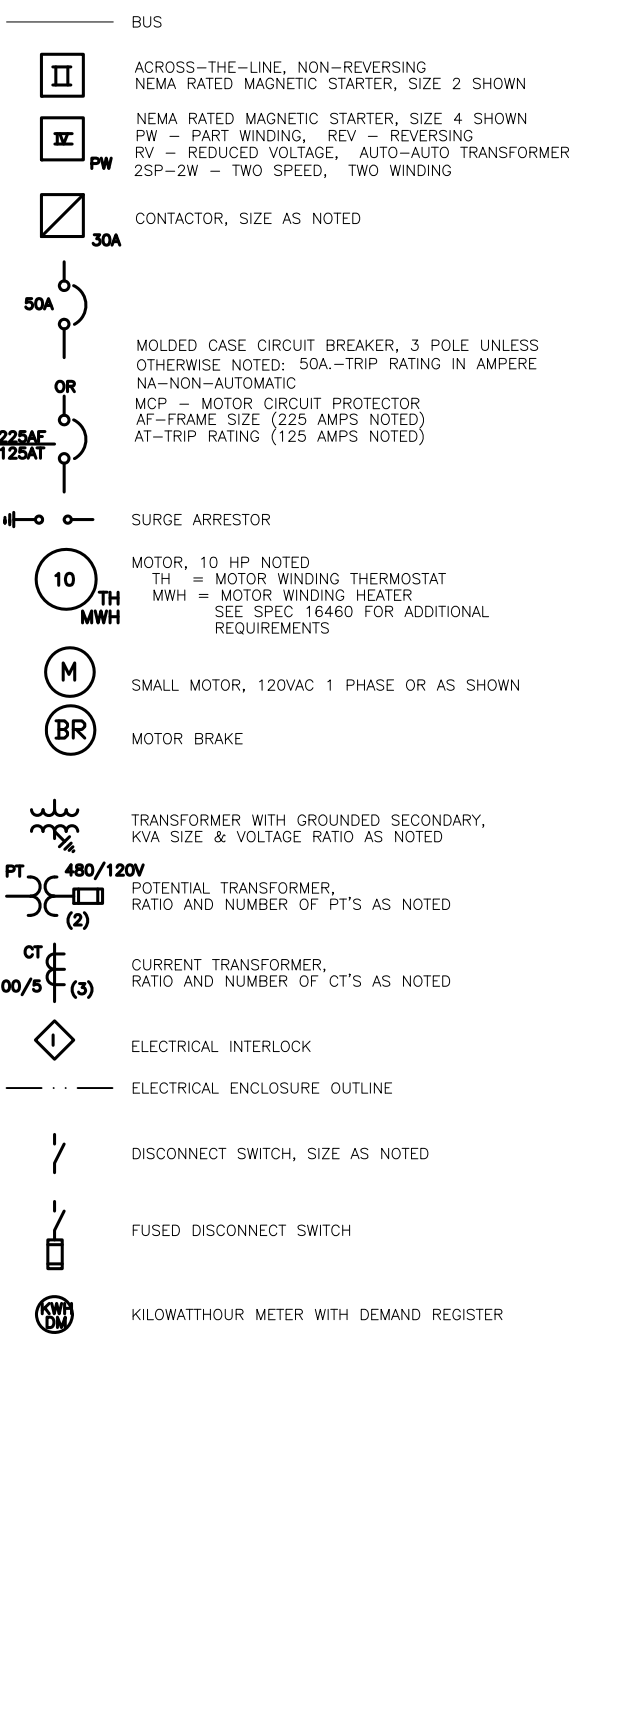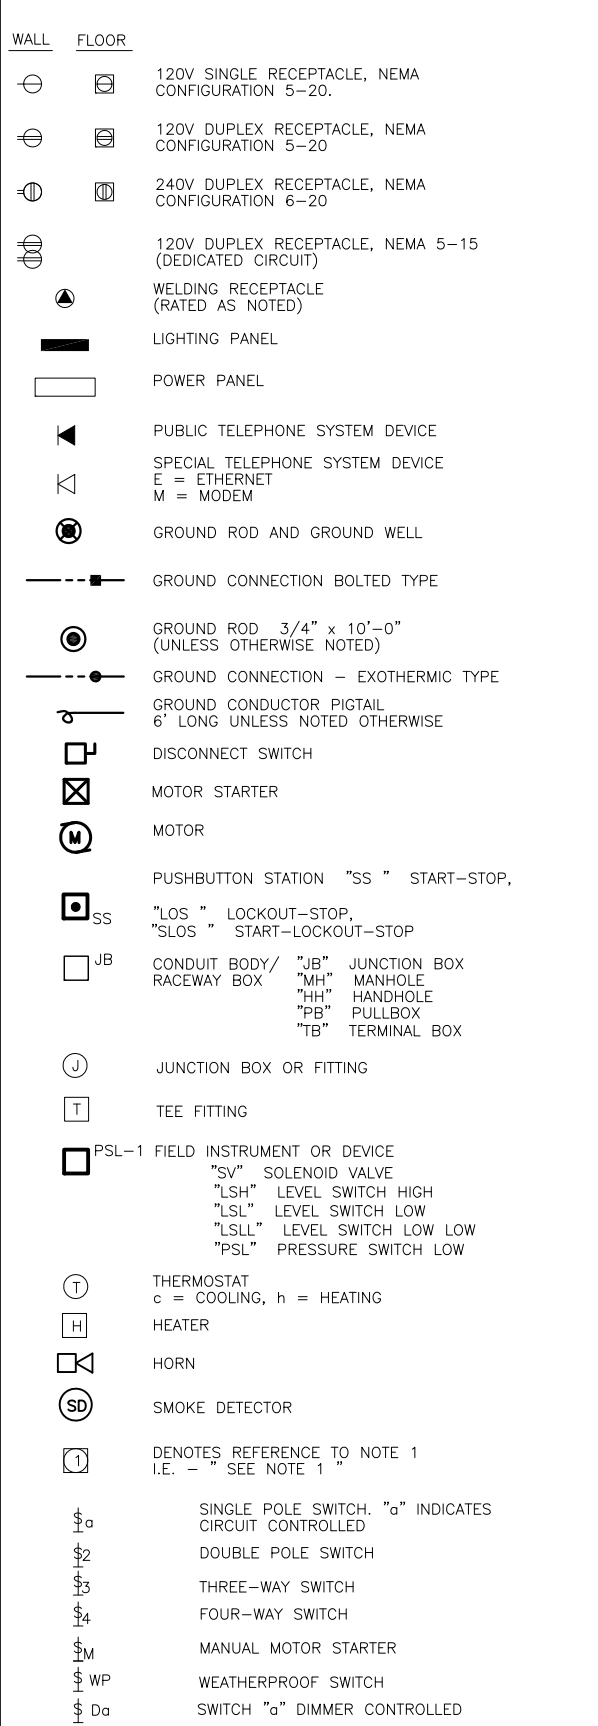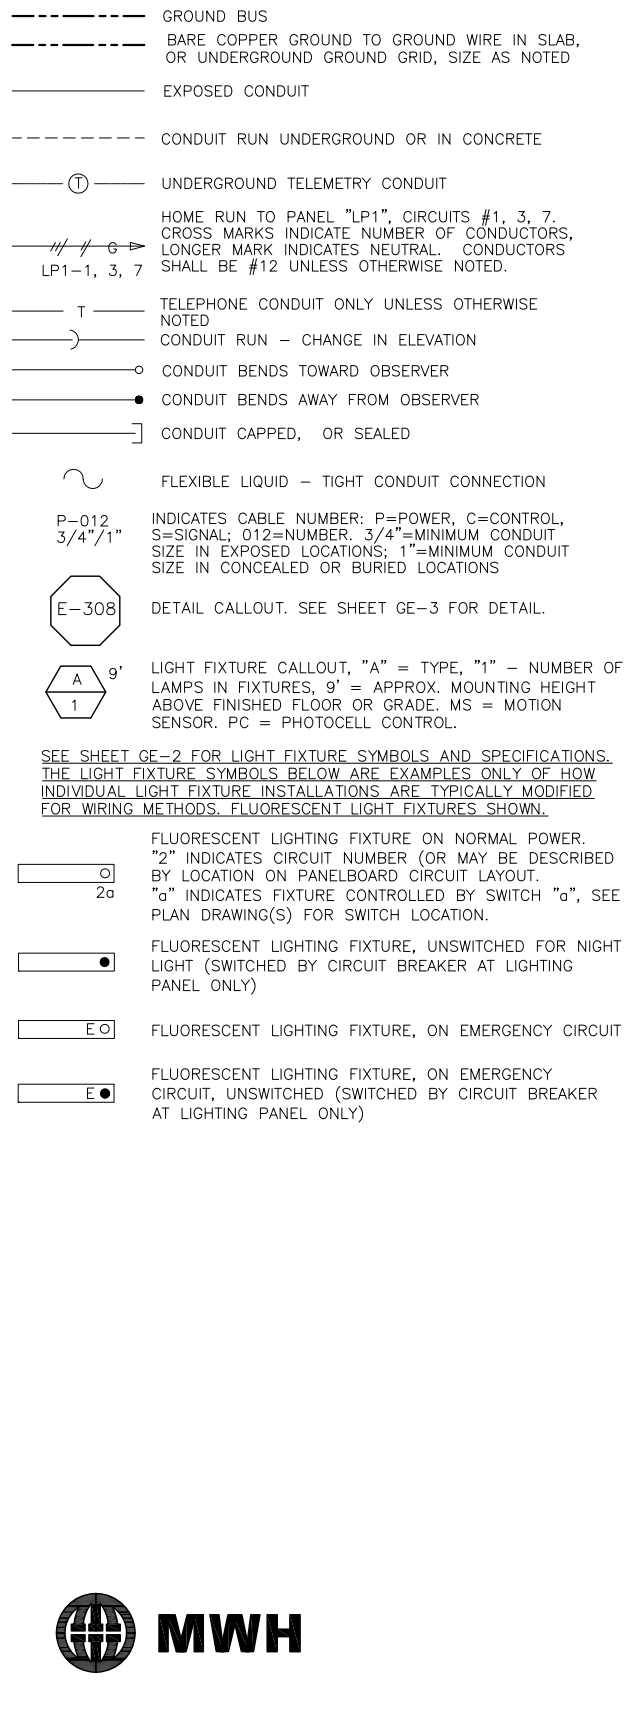

G:\PDX\Projects\07_0873\207_Design-Final_Plans\CAD\DOR\07-0873-207-OR-GE-1-R.dwg GE-1 8/31/2011 4:27 PM DAK 18.1s (LMS Tech)



NOTICE

0 1/2 1

IF THIS BAR DOES NOT MEASURE 1" THEN DRAWING IS NOT TO SCALE

RECORD DRAWING

SEE DISCLAIMER, SHEET 1.

VERSION 4.1
12-9-97

MSA Murray Smith & Associates, Inc.
Engineers/Planners

121 S.W. Salmon, Suite 900 PHONE 503-225-9010
Portland, Oregon 97204 FAX 503-225-9022

WATER SUPPLY IMPROVEMENT PROJECT TRANSMISSION PIPELINE

City of Sherwood Oregon


ELECTRICAL GENERAL SYMBOLS

PROJECT NO.: 07-0873.207 SCALE: NONE DATE: MAY 2009

GE-1

77 OF 79

C:\PDX_Projects\07_0873\207_Design-Final_Plans\CAD\DOR\07-0873-207-OR-GE-2-R.dwg GE-2 8/31/2011 4:27 PM DAK 18.1s (LMS Tech)

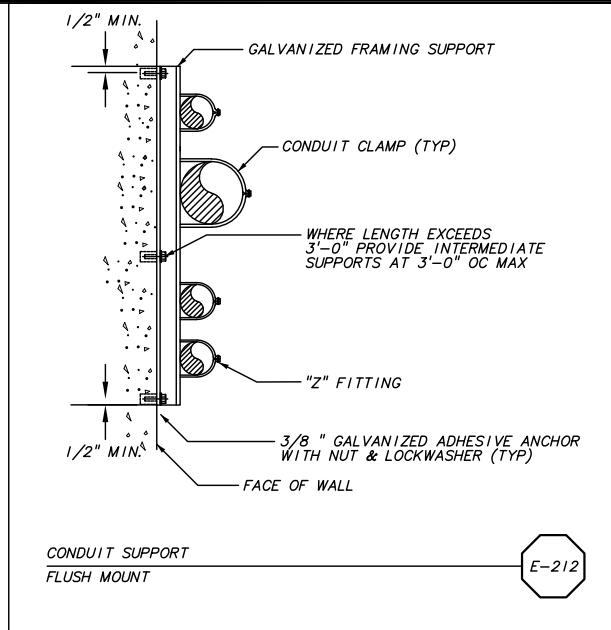

ABBREVIATIONS

<p>1P = ONE POLE 1PH = ONE PHASE 24PS = 24 VOLT DC POWER SUPPLY (REDUNDANT) 2P = TWO POLE 2SP-2W = TWO SPEED, TWO WINDING (MOTOR DR STARTER) 3P = THREE POLE 3PH = THREE PHASE 3W = THREE WIRE 4W = FOUR WIRE 52 = AC CIRCUIT BREAKER (POWER) A = AMPS/AMPERE RATING AFF = ABOVE FINISHED FLOOR AFR = AMPERE FRAME RATING AH = ALARM HORN AIC = AMPERE INTERRUPTING CURRENT (SYMMETRICAL) AIT = ANALYZER INDICATING TRANSMITTER AL = ALARM LIGHT AT = AMPERE TRIP RATING BC = BARE COPPER (CONDUCTOR) BLDG = BUILDING BP = BYPASS CONTACTOR (FVNR RATED) CAP = CAPACITOR (PF CORRECTION) CB = CIRCUIT BREAKER, THERMAL MAGNETIC CL = CLOSING LIGHT CDM = COMMON COMM = COMMUNICATION CPT = CONTROL POWER TRANSFORMER CT = CURRENT TRANSFORMER DISC = DISCONNECT DS = DISCONNECT (E) = EXISTING (EQUIPMENT, BLDG, ETC.) EQPT = EQUIPMENT ETC = ET CETERA FIT = FLOW INDICATING TRANSMITTER FT = FLOW TRANSMITTER FLEX = LIQUID TIGHT FLEXIBLE CONDUIT FS = FLOW SWITCH FVNR = FULL VOLTAGE NON-REVERSING FVR = FULL VOLTAGE REVERSING G = (IF EQPT NAME = GATE, SEE MECHANICAL SCHEDULES. IF WIRE OR PIN = GROUND) GFCI = GROUND-FAULT CIRCUIT-INTERRUPTER GND = GROUNDING WIRE OR CONNECTION H/O/A = HAND/OFF/AUTO (SELECTOR SWITCH) HMI = HUMAN-MACHINE INTERFACE (SCADA COMPUTER) HP = HORSEPOWER HS = HAND SWITCH IC = IN-LINE CONTACTOR JL = POWER LIGHT K = KILLO (THOUSAND) L/O/R = LOCAL/OFF/REMOTE (SELECTOR SWITCH) LCP = LOCAL CONTROL PANEL (FURNISHED BY CONTRACTOR) LI = LEVEL INDICATOR (DIGITAL PANEL METER) LLH = LEVEL LIGHT, HIGH LLHH = LEVEL LIGHT, HIGH HIGH LLLL = LEVEL LIGHT, LOW LOW LSH = LEVEL SWITCH, HIGH LSHH = LEVEL SWITCH, HIGH HIGH LSL = LEVEL SWITCH, LOW LSLL = LEVEL SWITCH, LOW LOW LP = LIGHTING PANELBOARD LT = LEVEL TRANSDUCER MCB = MAIN CONTROL BOARD (EXISTING) MCC = MOTOR CONTROL CENTER MCP = MOTOR CIRCUIT PROTECTOR, SHORT CIRCUIT ME = (IF EQPT NAME = MECHANICAL EQUIPMENT, SEE MECHANICAL SCHEDULES) MFR = MANUFACTURER MISC = MISCELLANEOUS</p>	<p>MS = MOTOR STARTER (FVNR/FVR RATED) MWH = MOTOR WINDING HEATER N/A = NOT APPLICABLE N/B = NORMAL/BYPASS (SELECTOR SWITCH) NEC = NATIONAL ELECTRICAL CODE NEMA = NATIONAL ELECTRICAL MFR. ASSOC. OL = OVERLOAD (THERMAL OR ELECTRONIC) OR OPENING LIGHT PB = PUSHBUTTON PF = POWER FACTOR PG = PRESSURE GAUGE PIT = PRESSURE INDICATING TRANSMITTER PLC = PROGRAMMABLE LOGIC CONTROLLER PM = POWER MONITOR (DIGITAL METER) PNL = PANELBOARD PDT = POTENTIOMETER PP = POWER PANELBOARD PRGS = PVC COATED RGS (CONDUIT) PSH = PRESSURE SWITCH, HIGH PSL = PRESSURE SWITCH, LOW PIT = PRESSURE INDICATING TRANSMITTER PT = POTENTIAL (VOLTAGE) TRANSFORMER PVC = POLYVINYL CHLORIDE (CONDUIT) RGS = RIGID GALVANIZED STEEL (CONDUIT) RIO = REMOTE INPUT/OUTPUT (SIMILAR TO PLC) RTD = RESISTANCE TEMPERATURE DETECTOR RVSS = REDUCED VOLTAGE SOLID STATE (STARTER) SC = SHORTING CONTACTOR (NOT FVNR RATED) SCADA = SUPERVISORY CONTROL AND DATA ACQUISITION SCH = SCHEDULE SS = (IF MATERIAL = STAINLESS STEEL, IF DEVICE = SURGE SUPPRESSOR) SV = SOLENOID VALVE TE = TEMPERATURE ELEMENT (RTD) TH = THERMOSTAT TLH = TEMPERATURE LIGHT, HIGH TP = TELEPHONE PANEL TSH = TEMPERATURE SWITCH, HIGH TSC = TORQUE SWITCH, CLOSED TSD = TORQUE SWITCH, OPEN TSP = TWISTED SHIELDED PAIR (SIGNAL CABLE) TST = TWISTED SHIELDED TRIAD (SIGNAL CABLE) TT = TEMPERATURE TRANSMITTER TVSS = TRANSIENT VOLTAGE SURGE SUPPRESSOR UPS = UNINTERRUPTIBLE POWER SUPPLY VCP = VENDOR CONTROL PANEL (FURNISHED BY EQPT. MFR.) VFD = VARIABLE FREQUENCY DRIVE W/ = WITH WP = WEATHER-PROOF XFMR = TRANSFORMER YI = STATUS INDICATOR (RUN CONTACT, ETC.) YA = STATUS ALARM (TROUBLE CONTACT) ZCL = POSITION LIGHT, CLOSED ZL = POSITION LIGHT ZDL = POSITION LIGHT, OPEN ZS = POSITION (LIMIT OR PROXIMITY) SWITCH ZSC = POSITION SWITCH, CLOSED ZSD = POSITION SWITCH, OPEN</p>
--	--


GENERAL NOTES

- ALL ITEMS ARE NEW UNDER THIS CONTRACT UNLESS OTHERWISE NOTED. ITEMS SHOWN AS "SCREENED" (LIGHTER GRAY TONE OR LIGHT WEIGHT) ARE EXISTING. SCREENED ELECTRICAL OR MECHANICAL EQUIPMENT OR DEVICES SHOULD ALSO BE NOTED AS "EXISTING" OR "(E)". IF EQUIPMENT OR DEVICES ARE NOT SO NOTED THE CONTRACTOR SHALL OBTAIN CLARIFICATION FROM THE OWNER BEFORE BIDDING THAT PORTION OF THE WORK.
- GROUND ALL ELECTRICAL EQUIPMENT, ENCLOSURES, RACEWAYS, EXPOSED METAL, PER NATIONAL ELECTRIC CODE (NEC). THIS PROJECT WAS DESIGNED UNDER THE 2008 NEC.
- FURNISH, INSTALL AND CONNECT CONDUIT AND WIRE FOR ALL PANELBOARD AND MISCELLANEOUS LOADS. CONDUIT AND WIRE SHALL BE INSTALLED IN ACCORDANCE WITH THE SPECIFICATIONS AND APPLICABLE CODES. MINIMUM CONDUIT SIZE FOR PANELBOARD LOADS SHALL BE 3/4" FOR SURFACE MOUNTED AND 1" FOR ENCASED CONDUITS IN ACCORDANCE WITH SECTION 16110. MINIMUM WIRE FILL SHALL BE 3#12, #12 GROUND FOR 3 PHASE LOADS AND 2#12, #12 GROUND FOR 1 PHASE LOADS, OR LARGER AS SHOWN OR REQUIRED BY CODE IN ACCORDANCE WITH SECTION 16120. LAST TWO DIGITS OF CABLE NUMBER FOR LOADS FED FROM PANELBOARDS SHALL BE THE CIRCUIT/POLE NUMBER.
- FURNISH, INSTALL AND CONNECT CONDUIT AND WIRE FOR ALL EQUIPMENT. SEE ELECTRICAL DRAWINGS FOR CONDUIT AND CONDUCTORS TO BE ROUTED BETWEEN EQUIPMENT. CABLE NUMBERS FOR EQUIPMENT SHALL BE THE NUMBER SHOWN ON THE DRAWINGS.
- THE OWNERS SYSTEM INTEGRATOR S&B INC. WILL FURNISH THE FLOW METER AND CONTROL VALVE. THE CONTRACTOR SHALL INSTALL AND CONNECT ALL THIS EQUIPMENT, AND SHALL INCLUDE THOSE COSTS IN THEIR BID. THE CONTRACTOR SHALL COORDINATE WITH S&B INC. TO ENSURE THAT NO OVERLAPS OR OMISSIONS OCCUR IN THEIR BID. S&B INC. WILL PROGRAM THE REMOTE TERMINAL UNIT (RTU - TELEMETRY) EQUIPMENT.

VERY IMPORTANT

CABLE NUMBER LEGEND

- XXX = 3 DIGIT CIRCUIT NUMBER (SAME AS EQPT TAG/LDDP NUMBER)
- T-XXX = TELEPHONE
- P-1XXX = 12.47kVAC POWER
 P-2XXX = 4.16kVAC POWER
 P-3XXX = 480VAC POWER
 P-4XXX = 120/208/240VAC POWER
- C-5XXX = 120VAC CONTROL
 C-6XXX = 24VDC CONTROL
- S-7XXX = 4-20mA SIGNAL
 S-8XXX = OTHER SIGNAL(S)
- D-9XXX = DATA COMM/NETWORK

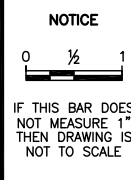

JCD
DESIGNED
JCD
DRAWN
SNH
CHECKED

RECORD DRAWING
SEE DISCLAIMER, SHEET 1.
VERSION 4.1
12-9-97

121 S.W. Salmon, Suite 900 PHONE 503-225-9010
Portland, Oregon 97204 FAX 503-225-9022




WATER SUPPLY IMPROVEMENT PROJECT TRANSMISSION PIPELINE

ELECTRICAL GENERAL ABBREVIATIONS AND NOTES

PROJECT NO.: 07-0873.207 SCALE: NONE DATE: MAY 2009

c:\pdx_projects\07_0873\207_Design-Final_Plans\CAD\DOR\07-0873-207-OR-E-1-R.dwg E-1 9/6/2011 11:50 AM DAK 18.js (LMS Tech)

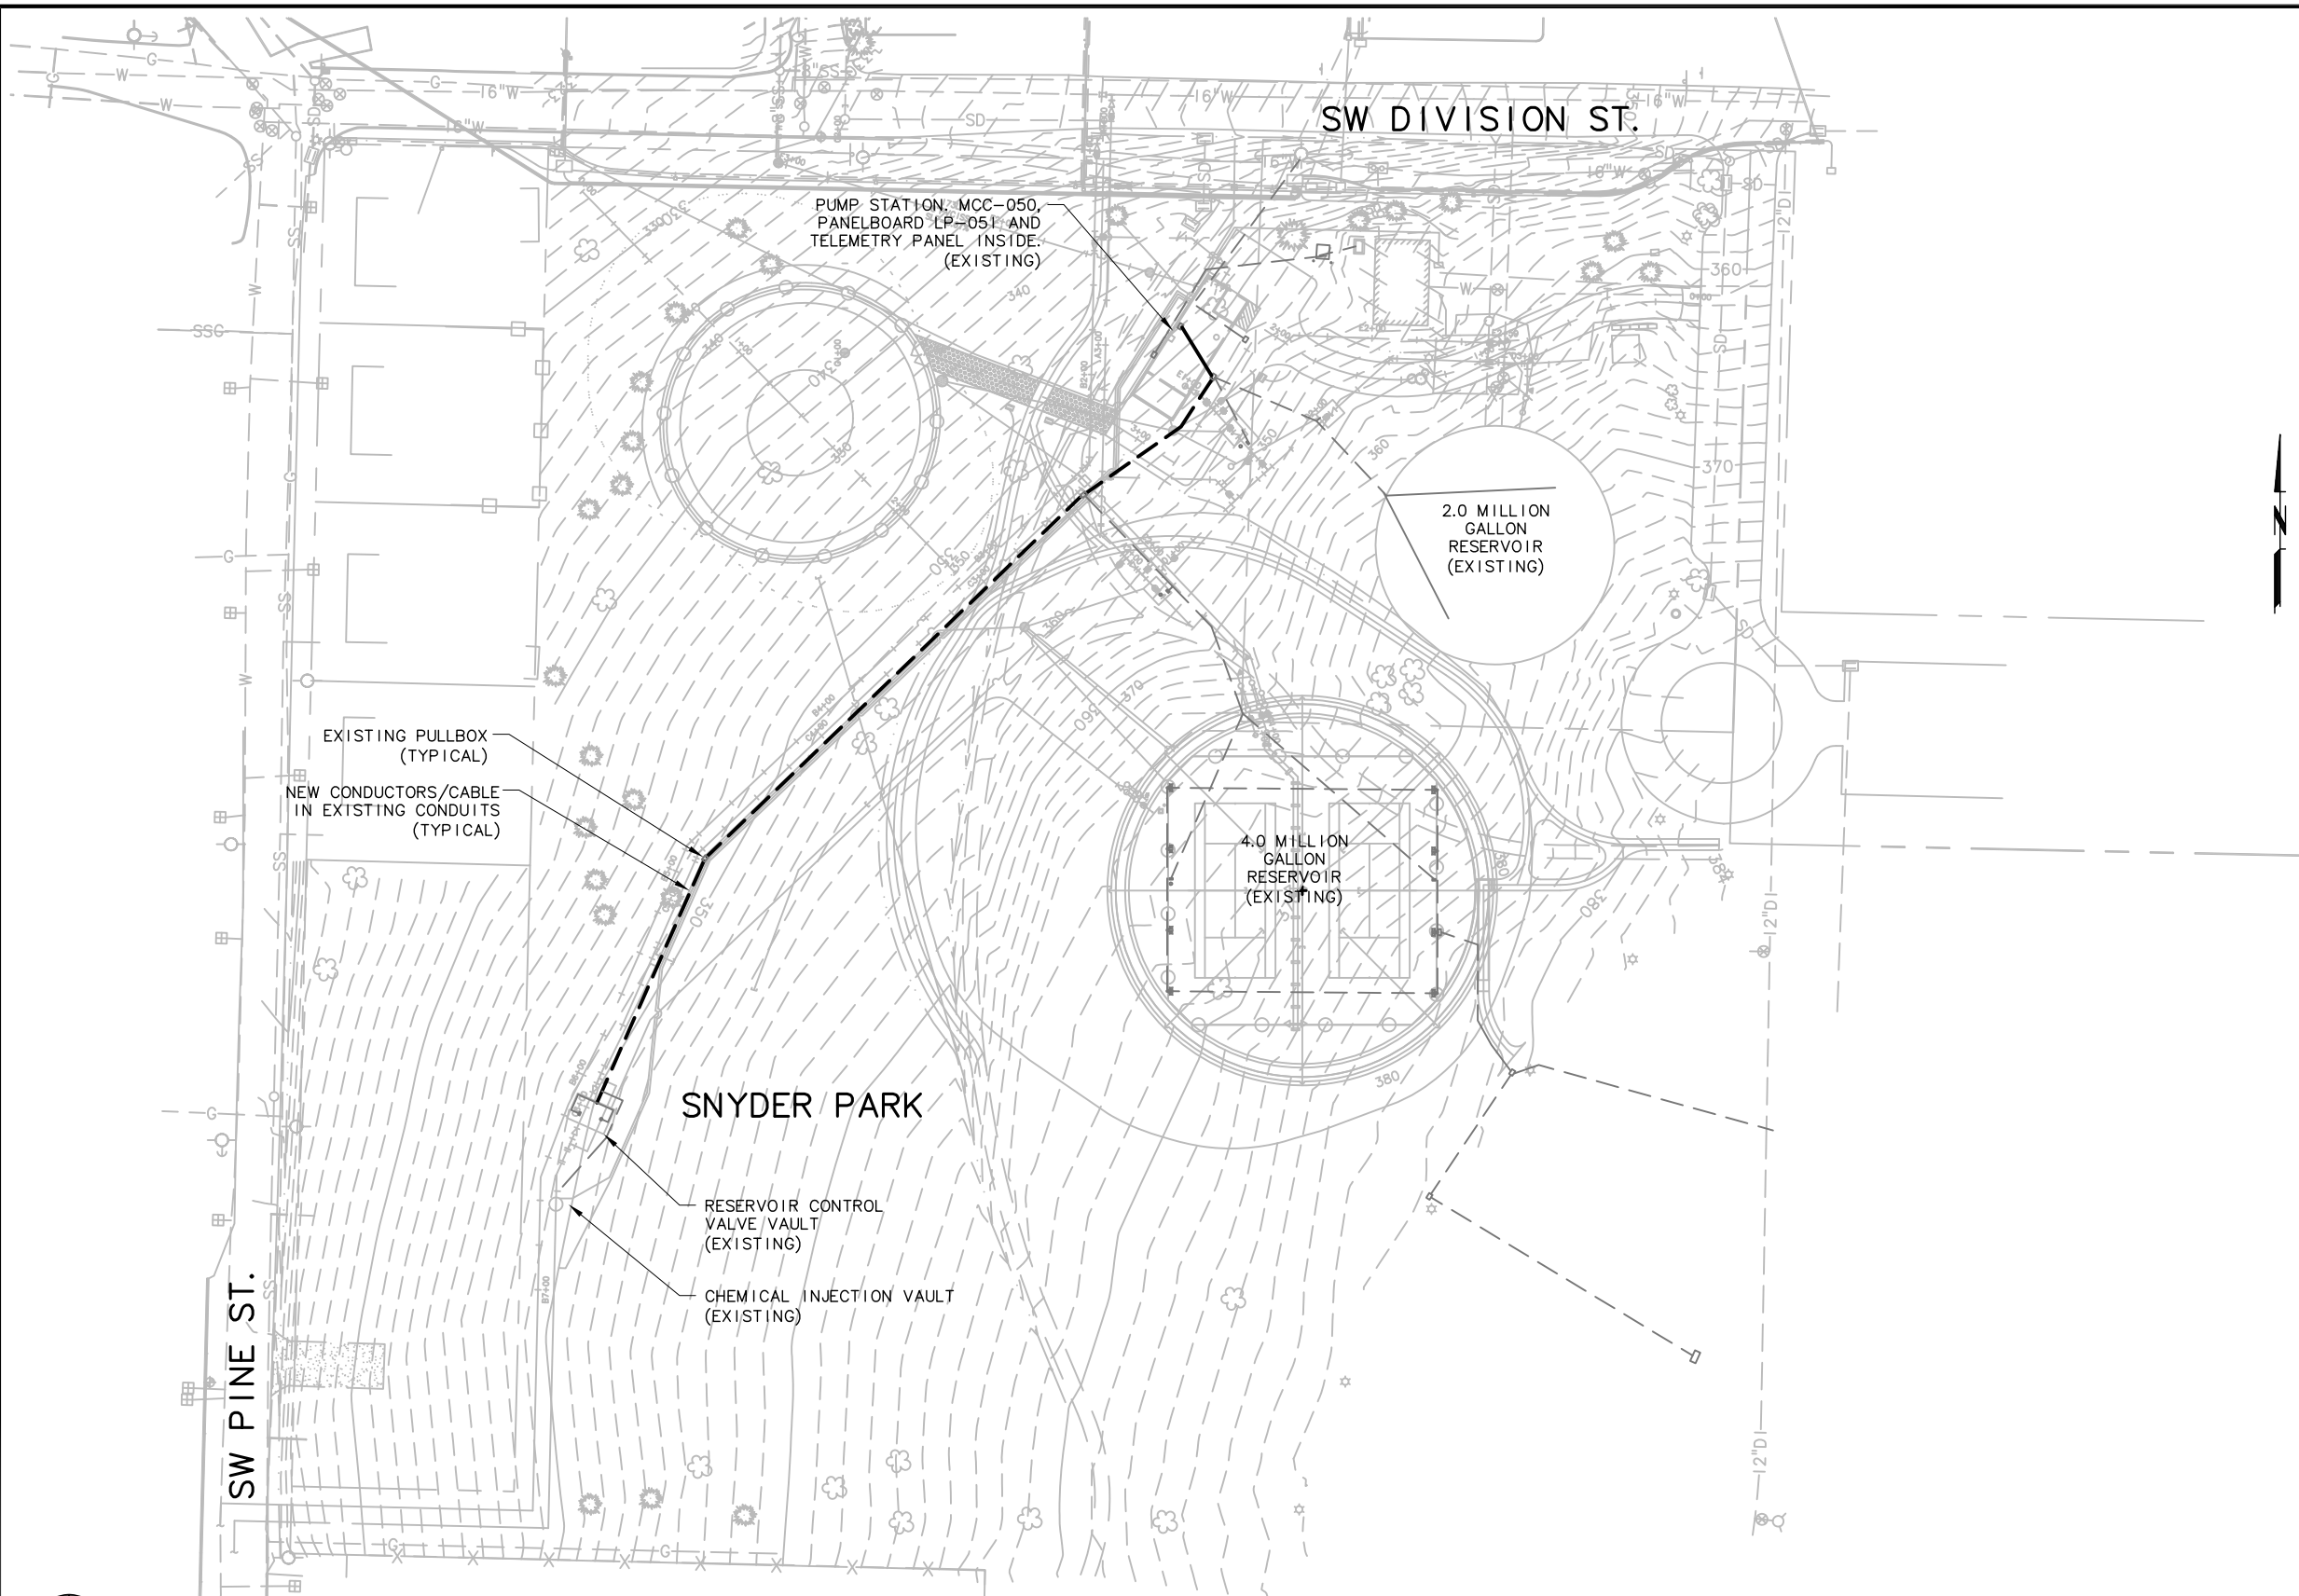

- NOTES:**
1. SEE GENERAL NOTES ON SHEET GE-2.
 2. WORK CONSISTS OF THE FOLLOWING TASKS:
 - A. PULLING NEW CABLES IN EXISTING EMPTY CONDUITS FROM THE EXISTING TELEMETRY PANEL IN THE EXISTING PUMP STATION TO THE EXISTING TERMINAL BOX IN THE EXISTING RESERVOIR CONTROL VALVE VAULT.
 - B. PROVIDING NEW CABLES AND RACEWAYS FROM THE EXISTING TERMINAL BOX TO THE NEW CONTROL VALVE AND FLOWMETER IN THE EXISTING RESERVOIR CONTROL VALVE VAULT.
 - C. TERMINATING CABLES AT EACH LOCATION AS DIRECTED BY THE OWNER'S SYSTEM INTEGRATOR. ALL SPARE CONDUCTORS IN THE TERMINAL BOX SHALL BE TERMINATED ON TERMINALS.
 - D. TESTING PER THE SPECIFICATIONS AND AS REQUIRED BY THE OWNER'S SYSTEM INTEGRATOR.
 3. PROVIDE 4 NEW #16TSP (TWISTED SHIELDED PAIR) SIGNAL CABLES AND 2 NEW #16TST (TWISTED SHIELDED TRIAD) SIGNAL CABLES IN EXISTING CONDUIT S-6211 FROM THE EXISTING TELEMETRY PANEL TO THE EXISTING TERMINAL BOX IN THE EXISTING RESERVOIR CONTROL VALVE VAULT.
 4. PROVIDE 12 NEW #10 120VAC POWER CONDUCTORS IN EXISTING CONDUIT P-4211 FROM THE EXISTING TELEMETRY PANEL TO THE EXISTING TERMINAL BOX IN THE EXISTING RESERVOIR CONTROL VALVE VAULT.
 5. PROVIDE NEW #16TSP AND/OR TST SIGNAL, #14 CONTROL AND #12 POWER CONDUCTORS/ CABLES IN NEW RACEWAYS FROM THE EXISTING TERMINAL BOX IN THE EXISTING RESERVOIR CONTROL VALVE VAULT TO THE NEW FLOW METER AND CONTROL VALVE AS DIRECTED BY THE OWNER'S SYSTEM INTEGRATOR.



SITE PLAN
SCALE: 1"=40'

NO.	DATE	BY	REVISION
1	08/22/11	BVO	RECORD DRAWING

NOTICE

0 1/2 1

IF THIS BAR DOES NOT MEASURE 1" THEN DRAWING IS NOT TO SCALE

JCD DESIGNED
JCD DRAWN
SNH CHECKED

RECORD DRAWING

SEE DISCLAIMER, SHEET 1.

VERSION 4.1
12-9-97

MSA Murray Smith & Associates, Inc.
Engineers/Planners

121 S.W. Salmon, Suite 900 PHONE 503-225-9010
Portland, Oregon 97204 FAX 503-225-9022



WATER SUPPLY IMPROVEMENT PROJECT TRANSMISSION PIPELINE

ELECTRICAL SITE LAYOUT PLAN

PROJECT NO.: 07-0873.207 SCALE: AS SHOWN DATE: MAY 2009